

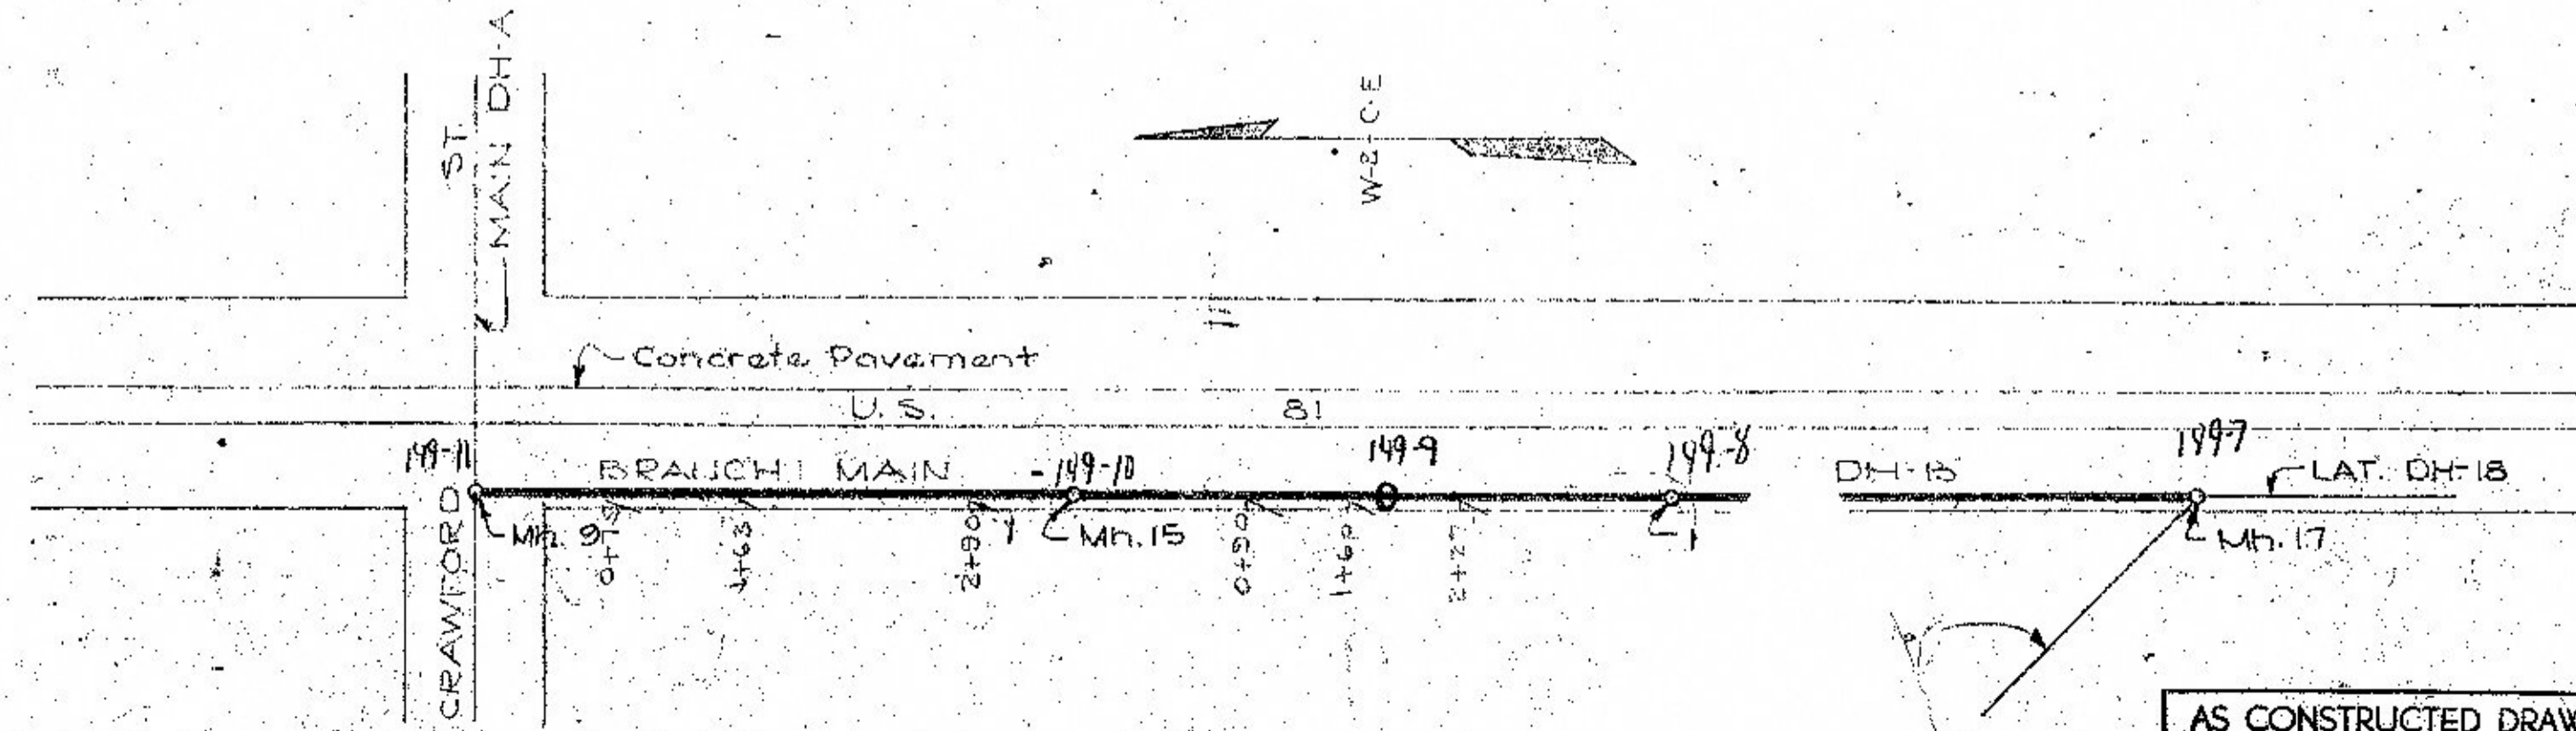


NOTE:
Tops of all manholes to be constructed to finished grade elevation.
Ground water elevations as of 7 July 1952.

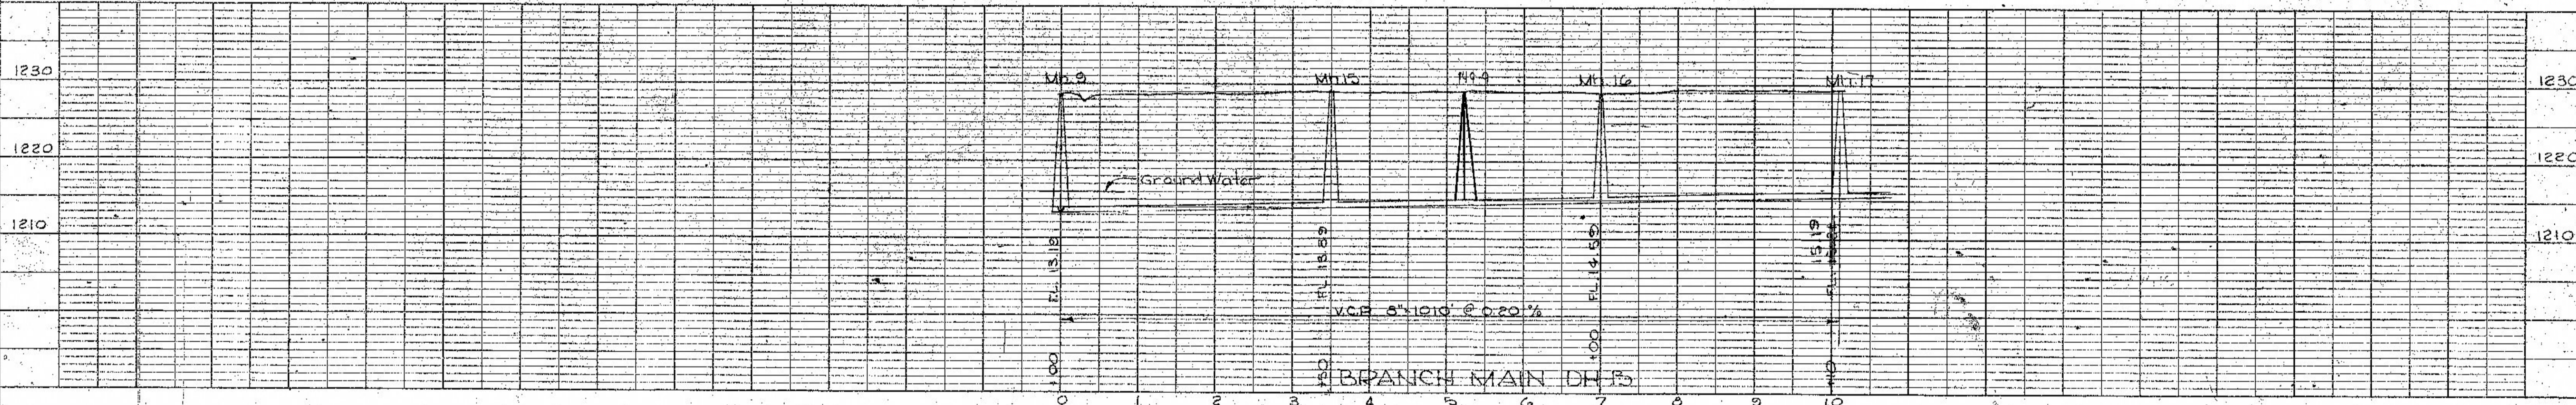

SCALE
Plan: 1"=50'
Profile: 1"=10' Vert.
1"=50' Horiz.

AS CONSTRUCTED DRAWING
By _____ Date APR 14 1953

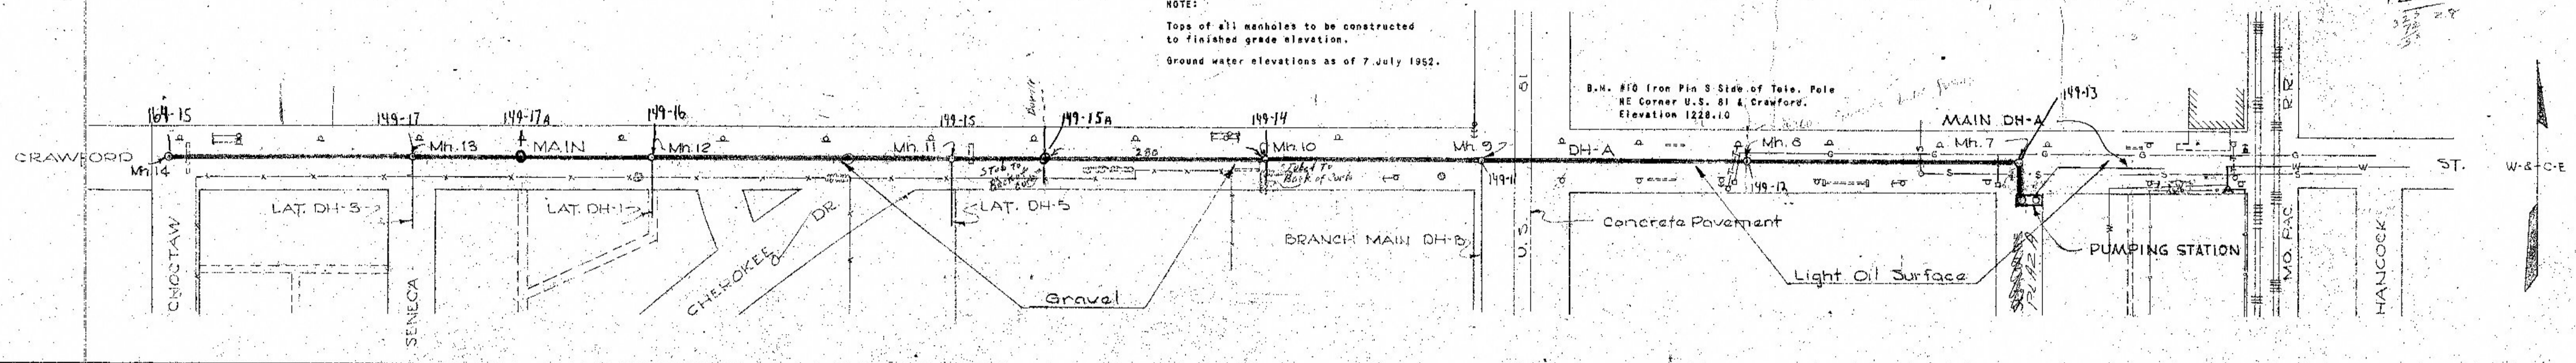

SALINA, KANSAS
SANITARY SEWER EXTENSIONS
MAIN DH-A STA 0+00 TO STA 24+25
AND MAIN DH-B
Scale as Noted
WILSON & COMPANY
ENGINEERS -
Salina, Kansas
1952

PROJECT: SALINA, KANSAS
SALINA, KANSAS
SALINA, KANSAS
SALINA, KANSAS
SALINA, KANSAS

FILE NO: 151-812
SUB P.S.
DATE: _____