
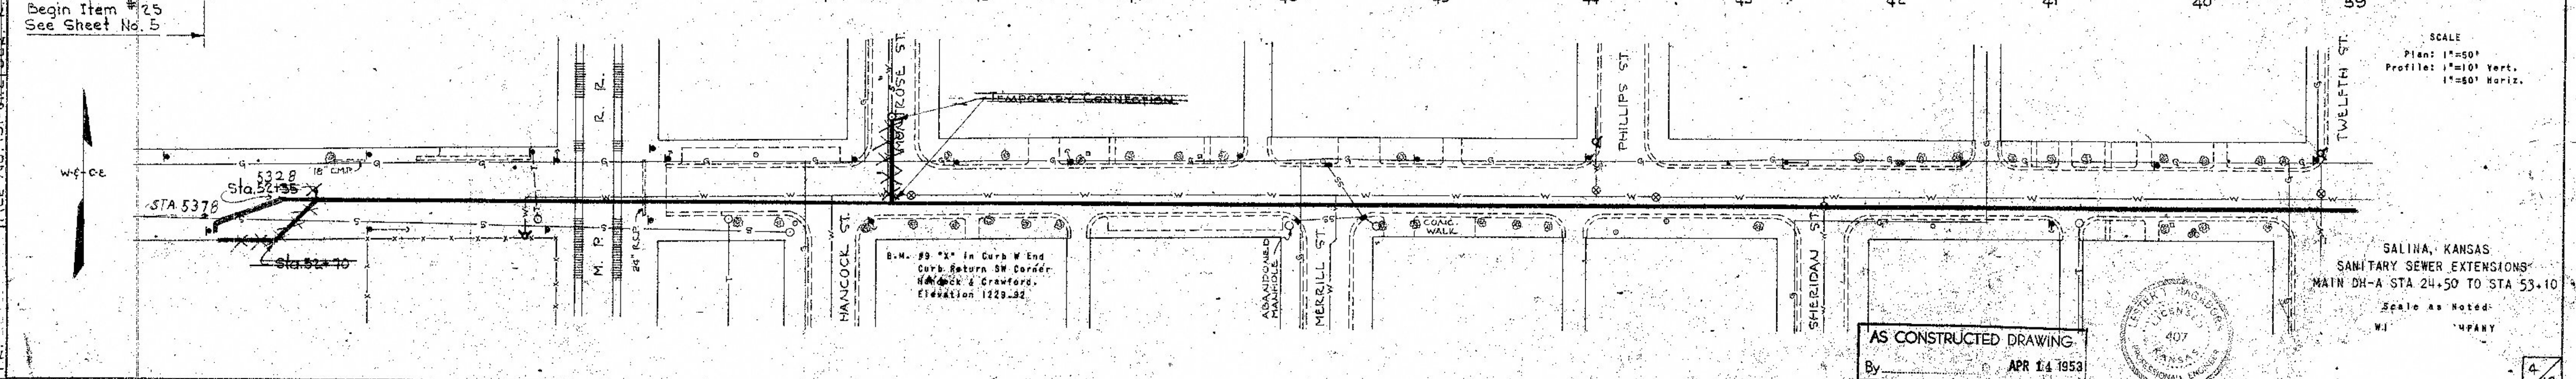
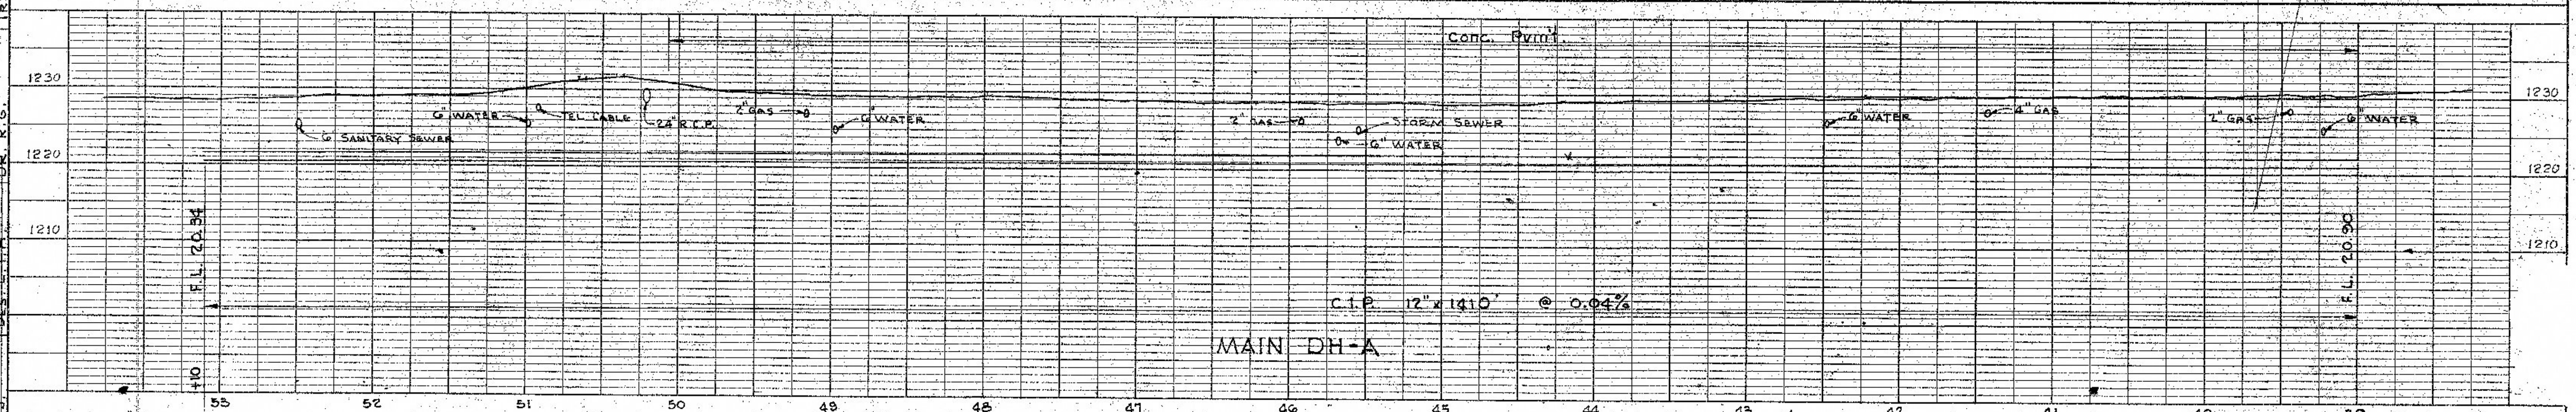
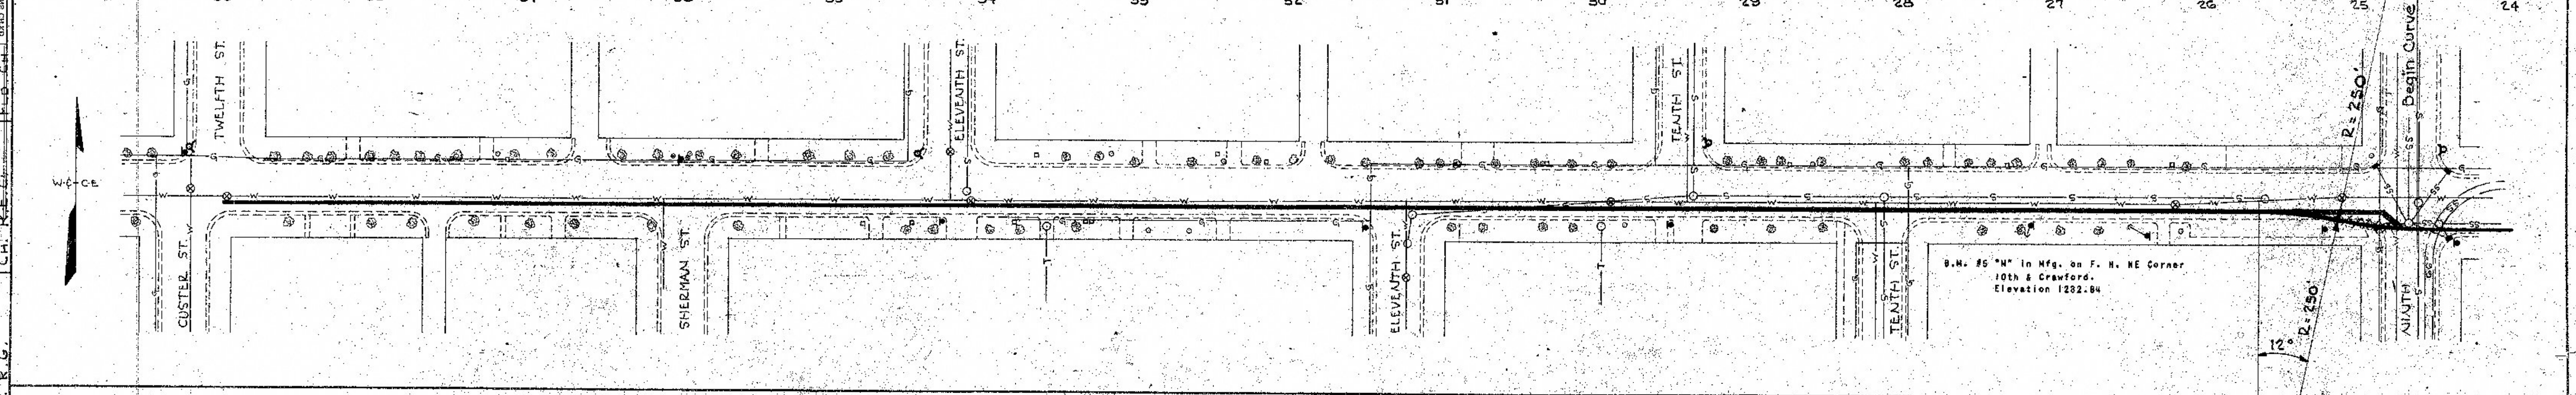


| | |
|----------|----------|
| PROJECT | 1211 |
| DATE | 12/15/53 |
| BY | BA |
| CHECKED | |
| APPROVED | |
| SCALE | AS NOTED |

| | |
|----------|----------|
| FILE NO. | 51-8-2-3 |
| DATE | 12/15/53 |
| BY | BA |
| CHECKED | |
| APPROVED | |
| SCALE | AS NOTED |

| | |
|----------|----------|
| FILE NO. | 51-8-2-3 |
| DATE | 12/15/53 |
| BY | BA |
| CHECKED | |
| APPROVED | |
| SCALE | AS NOTED |

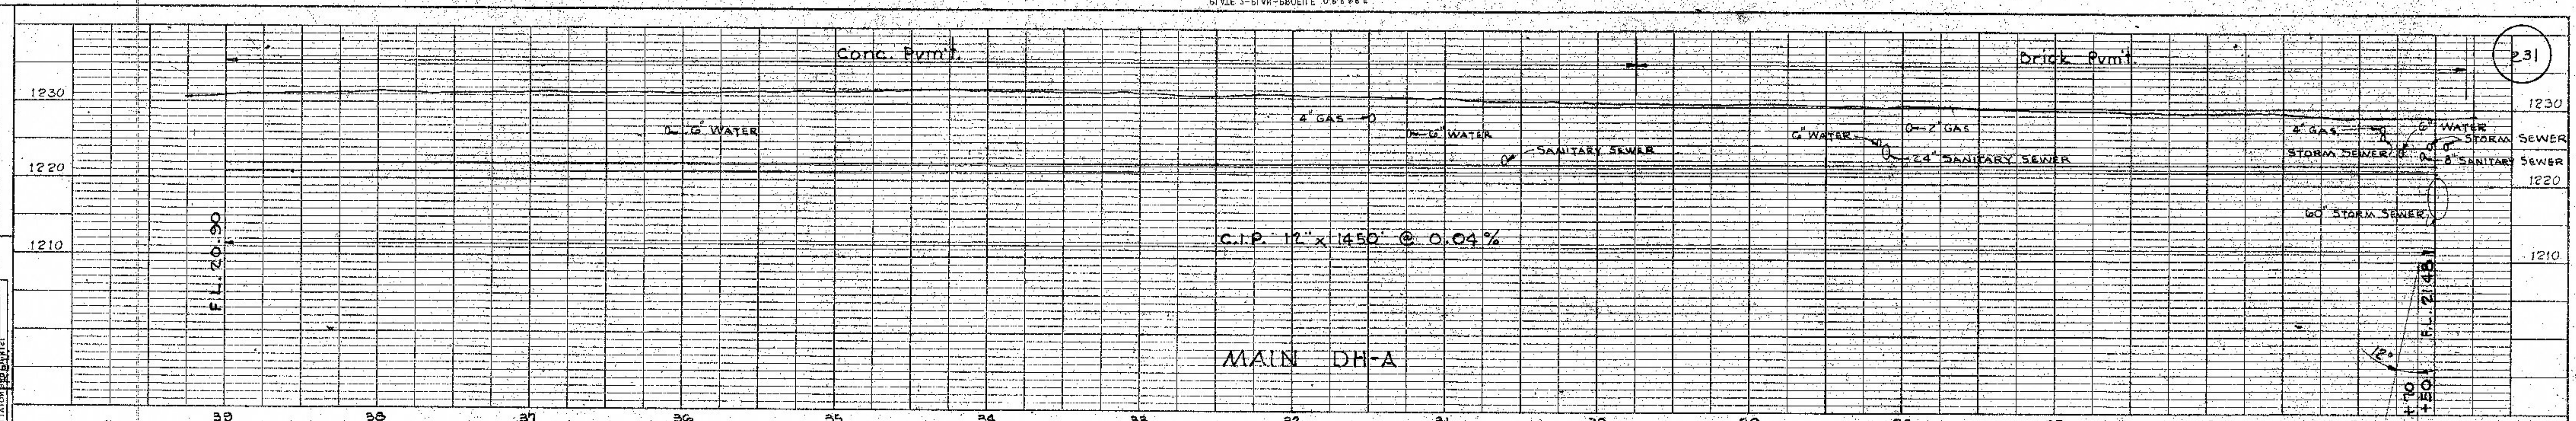

AS CONSTRUCTED DRAWING
By _____ APR 14 1953



SALINA, KANSAS
SANITARY SEWER EXTENSIONS
MAIN DH-A STA 24+50 TO STA 53+10