



PLAN	SURVEYED	DATE
NOTED	BY	
CHECKED		
APPROVED		


PROFILE	SURVEYED	DATE
NOTED	BY	
CHECKED		
APPROVED		

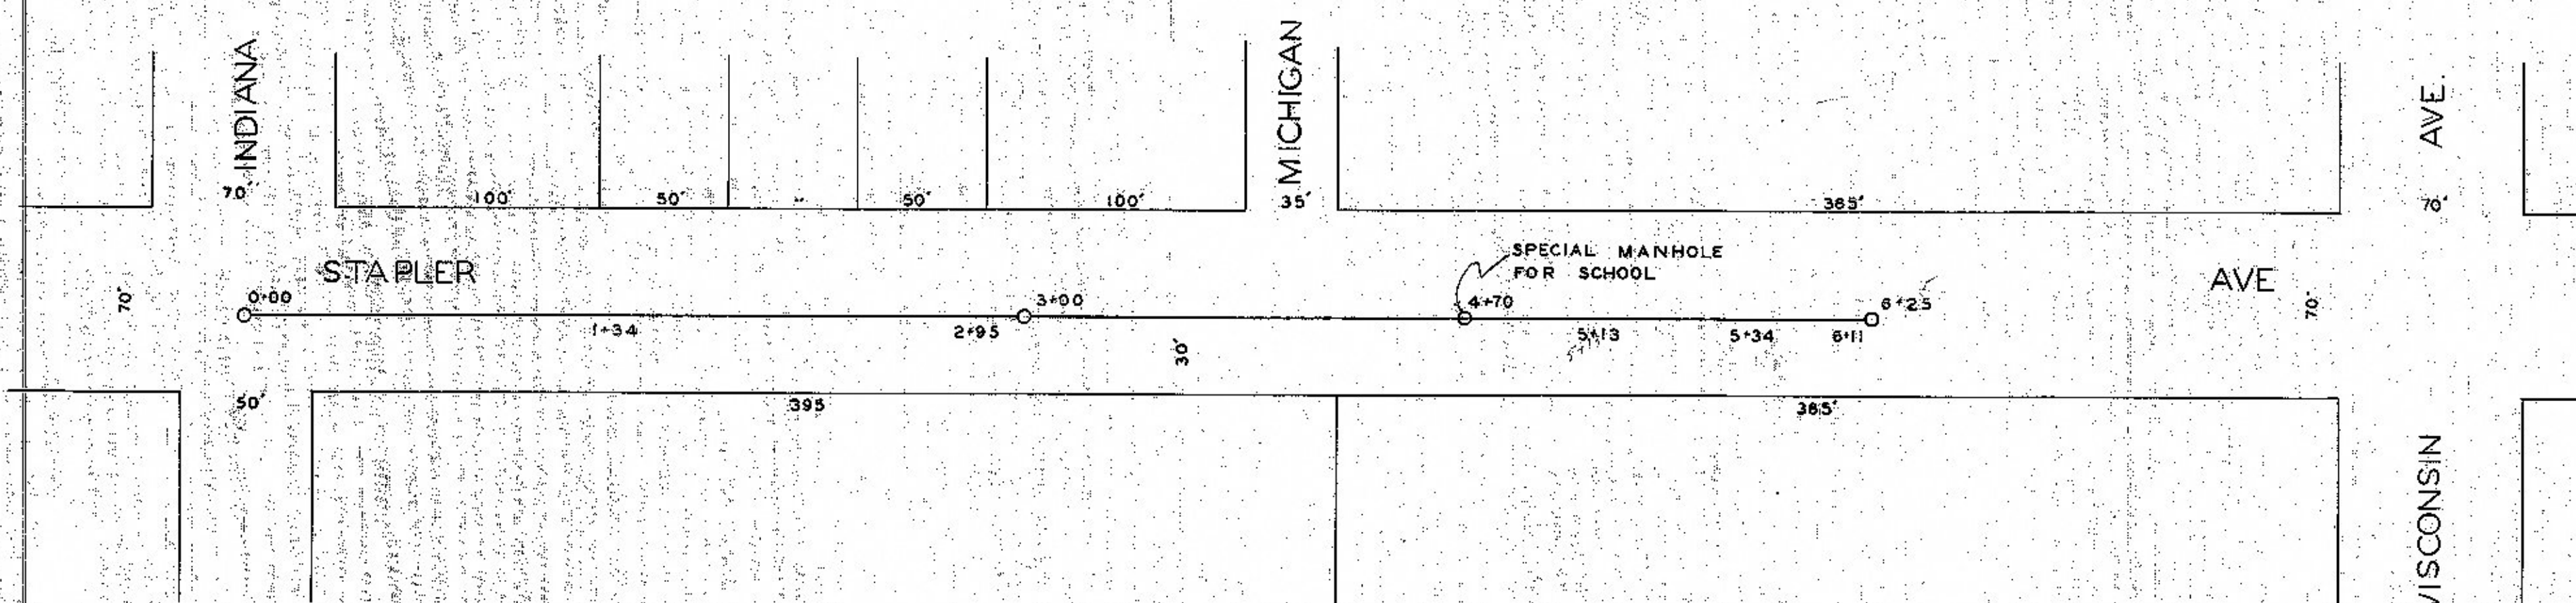


STAPLER AVE - INDIANA TO 650' EAST

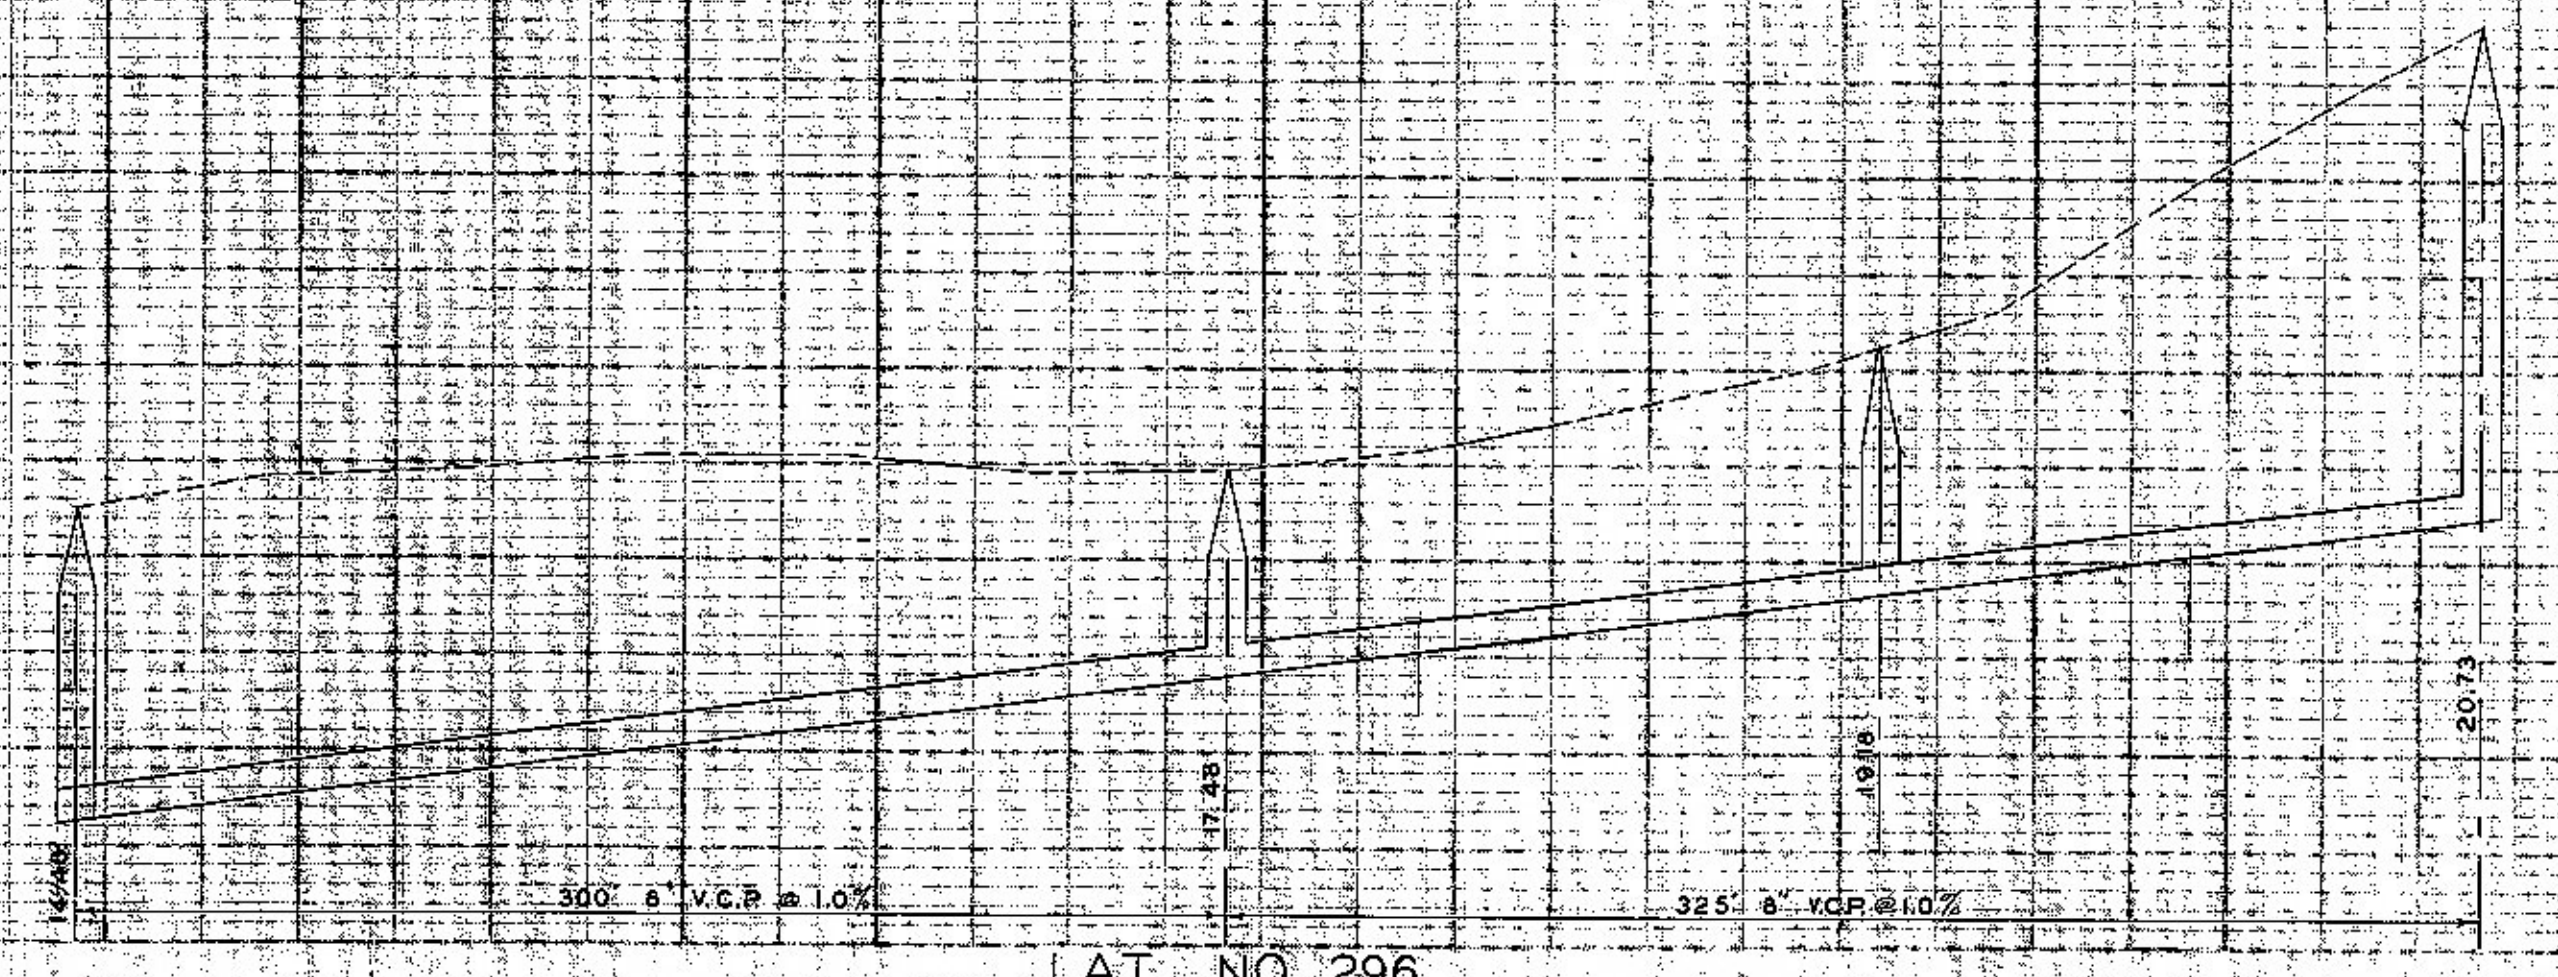

AS-BUILT PLAN
 CONSTRUCTED - MAY, 1953
 BY
 M. COLLEUM CONST. CO.
 SALINA - KANSAS

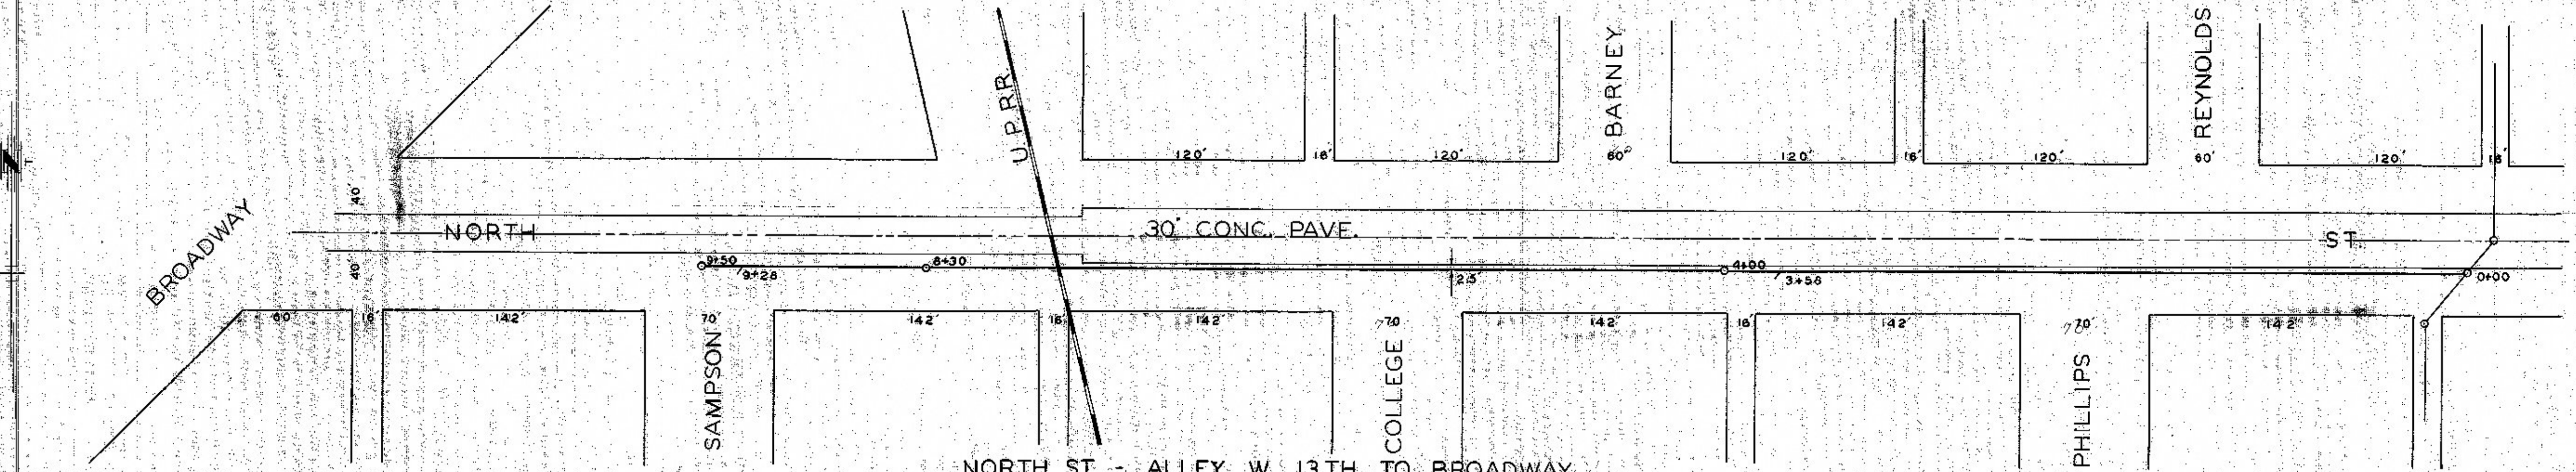

NORTH ST - ALLEY W 13TH TO BROADWAY

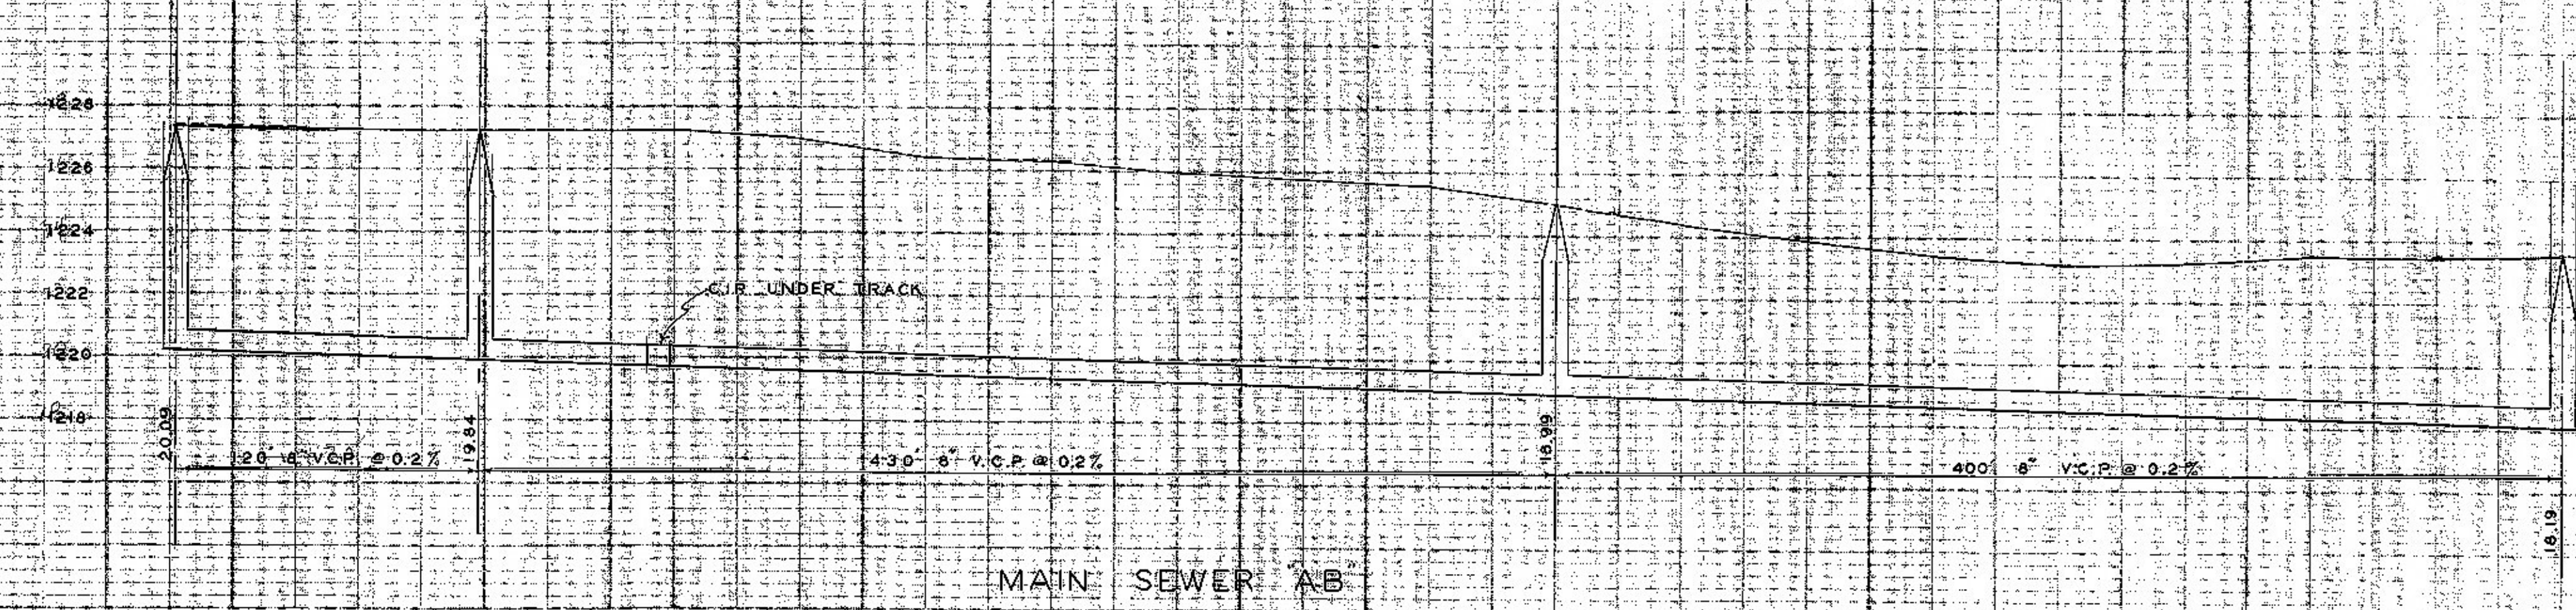

AS-BUILT PLAN
 CONSTRUCTED - MAY, 1953
 BY
 M. COLLEUM CONST. CO.
 SALINA - KANSAS