

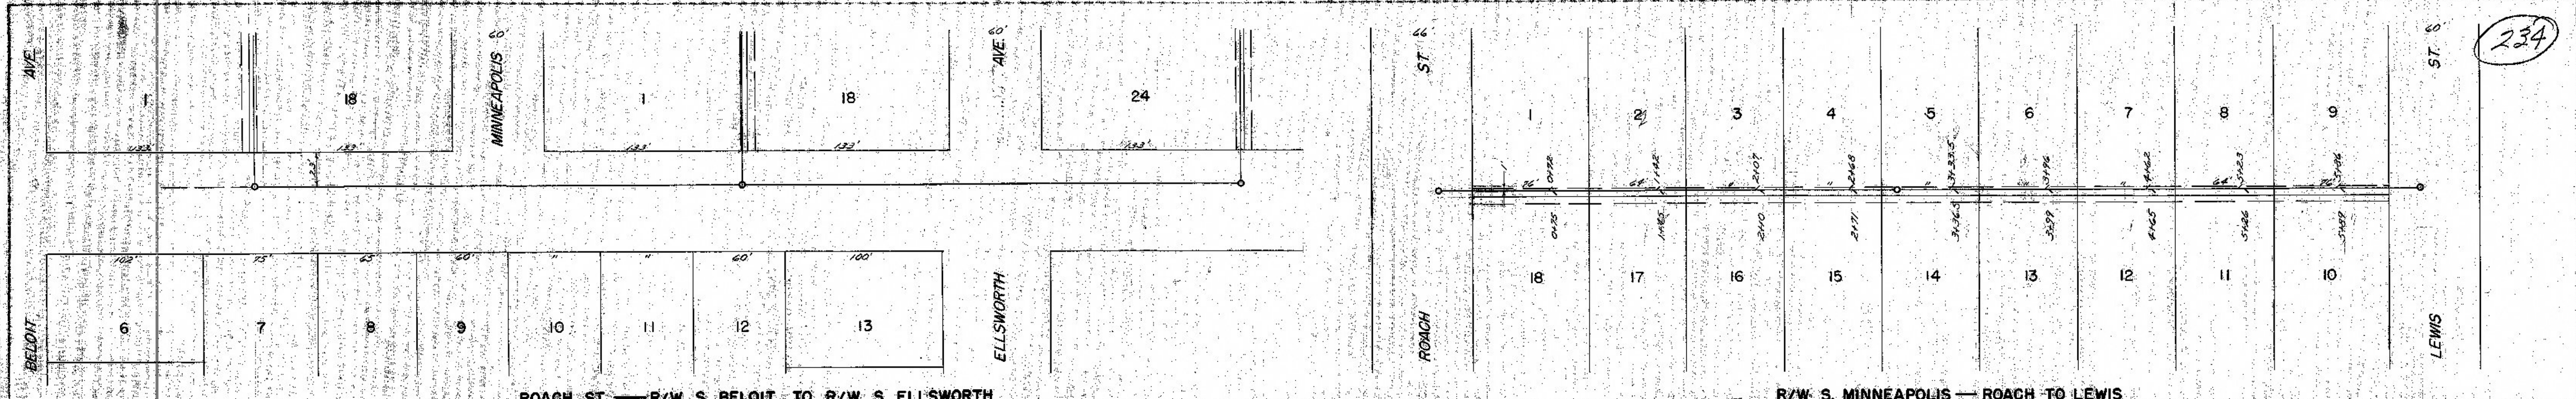


PLAN SURVEYED BY DATE
 NOTE BOOK GRADES CHECKED BY
 PLANNED BY
 E.C. OF W.A. CHECKED BY


PROFILE SURVEYED BY DATE
 NOTE BOOK GRADES CHECKED BY
 PLANNED BY
 E.C. OF W.A. CHECKED BY

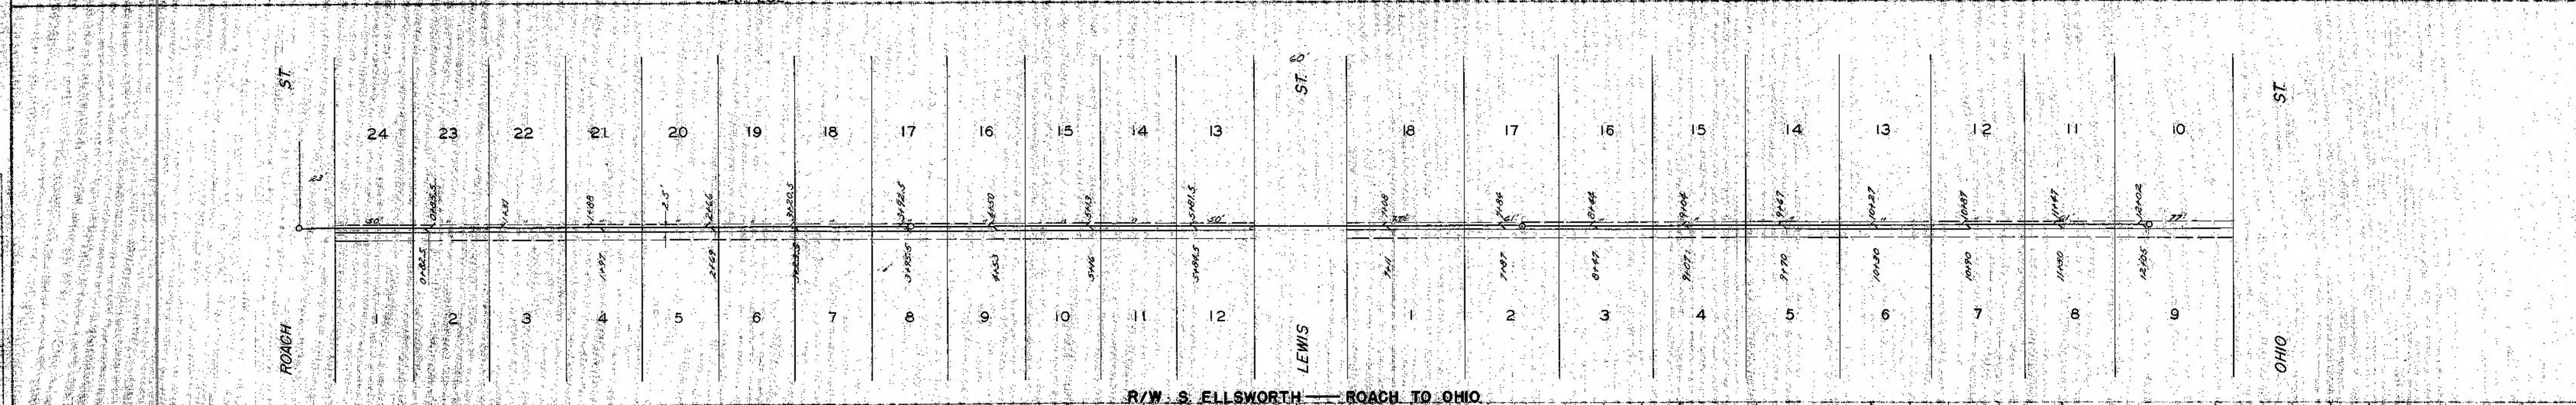

ROACH ST — R/W S. BELOIT TO R/W S. ELLSWORTH
 R/W S. MINNEAPOLIS — ROACH TO LEWIS

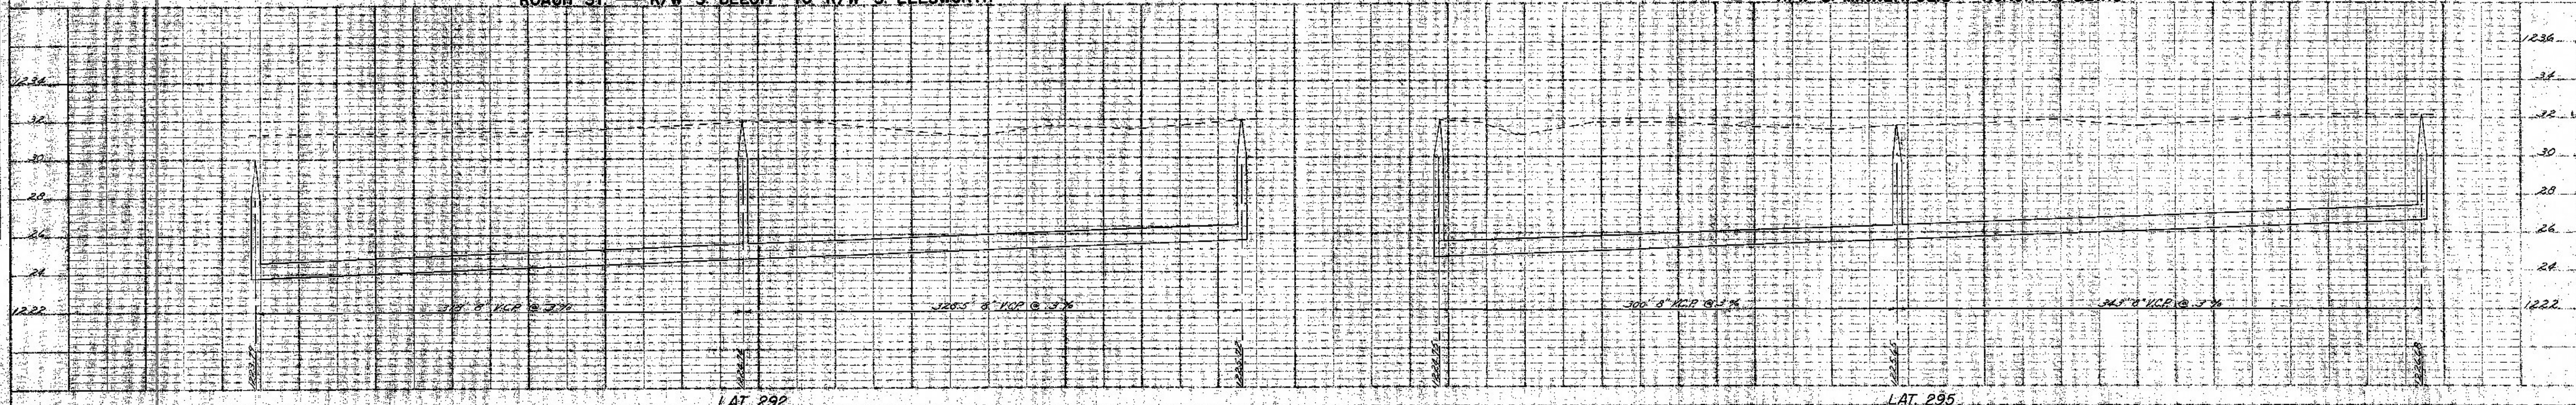

R/W S. ELLSWORTH — ROACH TO OHIO

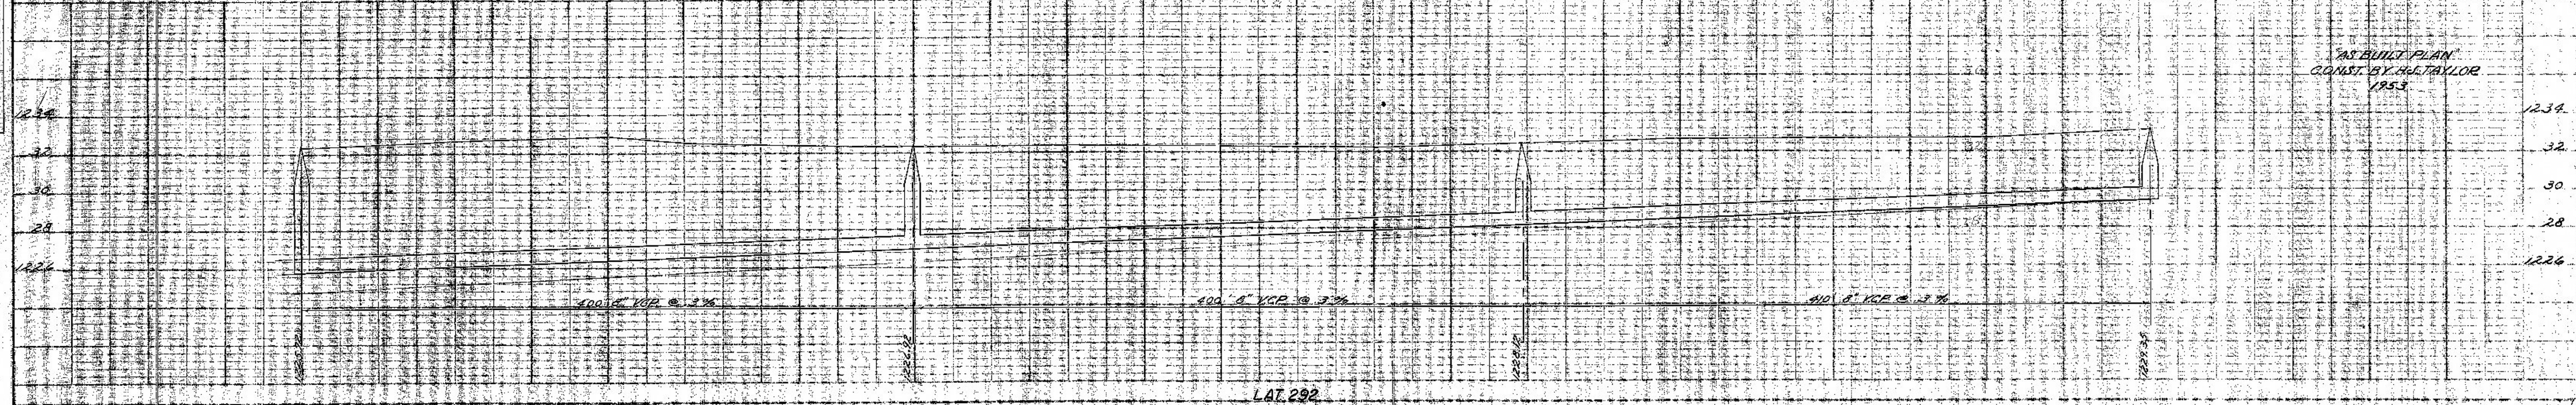

AS BUILT PLAN
 COMPILED BY H. TAYLOR
 1953