


PLAN
 SURVEYED BY _____ DATE _____
 PLOTTED BY _____
 NOTE BOOK ALIGNMENT CHECKED BY _____
 NO. _____

PROFILE
 SURVEYED BY _____ DATE _____
 PLOTTED BY _____
 NOTE BOOK GRADES CHECKED BY _____
 NO. _____

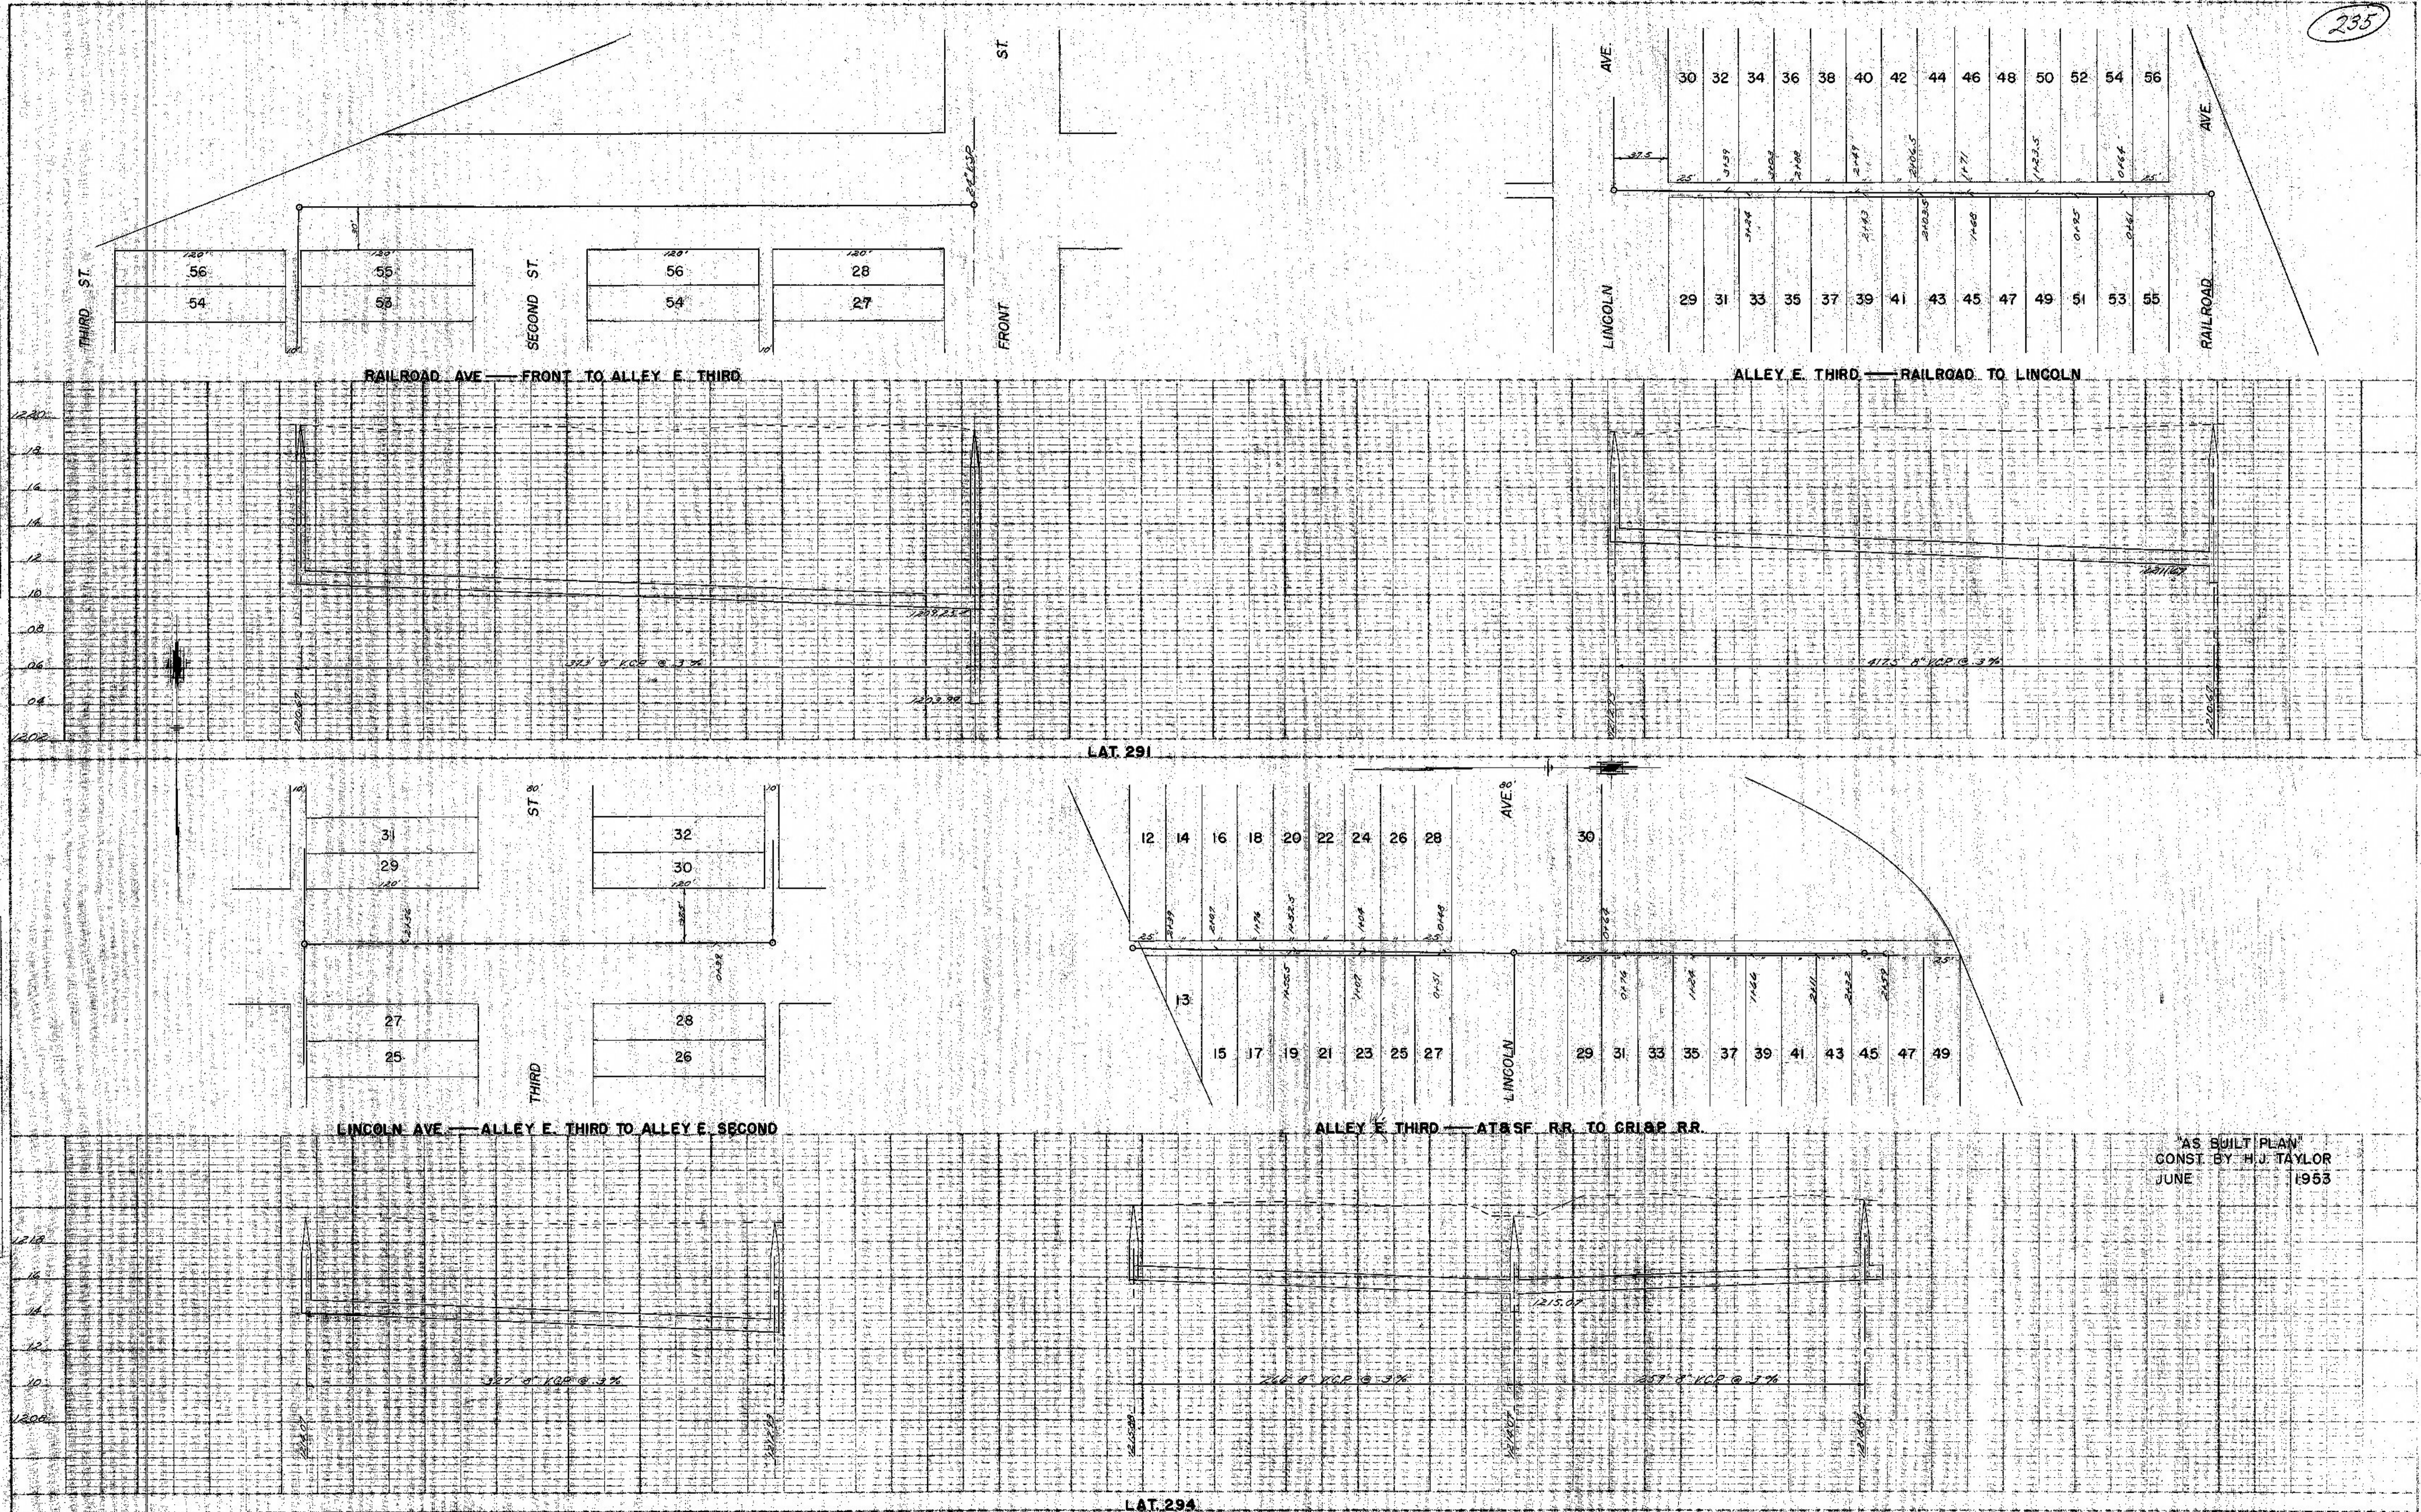

AS BUILT PLAN
 CONST. BY H. J. TAYLOR
 JUNE 1953