


Scale 1"=50'

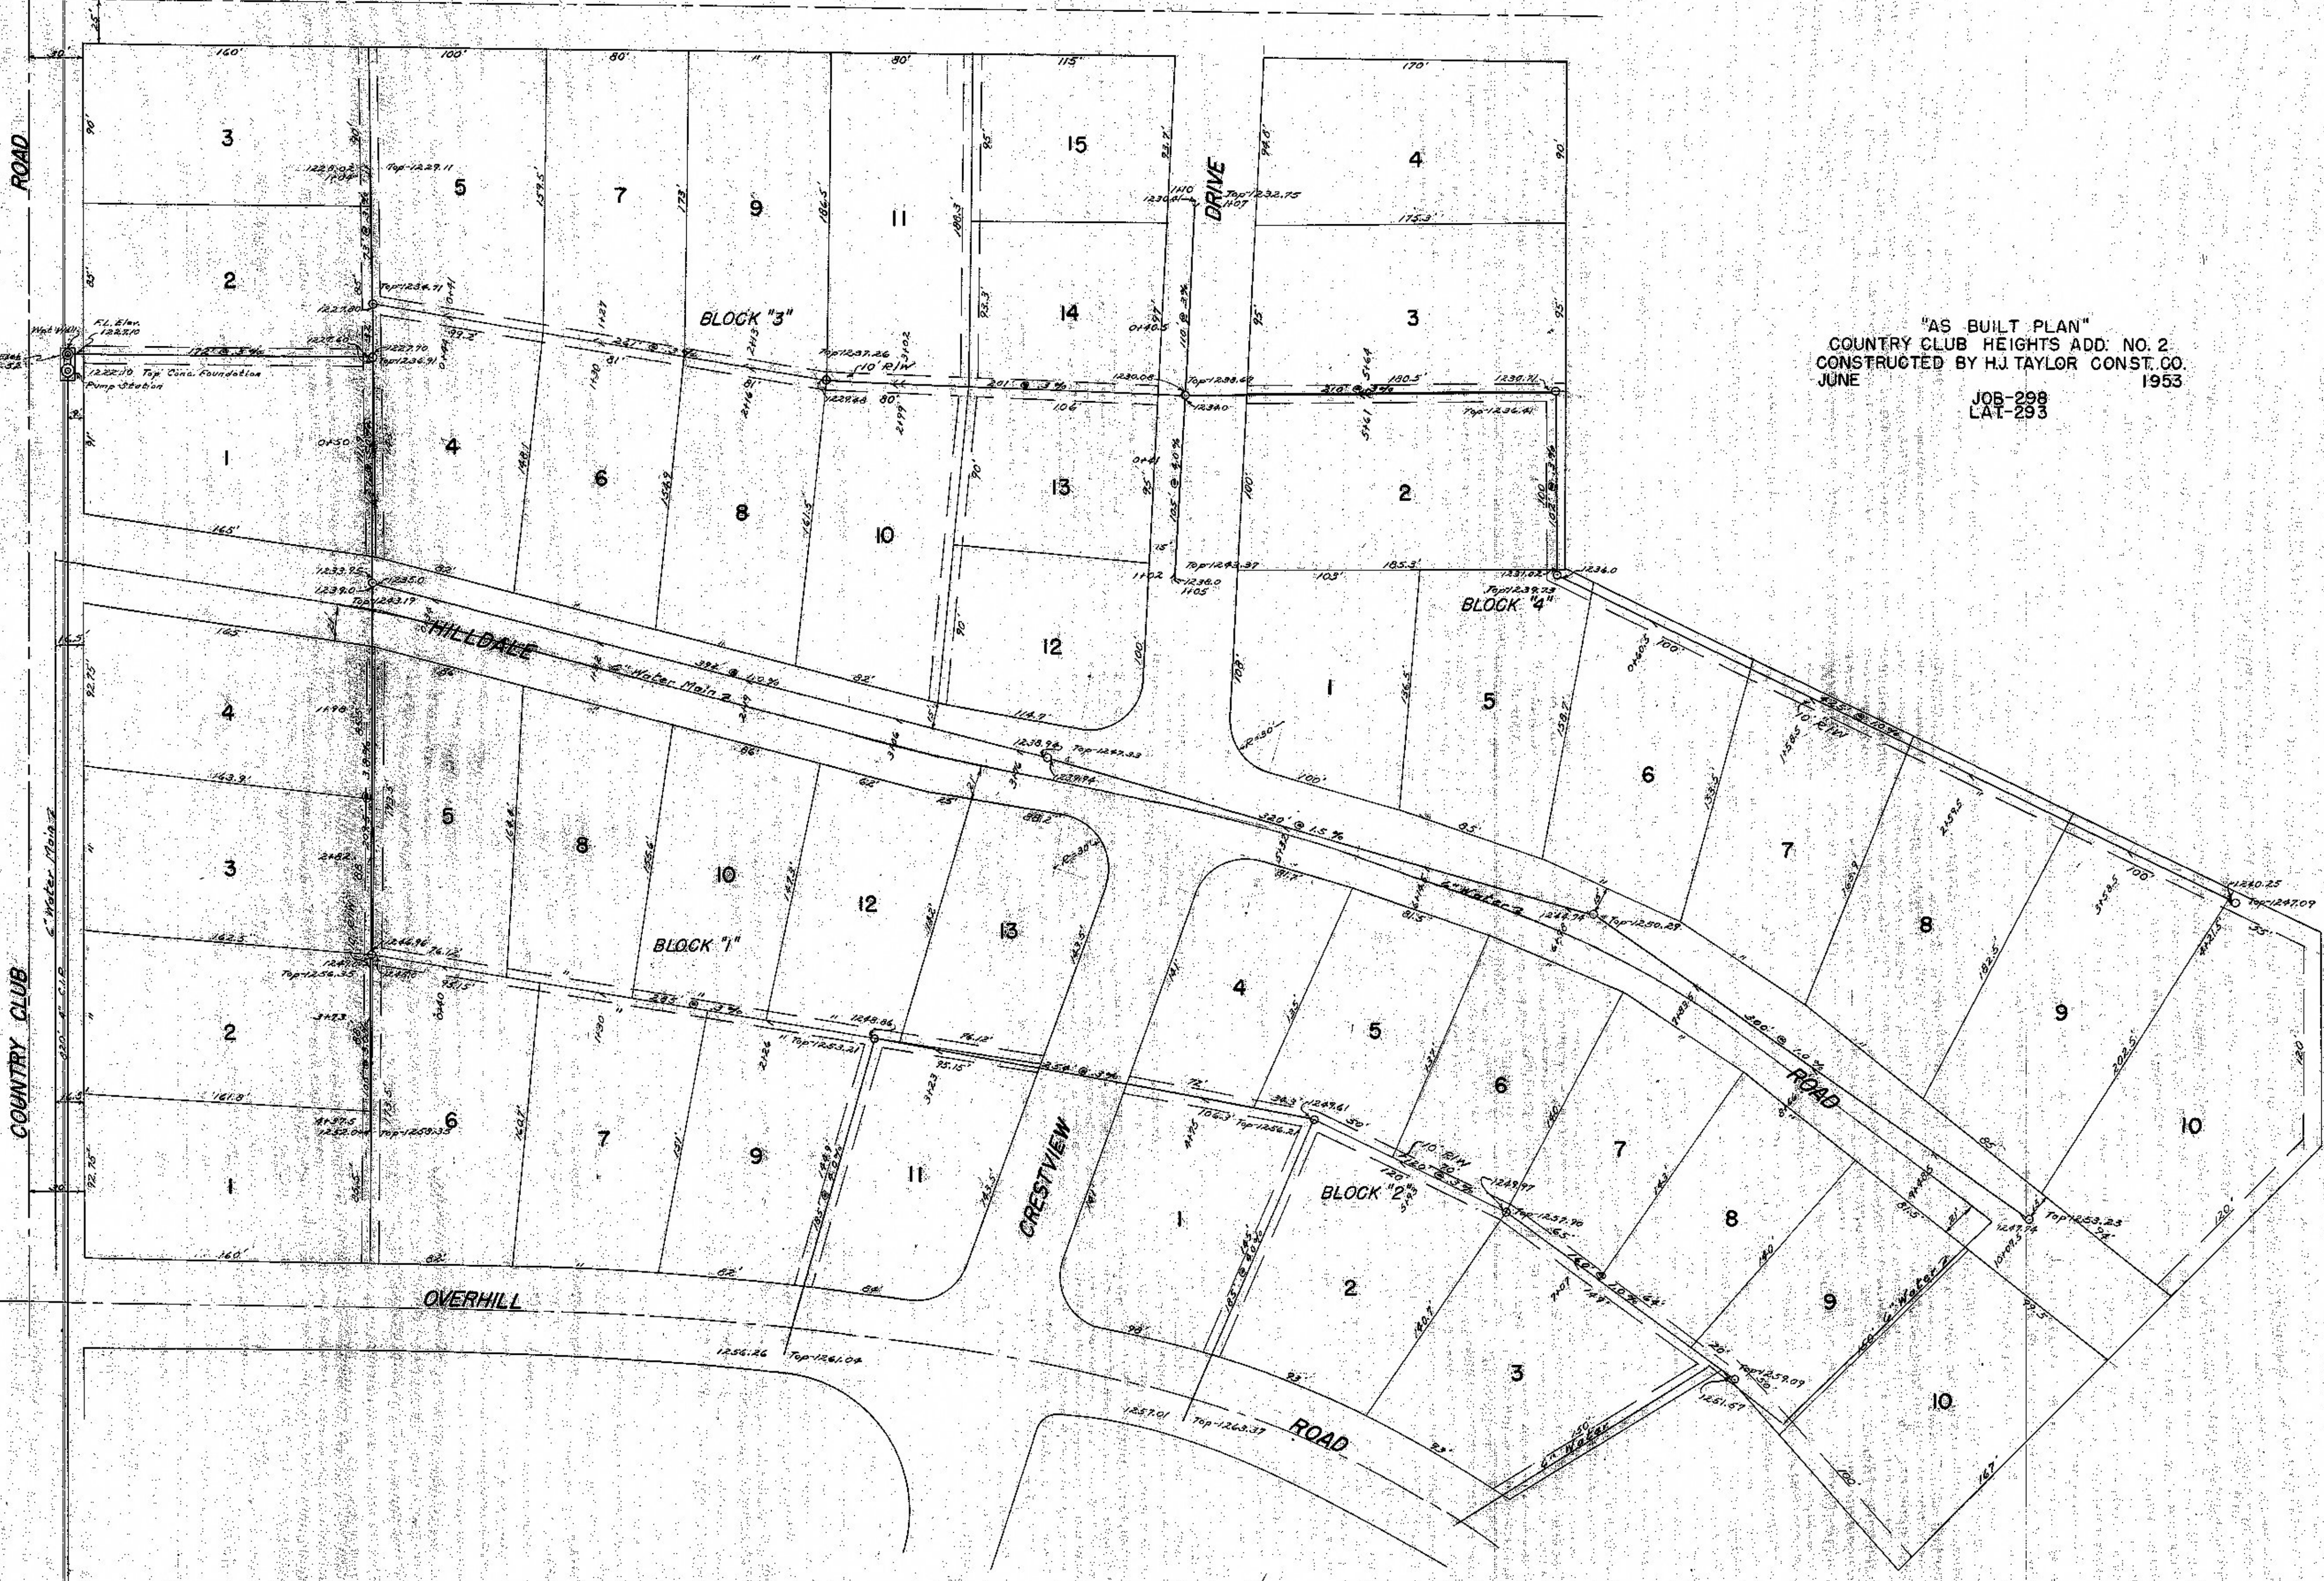

"AS BUILT PLAN"
 COUNTRY CLUB HEIGHTS ADD. NO. 2
 CONSTRUCTED BY H.J. TAYLOR CONST. CO.
 JUNE 1953
 JOB-298
 LAT-293

ROAD

DRIVE

BLOCK "3"

BLOCK "4"

HILDALE

BLOCK "1"

CRESTVIEW

BLOCK "2"

ROAD

OVERHILL

ROAD

COUNTRY CLUB

