

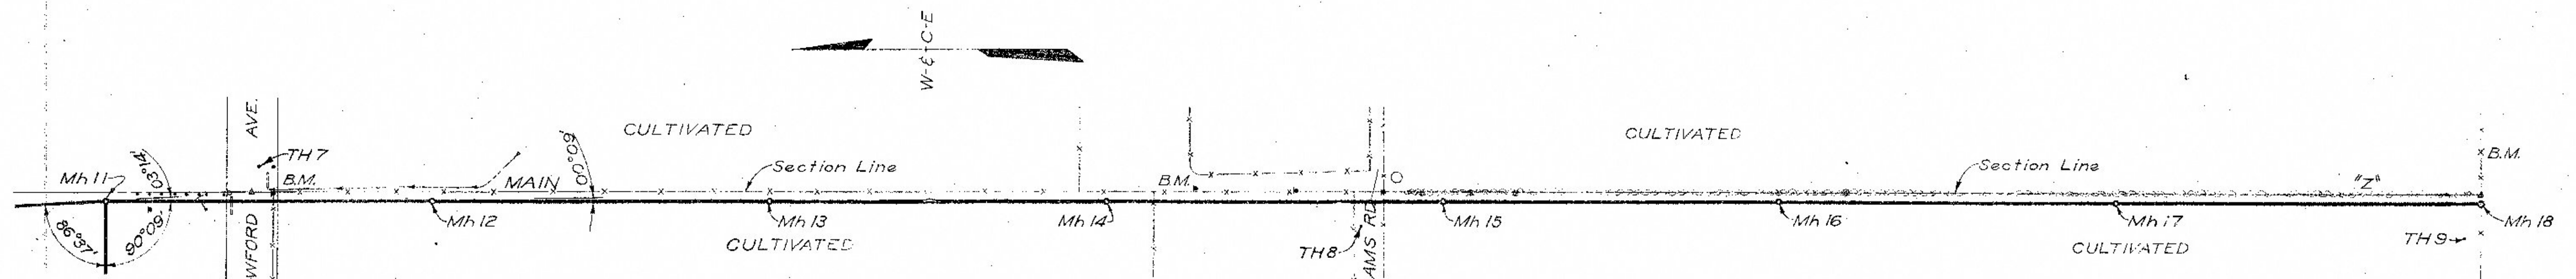


NO.	DATE	BY	CHKD.
1			
2			
3			
4			
5			
6			
7			
8			
9			
10			

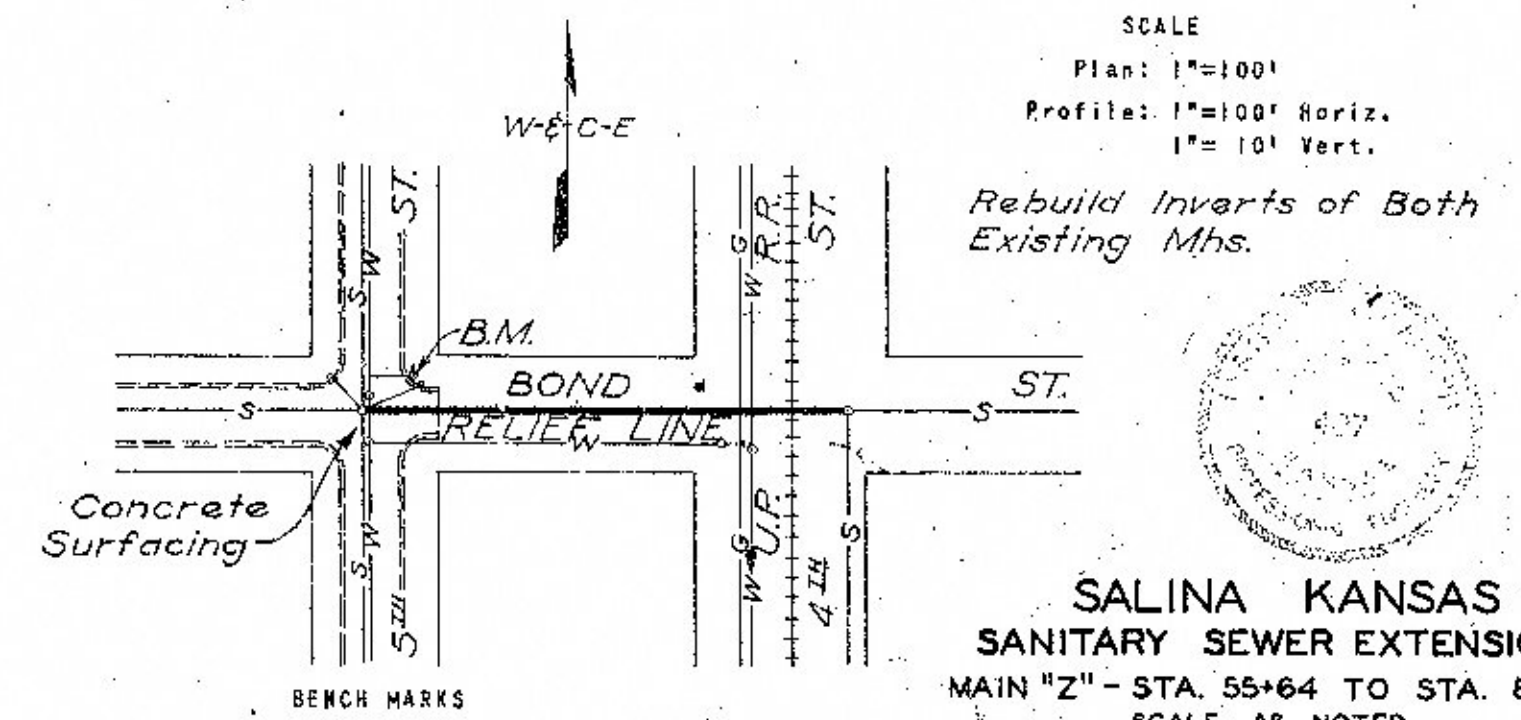

BENCH MARKS
 Spike in Power Pole S. of Crawford & Ohio Ave. & Extension. Elev. 1225.78
 Spike in 2nd Power Pole N. of McAdams & Ohio Ave. & Extension. Elev. 1234.06
 Top of Conc. Ref. Marker 50' E. of 1/4 Cor. Pin at Int. of Republic Avenue & Extension & Ohio Ave. & Extension. Elev. 1228.18

NO.	DATE	BY	CHKD.
1			
2			
3			
4			
5			
6			
7			
8			
9			
10			

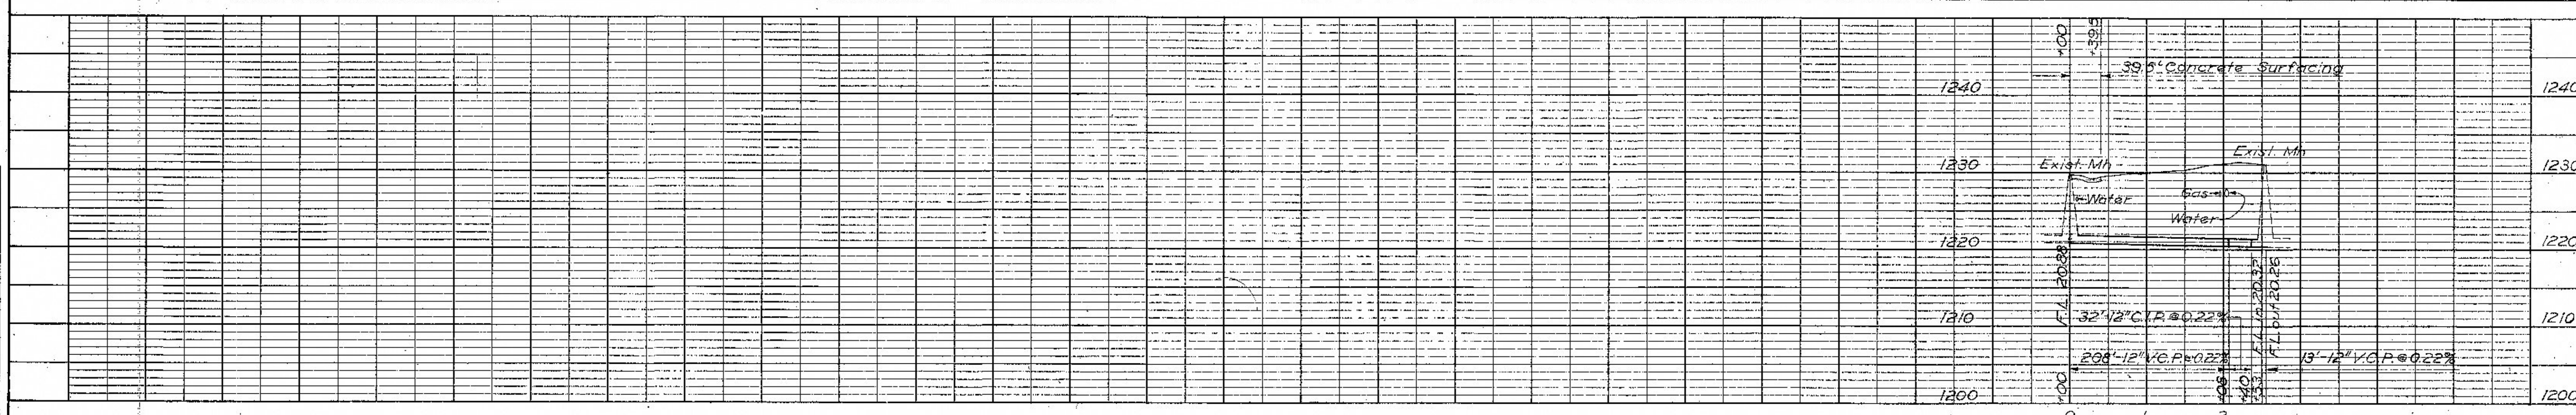

NOTE:
 Where existing water mains parallel sewer lines, the minimum distance between C's to be 10' if right of way permits.

NOTE:
 For Legend see Sheet No. 5

SCALE
 Plan: 1"=100'
 Profile: 1"=100' Horiz.
 1"=10' Vert.

Rebuild Inverts of Both Existing Mhs.

SALINA KANSAS
SANITARY SEWER EXTENSIONS
 MAIN "Z" - STA. 55+64 TO STA. 83+89
 SCALE AS NOTED
WILSON AND COMPANY
 ENGINEERS
 SALINA KANSAS
 1952