


243

DATE: _____
 DRAWN BY: _____
 CHECKED BY: _____
 DATE: _____
 NO. _____


DATE: _____
 DRAWN BY: _____
 CHECKED BY: _____
 DATE: _____
 NO. _____

PLAN



PROFILE

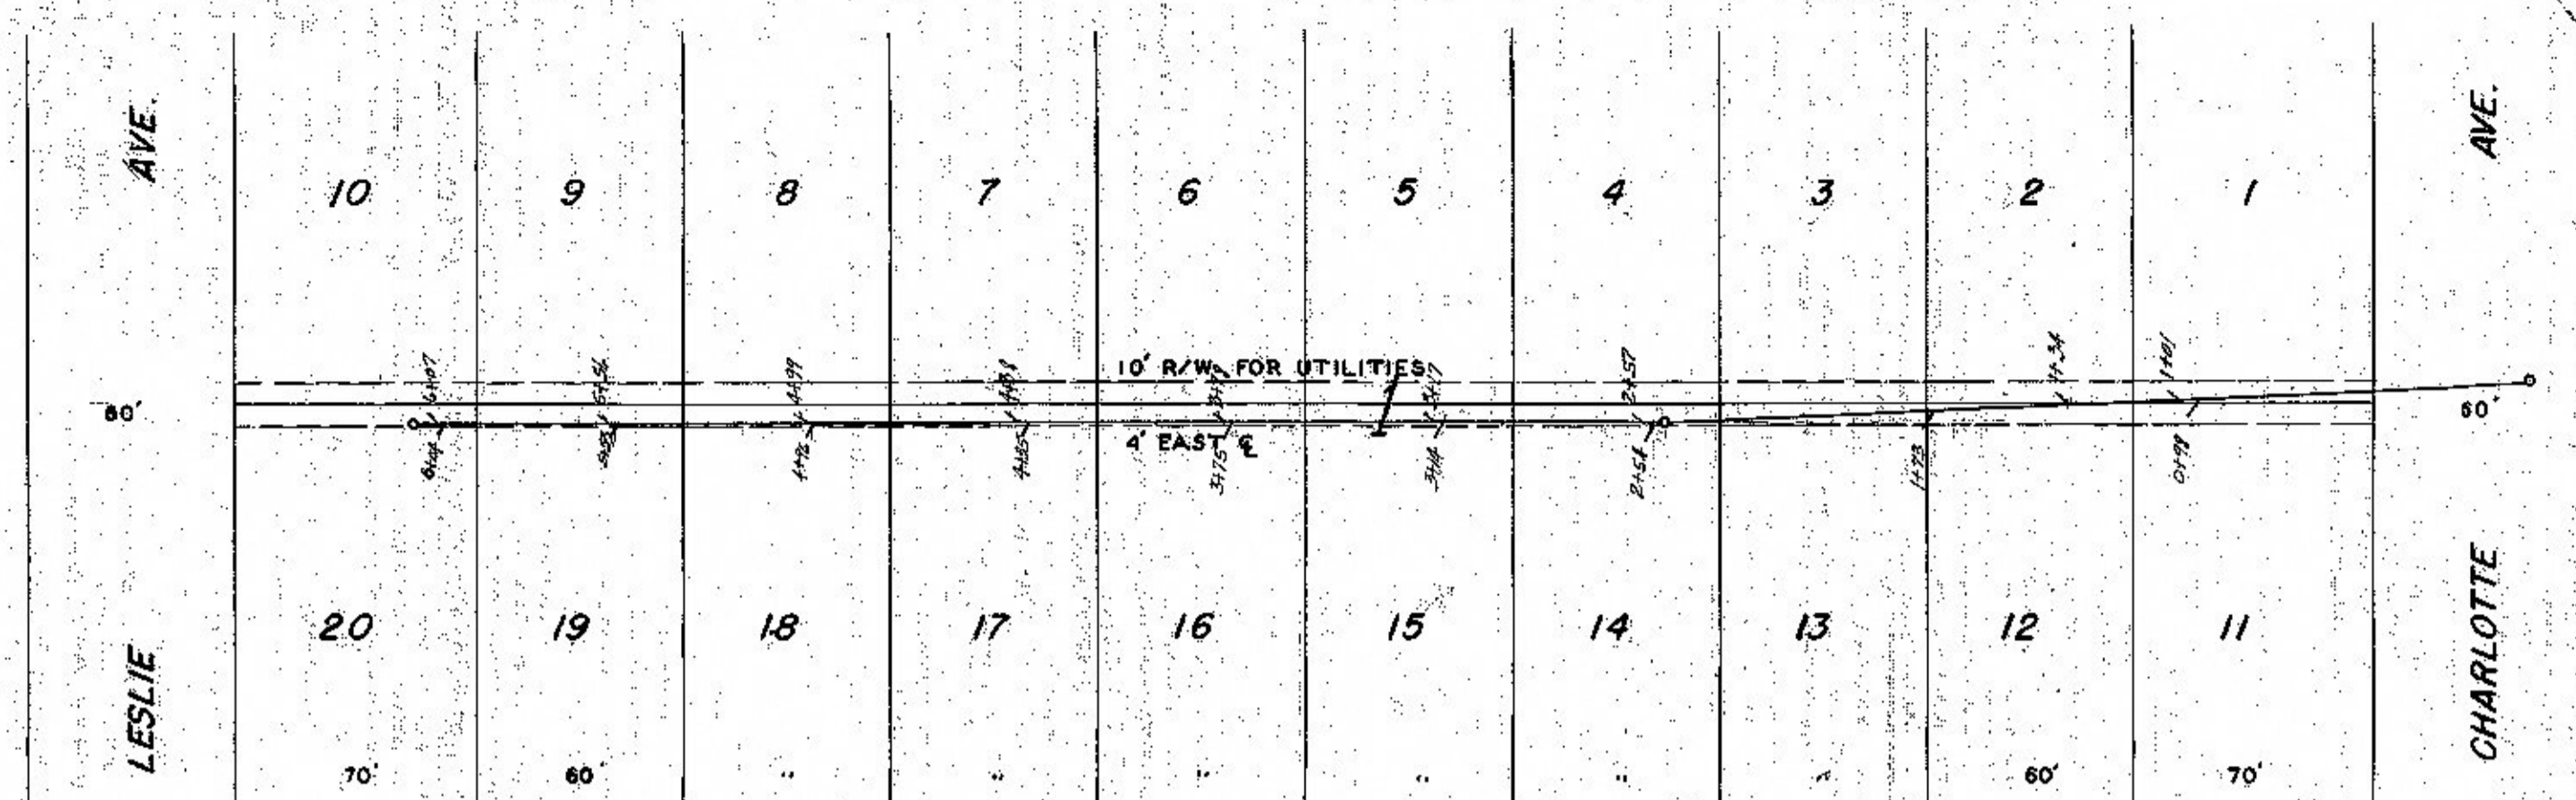

R/W E. NINTH STREET PLACE — CHARLOTTE TO LESLIE

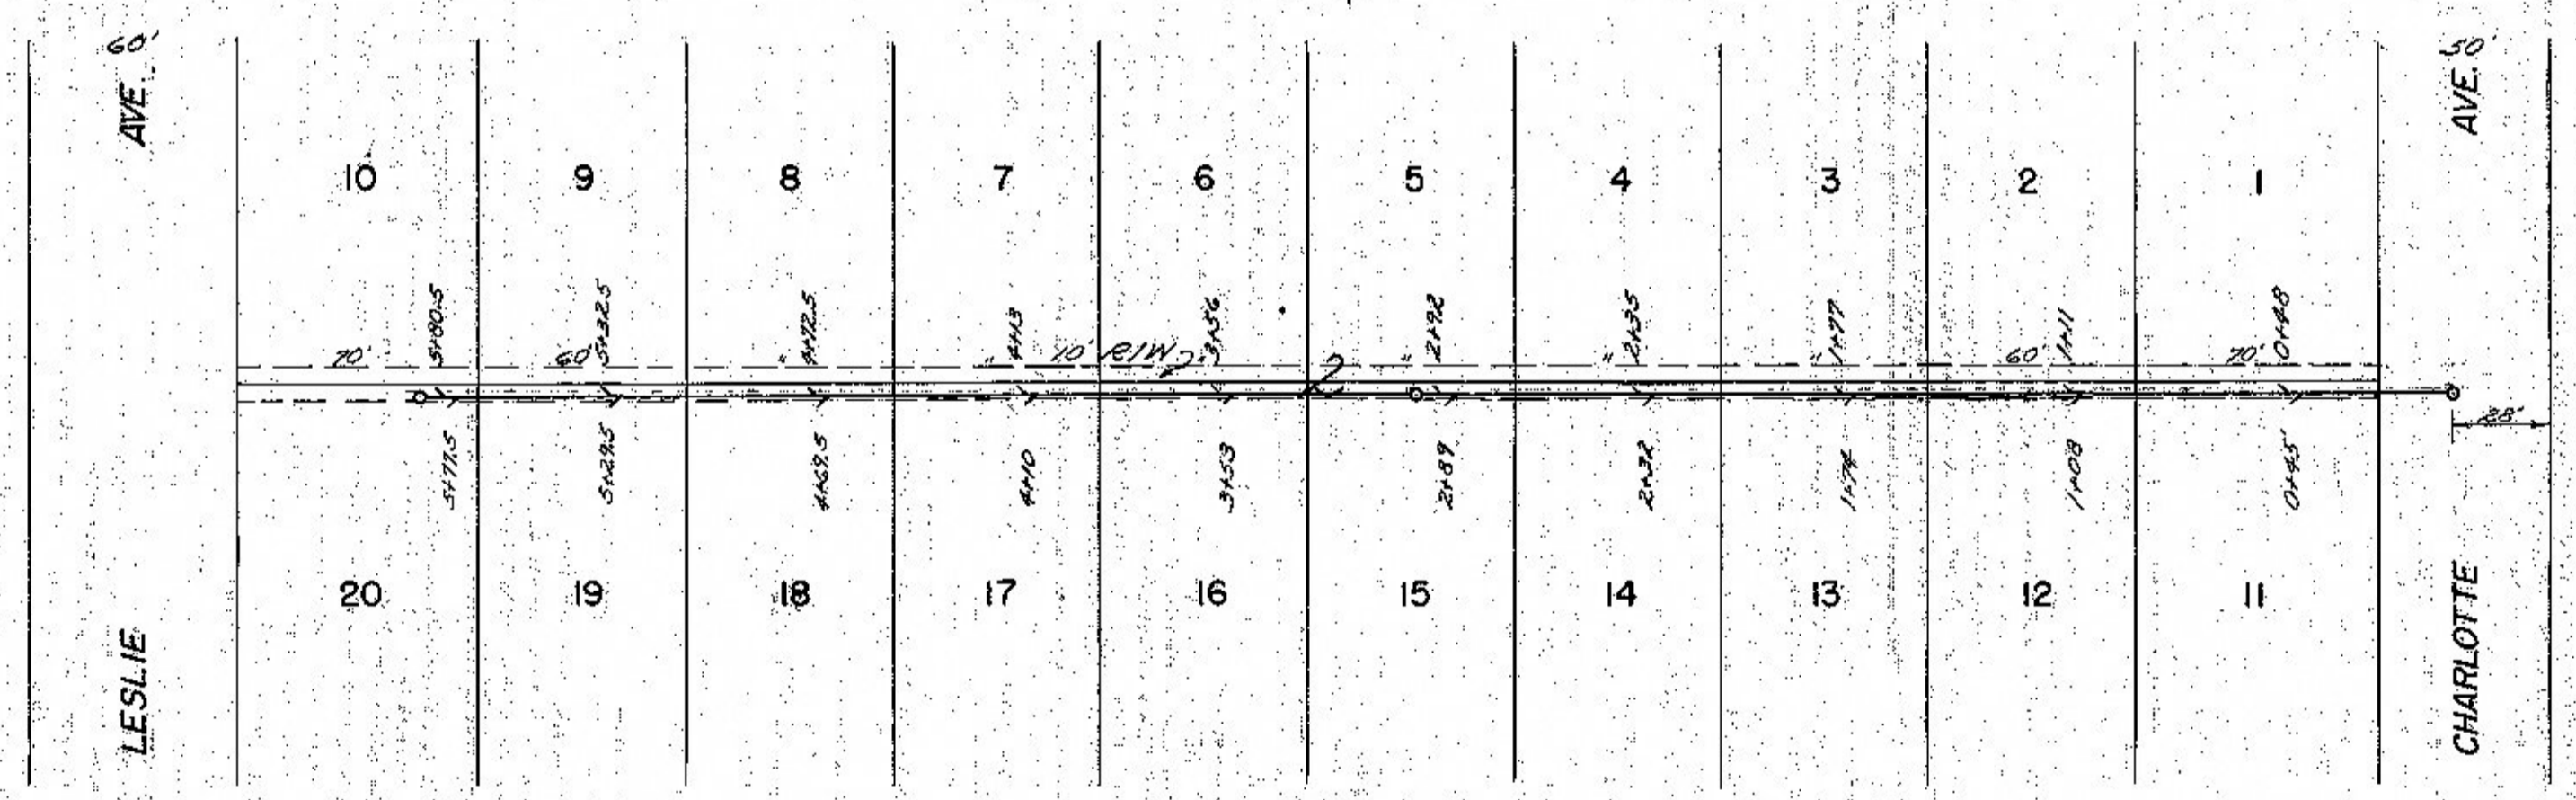

R/W E. HIGHLAND AVE — CHARLOTTE TO LESLIE

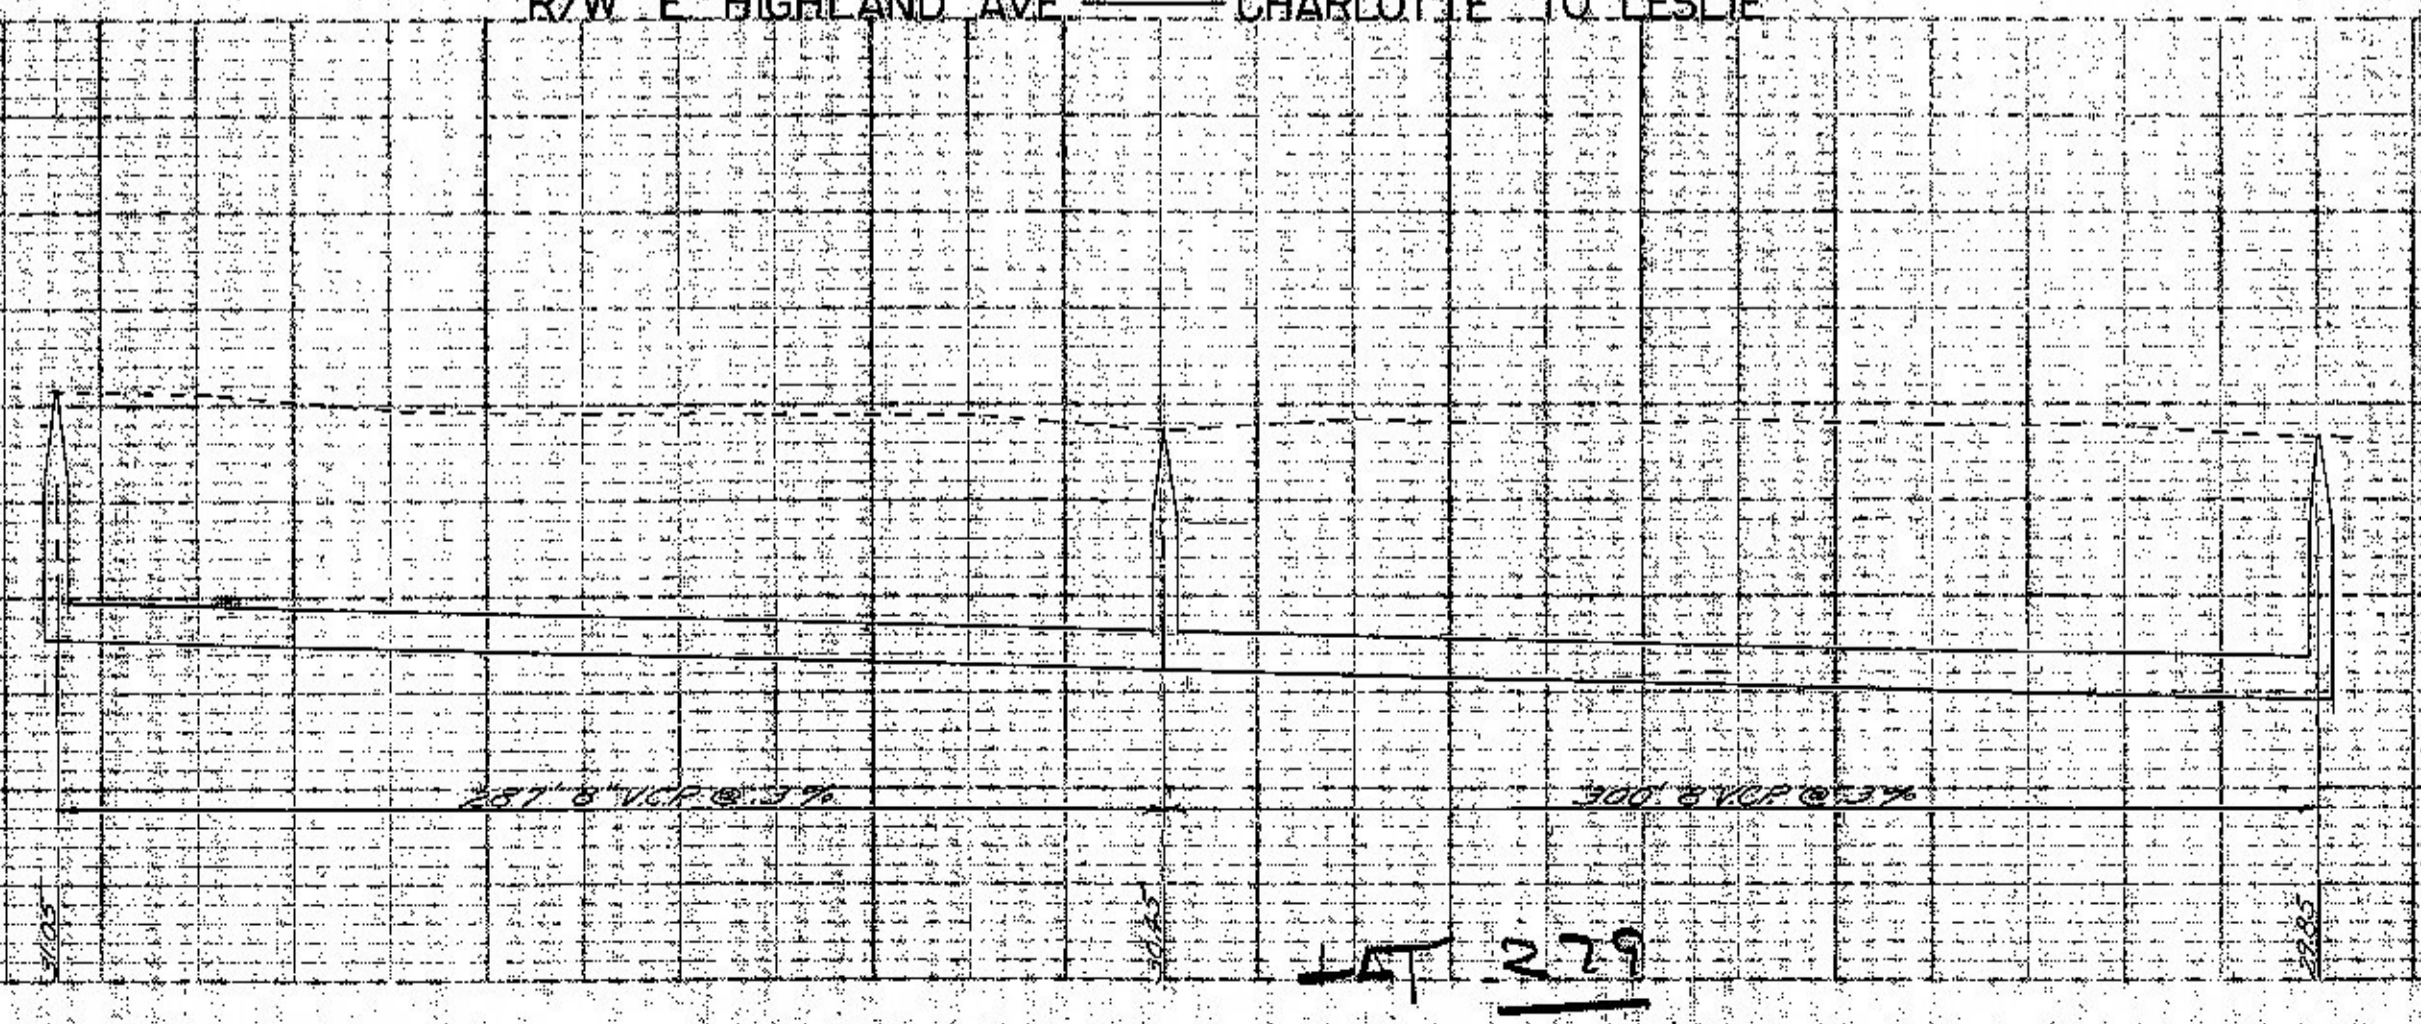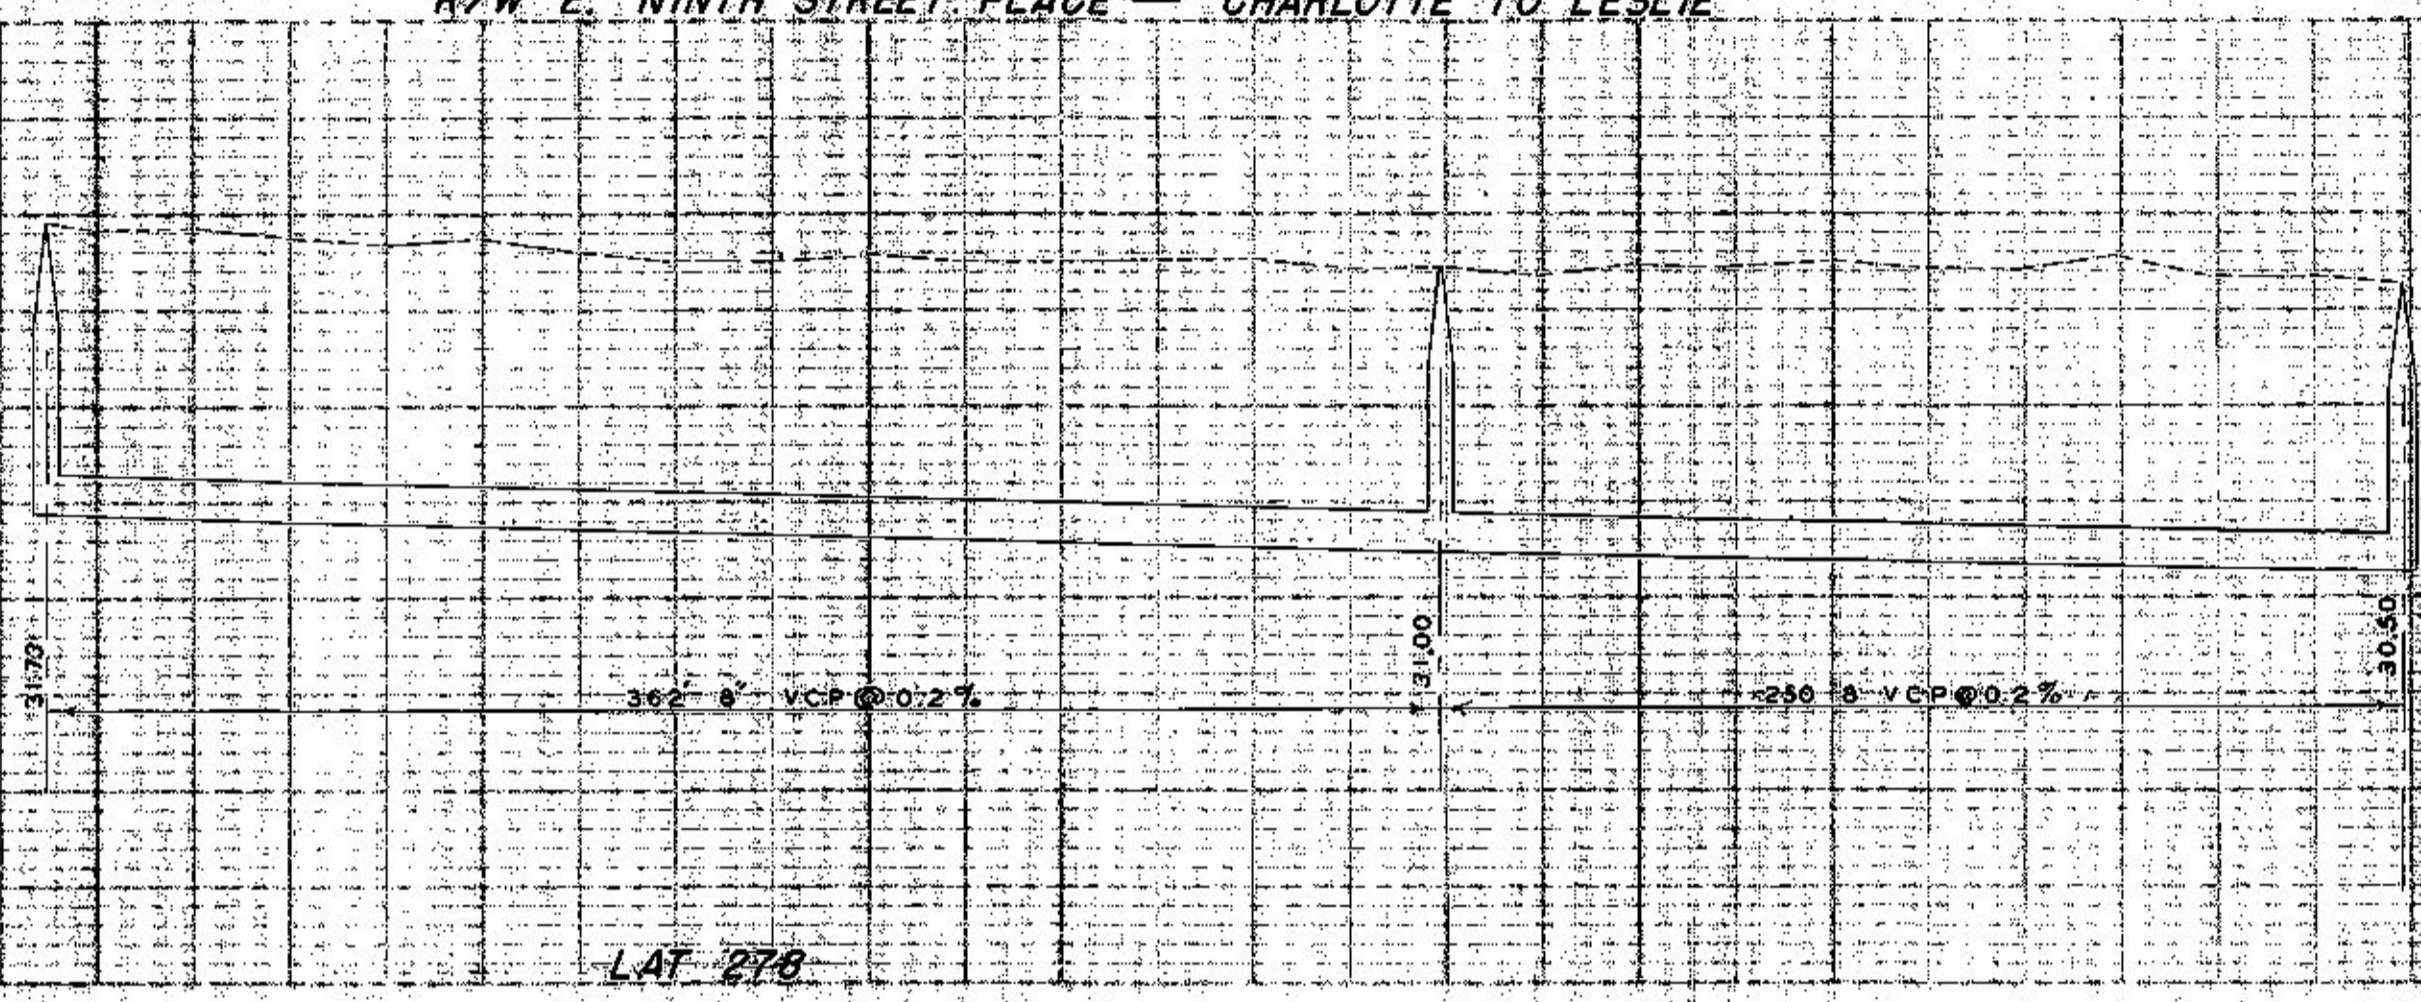

CR