

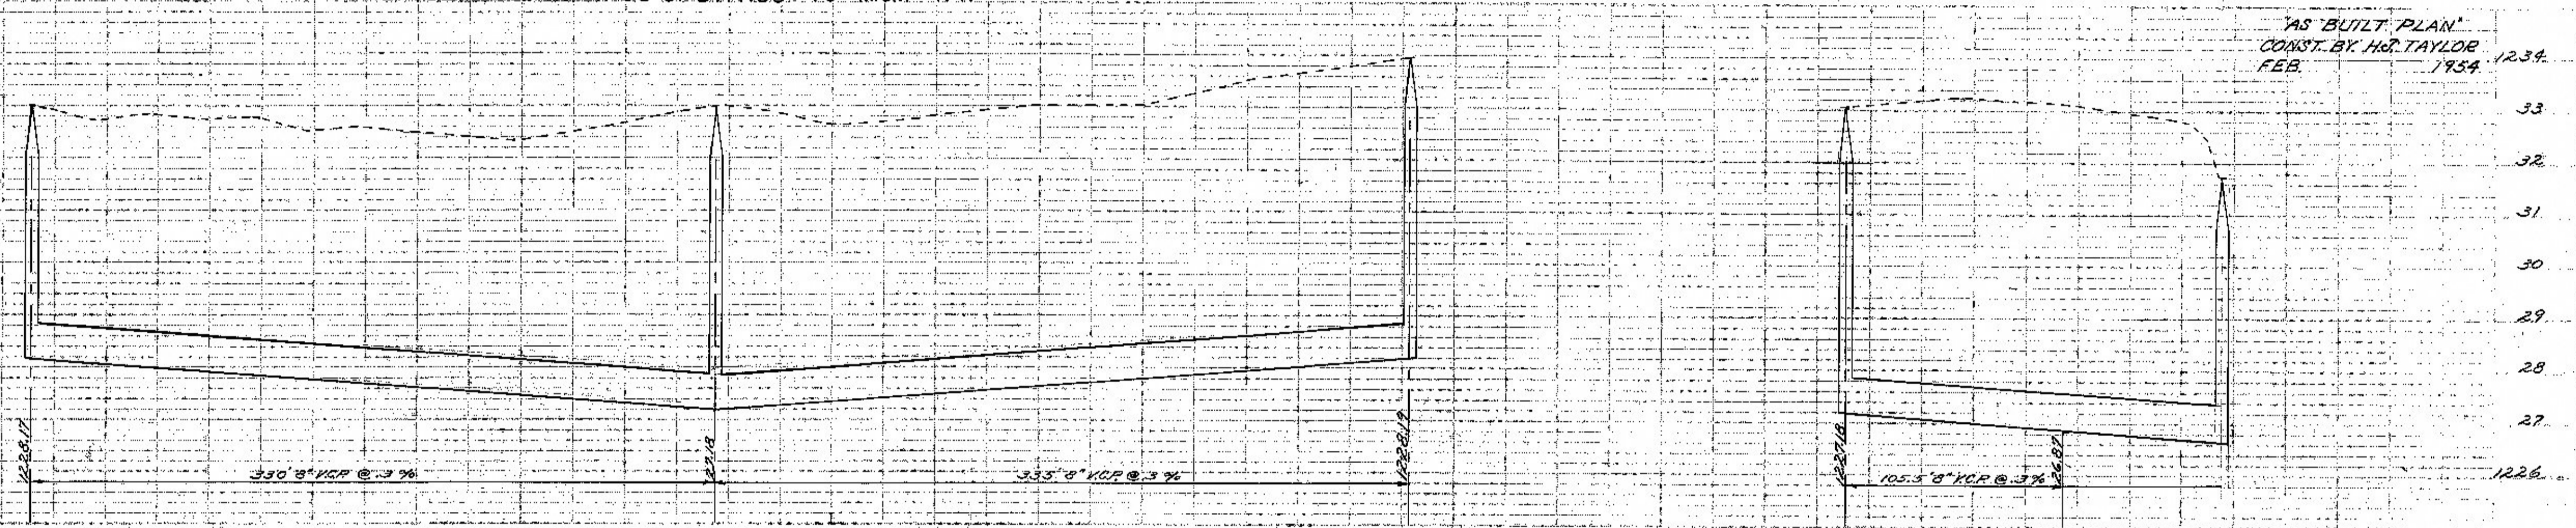
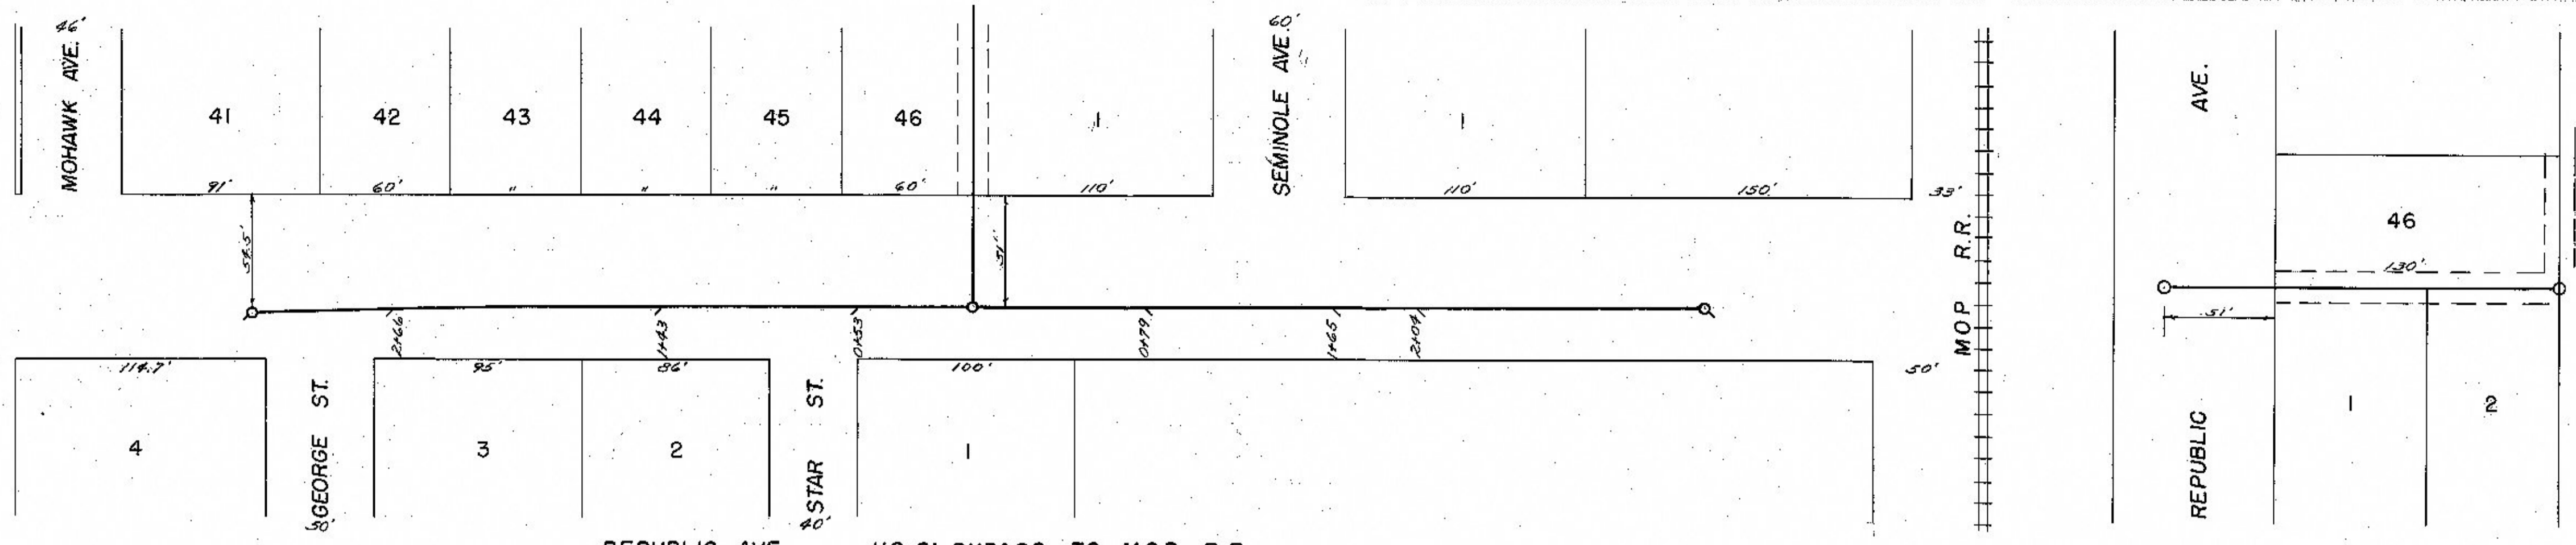


PLAN
 SURVEYED BY
 DATE
 SCALE
 CORRECTIONS
 BY
 DATE

PROFILE
 SURVEYED BY
 DATE
 SCALE
 CORRECTIONS
 BY
 DATE

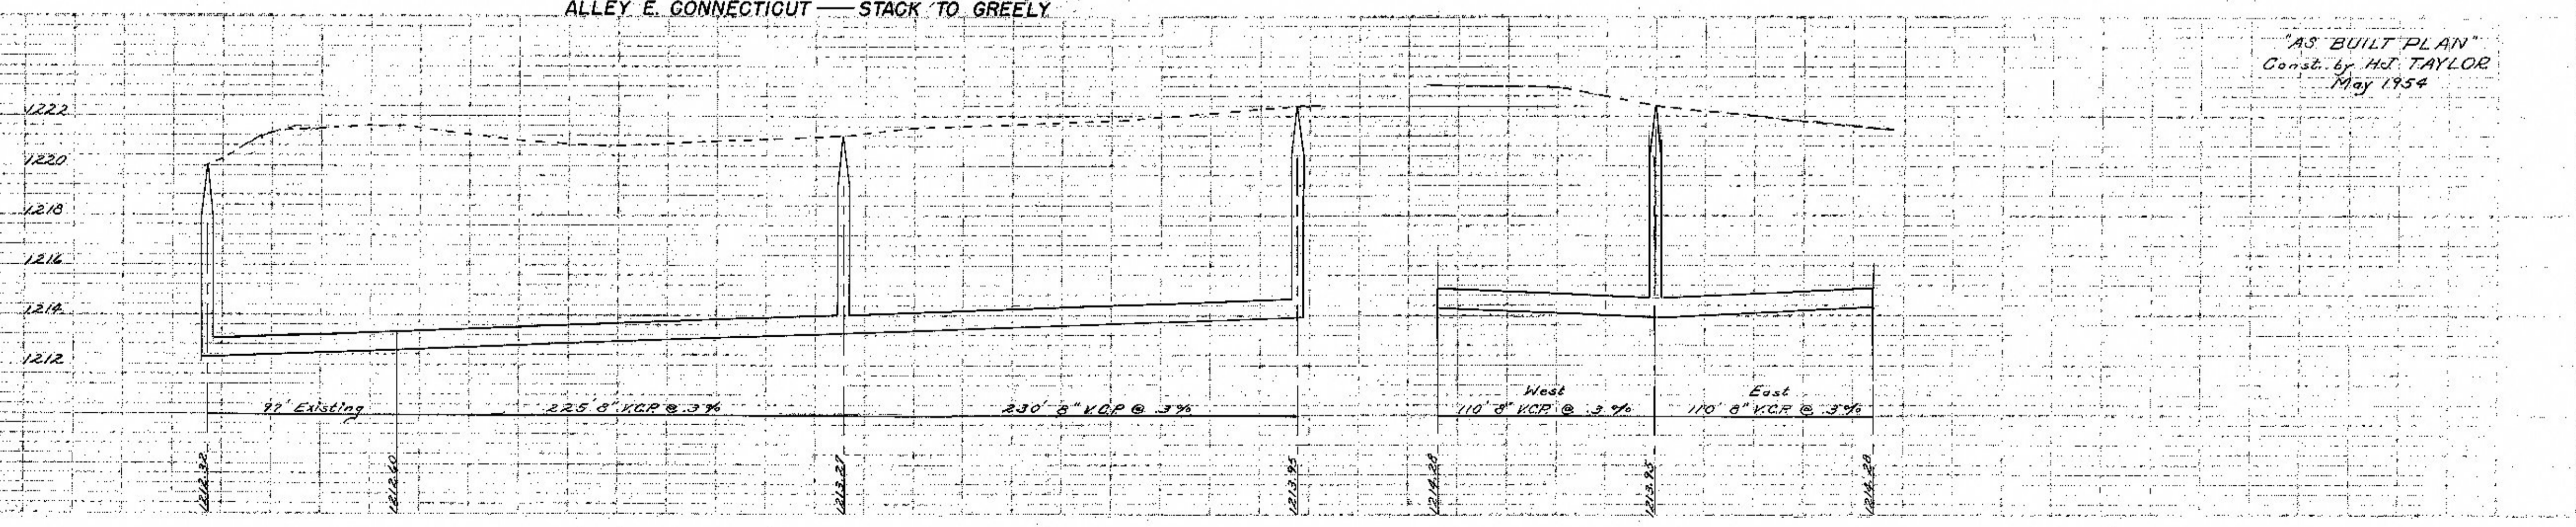

Lot 297

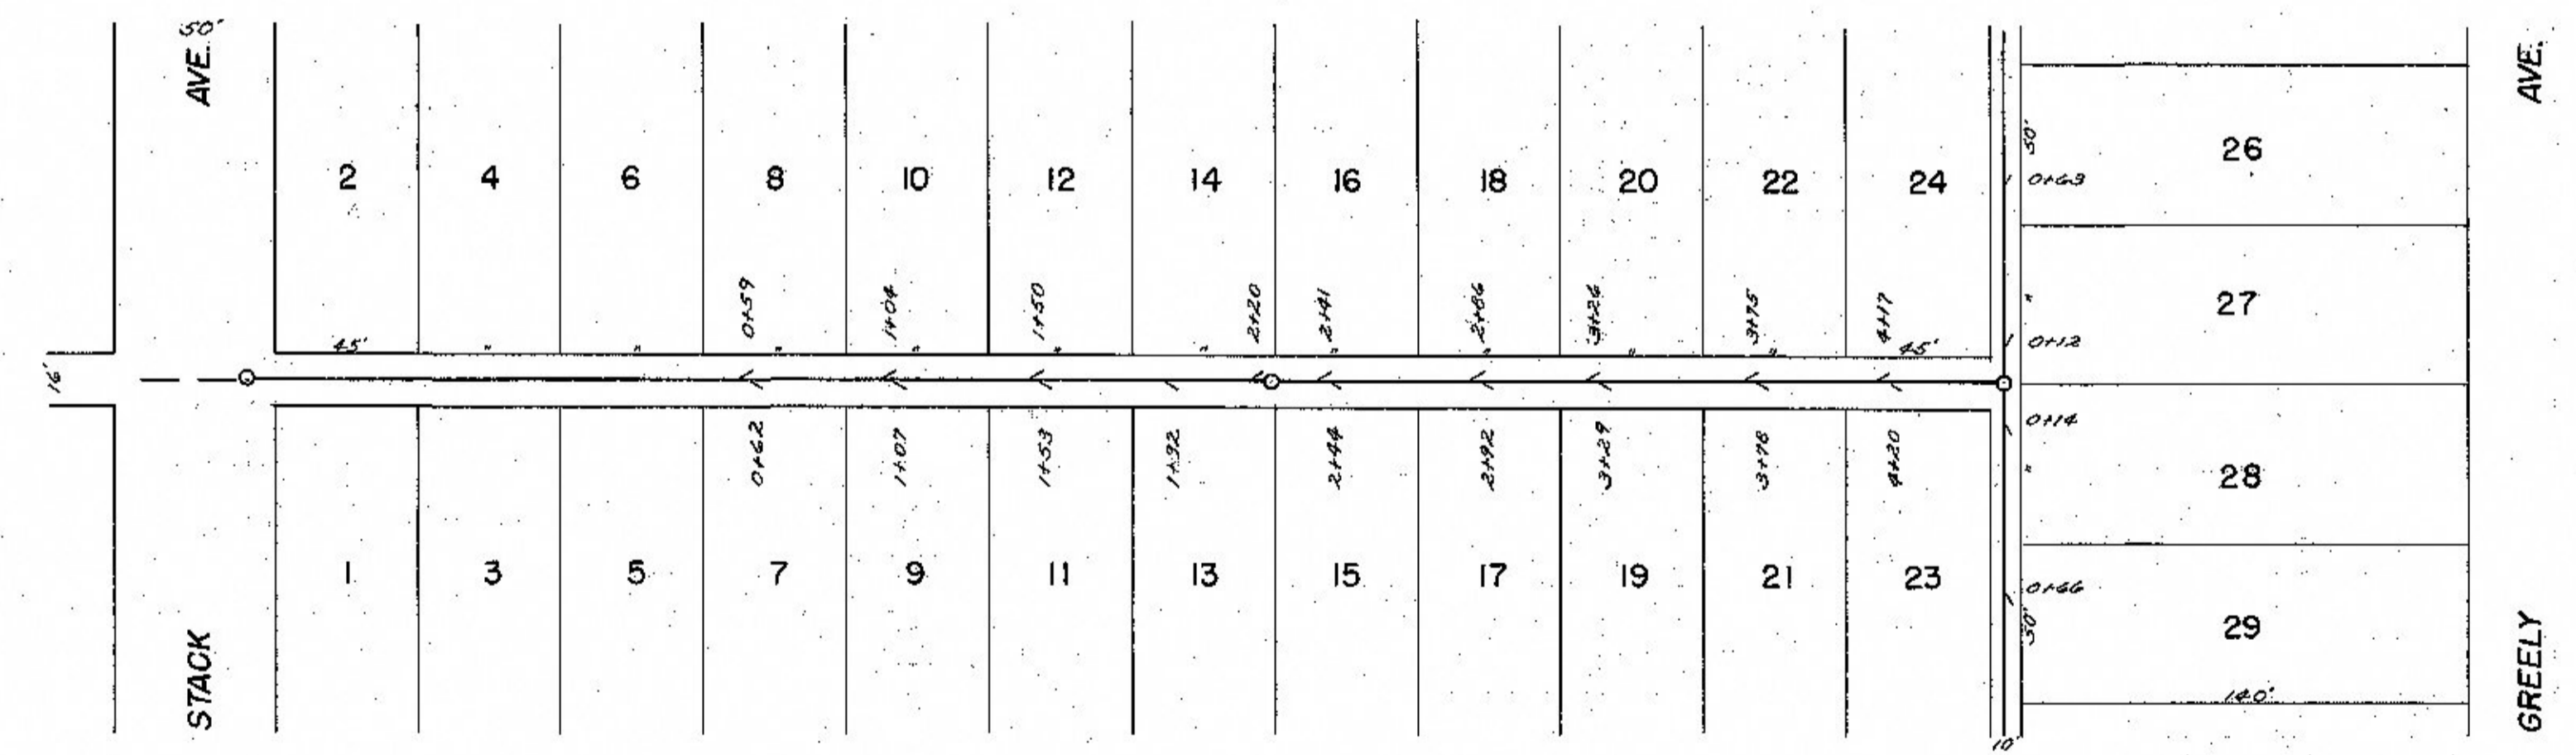

Lot 301