


248

PLAN

SURVEYED	DATE
PLOTTED	BY
NOTES CHECKED	
BY	
NO.	

PROFILE

SURVEYED	DATE
PLOTTED	BY
NOTES CHECKED	
BY	
NO.	

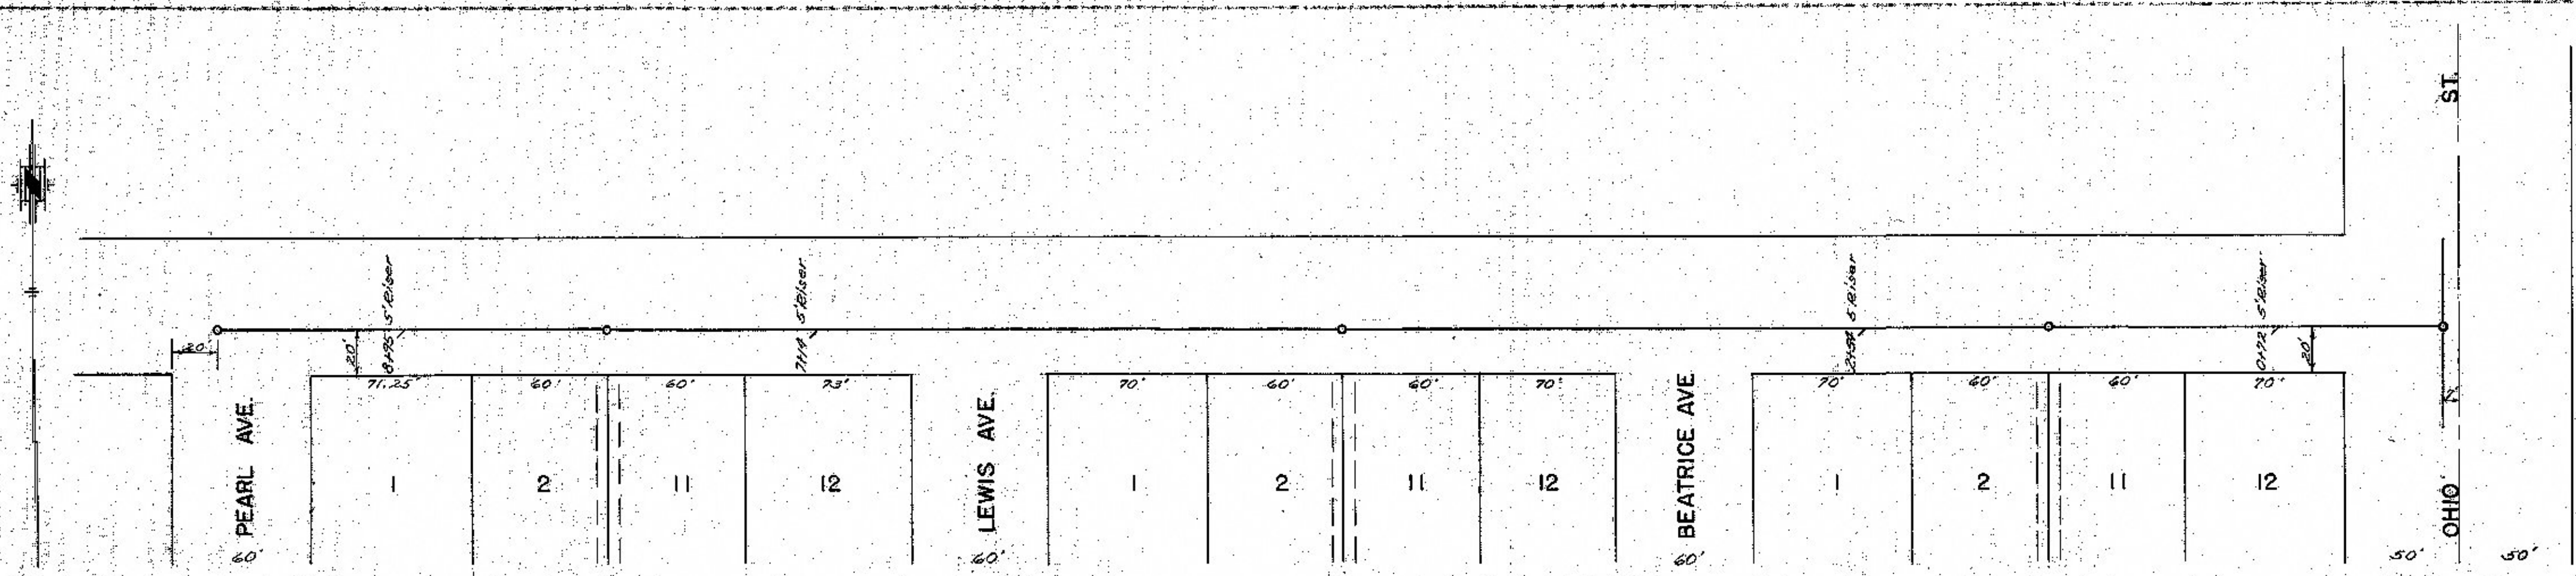

MADAM ROAD — OHIO ST. TO PEARL AVE.

