


PLAN	SURVEYED	DATE
NOTE BOOK	PLOTTED	
NO.	ALIGNMENT CHECKED	
	BY	
	NO. OF SHEETS	
	CHECKED	
	BY	



PROFILE	SURVEYED	DATE
NOTE BOOK	GRADES CHECKED	
NO.	STRUCTURE NOTATION	
	CHECKED	
	BY	

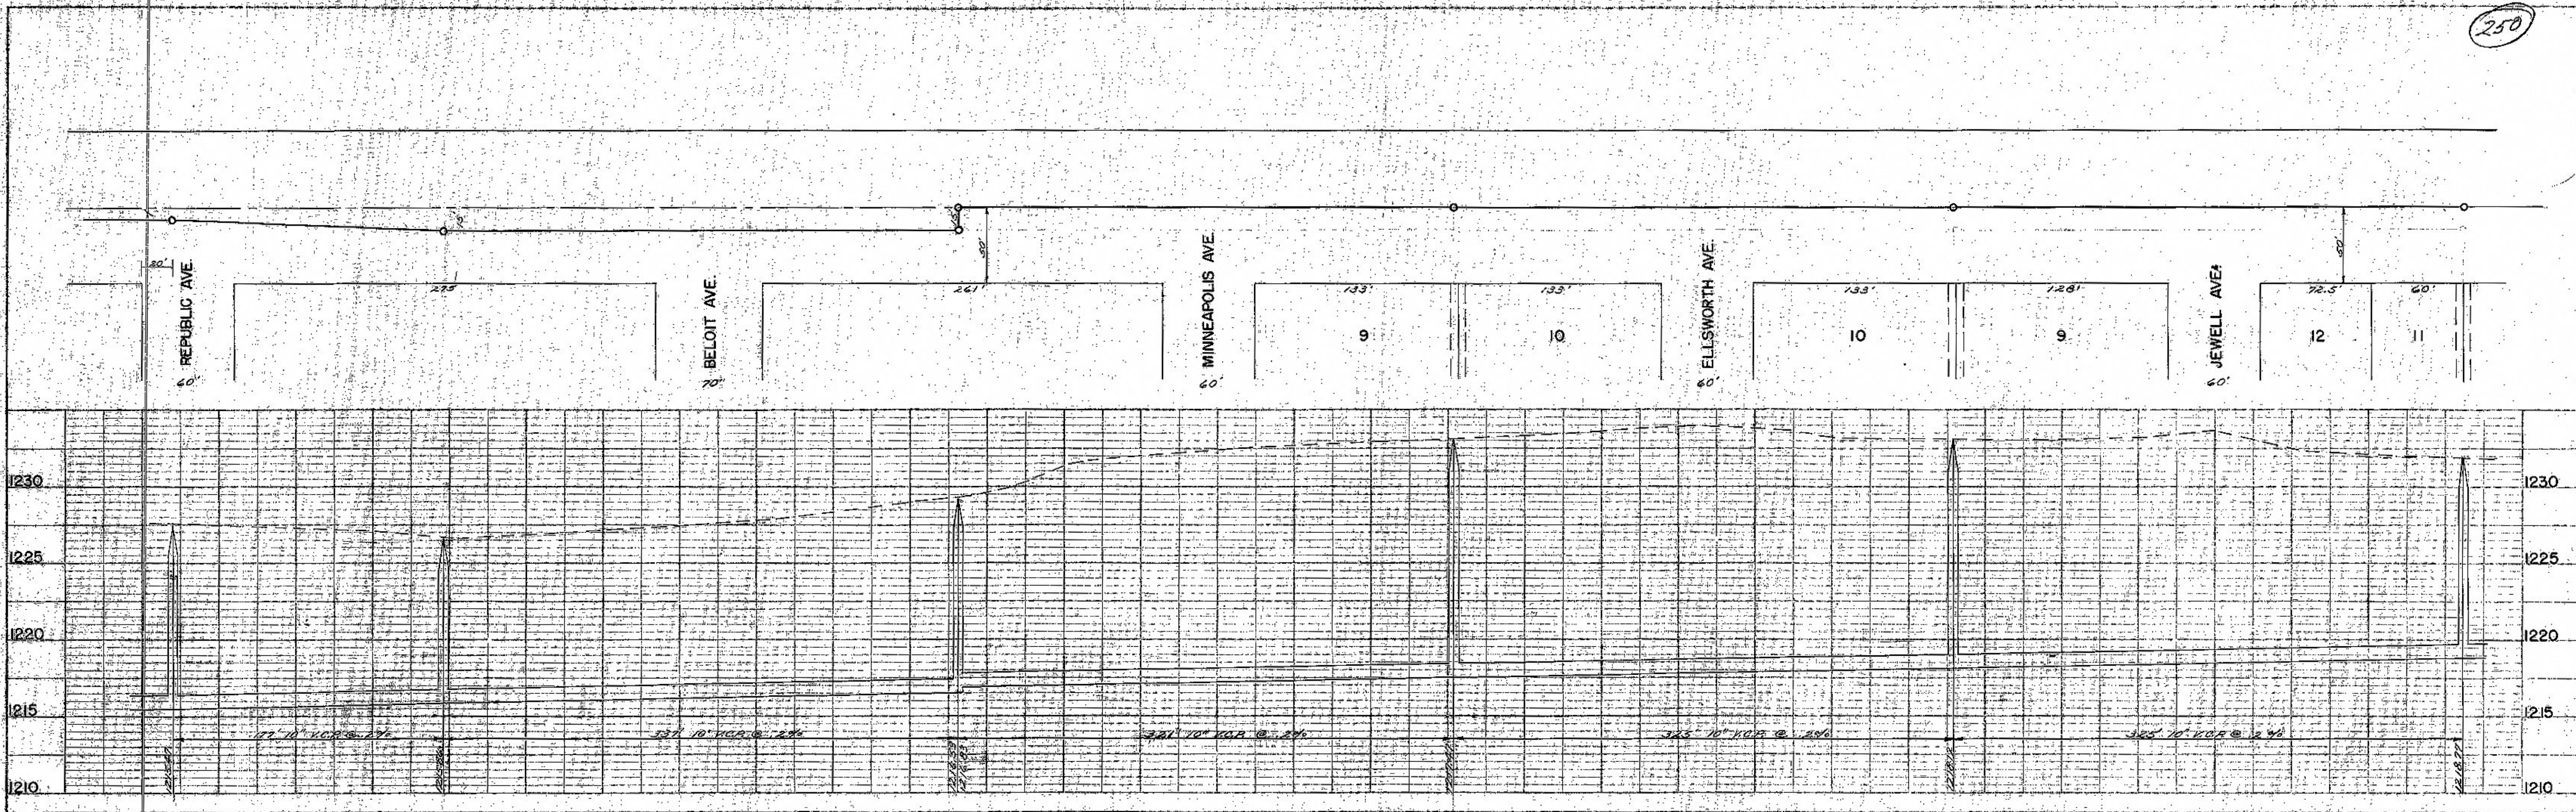