




PLAN
 SURVEYED BY: _____ DATE: _____
 PLOTTED BY: _____
 NOTE BOOK NO. _____
 REVISIONS BY: _____
 STRUCTURE NOTATION: _____

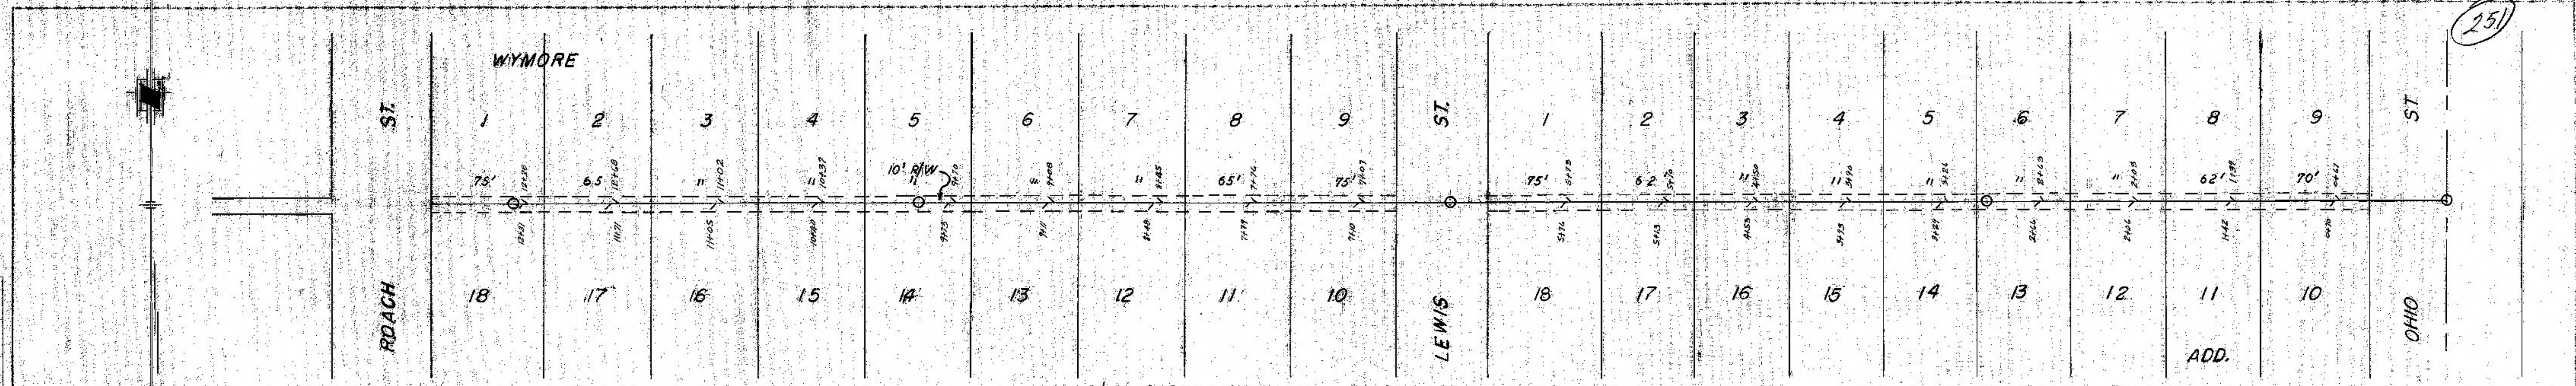

R/W NORTH CLAFLIN - ROACH TO OHIO

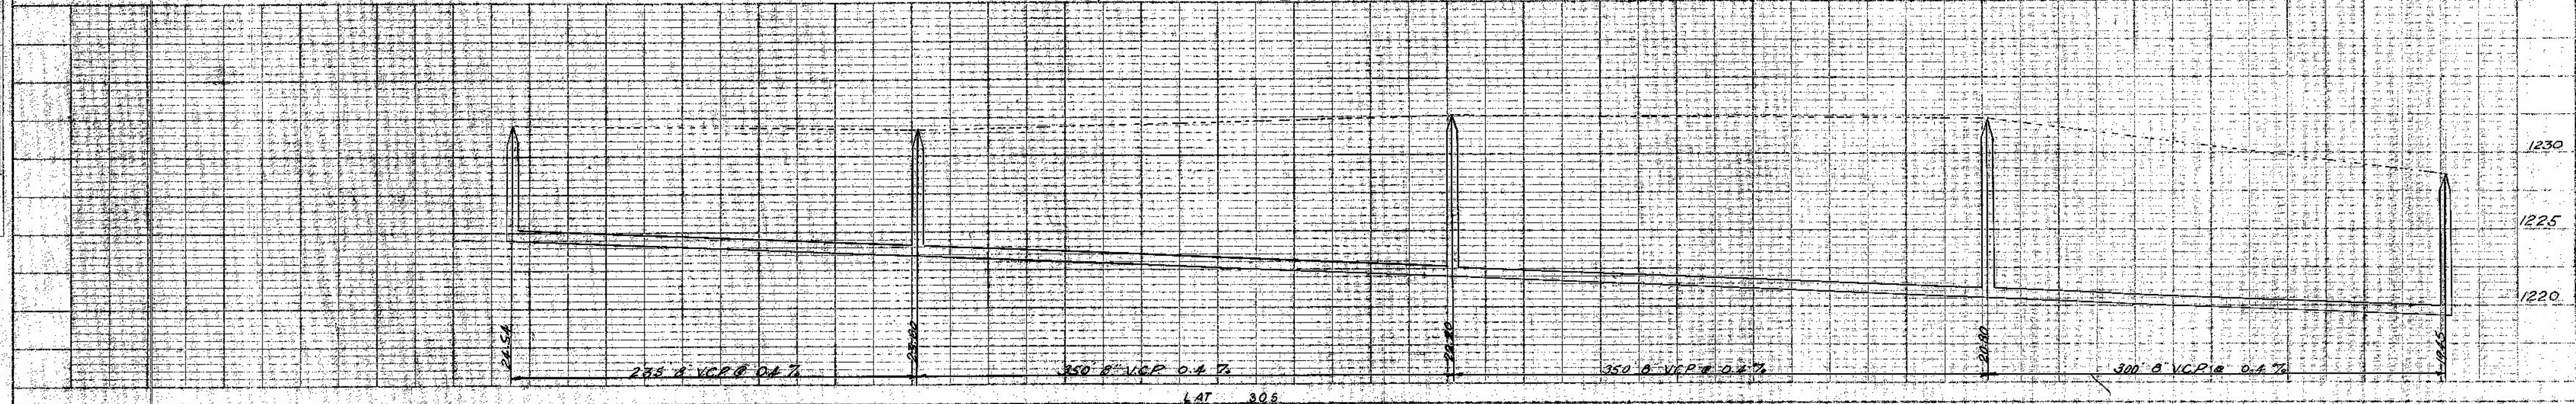

PROFILE
 SURVEYED BY: _____ DATE: _____
 PLOTTED BY: _____
 NOTE BOOK NO. _____
 REVISIONS BY: _____
 STRUCTURE NOTATION: _____

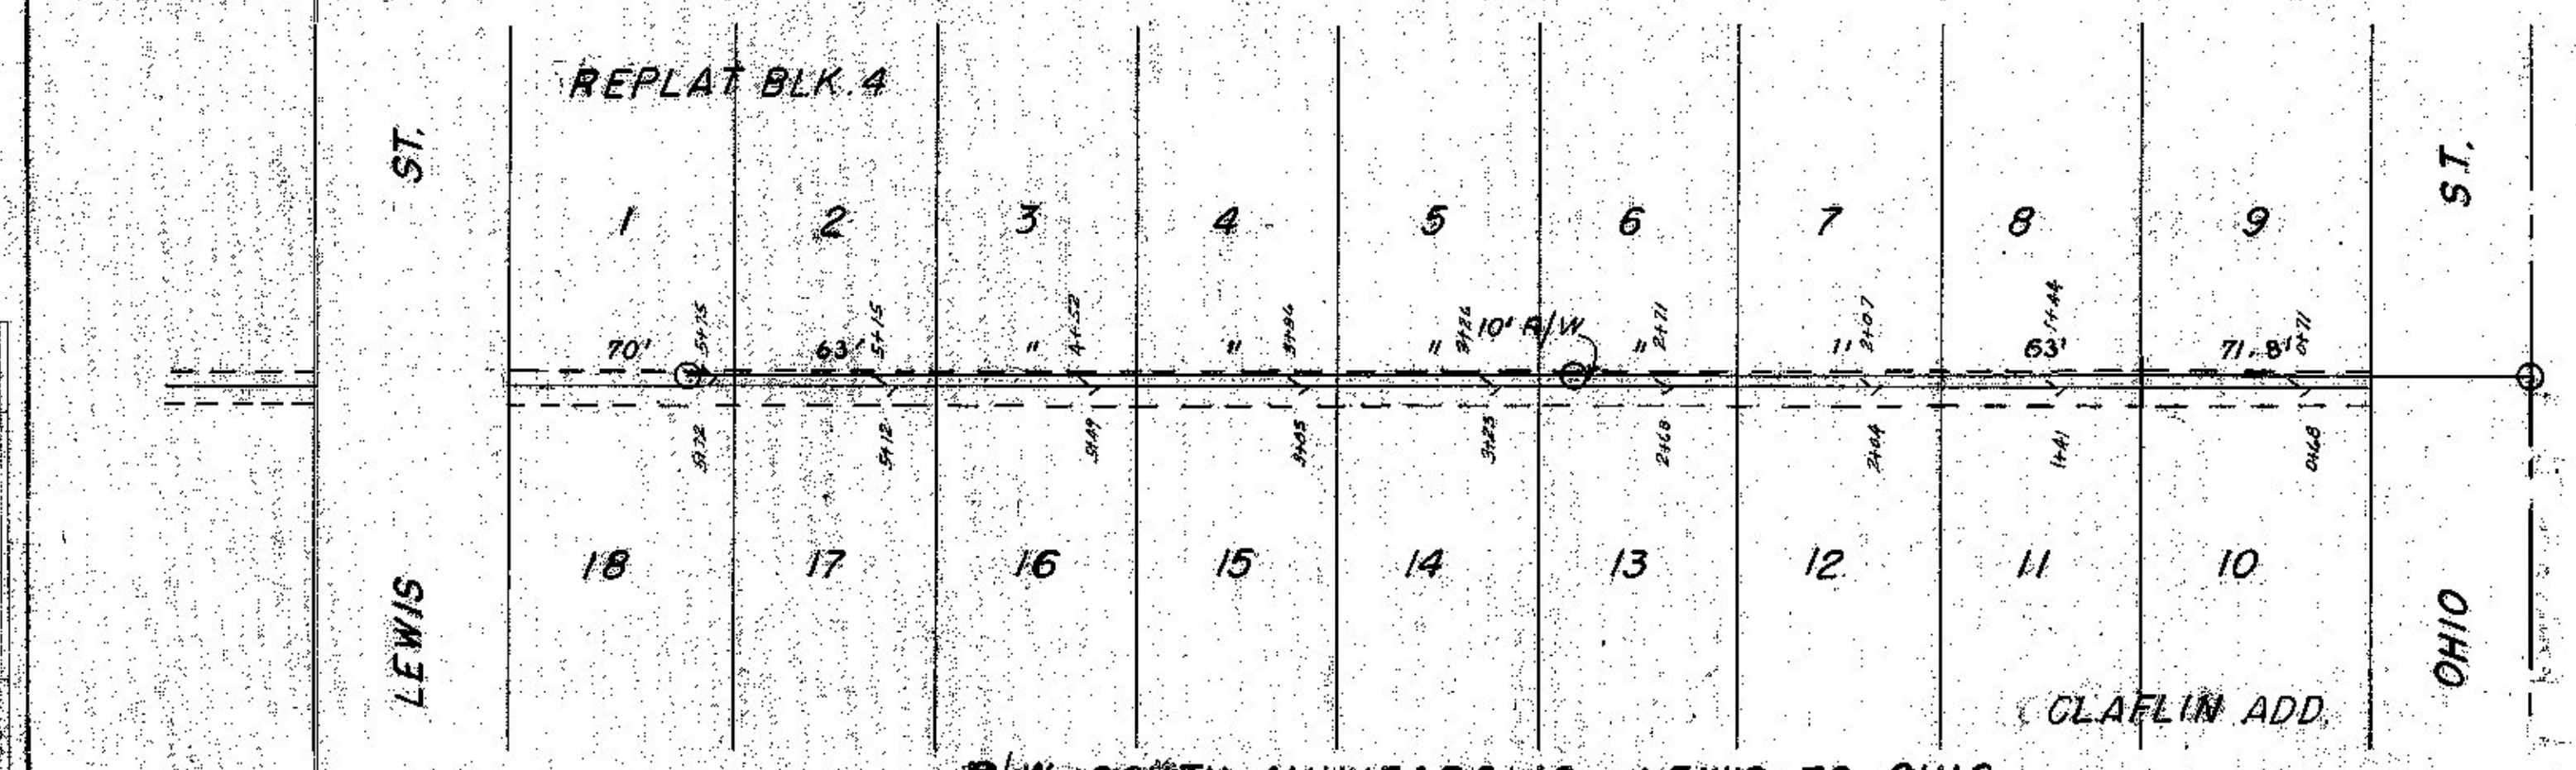

R/W SOUTH MINNEAPOLIS - LEWIS TO OHIO

