



254

DATE _____
 BY _____
 SURVEYED _____
 PLOTTED _____
 NOTE BOOK _____
 CHECKED _____
 NO. _____
 STRUCTURE _____
 DATE _____

DATE _____
 BY _____
 SURVEYED _____
 PLOTTED _____
 NOTE BOOK _____
 CHECKED _____
 NO. _____
 STRUCTURE _____
 DATE _____

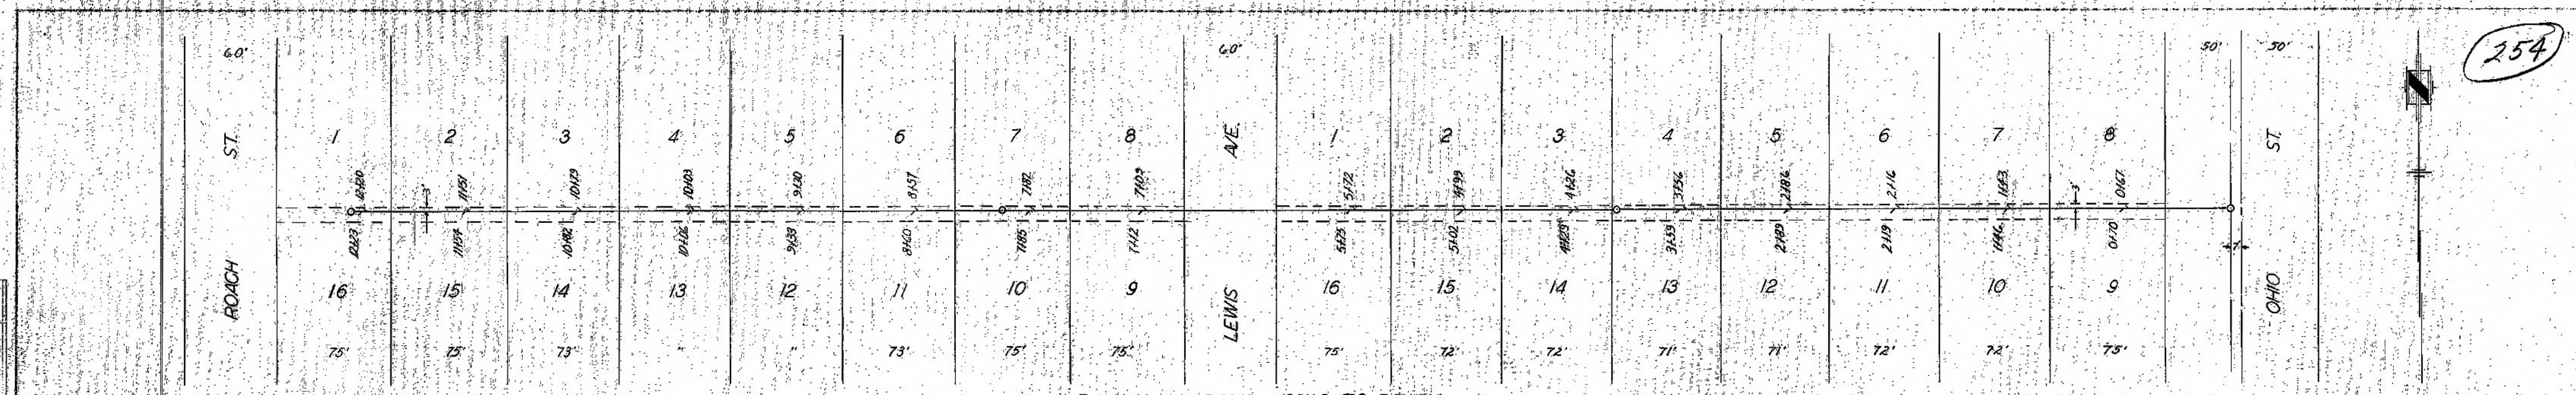

R/W N. MADAMS - OHIO TO ROACH.

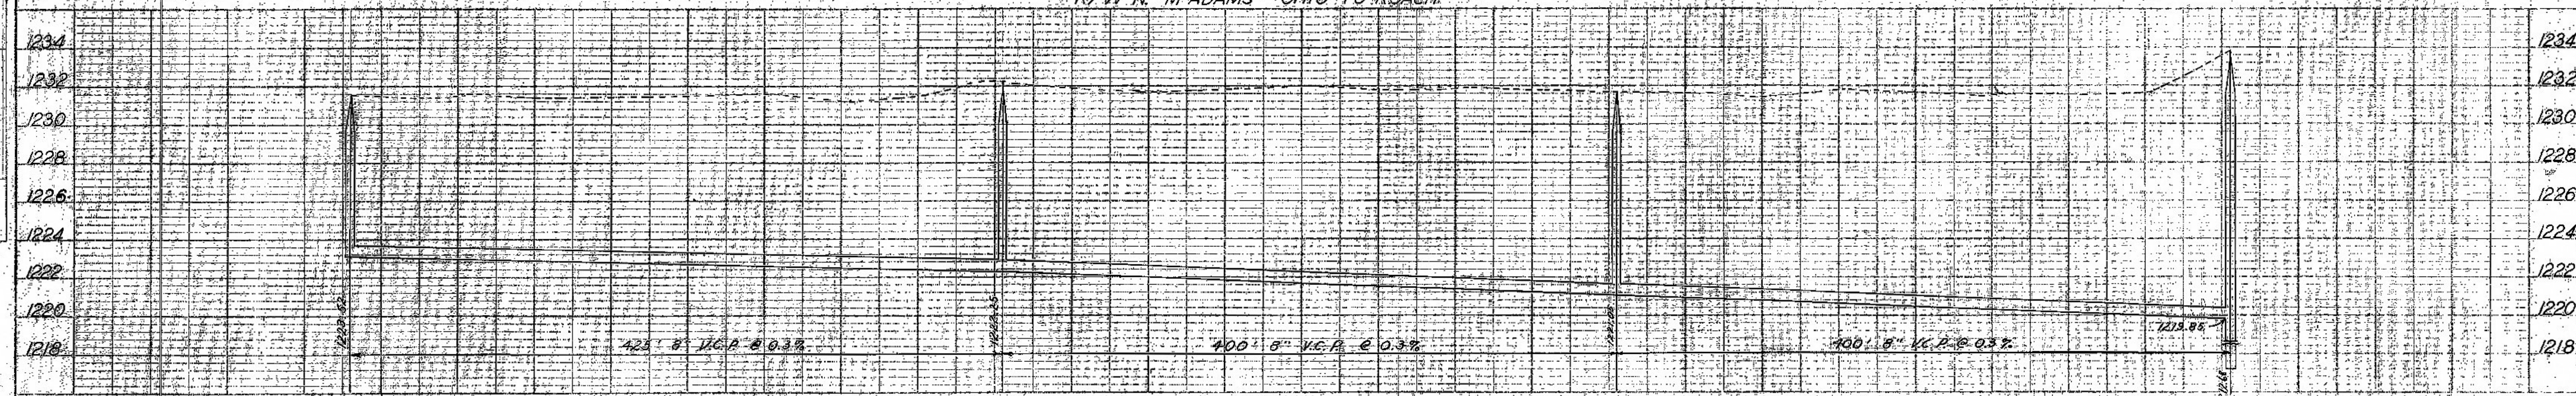

LAT. 313