

256

PLAN


BY \_\_\_\_\_ DATE \_\_\_\_\_

NO. \_\_\_\_\_


NOTE: BOOK \_\_\_\_\_

ALIGNED CHECKED \_\_\_\_\_

RT. OF WAY CHECKED \_\_\_\_\_

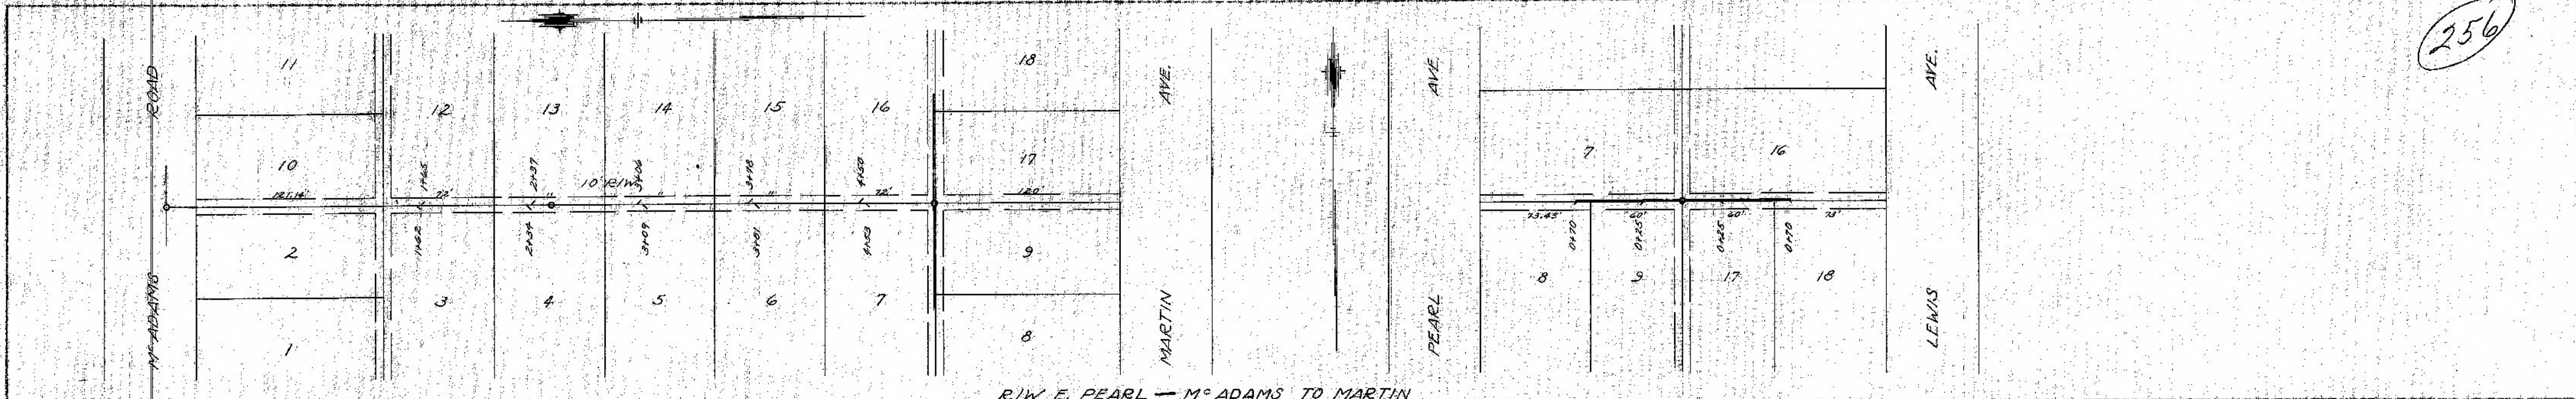

R.I.W. E. PEARL — M<sup>o</sup>. ADAMS TO MARTIN

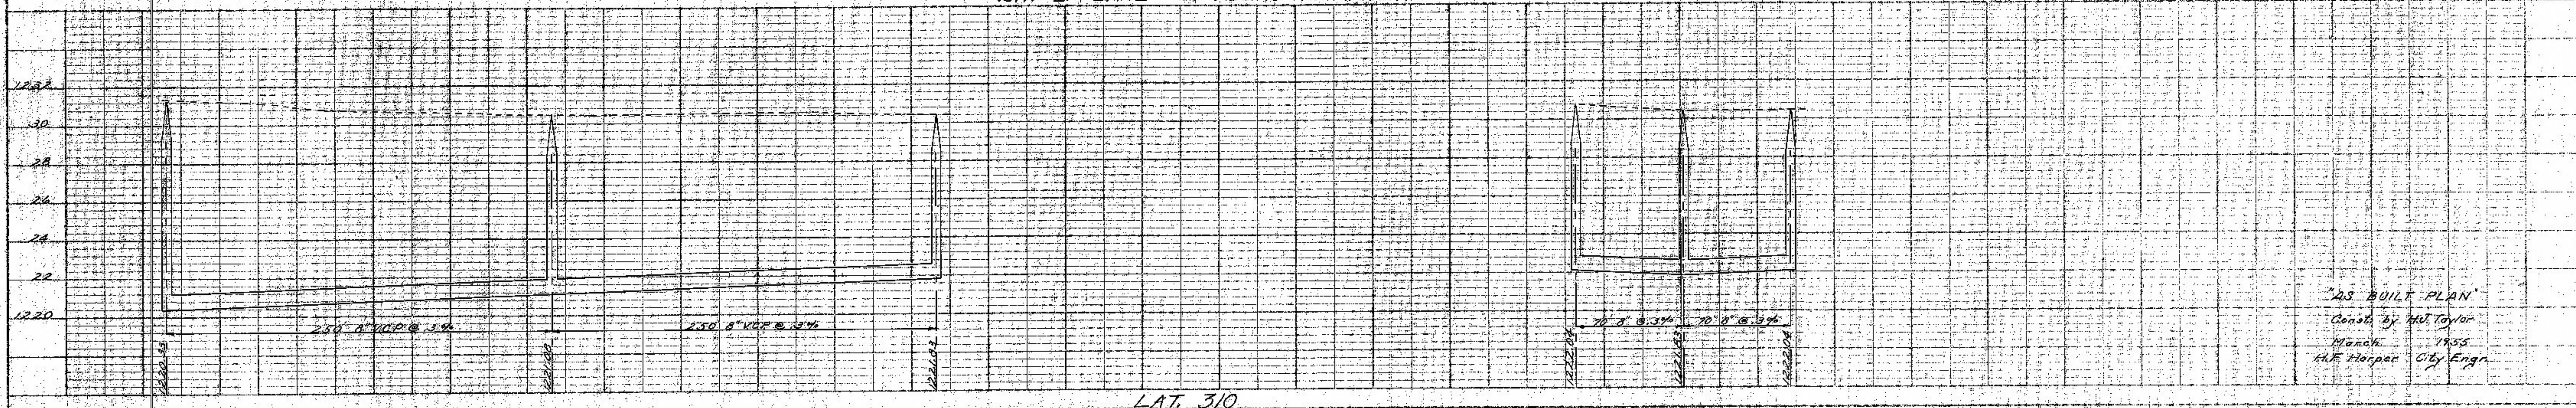

"AS BUILT PLAN"

Const. by H. Taylor

March 1855

H. E. Hooper City Engr.

PROFILE

BY \_\_\_\_\_ DATE \_\_\_\_\_


NO. \_\_\_\_\_

NOTE: BOOK \_\_\_\_\_

GRADES CHECKED \_\_\_\_\_

B. A. E. NOTED \_\_\_\_\_

STRUCTURE NOTATIONS \_\_\_\_\_

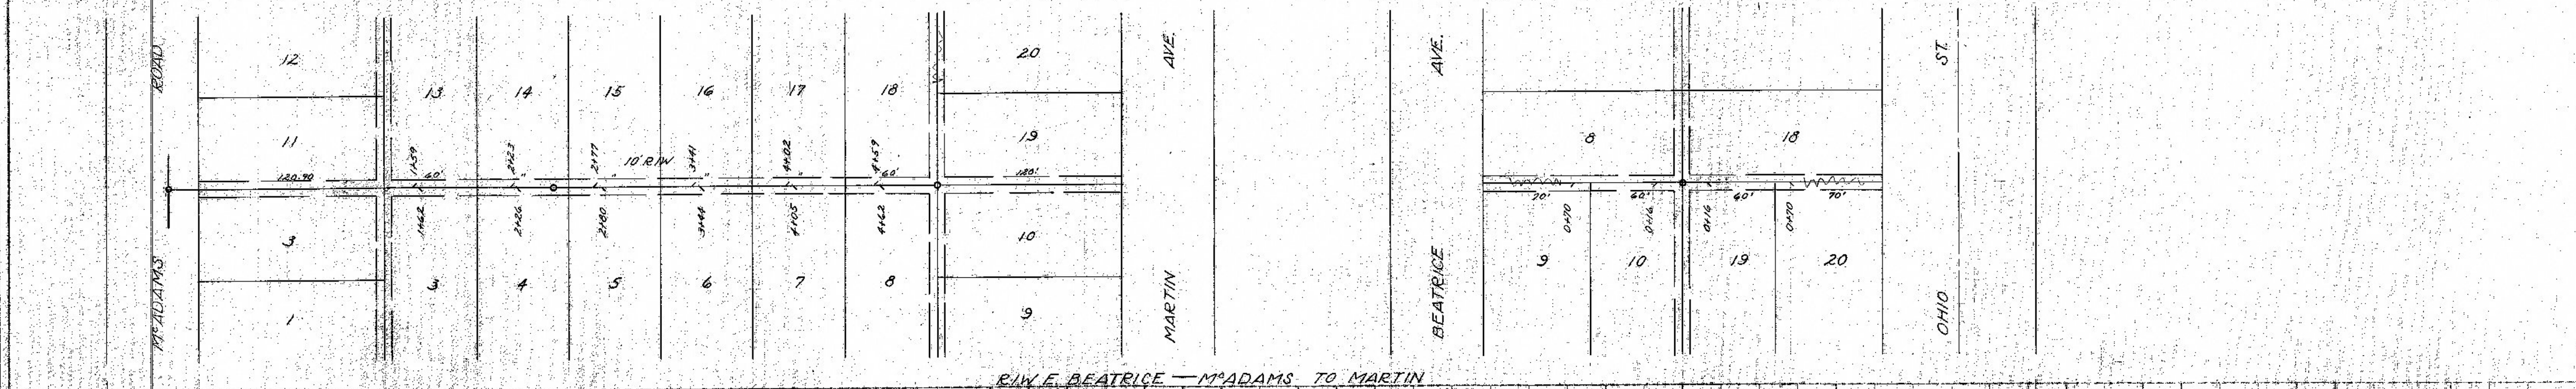

R.I.W. E. BEATRICE — M<sup>o</sup>. ADAMS TO MARTIN

