
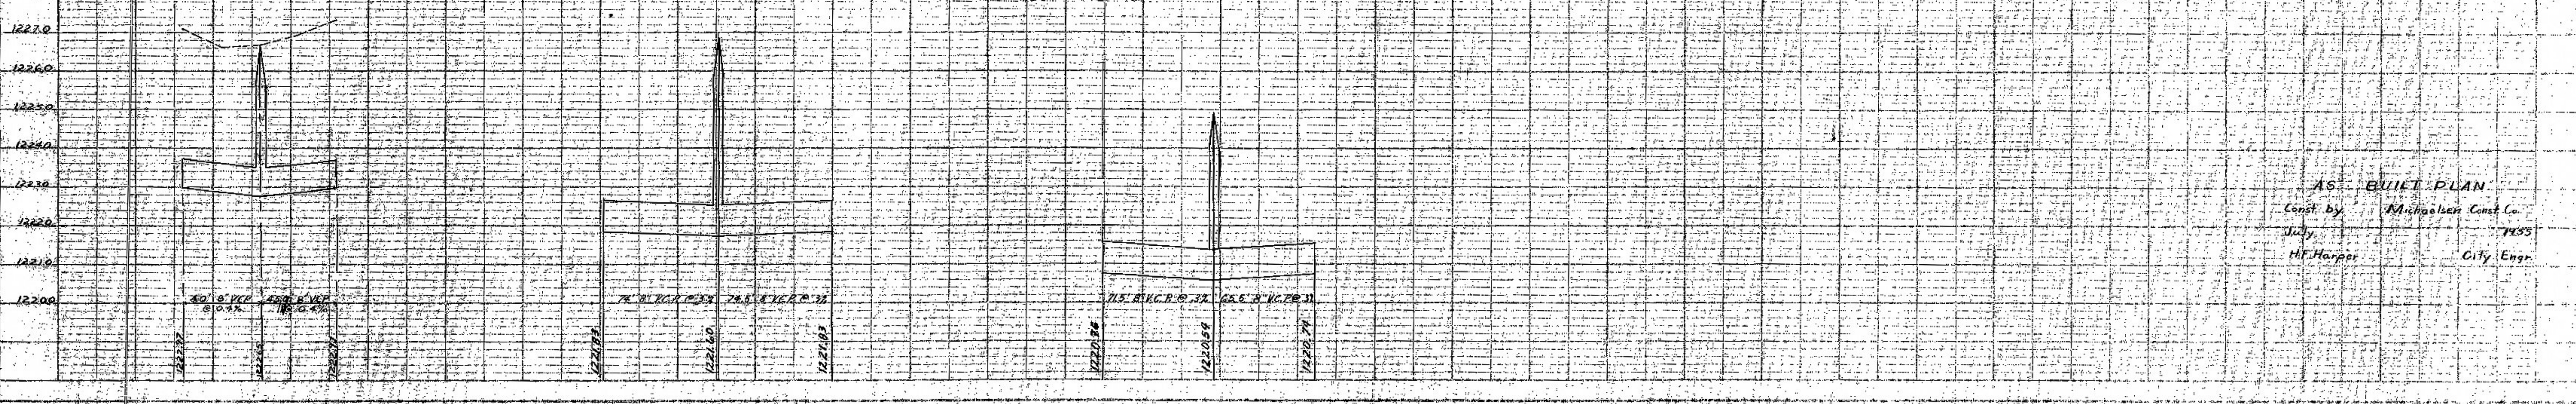
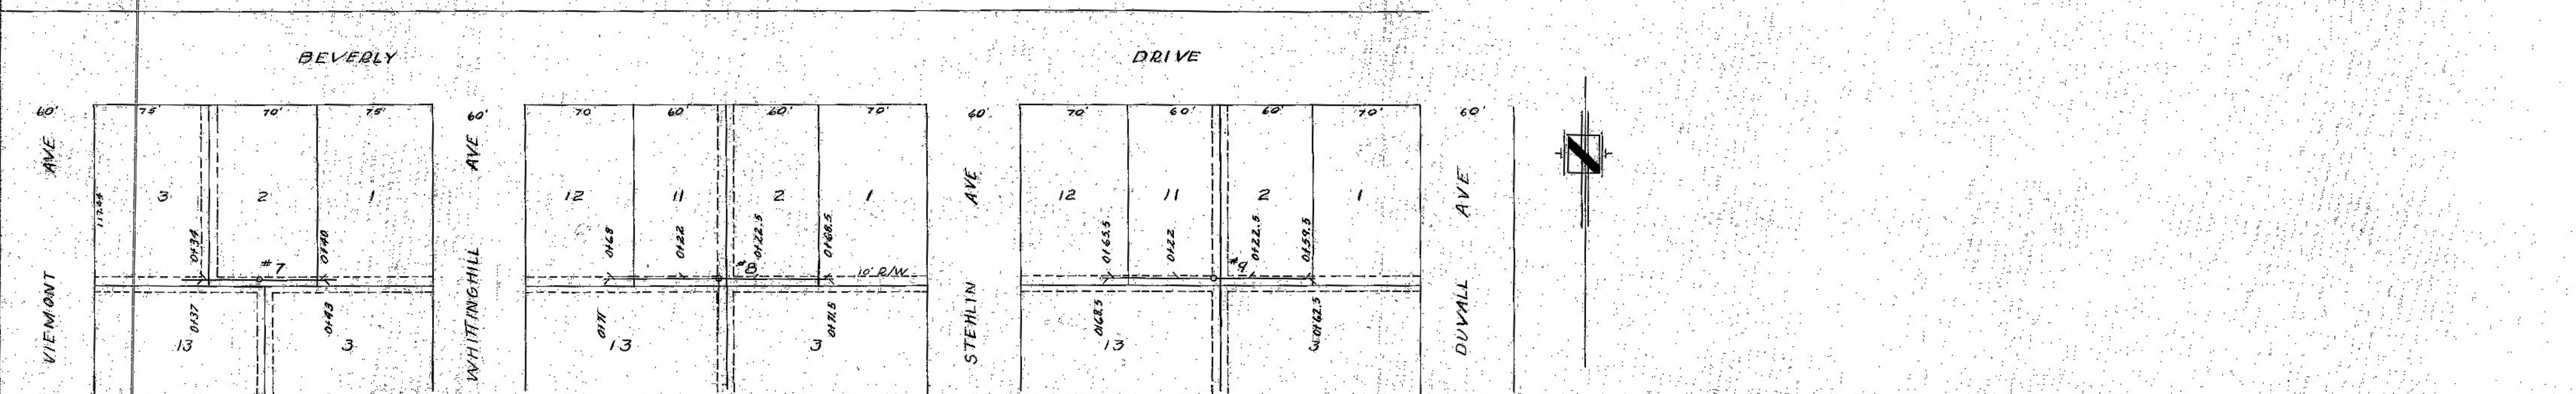
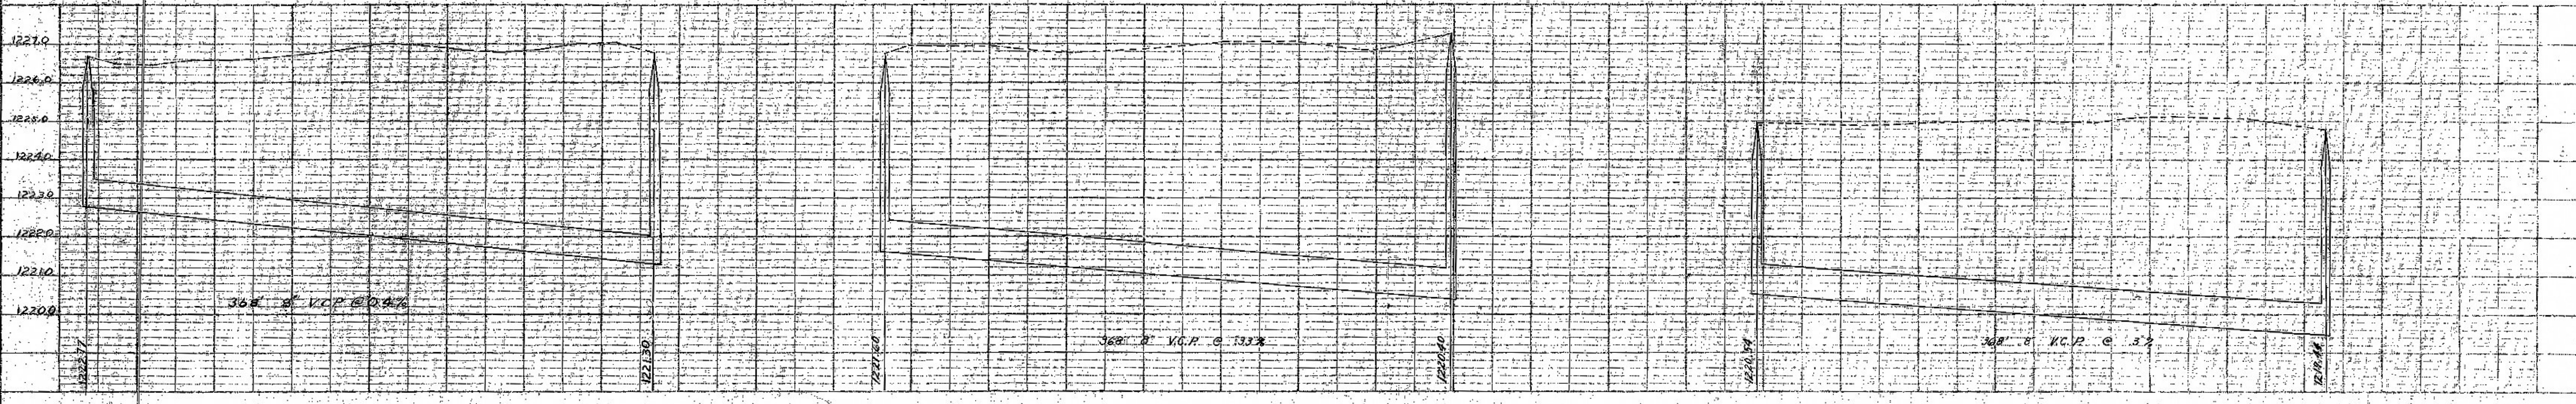


259

PLAN  
 SURVEYED  
 PLOTTED  
 NOTE BOOK NO.  
 DATE

PROFILE  
 SURVEYED  
 PLOTTED  
 NOTE BOOK NO.  
 DATE

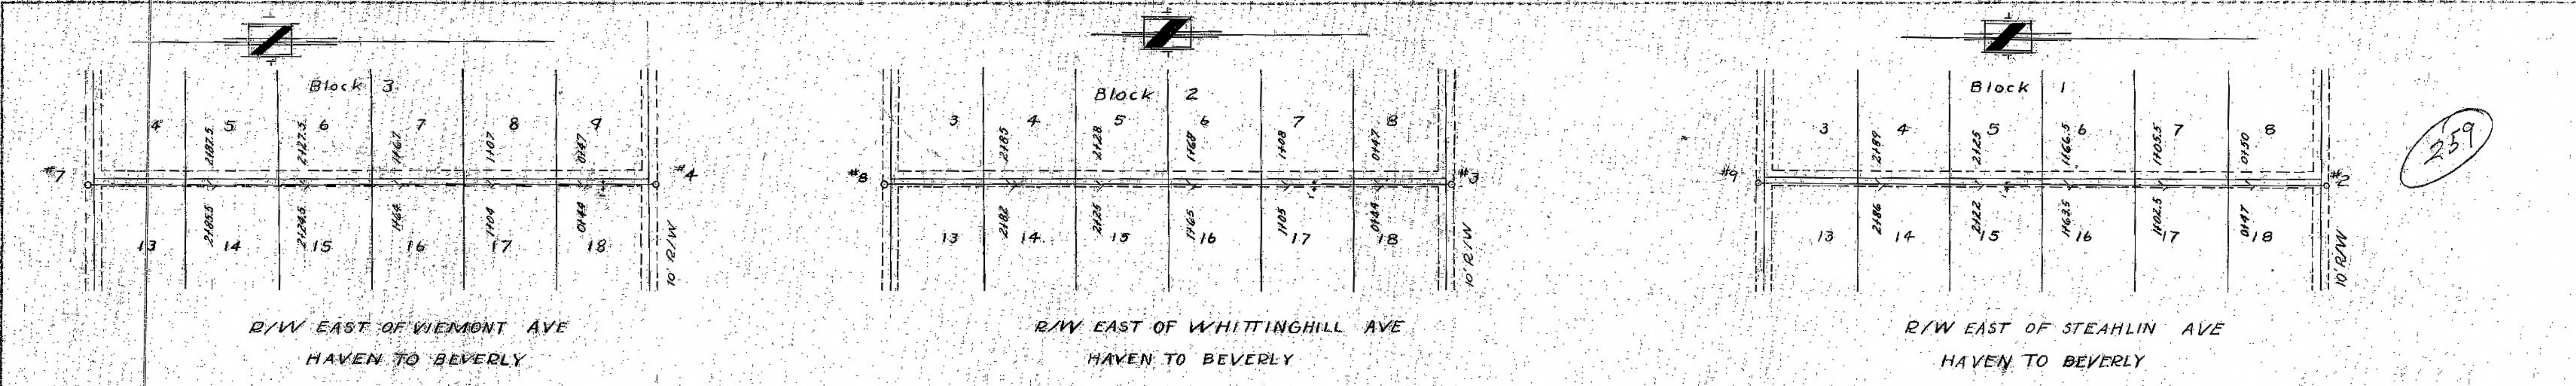

AS BUILT PLAN  
 Const. by Michaelson Const. Co.  
 July 1935  
 H.F. Harper City Engr.