
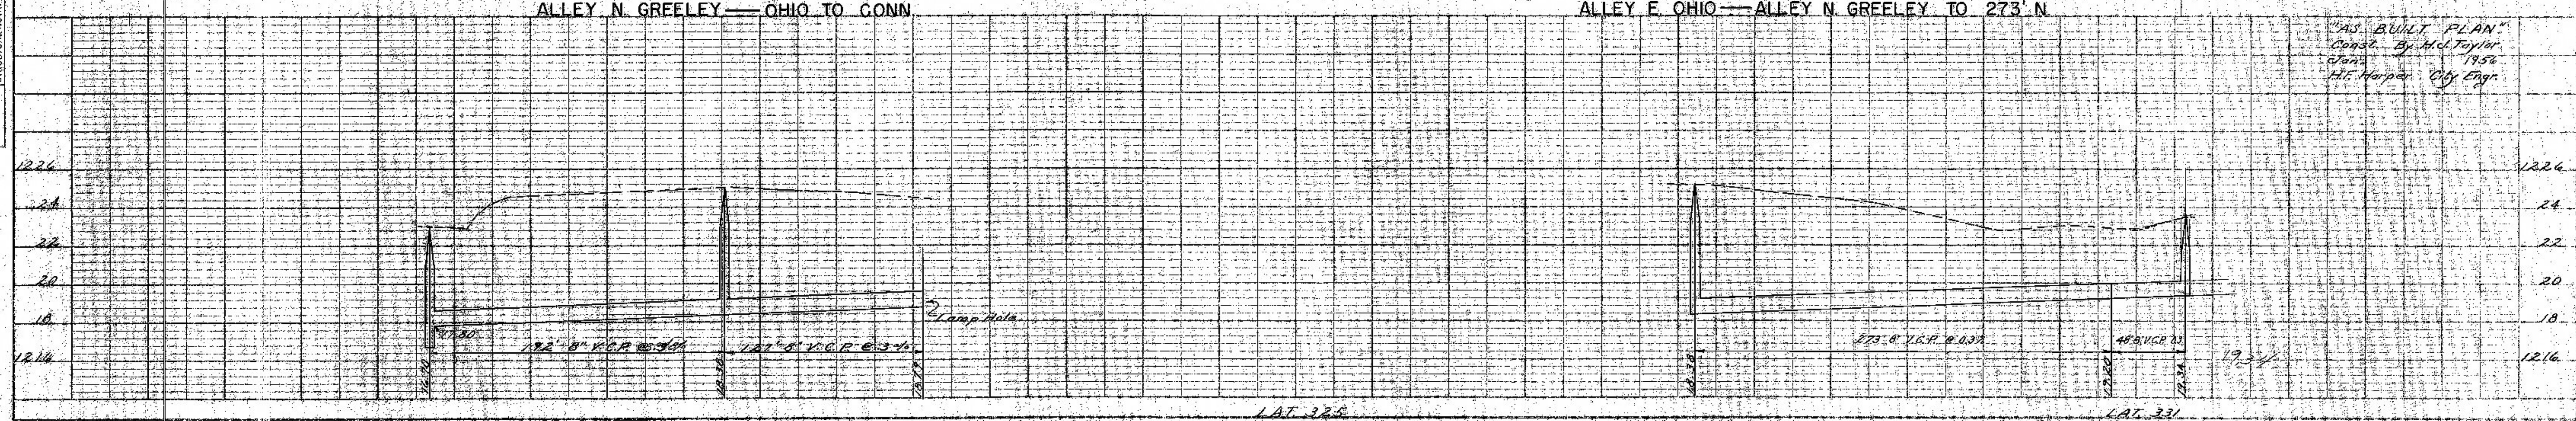
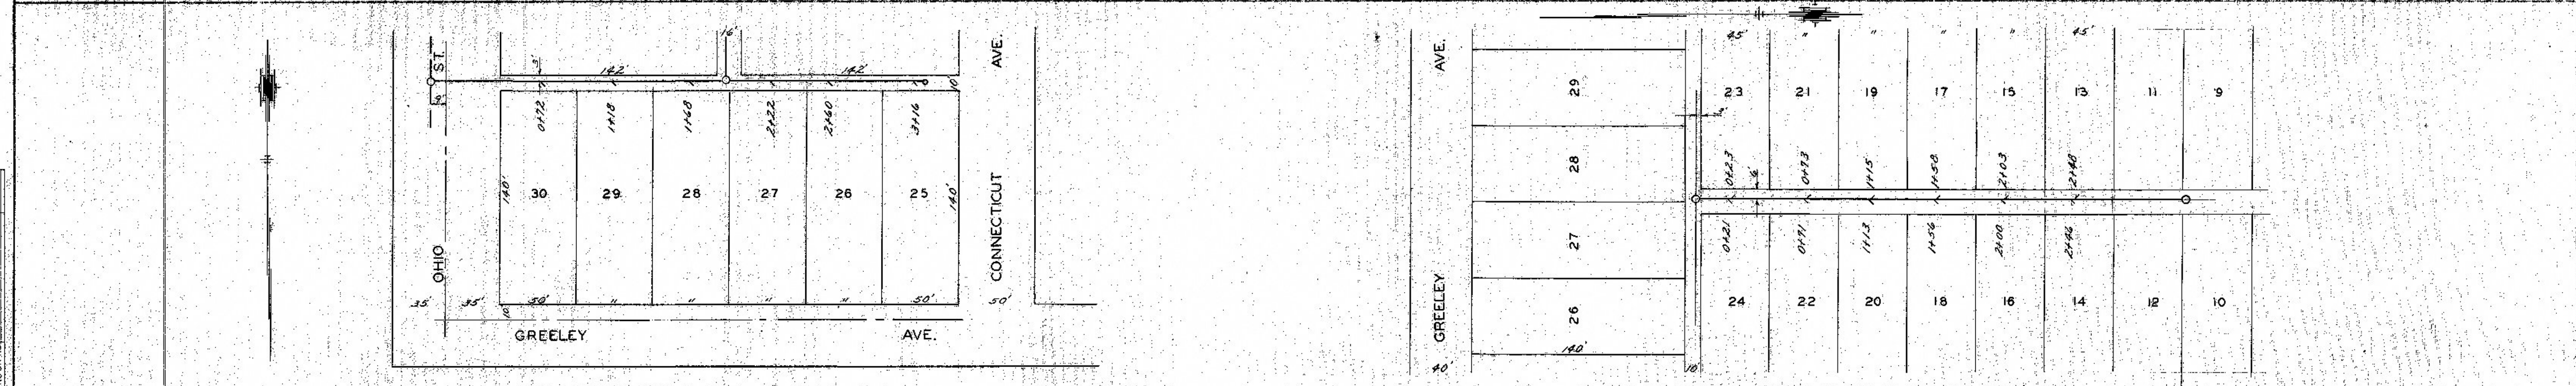
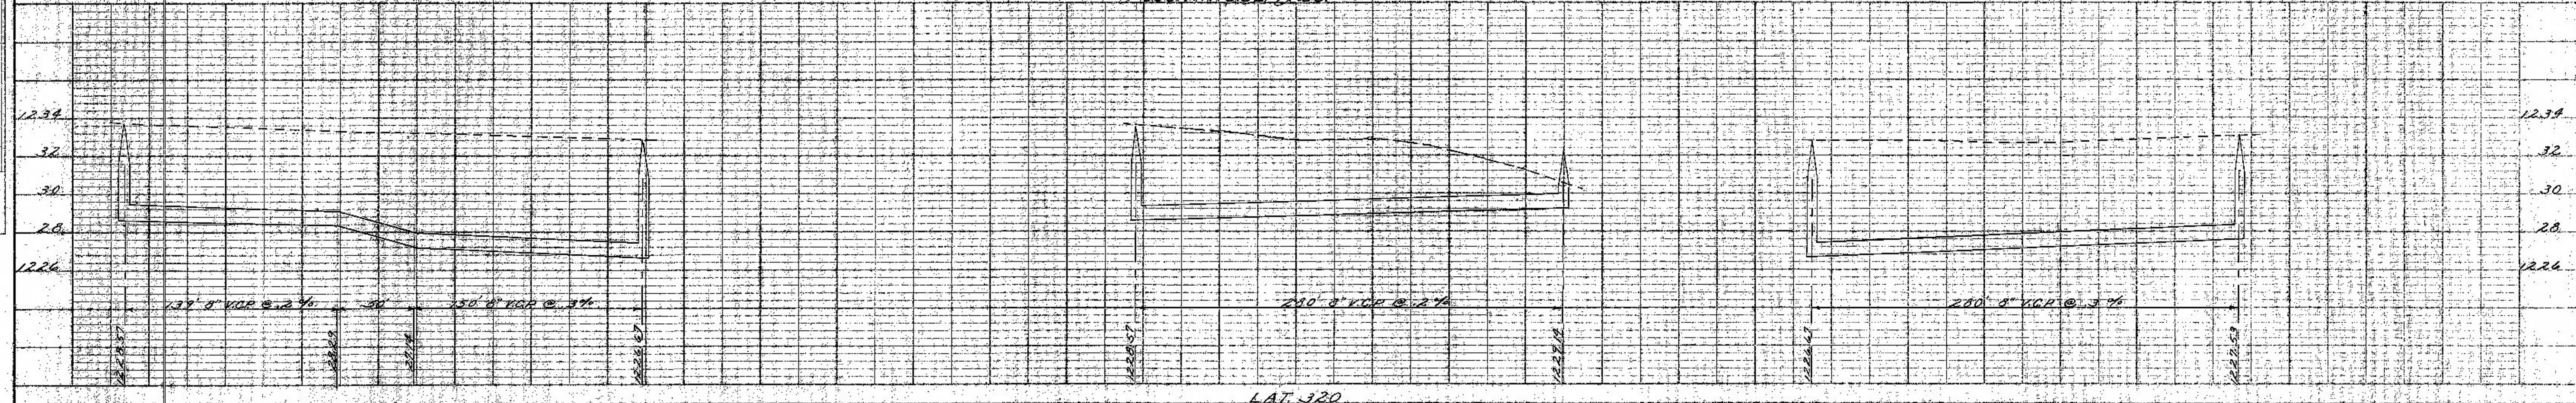


261

PLAN SURVEYED BY DATE
 PLOTTED BY
 NOTE BOOK NO. ALIGNMENT CHECKED BY
 NO. RT. OF WAY ORIGINATED BY

PROFILE SURVEYED BY DATE
 PLOTTED BY
 NOTE BOOK NO. GRADES CHECKED BY
 NO. STRUCTURE NOTATIONS BY

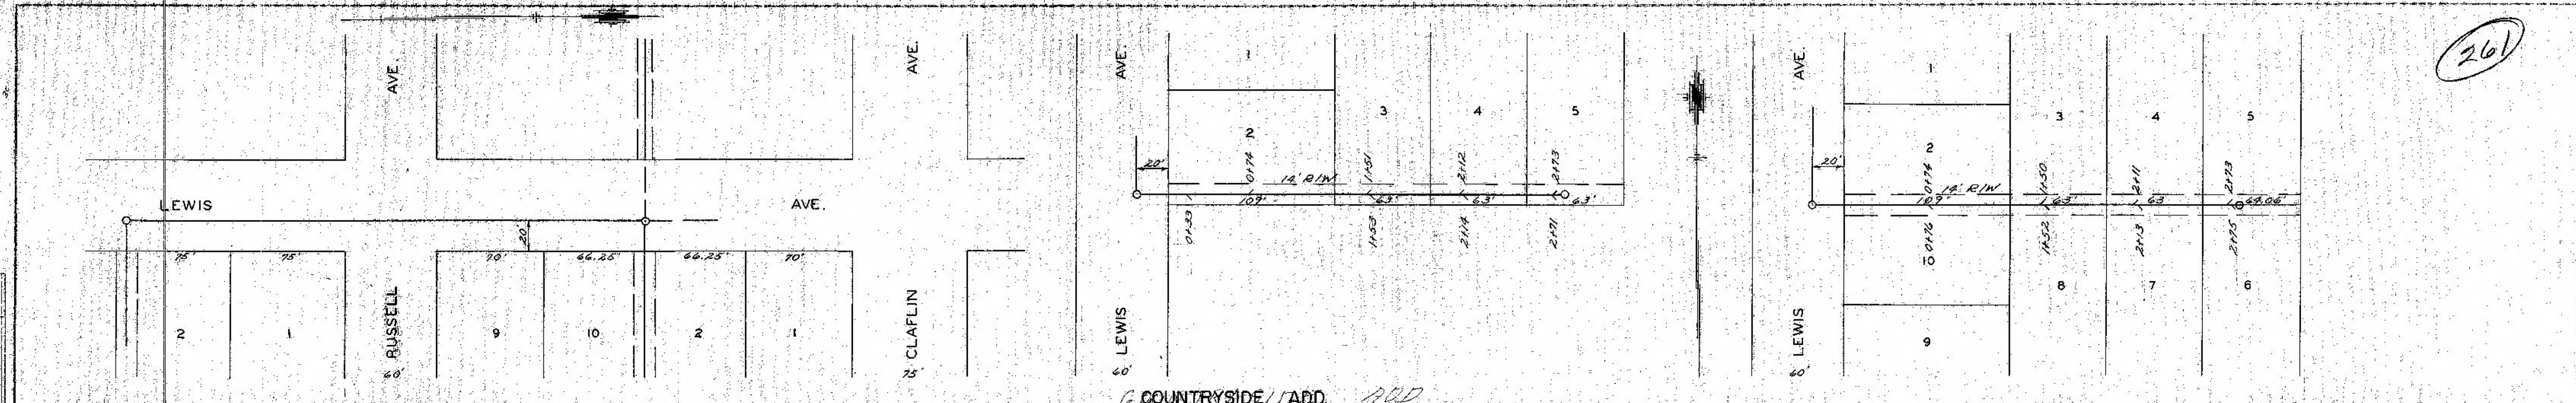

"AS BUILT PLAN"
 Const. By Mr. Taylor
 Jan. 1952
 H. Harper, City Eng.