



262

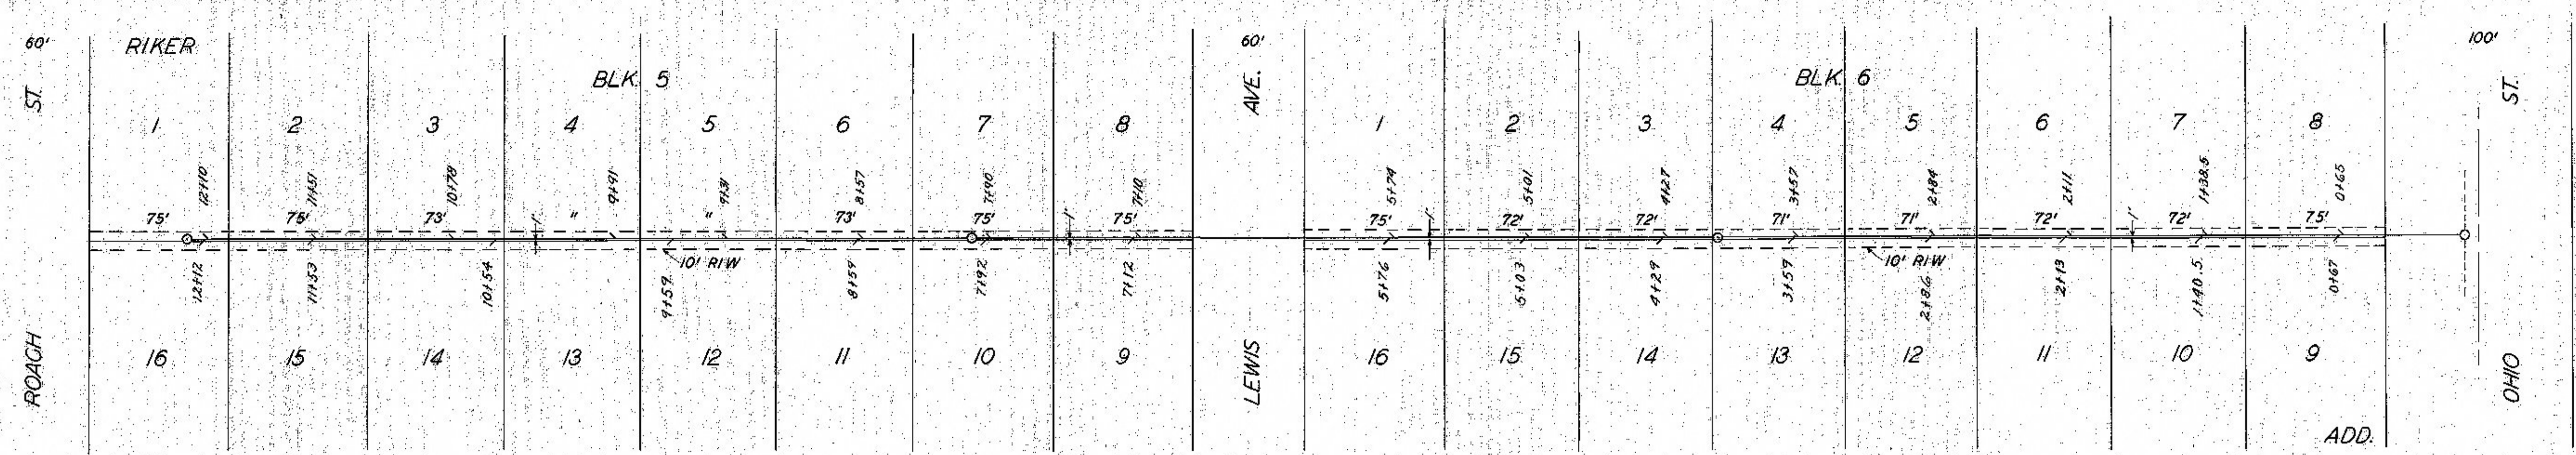


R/W NO. OF MELLINGER FROM OHIO TO ROACH

PLAN
 SURVEYED BY: []
 PLOTTED BY: []
 CHECKED BY: []
 DATE: []

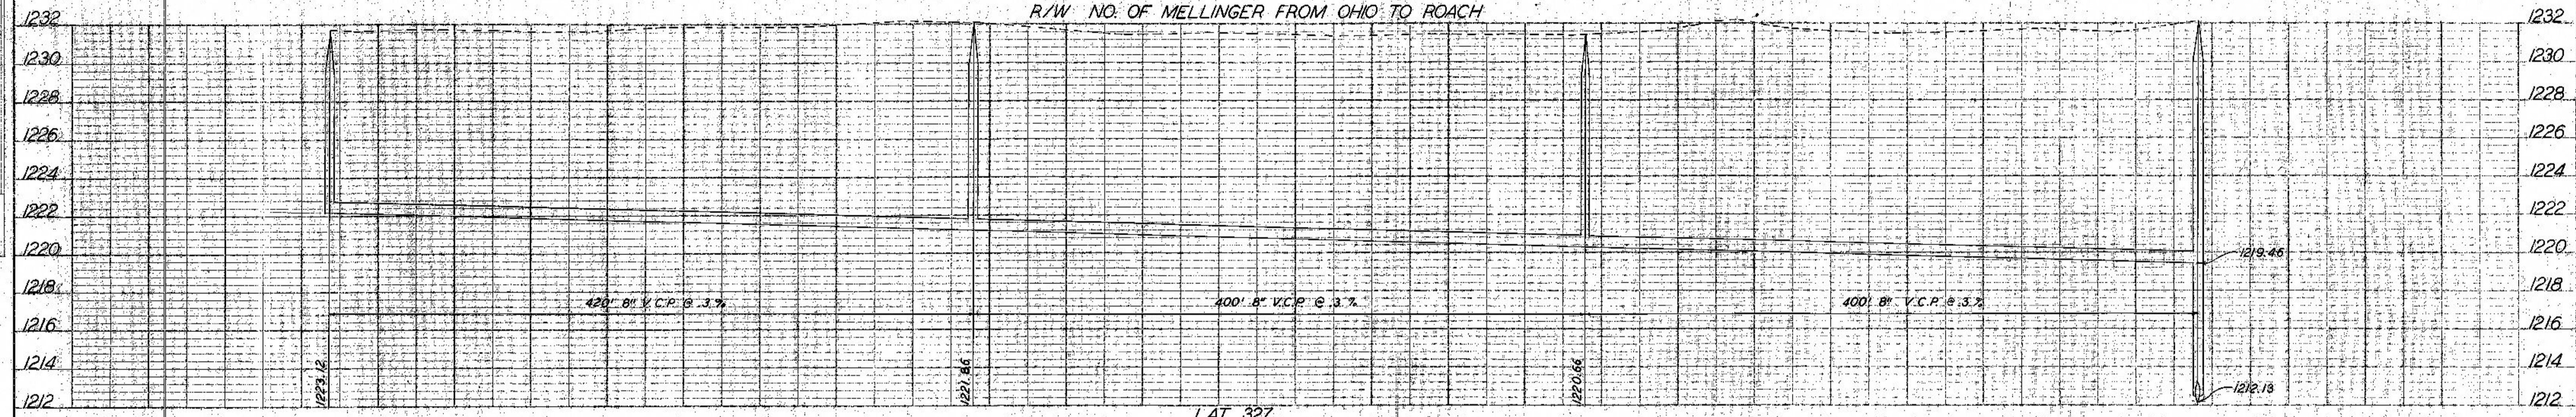

PROFILE
 SURVEYED BY: []
 PLOTTED BY: []
 CHECKED BY: []
 DATE: []

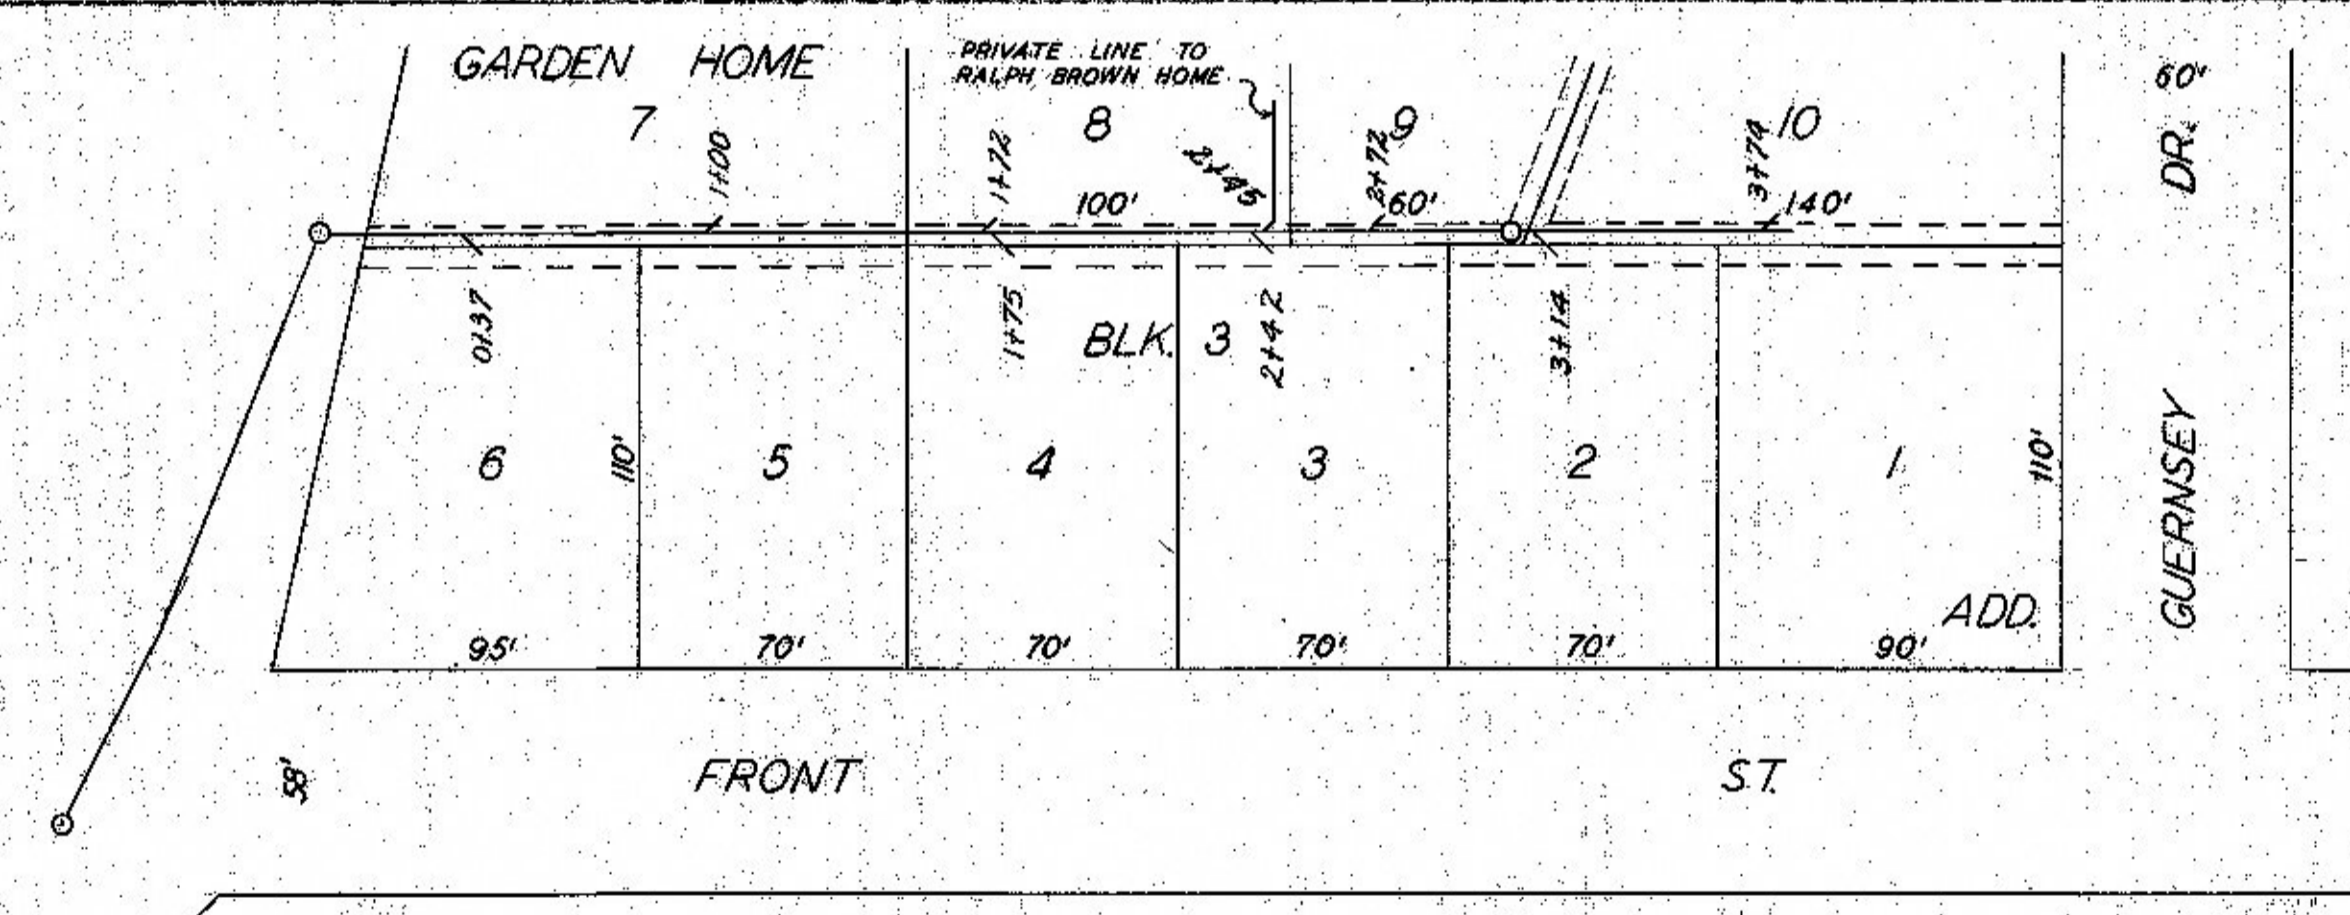

R/W E. OF FRONT FROM PRESCOTT TO GUERNSEY

