



264

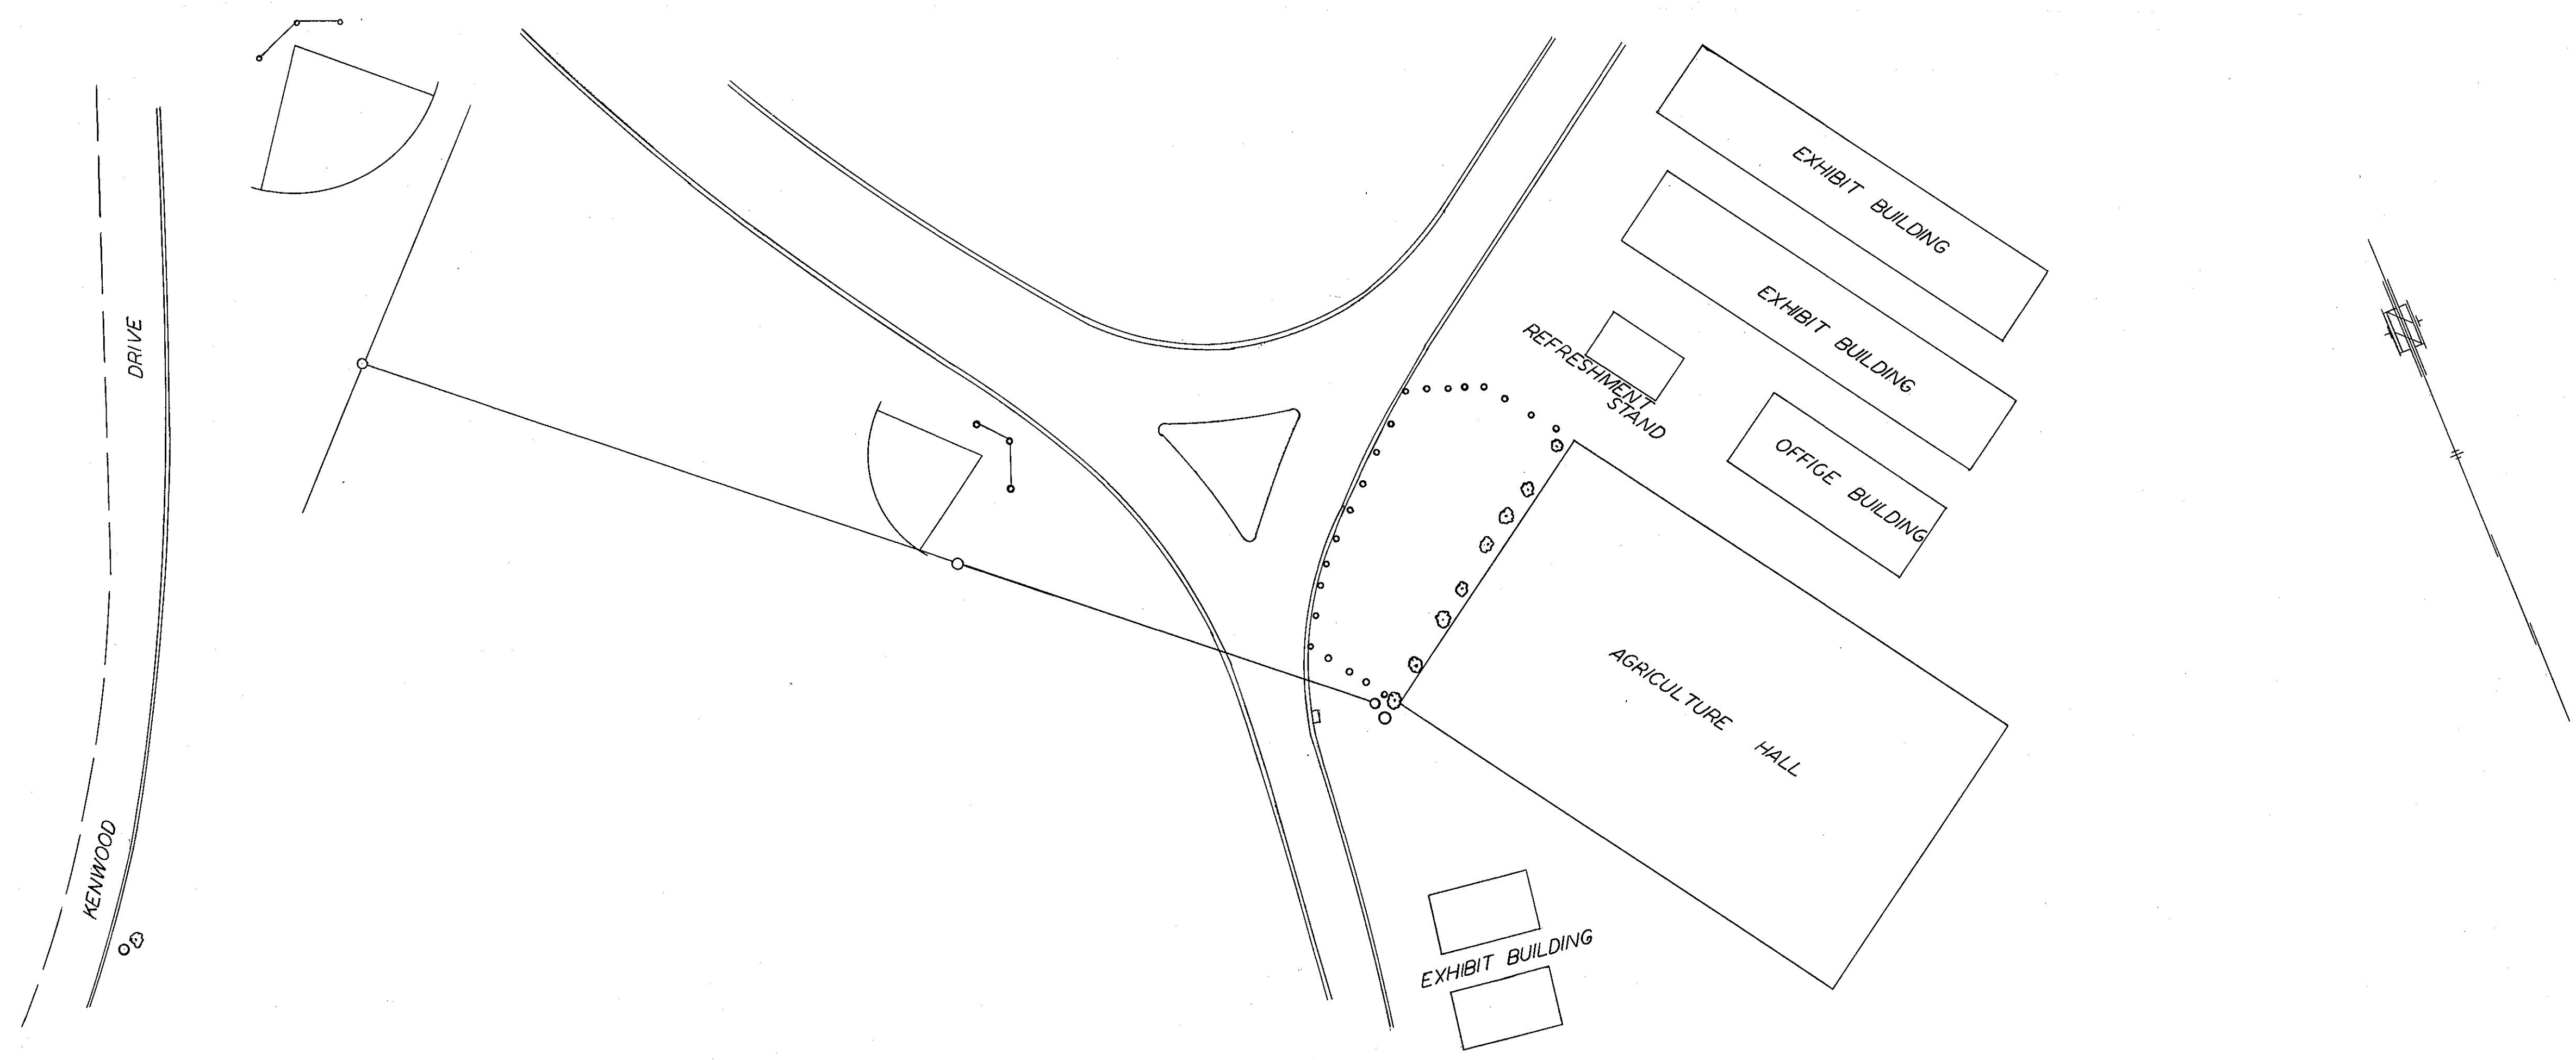

1226.00
1224.00
1222.00
1220.00
1218.00
1216.00

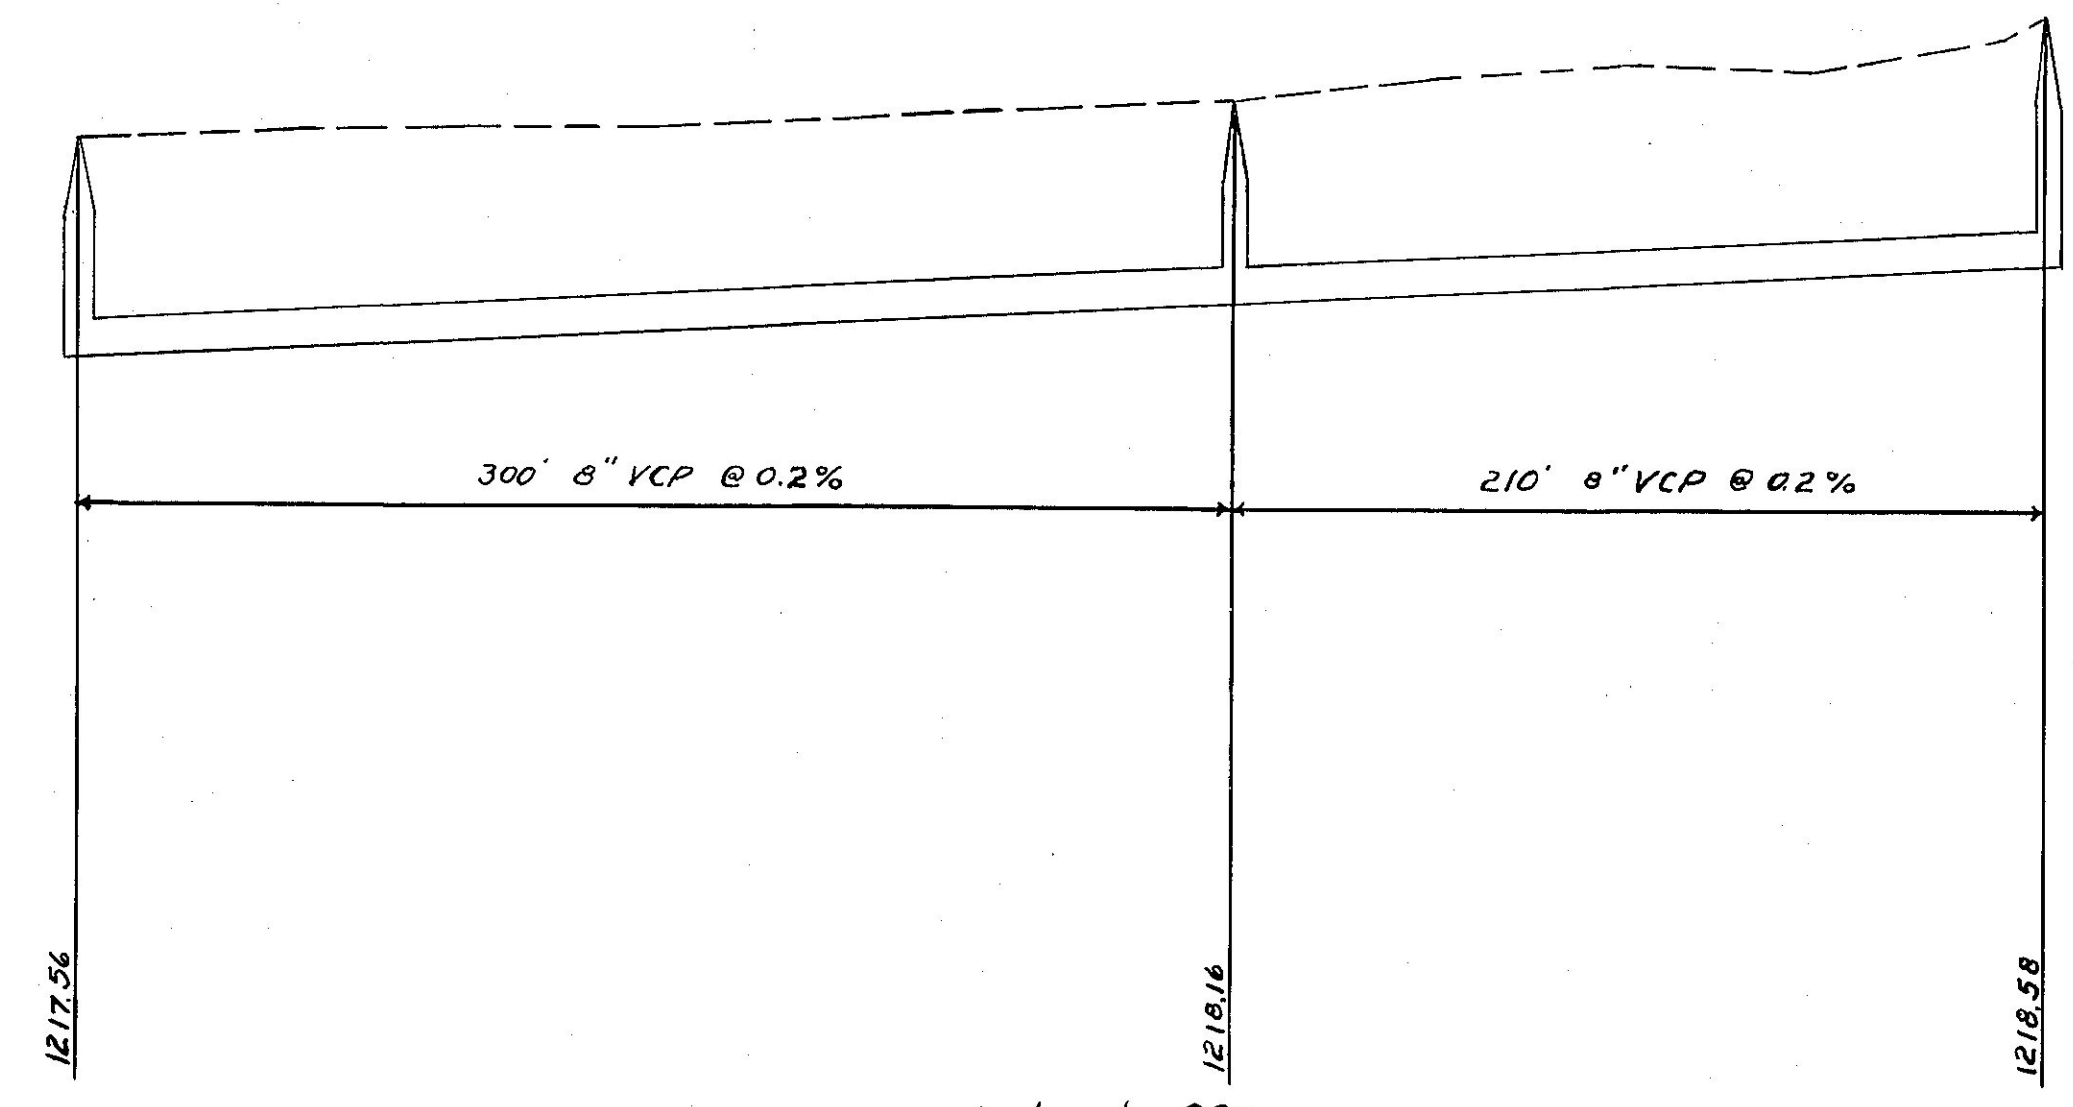

Lateral 326