


265



KENWOOD PARK SANITARY SEWER

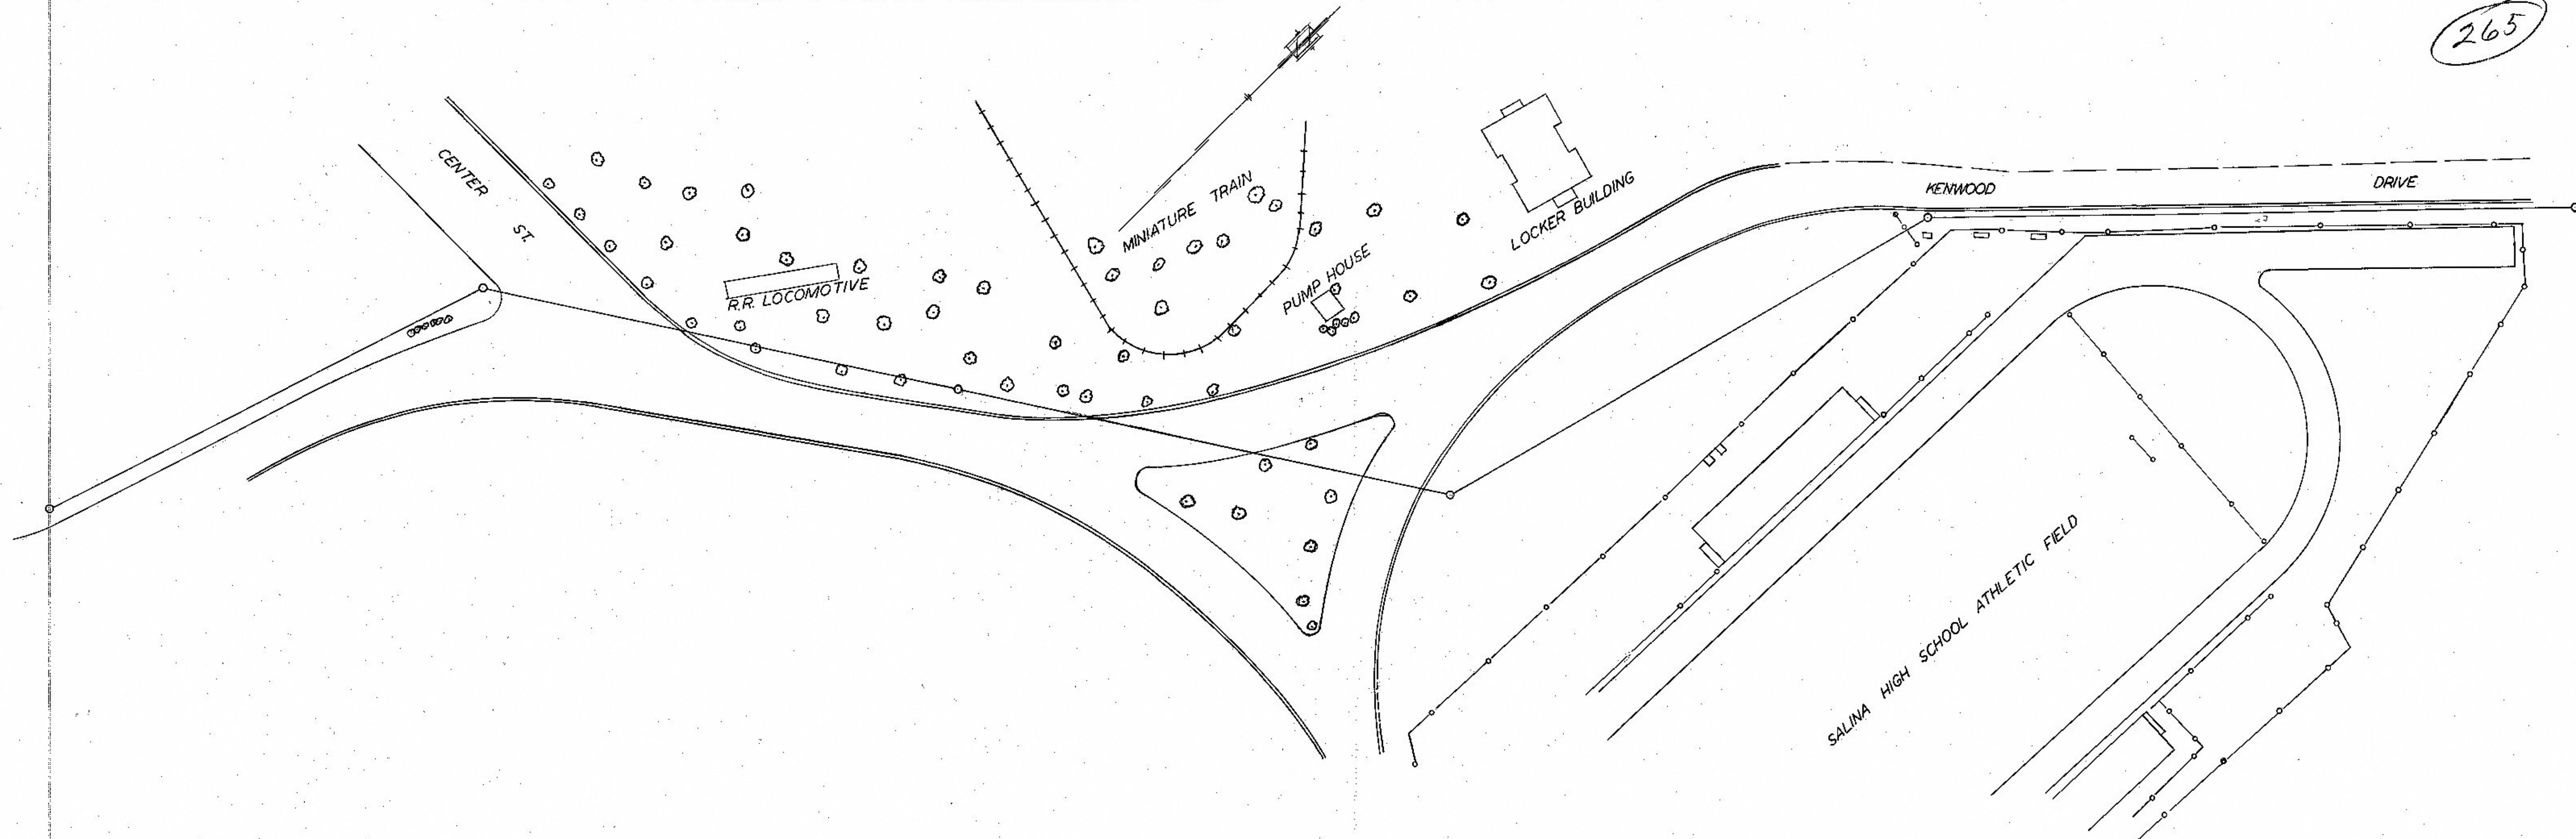