
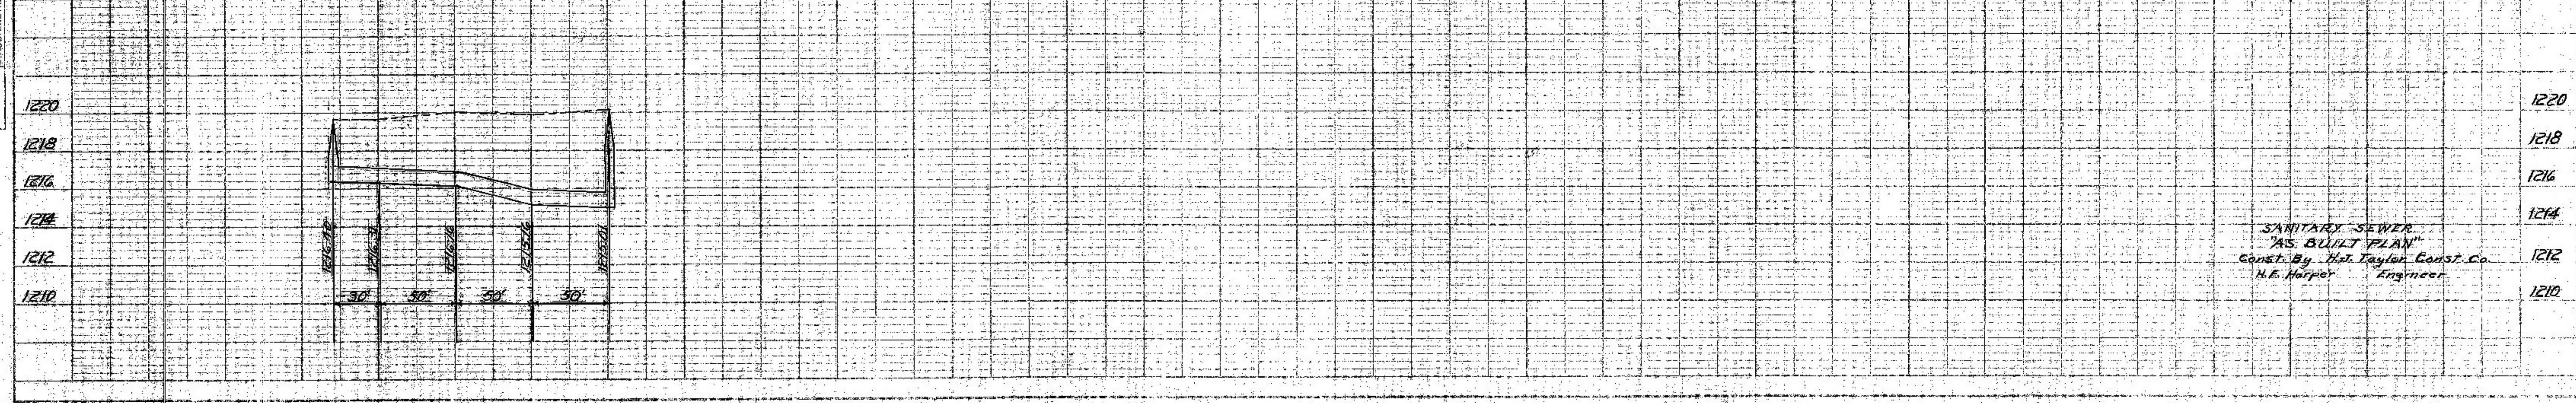
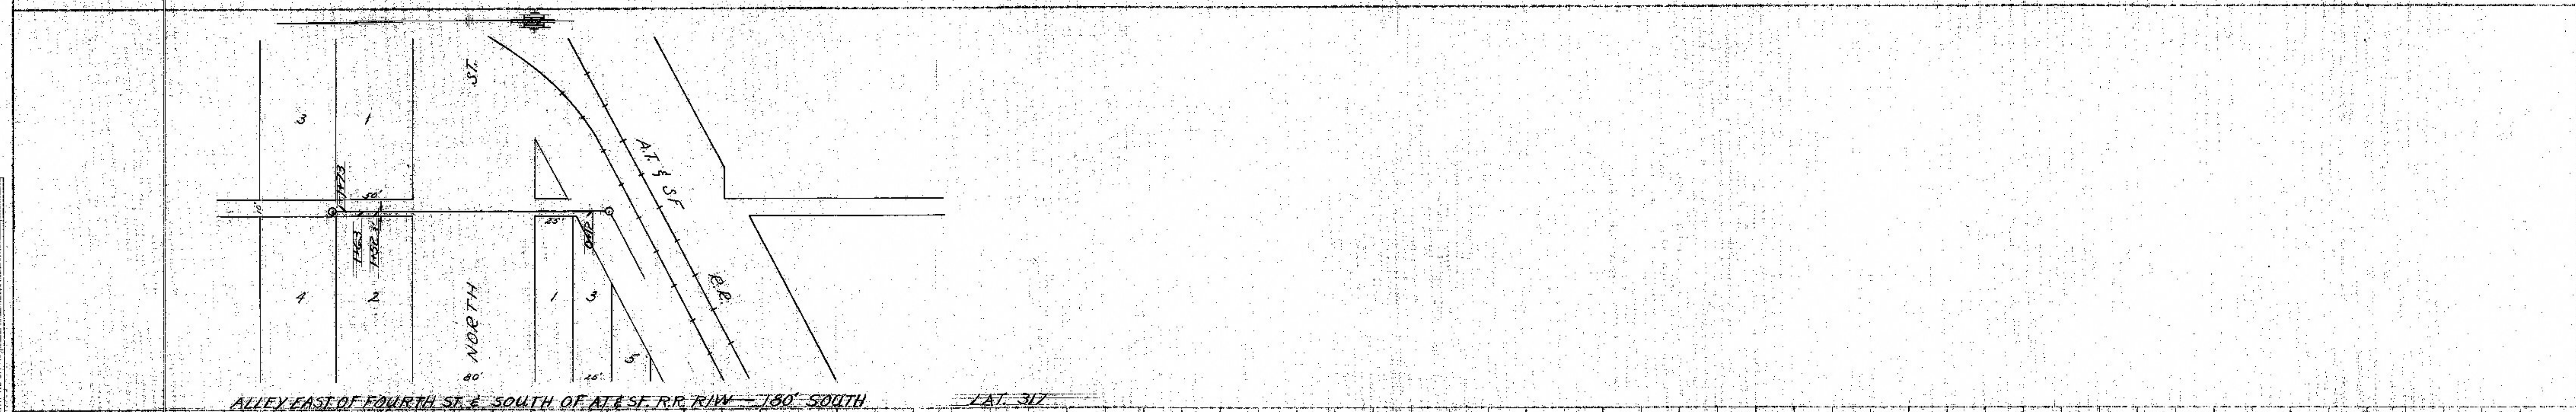
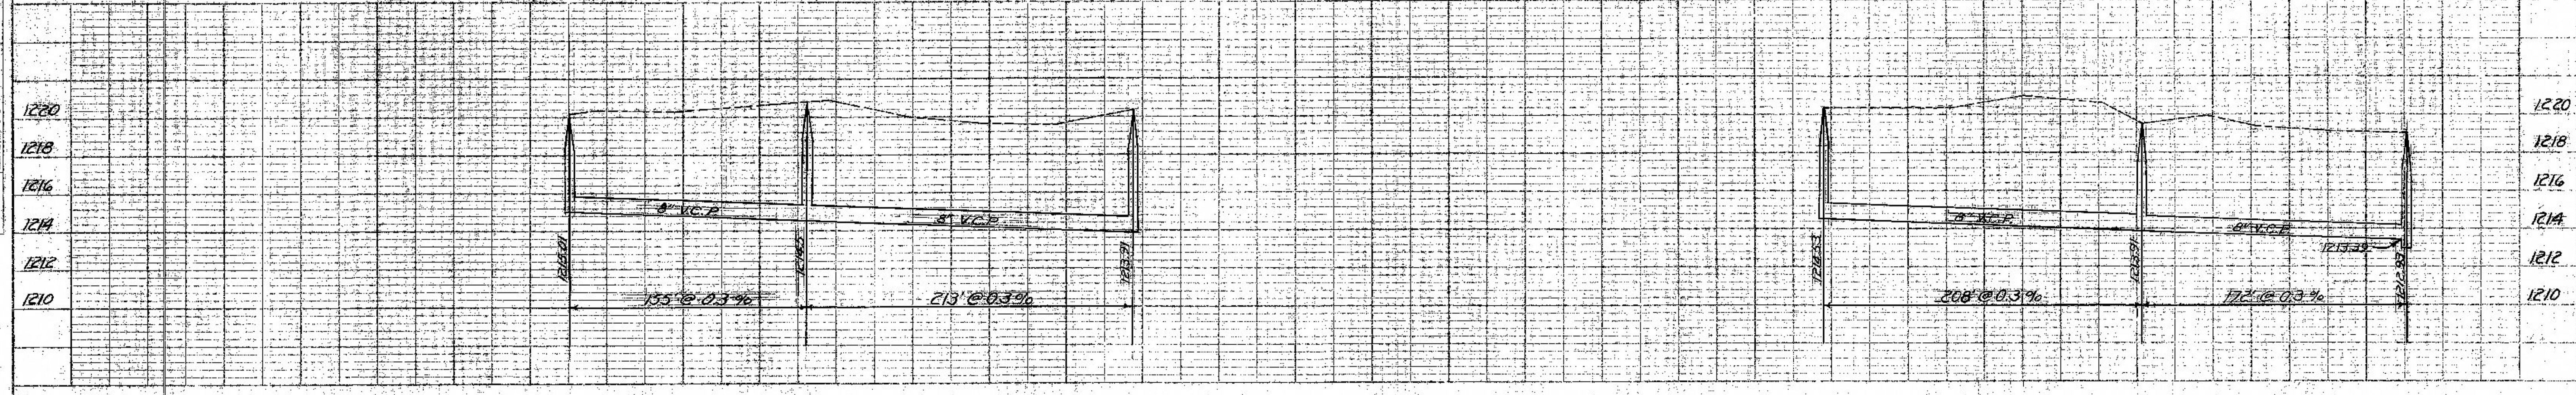


PLAN
 SURVEYED: _____
 PLOTTED: _____
 NOTE BOOK: _____
 NO. _____

PROFILE
 SURVEYED: _____
 PLOTTED: _____
 NOTE BOOK: _____
 NO. _____

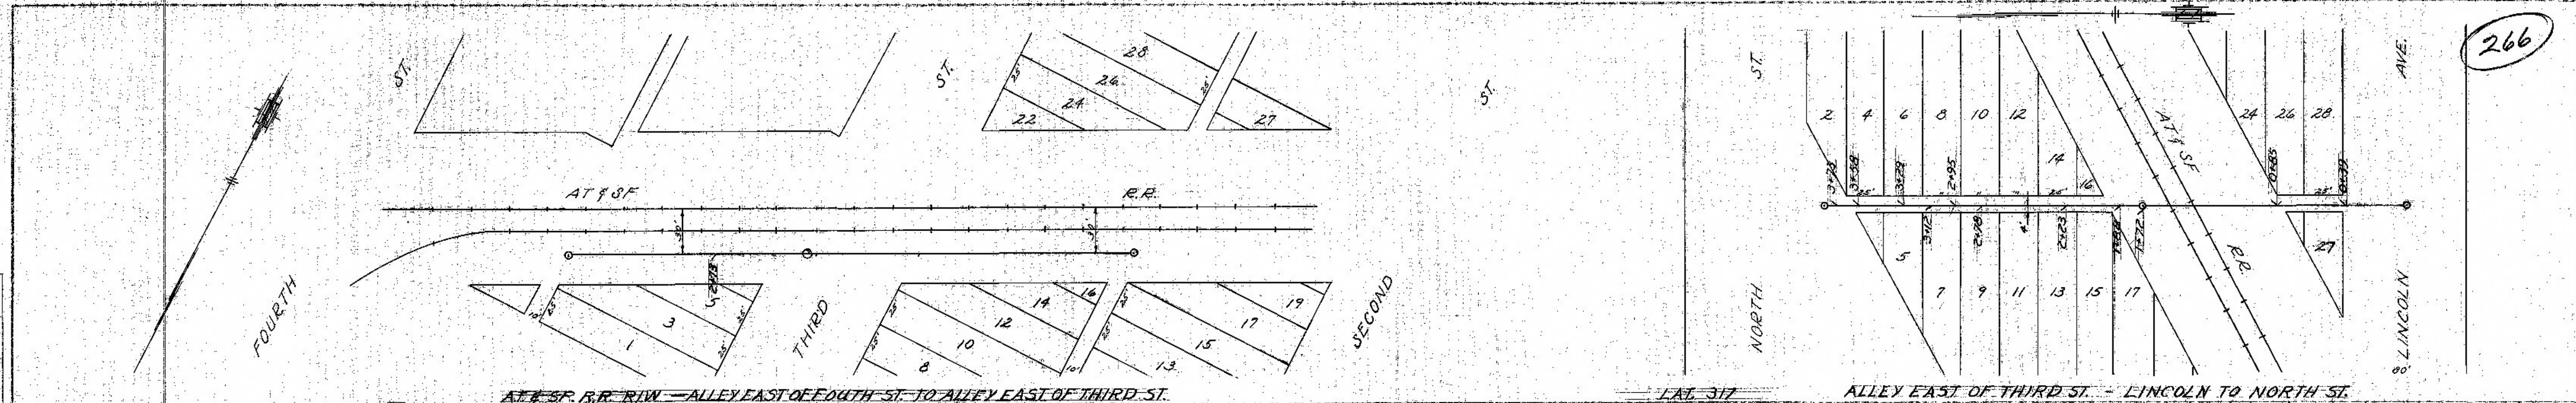

SANITARY SEWER
 "AS BUILT PLAN"
 Const. By: H.H. Taylor Const. Co.
 H.E. Harper Engineer