

RIW EAST OF SHAWNEE AVE. TO 140' NORTH.

RIW EAST OF SEMINOLE AVE. TO 120' NORTH & 30' EAST.

RIW WEST OF SEMINOLE AVE. TO 360' NORTH & 400' EAST.

1230

1225

1230

1225

1230

1225

1230


1225

1230

1225

1230

1225

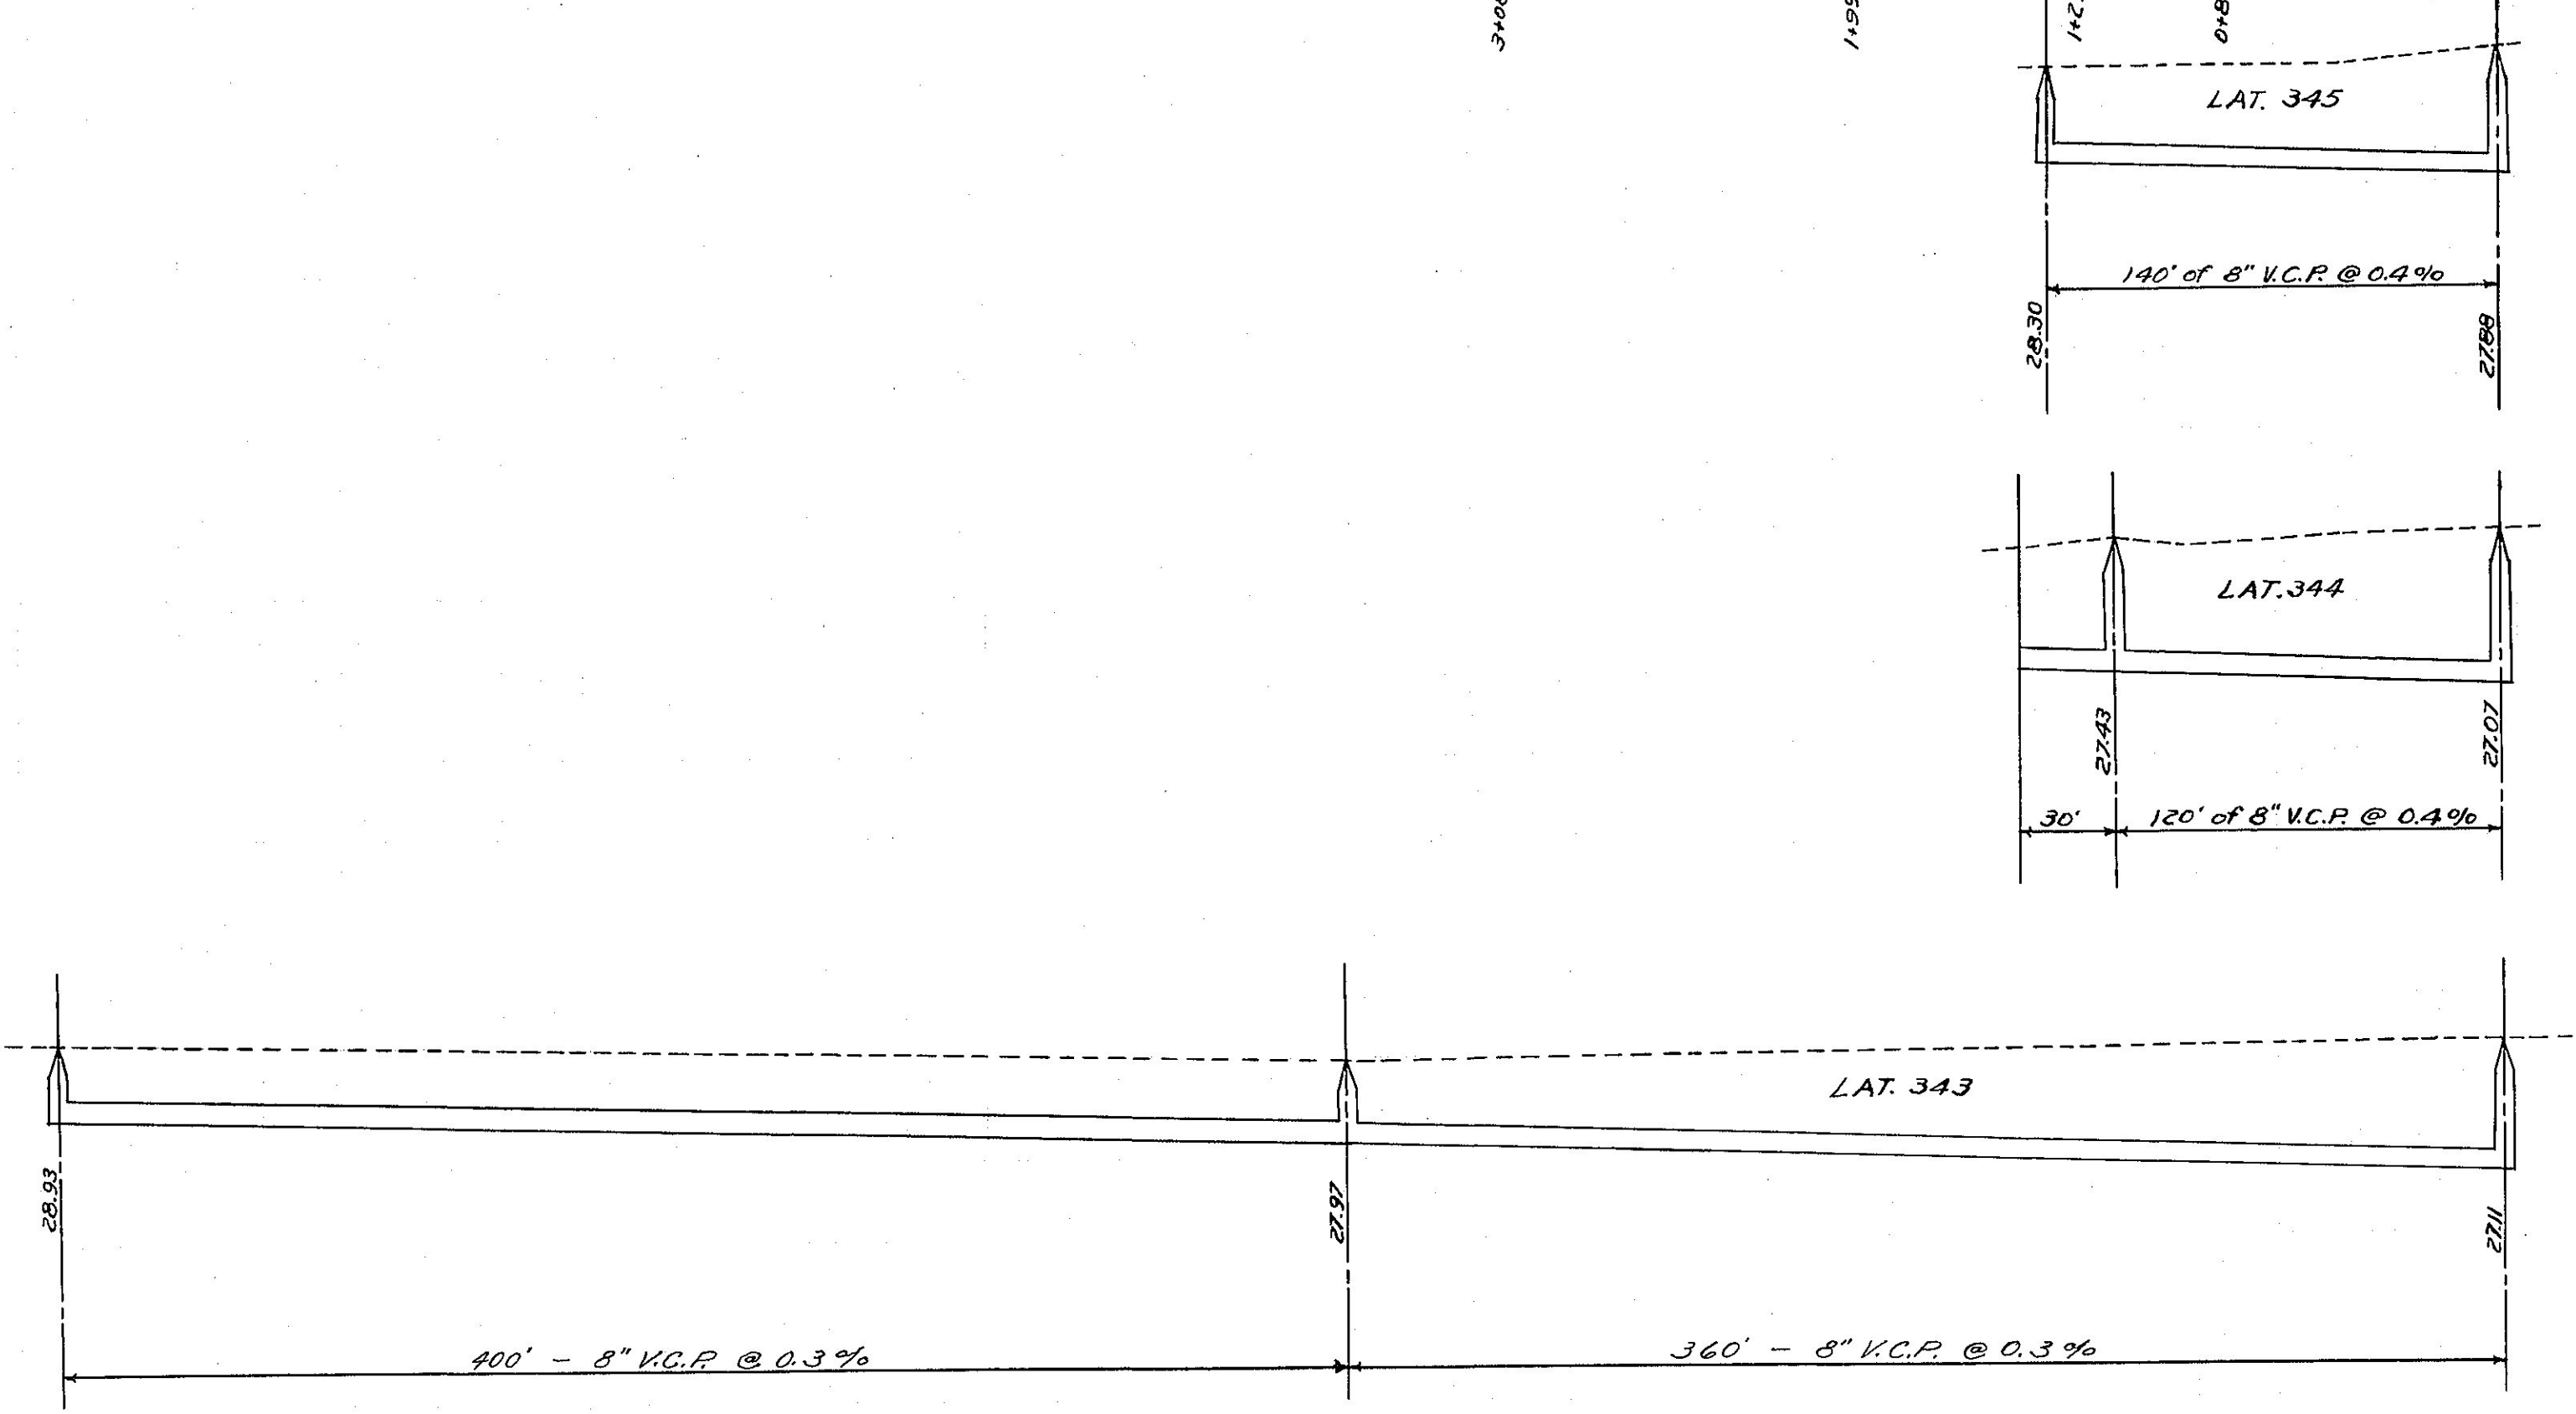

SANITARY SEWER
 "AS BUILT PLAN"
 Const. By H.J. Taylor Const. Co.
 April 1956
 H.F. Harper Engineer