



1218  
1216  
1214  
1212  
1210  
1208  
1206


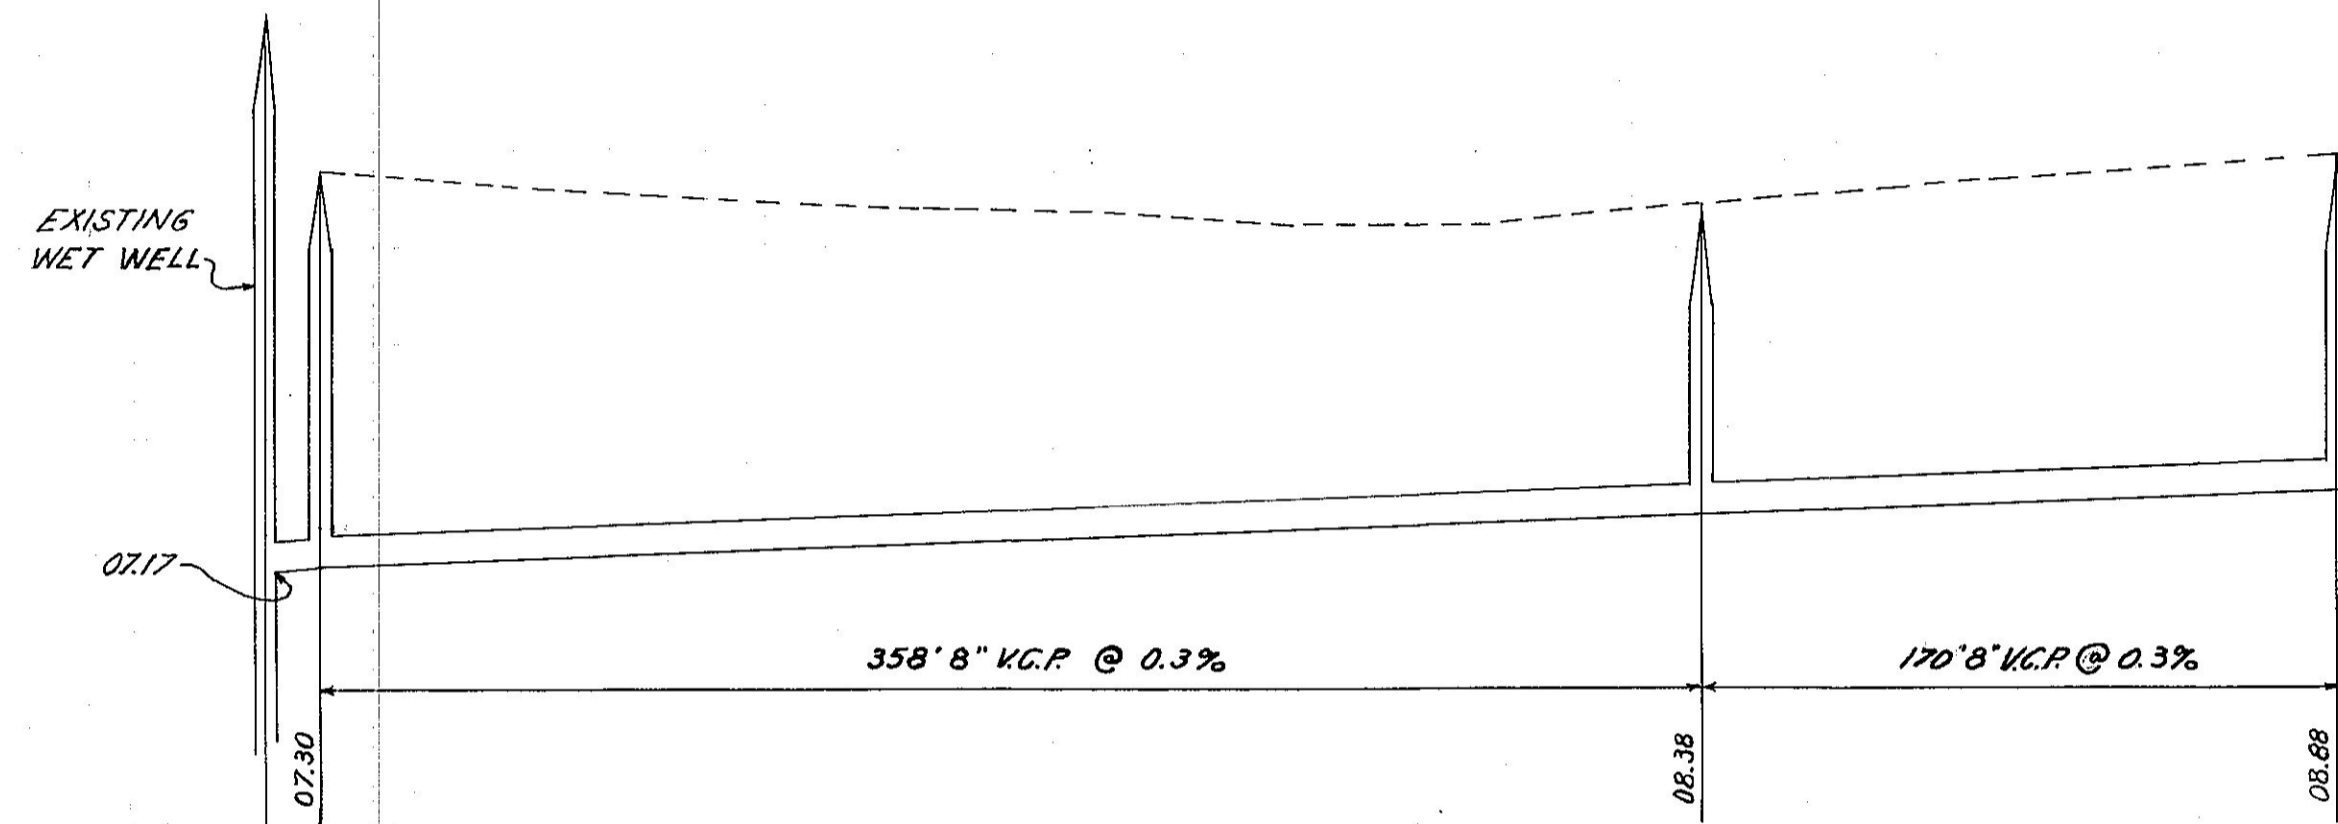


LAT. 328

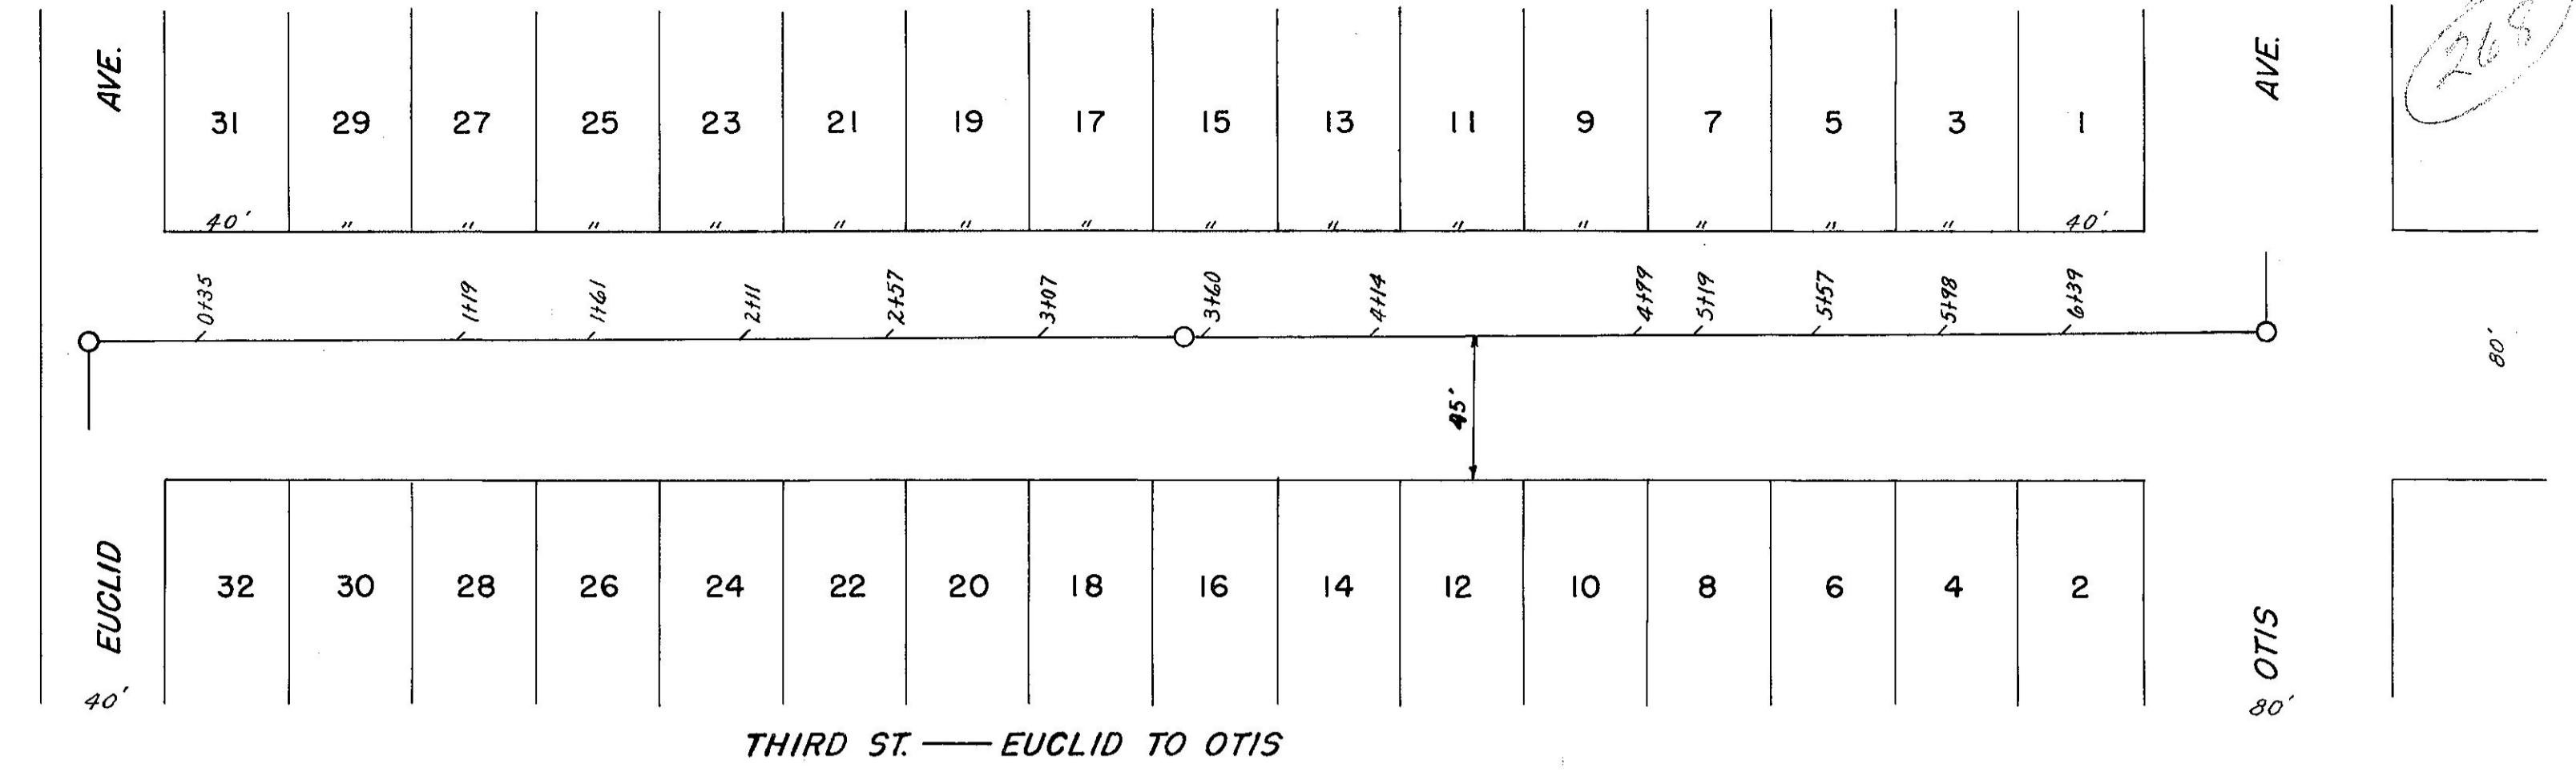


269


1218  
1216  
1214  
1212  
1210  
1208  
1206

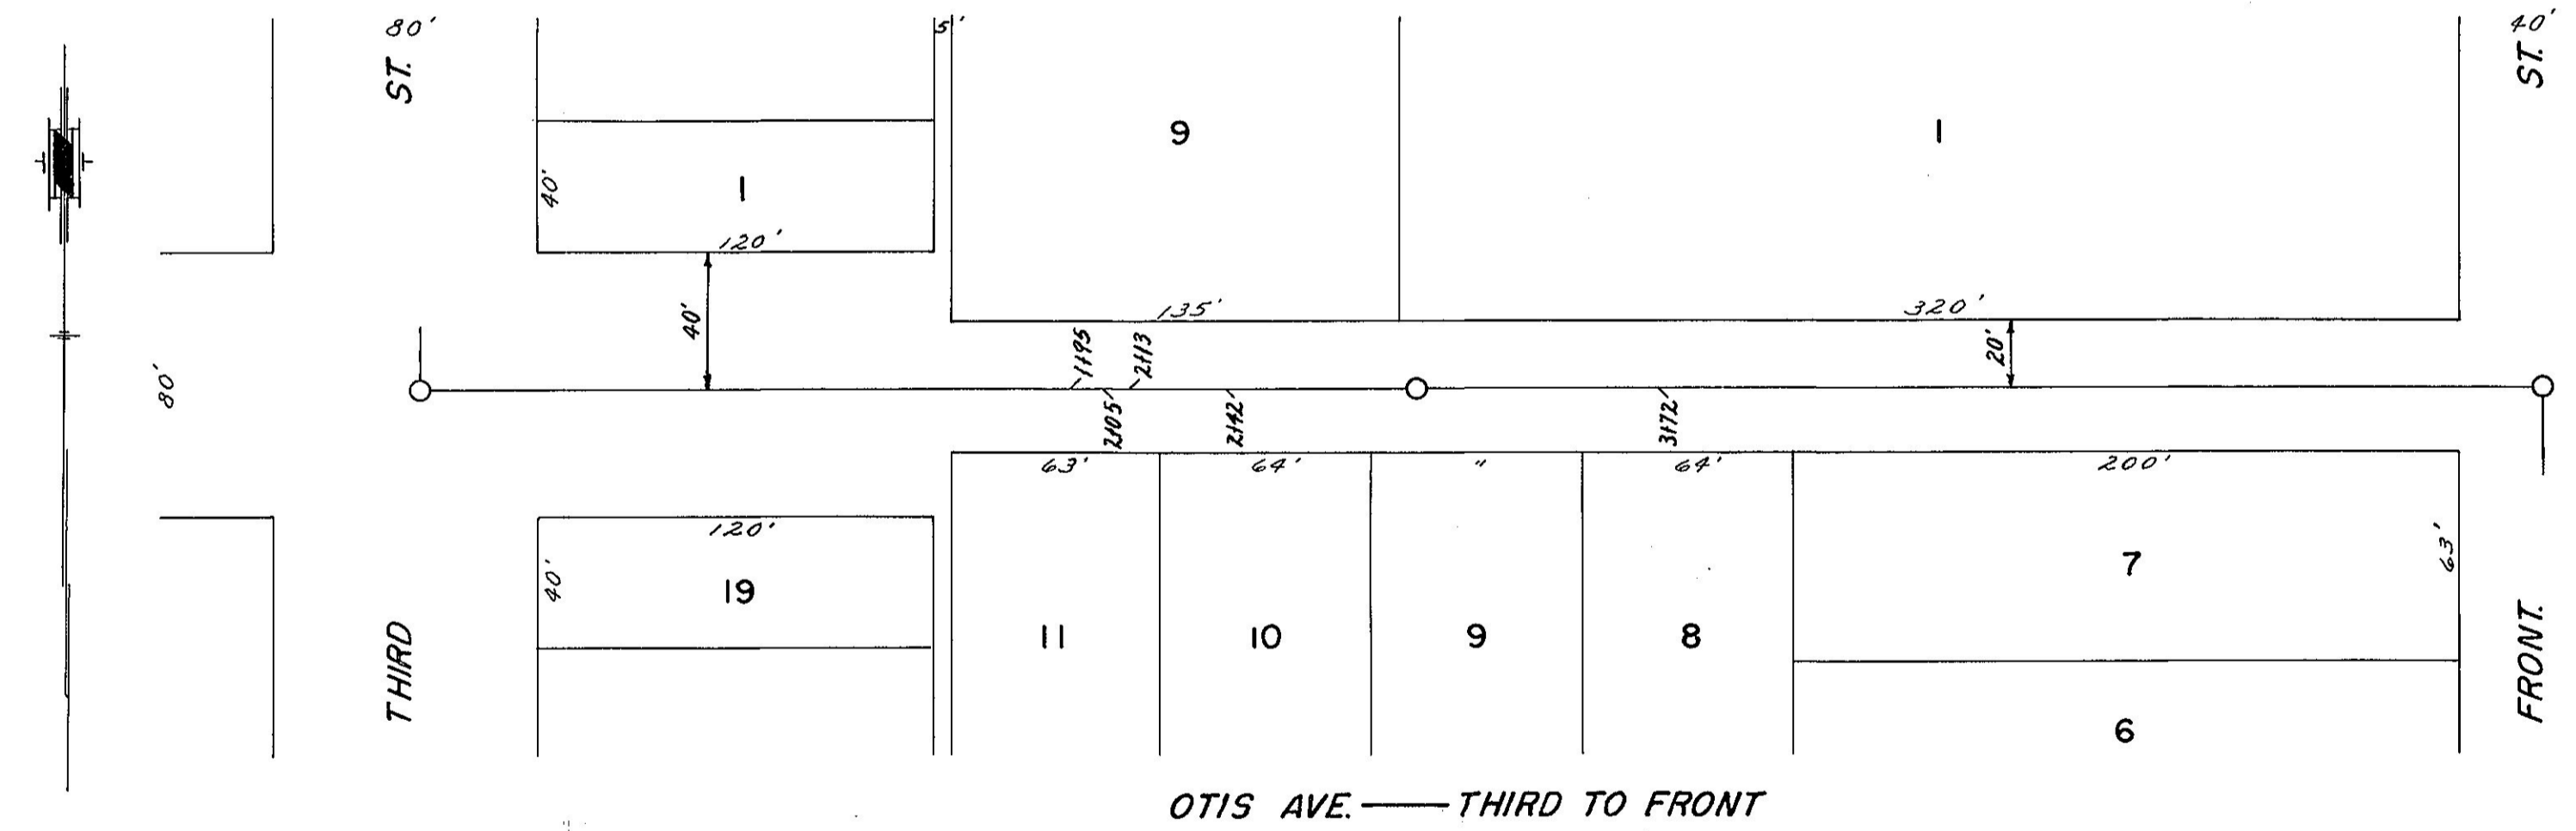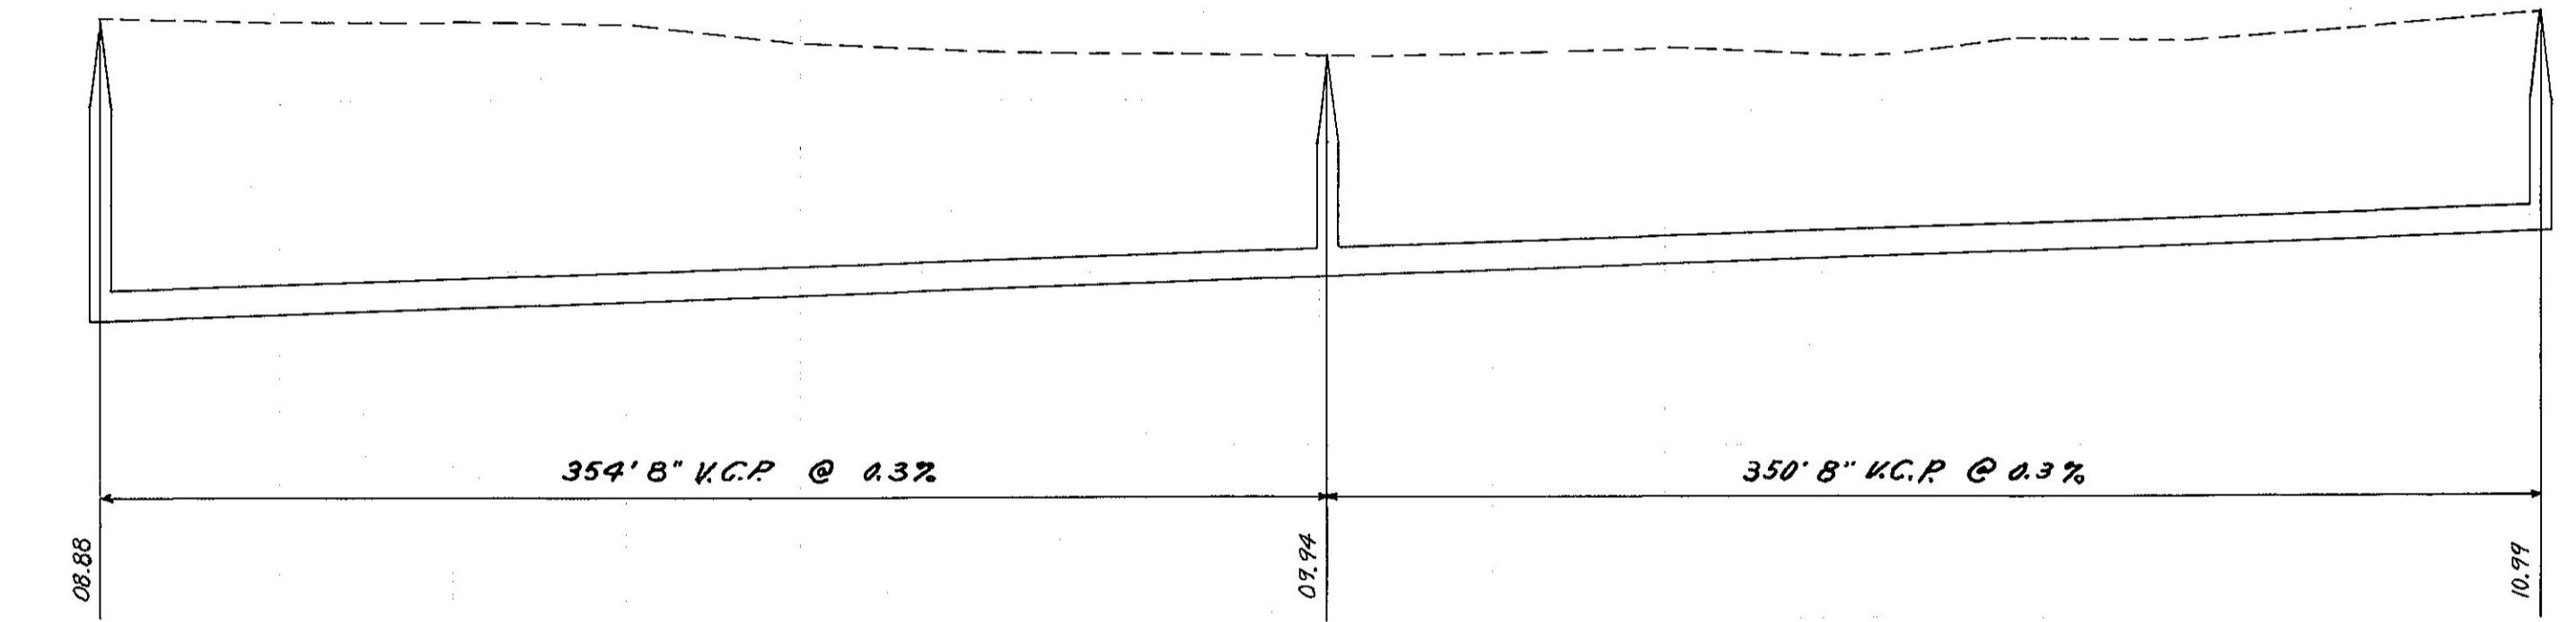

1218  
1216  
1214  
1212  
1210  
1208  
1206

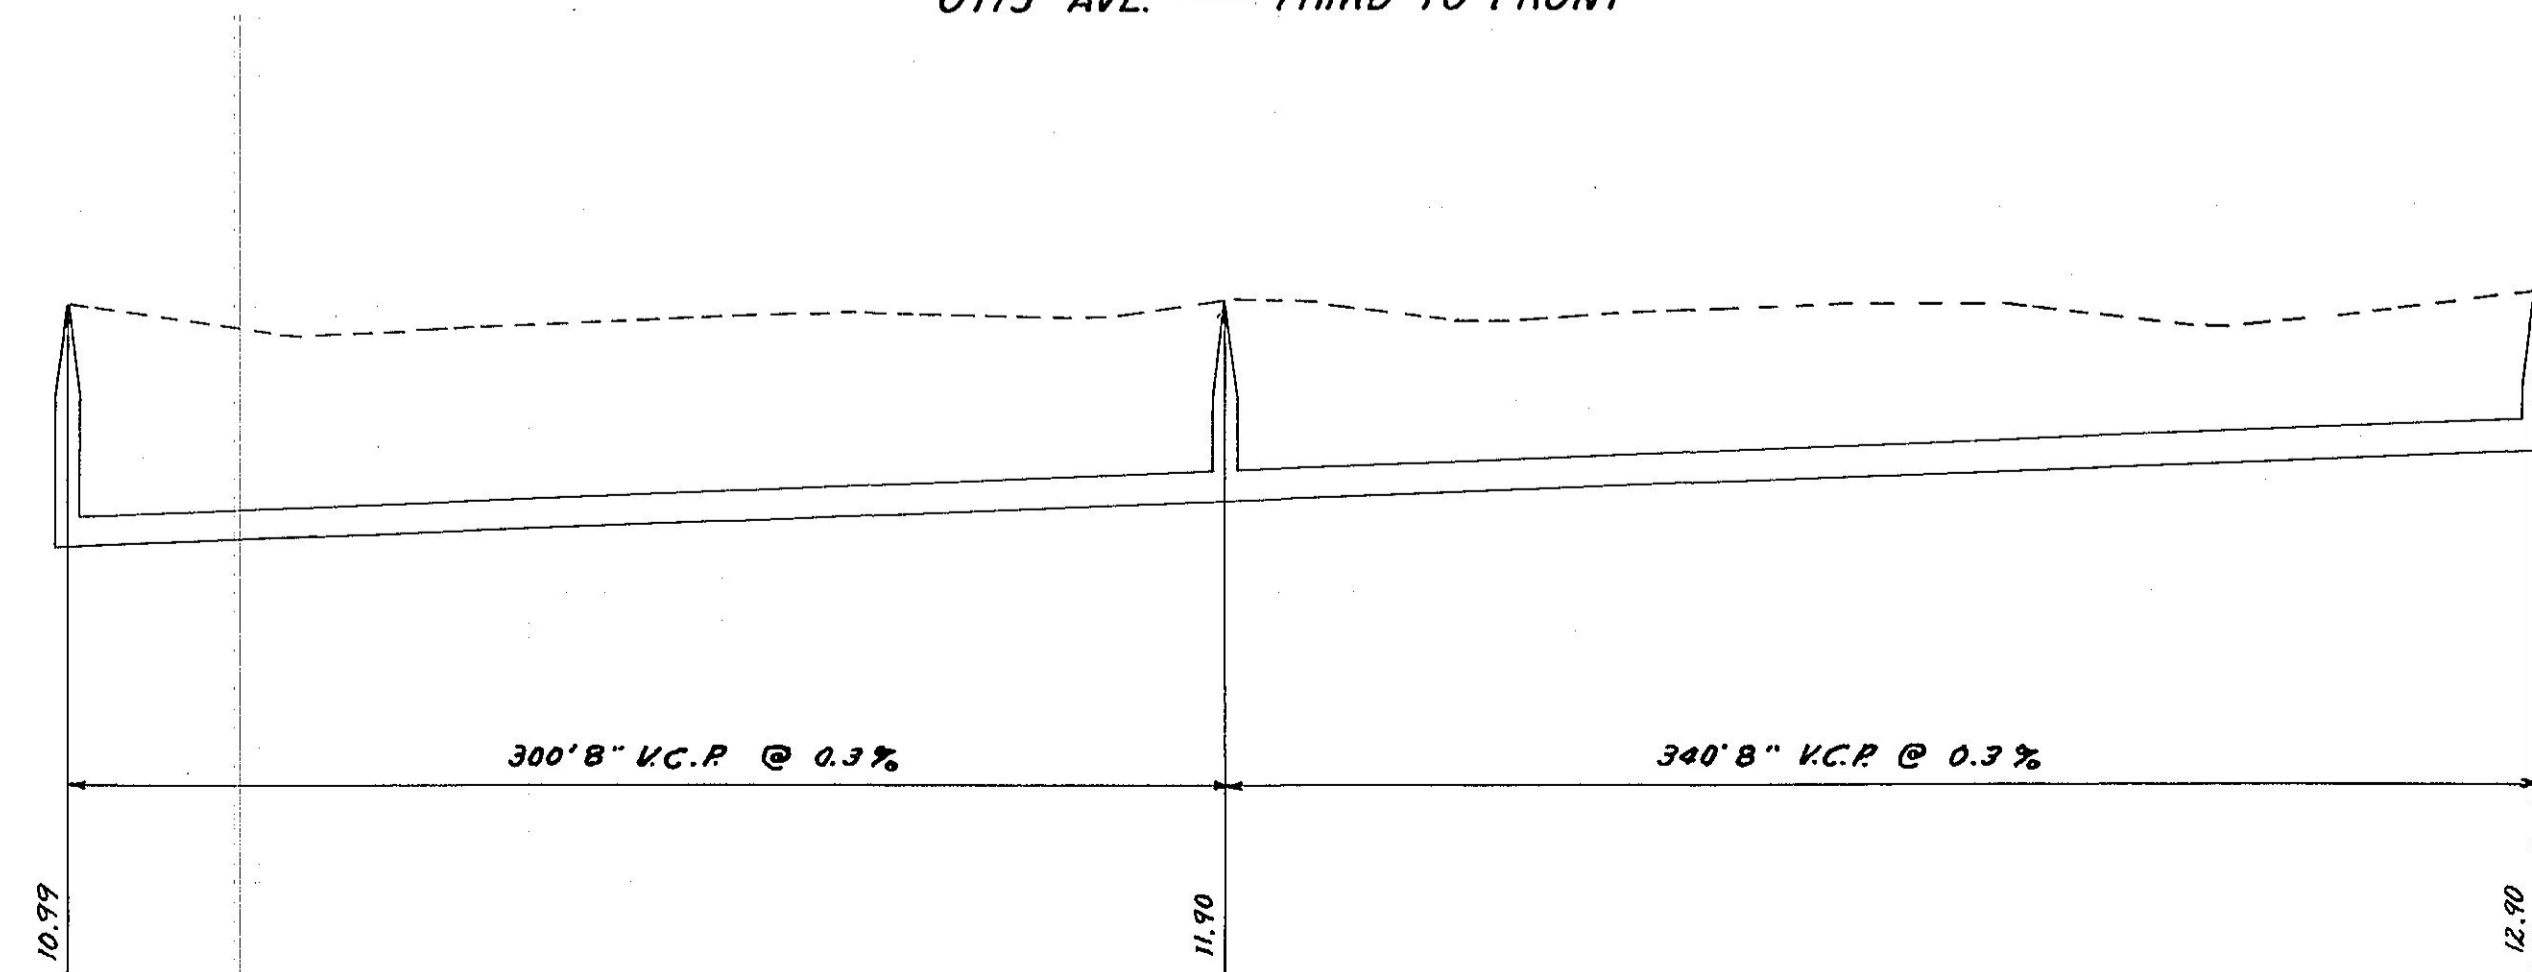

LAT 328

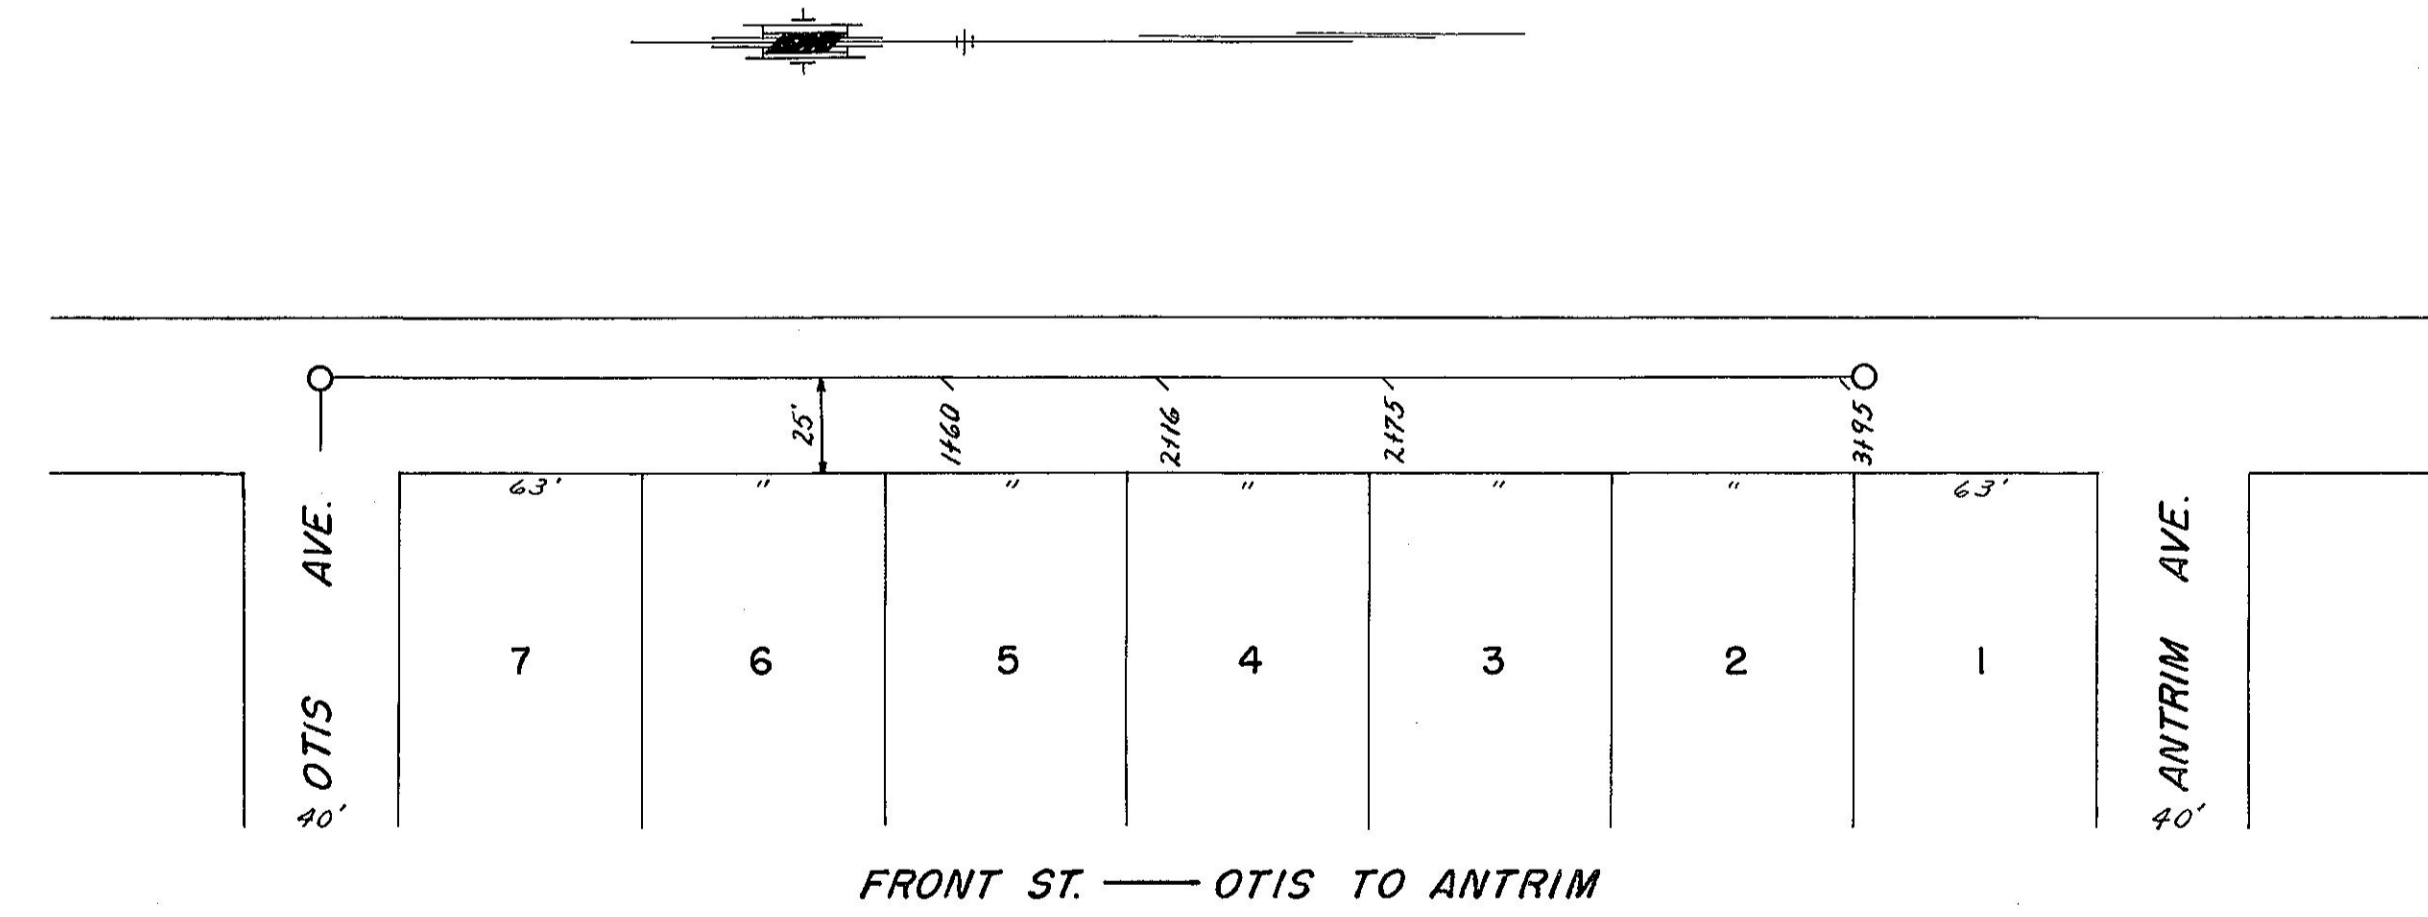

"AS BUILT PLAN"  
Const. by H.C. Taylor  
Jan. 1956  
H.F. Harper - City Eng.

1218  
1216  
1214  
1212  
1210  
1208  
1206

