


269



R/W W. OF BEACH ST. TO 550' SO.

R/W W. OF OAK ST. TO 208' SO.

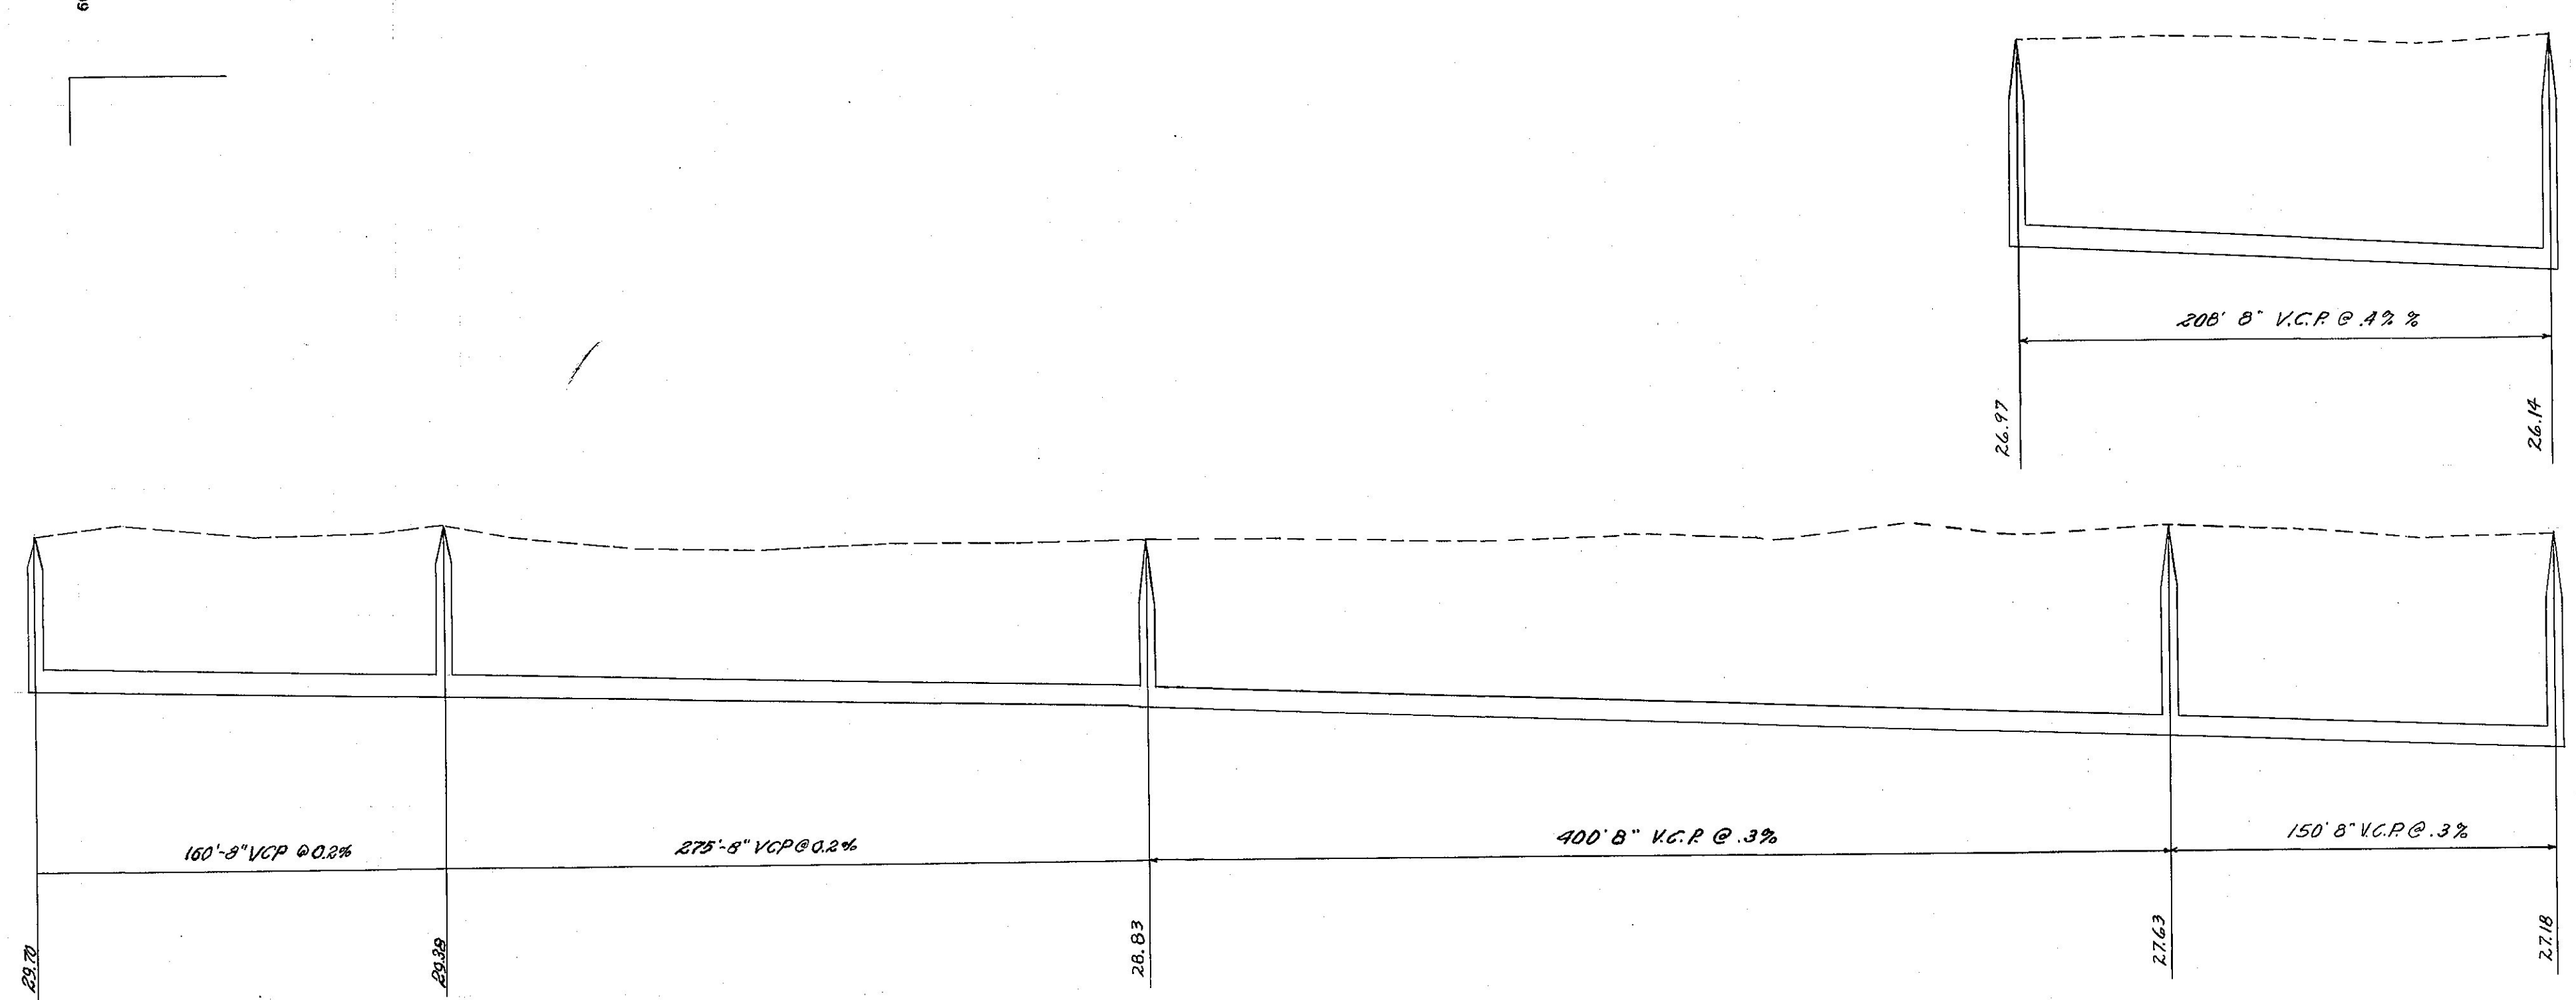

"AS BUILT PLAN"
 Const. by Michaelson Const Co.
 Feb. 1956
 H.F. Harper - City Engr.

- 1234
- 1232
- 1230
- 1228
- 1226
- 1224

- 1234
- 1232
- 1230
- 1228
- 1226
- 1224