

1236

1234

1232

1230

1228

1226

1224

1236

1234


1232

1230

1228

1226

1224

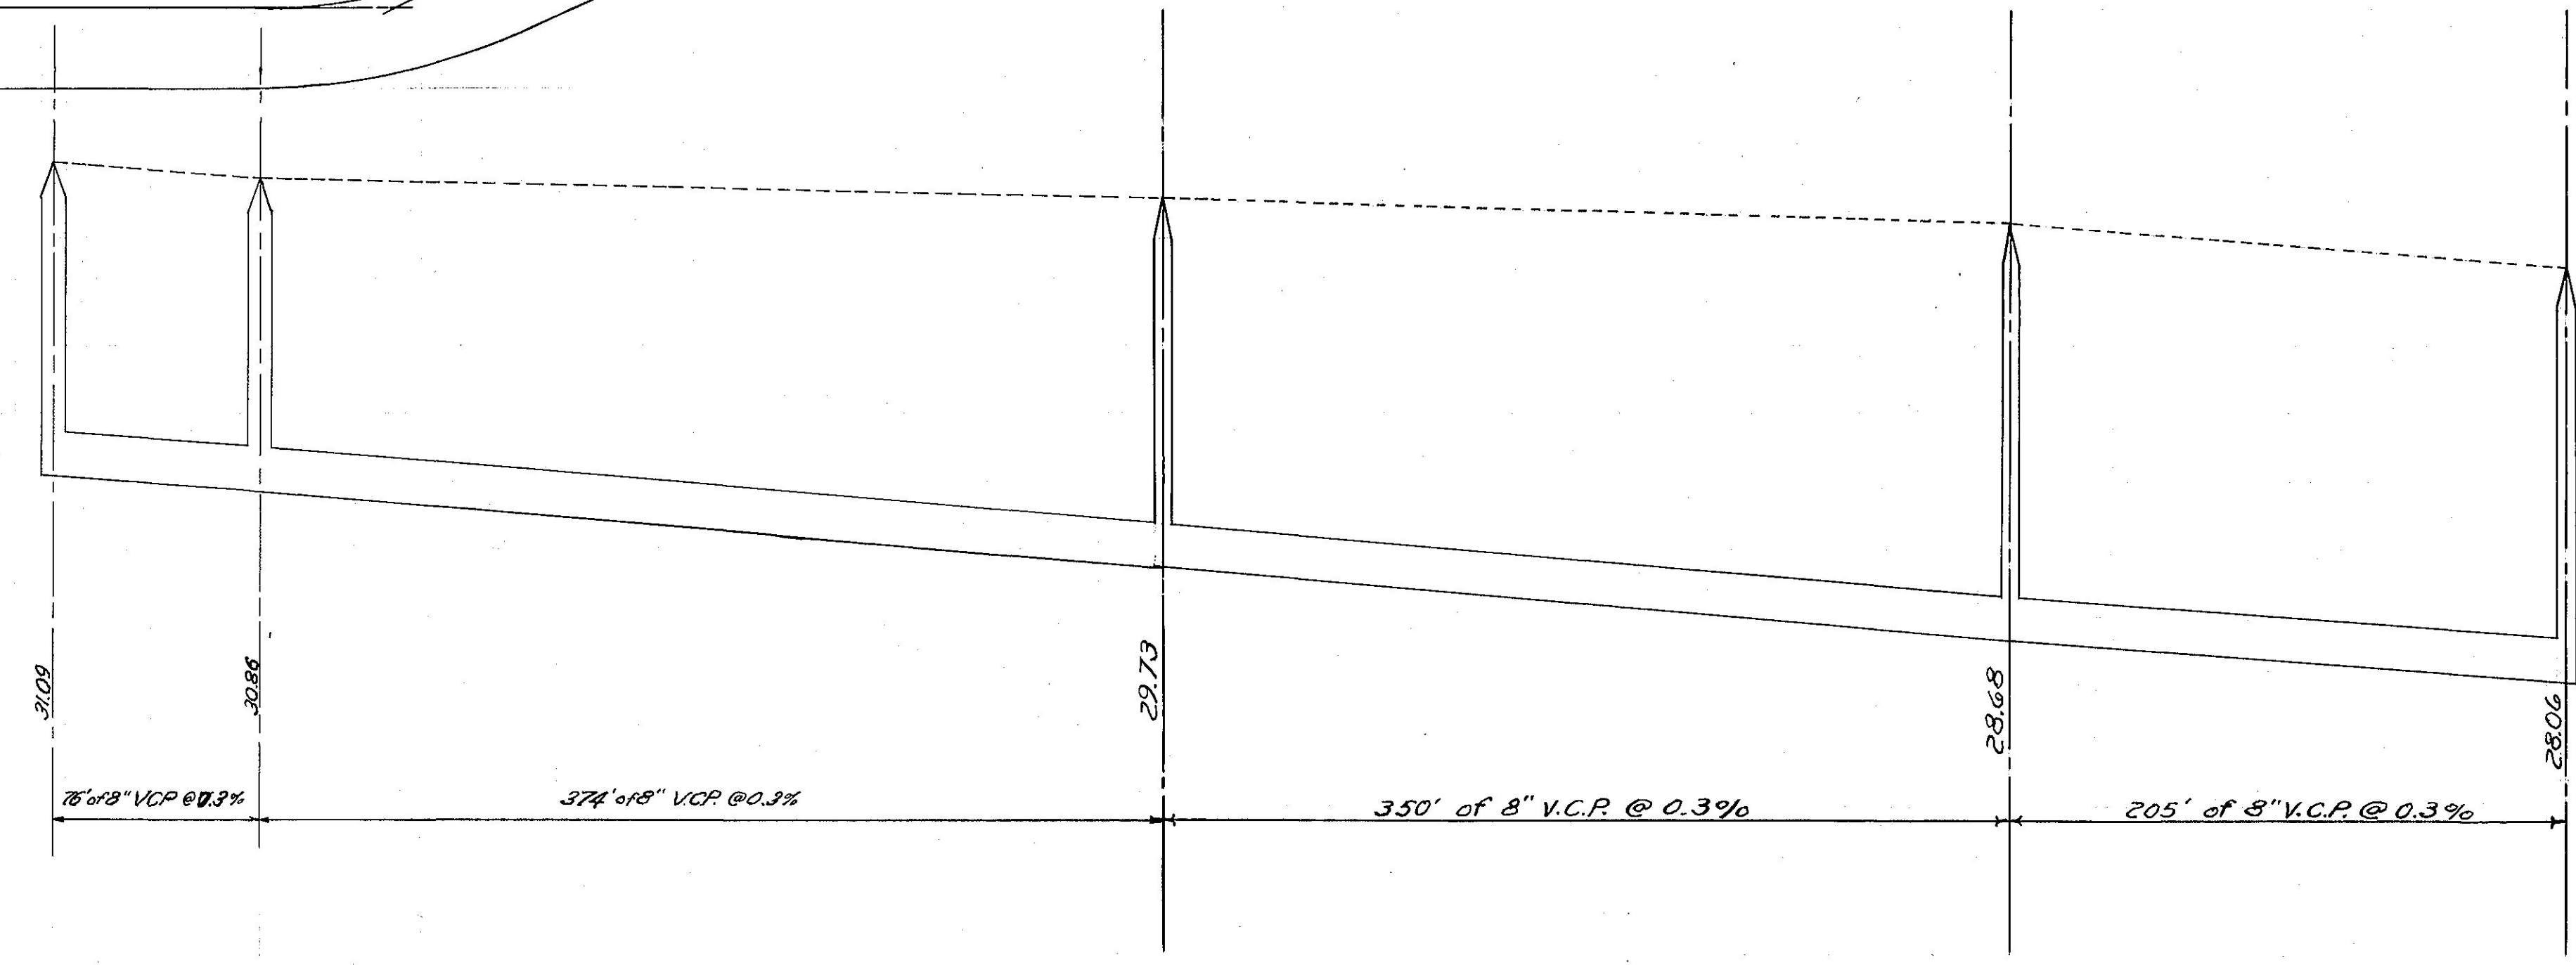

SANITARY SEWER
 "AS BUILT PLAN"
 CONST. BY MICHAELSEN CONST.CO.
 FEBRUARY 1956
 H.F. HARPER — CITY ENGR.