

271

PLAN

DATE \_\_\_\_\_

BY \_\_\_\_\_

REVISIONS:

NO. 1. DATE \_\_\_\_\_

NO. 2. DATE \_\_\_\_\_

NO. 3. DATE \_\_\_\_\_

NO. 4. DATE \_\_\_\_\_

NO. 5. DATE \_\_\_\_\_

NO. 6. DATE \_\_\_\_\_

NO. 7. DATE \_\_\_\_\_

NO. 8. DATE \_\_\_\_\_

NO. 9. DATE \_\_\_\_\_

NO. 10. DATE \_\_\_\_\_

NOTE BOOK: \_\_\_\_\_

ALIGNMENT CHECKED: \_\_\_\_\_

RT. OF WAY CHECKED: \_\_\_\_\_

PROFILE

DATE \_\_\_\_\_

BY \_\_\_\_\_

REVISIONS:

NO. 1. DATE \_\_\_\_\_

NO. 2. DATE \_\_\_\_\_

NO. 3. DATE \_\_\_\_\_

NO. 4. DATE \_\_\_\_\_

NO. 5. DATE \_\_\_\_\_

NO. 6. DATE \_\_\_\_\_

NO. 7. DATE \_\_\_\_\_

NO. 8. DATE \_\_\_\_\_

NO. 9. DATE \_\_\_\_\_





NO. 10. DATE \_\_\_\_\_

NOTE BOOK: \_\_\_\_\_

GRADES CHECKED: \_\_\_\_\_

D. M. 1. NOTED: \_\_\_\_\_

STRUCTURE NOTING: \_\_\_\_\_

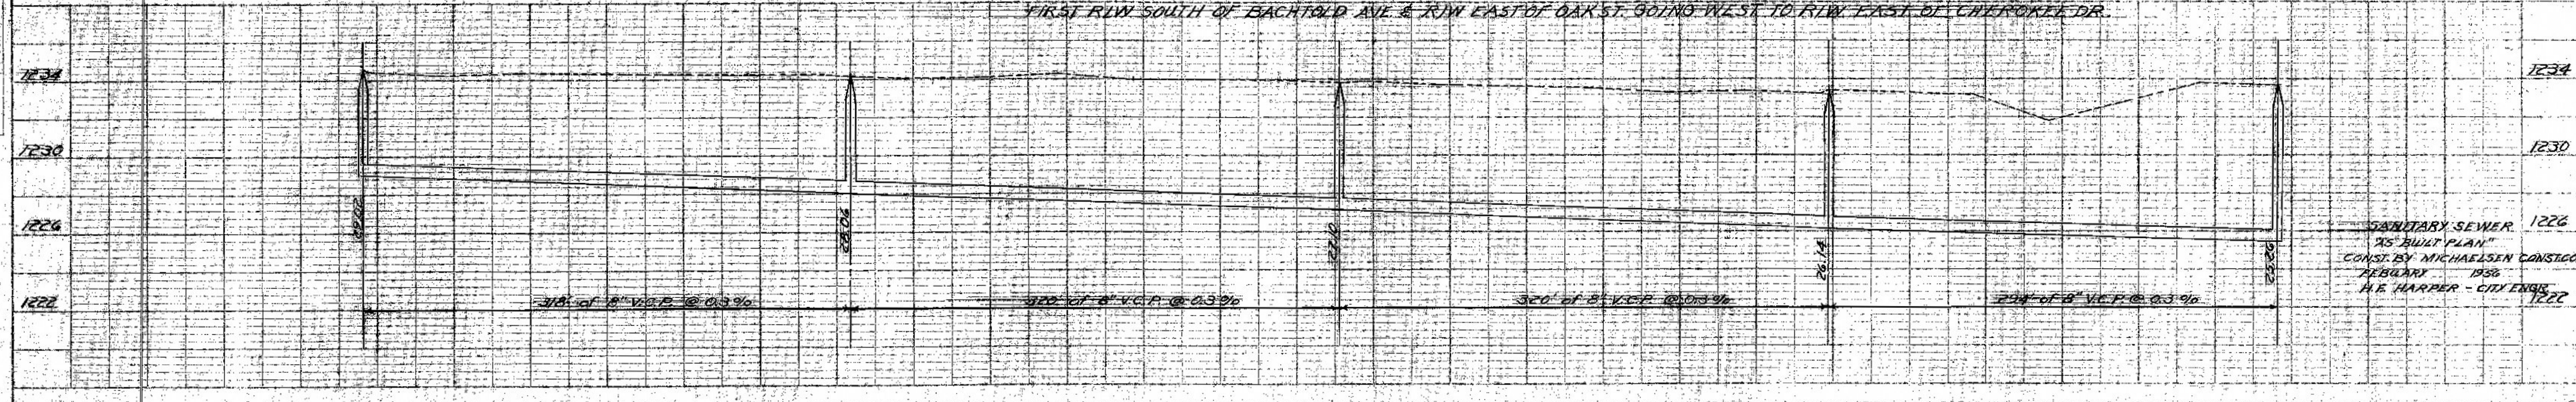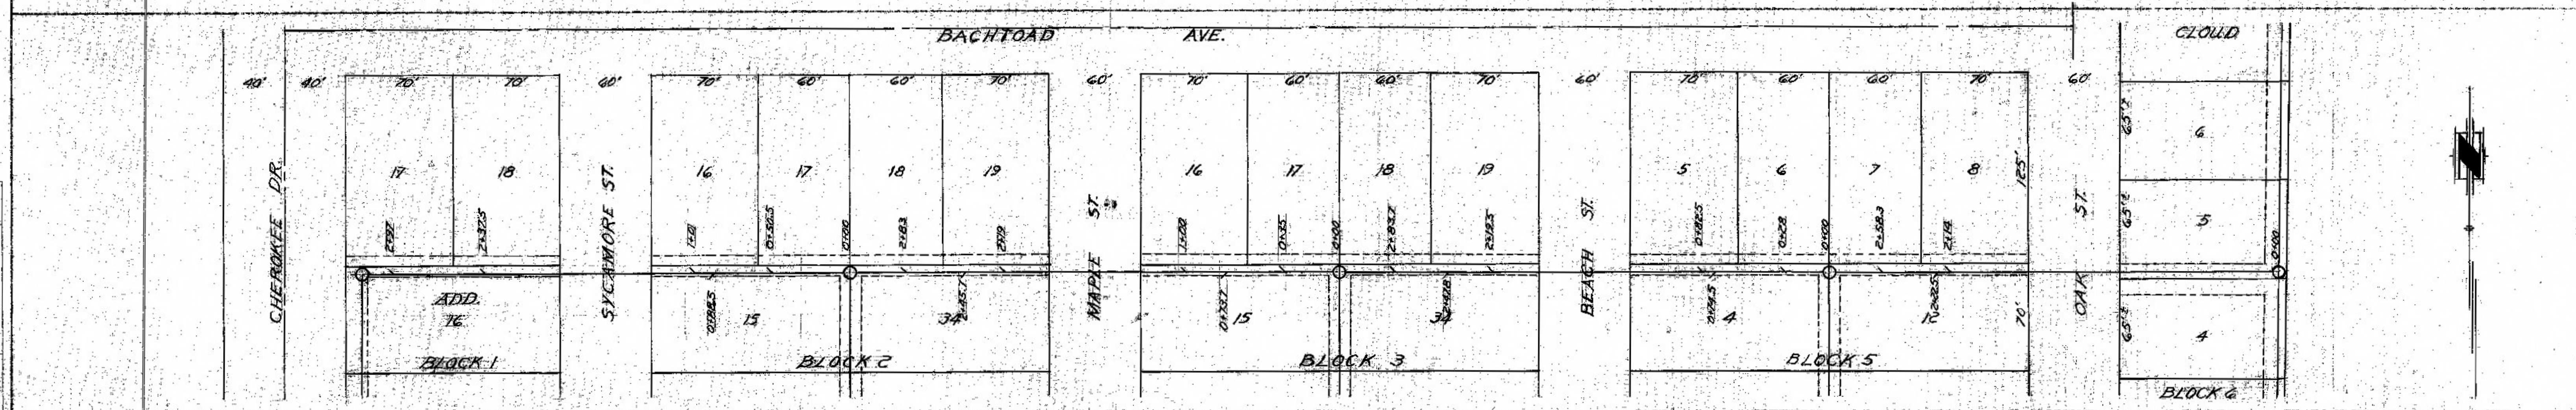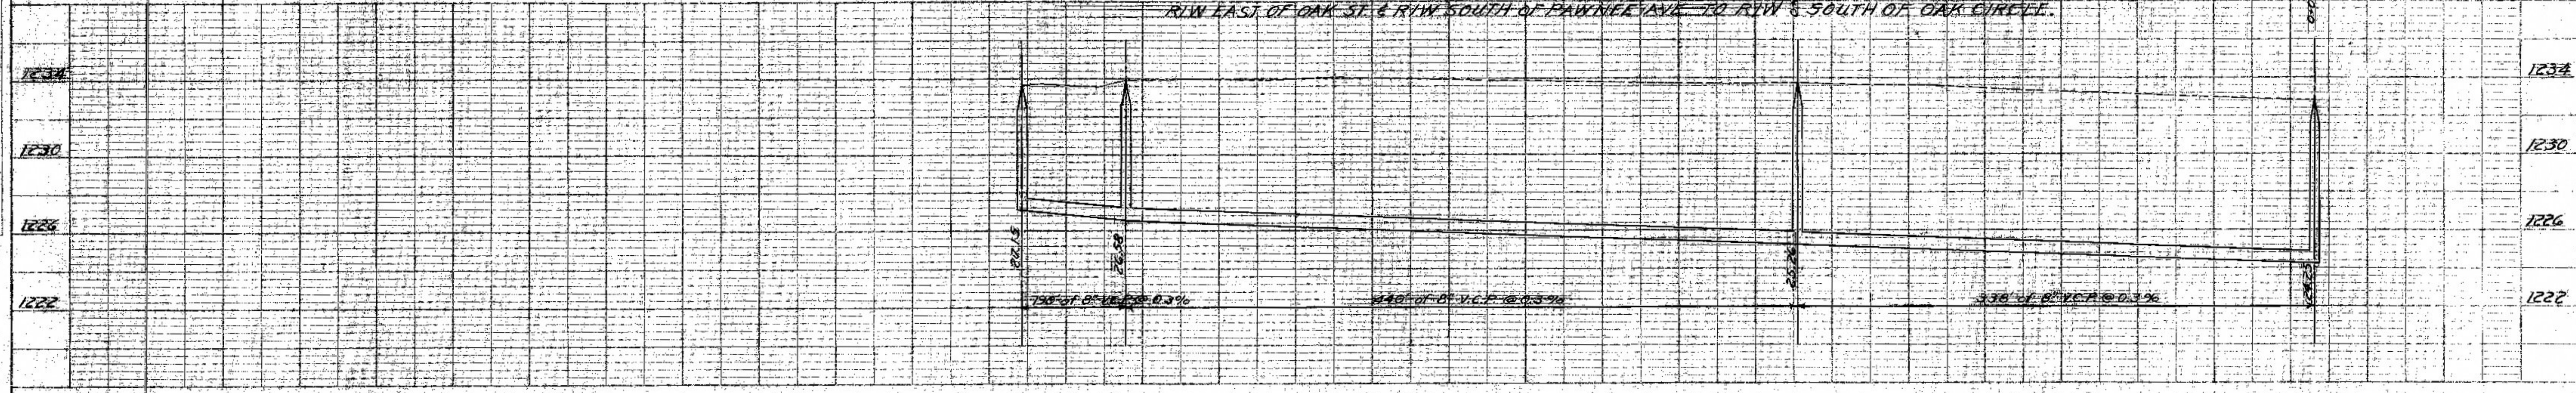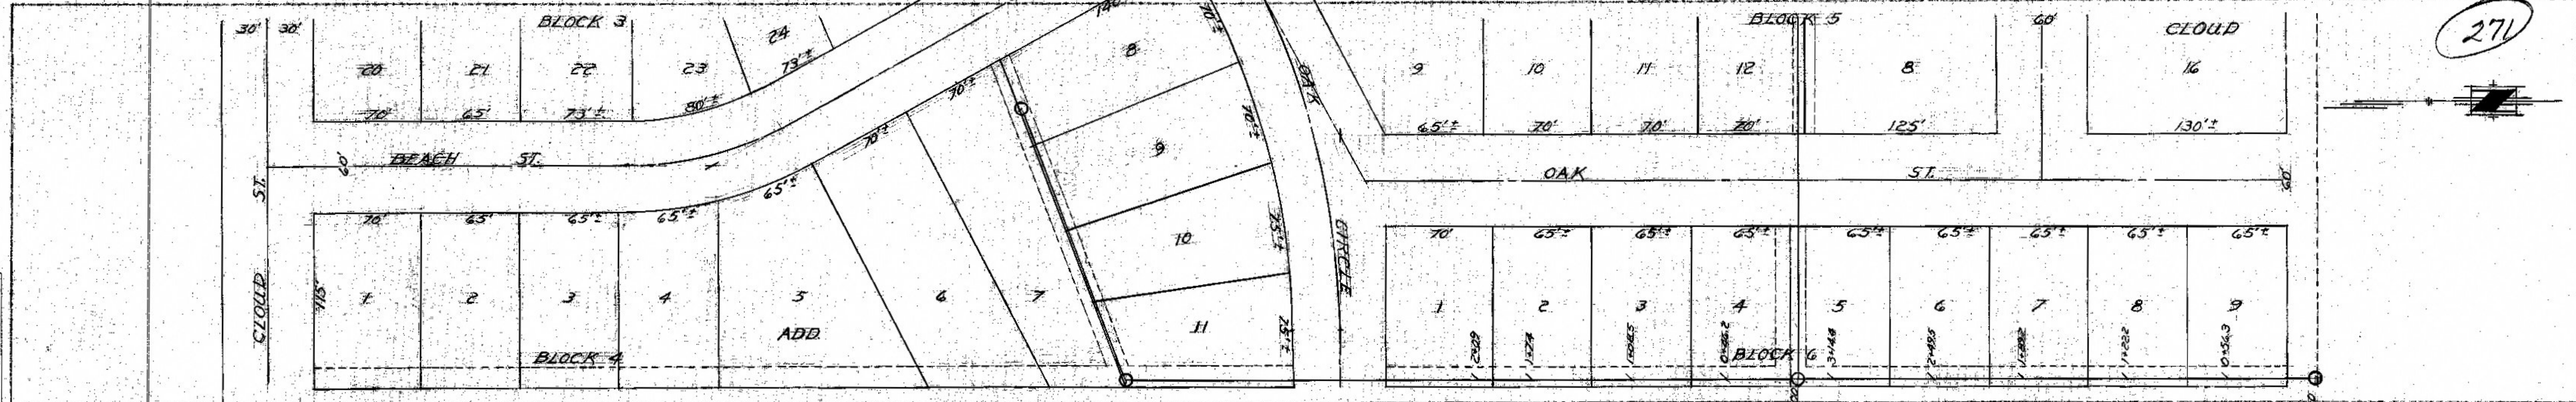

SANITARY SEWER 1226

AS BUILT PLAN

CONSTR. BY MICHAELSEN CONSTR.

FEBRUARY 1936

H. E. HARPER - CITY ENGR.