




272

PLAN
 SURVEYED
 DATE
 PLOTTED
 DATE
 CHECKED
 DATE
 NO. OF SHEETS
 THIS SHEET NO.



PROFILE
 SURVEYED
 DATE
 PLOTTED
 DATE
 CHECKED
 DATE
 NO. OF SHEETS
 THIS SHEET NO.

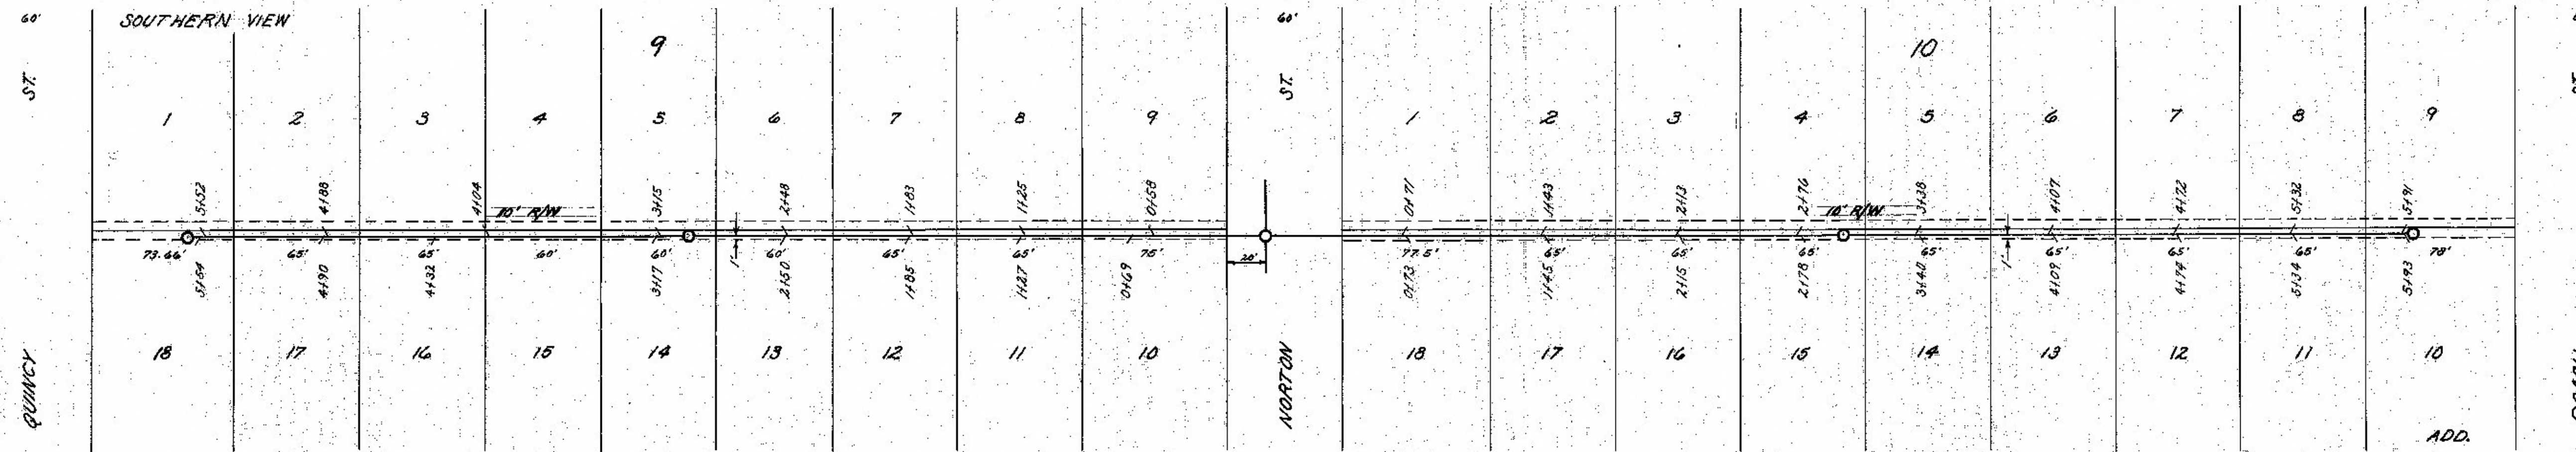

LAT 341 R/W No. of LESLIE from NORTON to 560' W. & 597' E. LAT 342

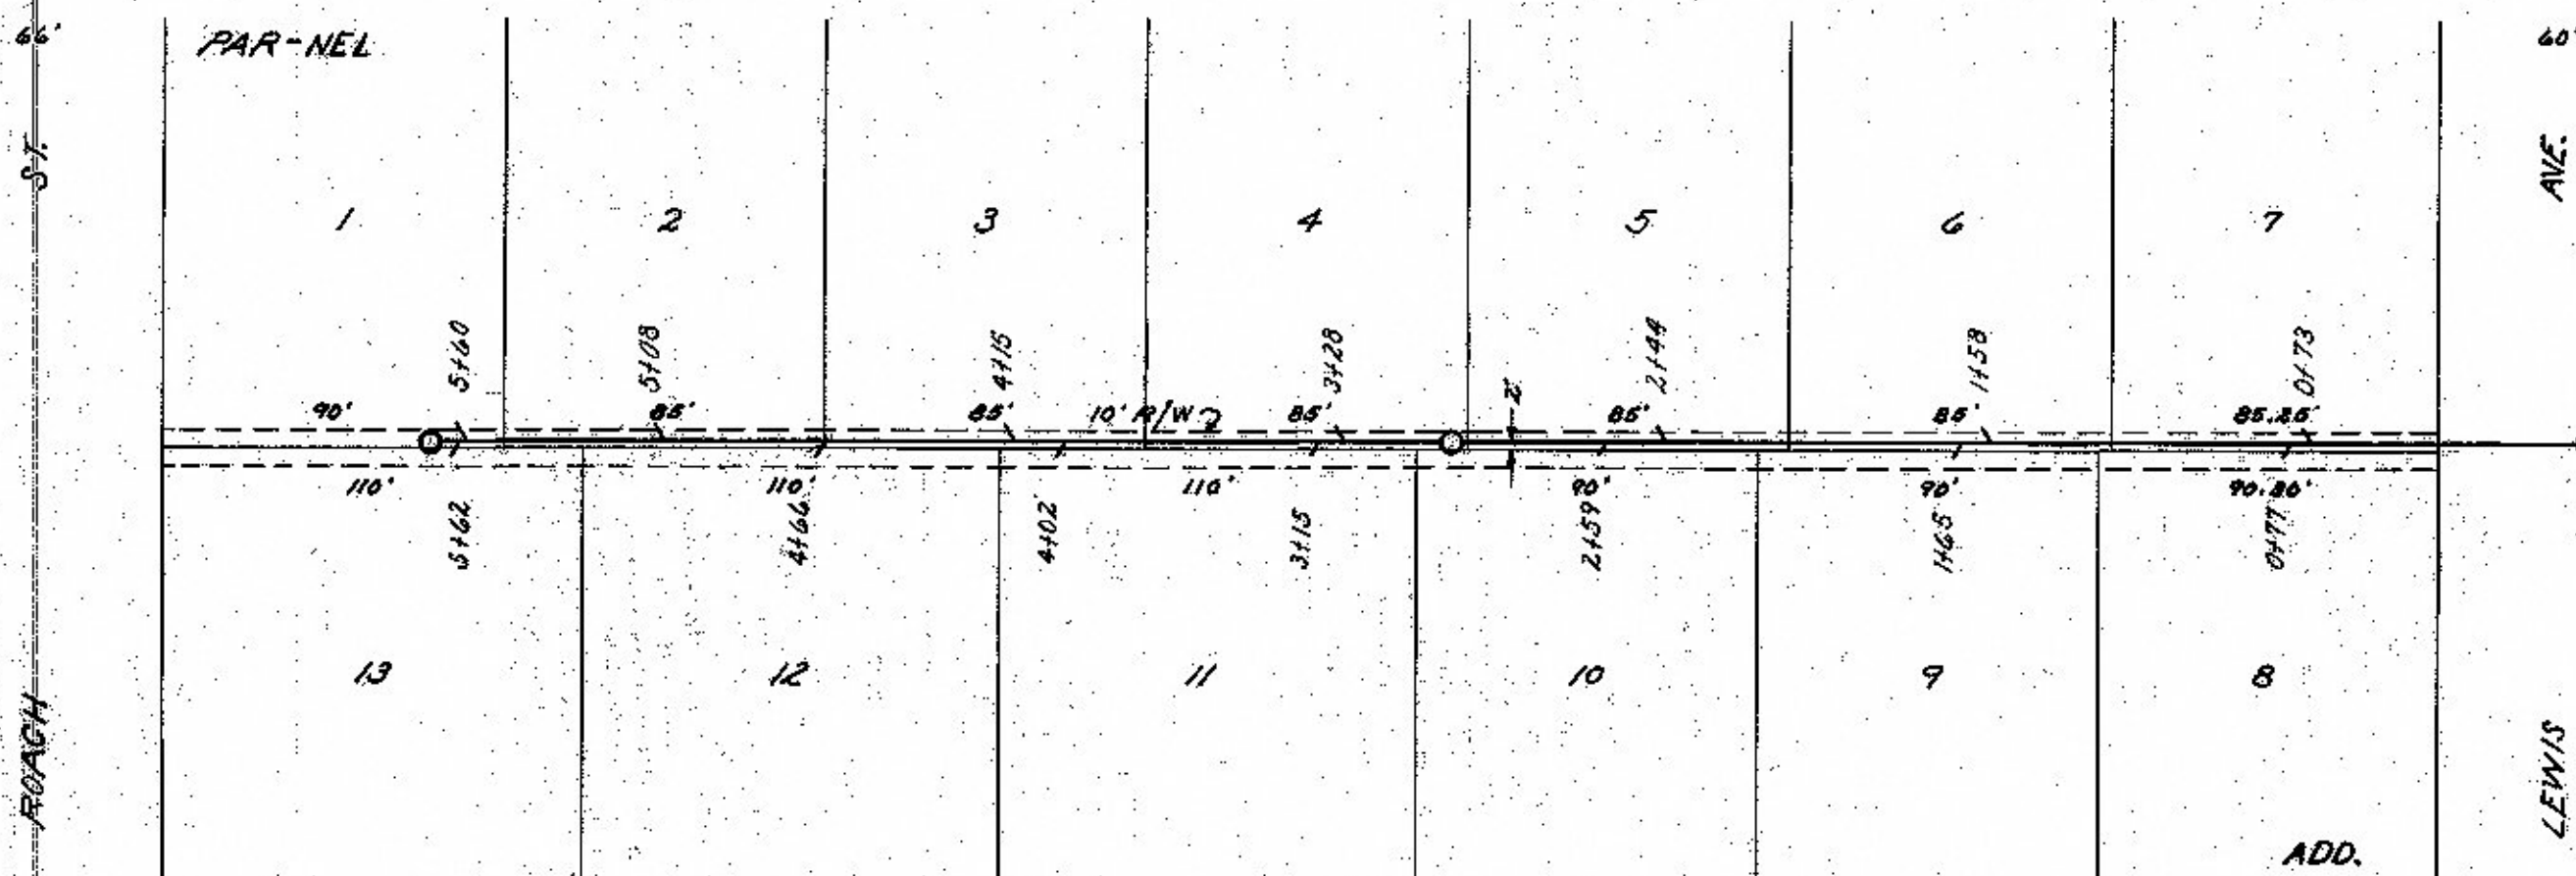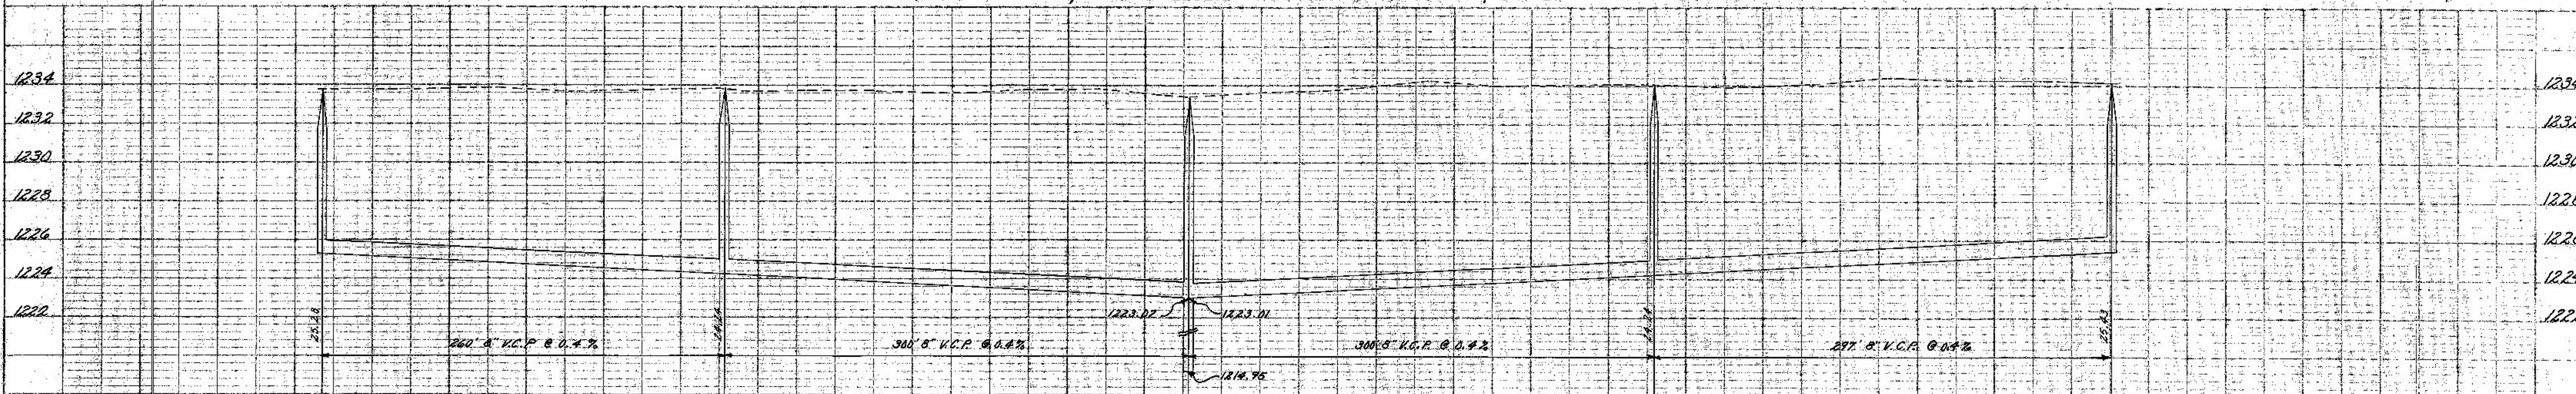

LAT 329 R/W No. of CLOUD - LEWIS to ROACH

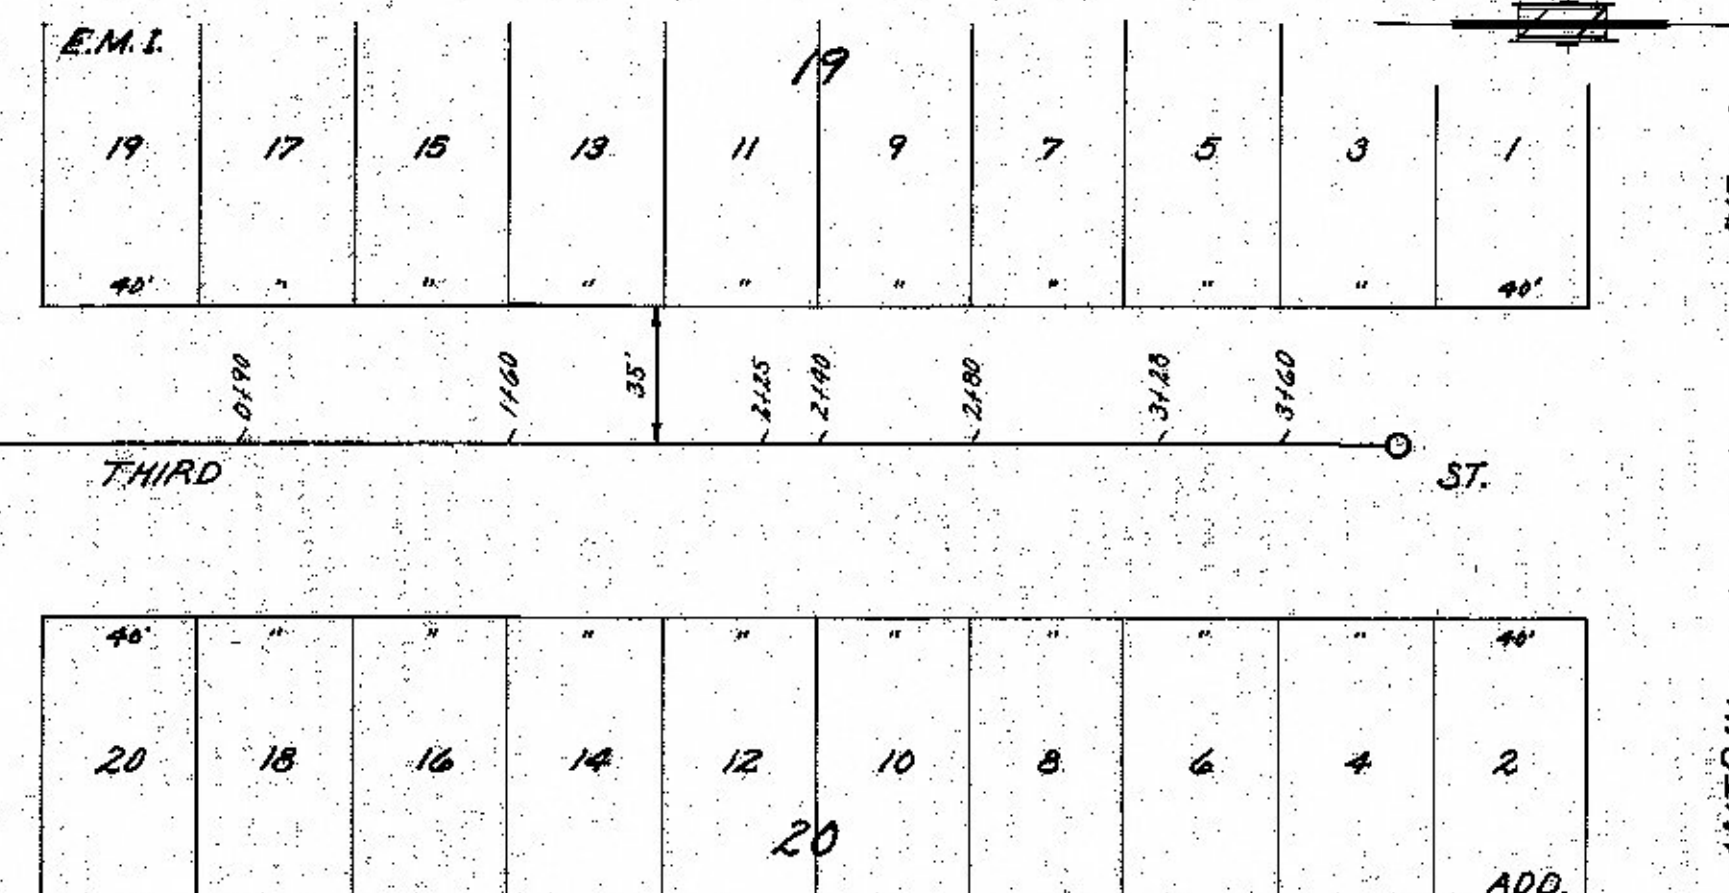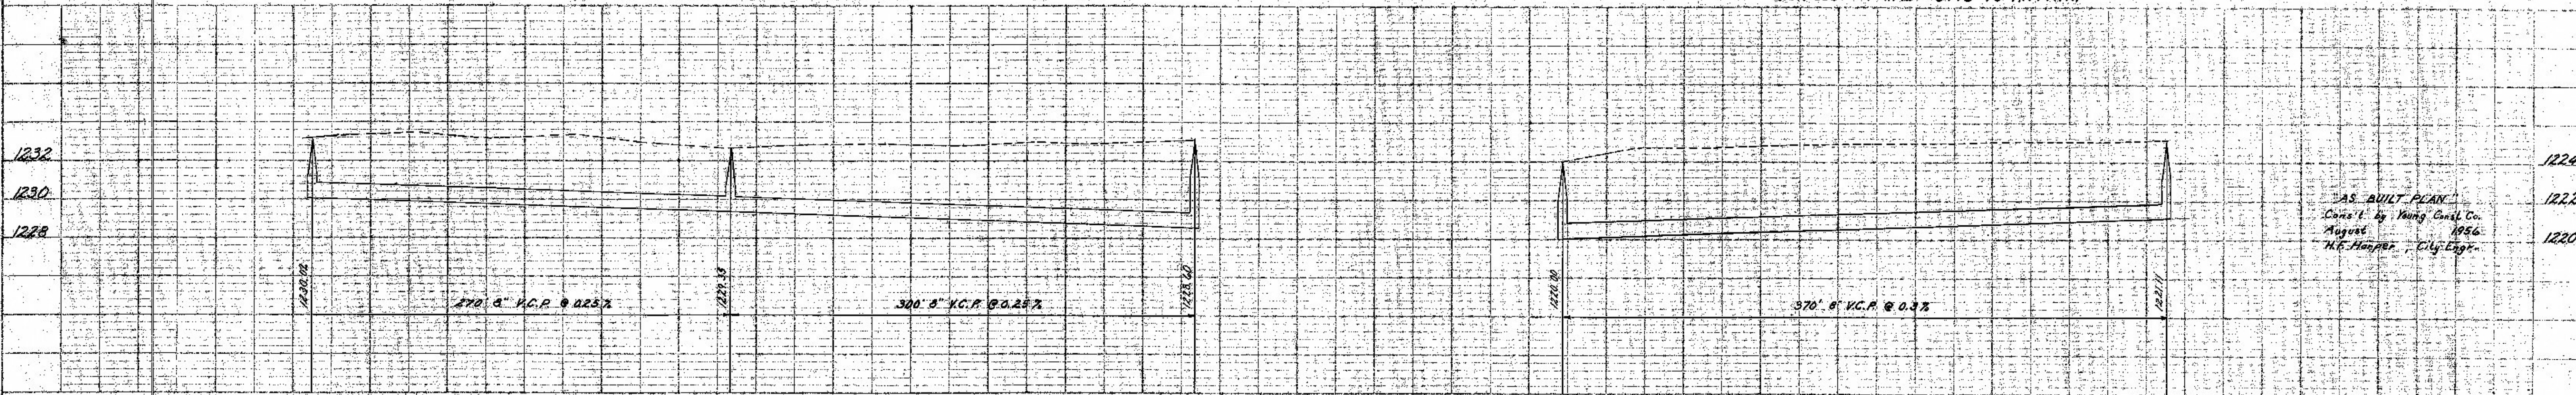

LAT 330 THIRD - OTIS TO ANTRIM

AS BUILT PLAN
 Cons't. by Young Const. Co.
 August 1956
 H.F. HANSEN, City Engr.