

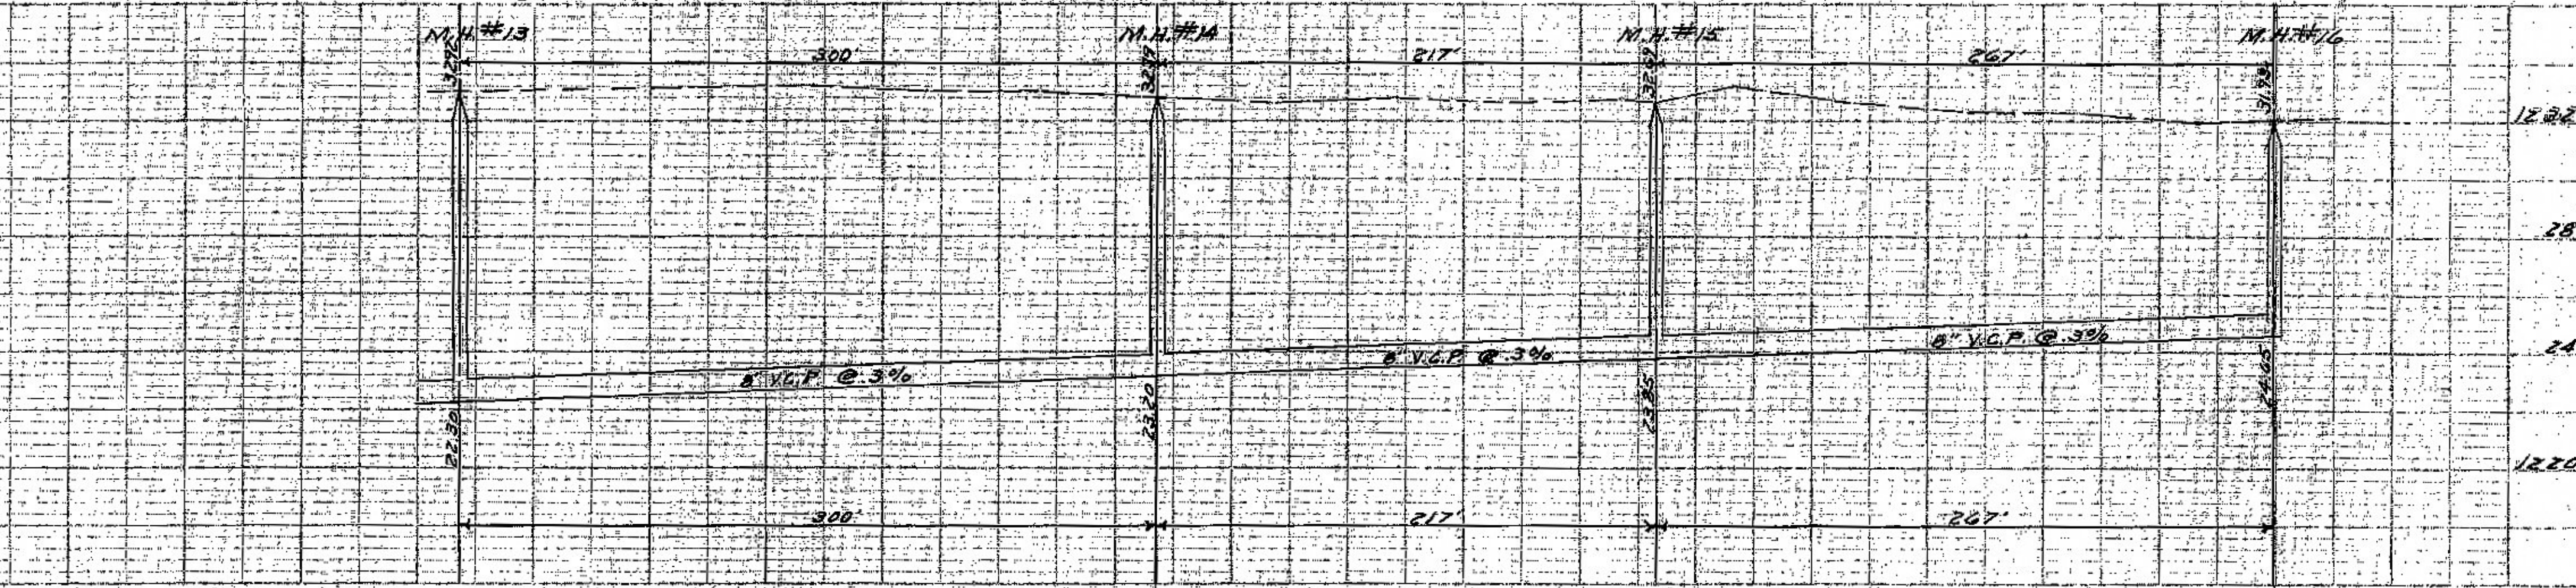
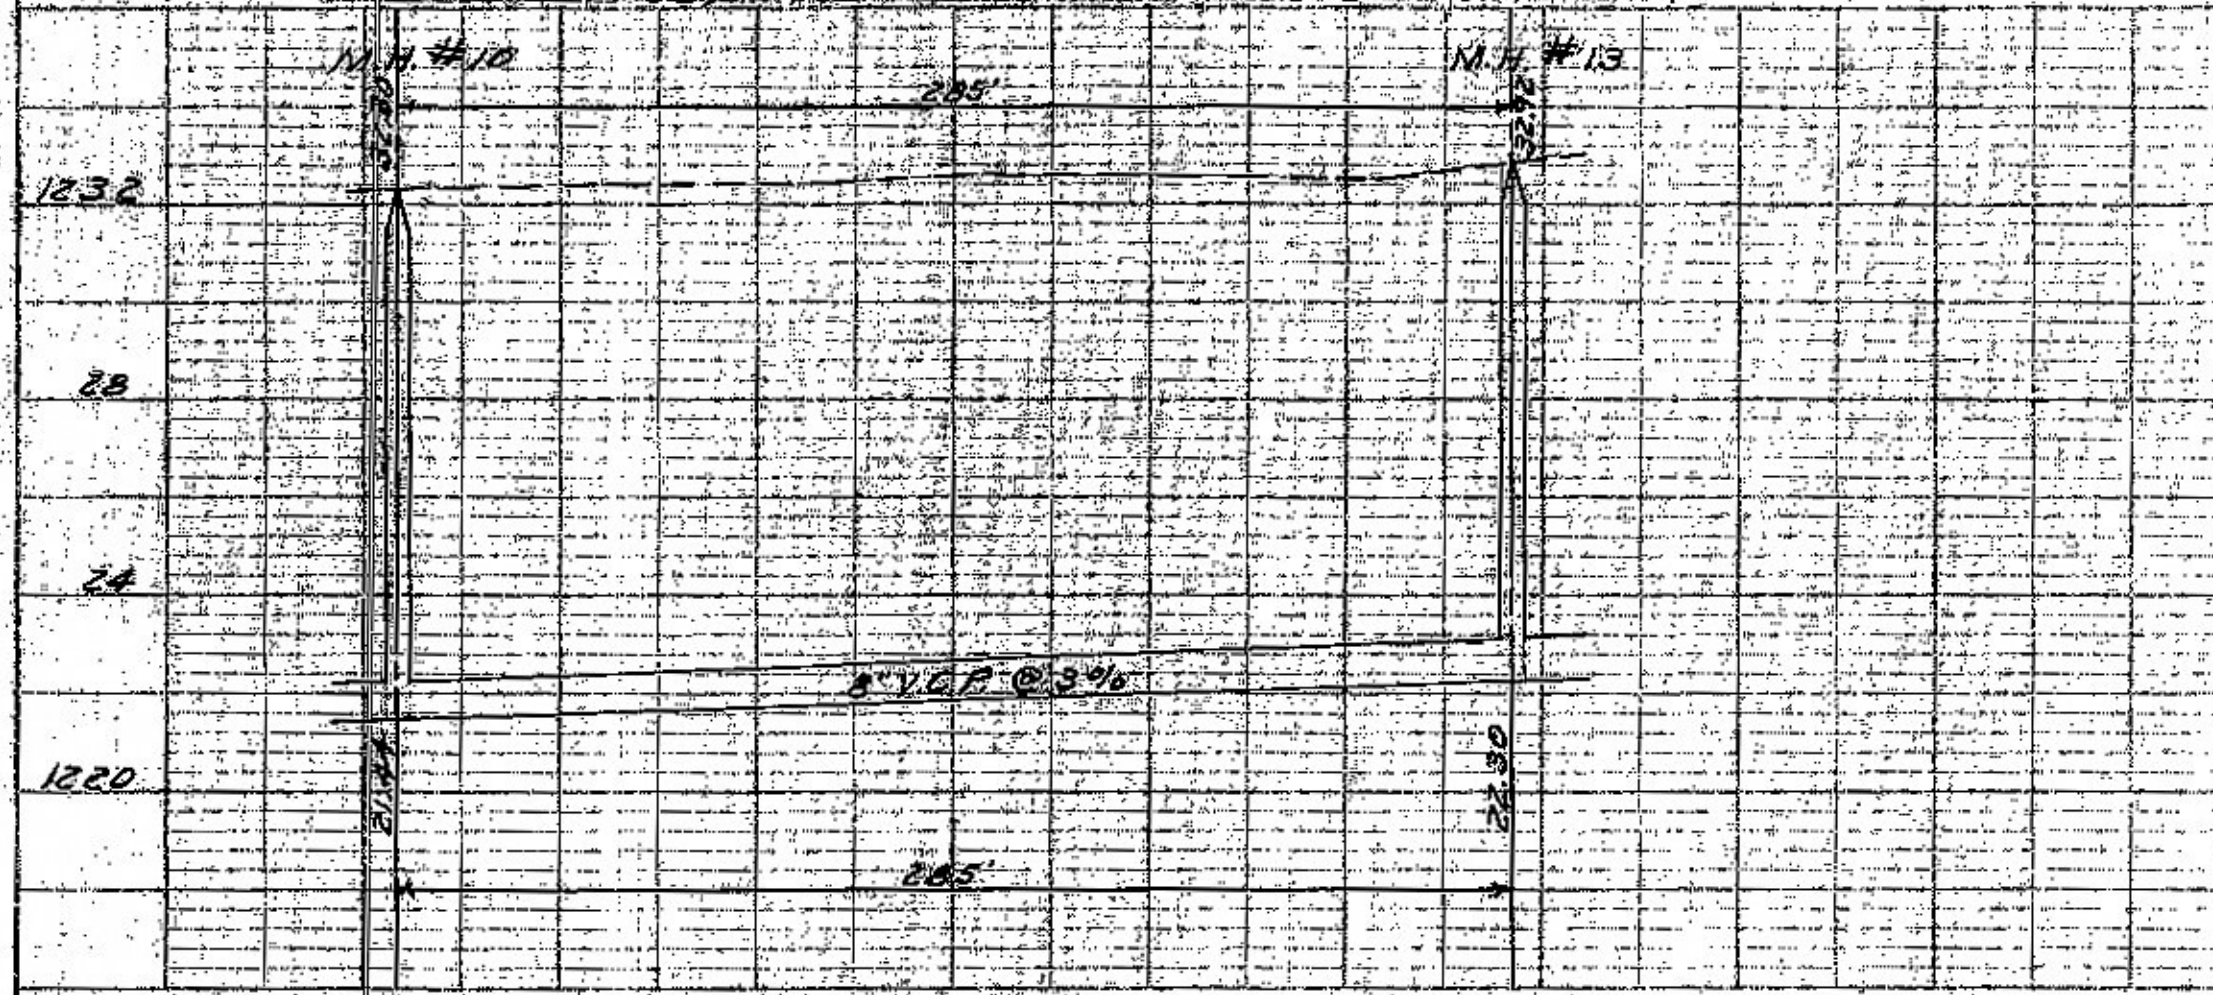
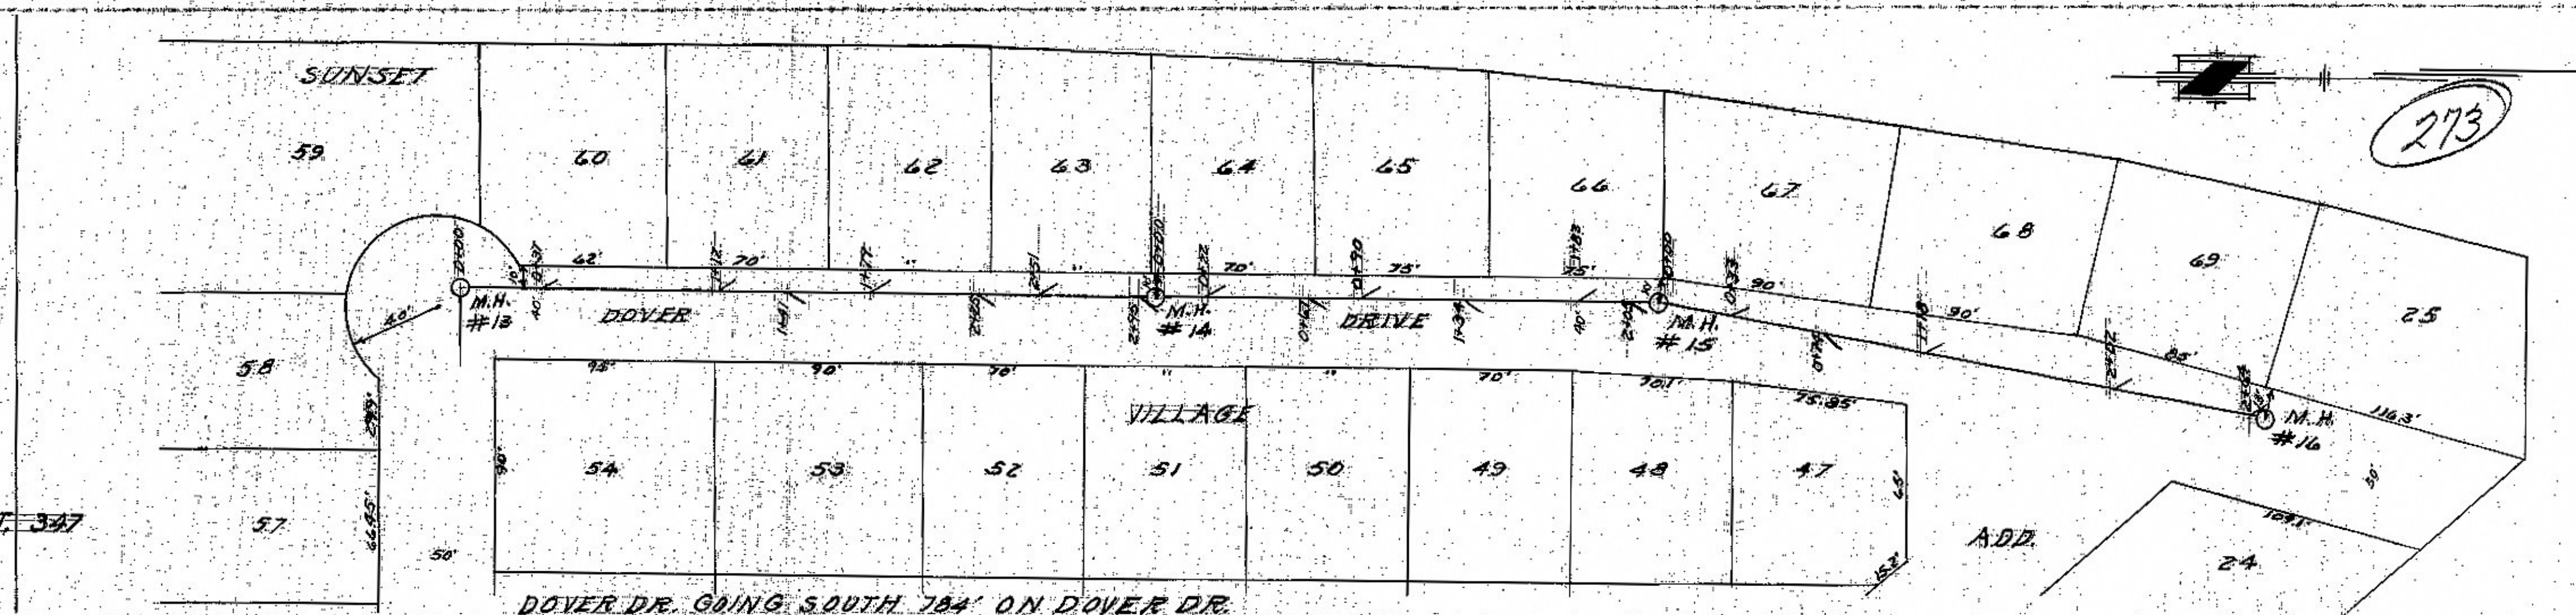
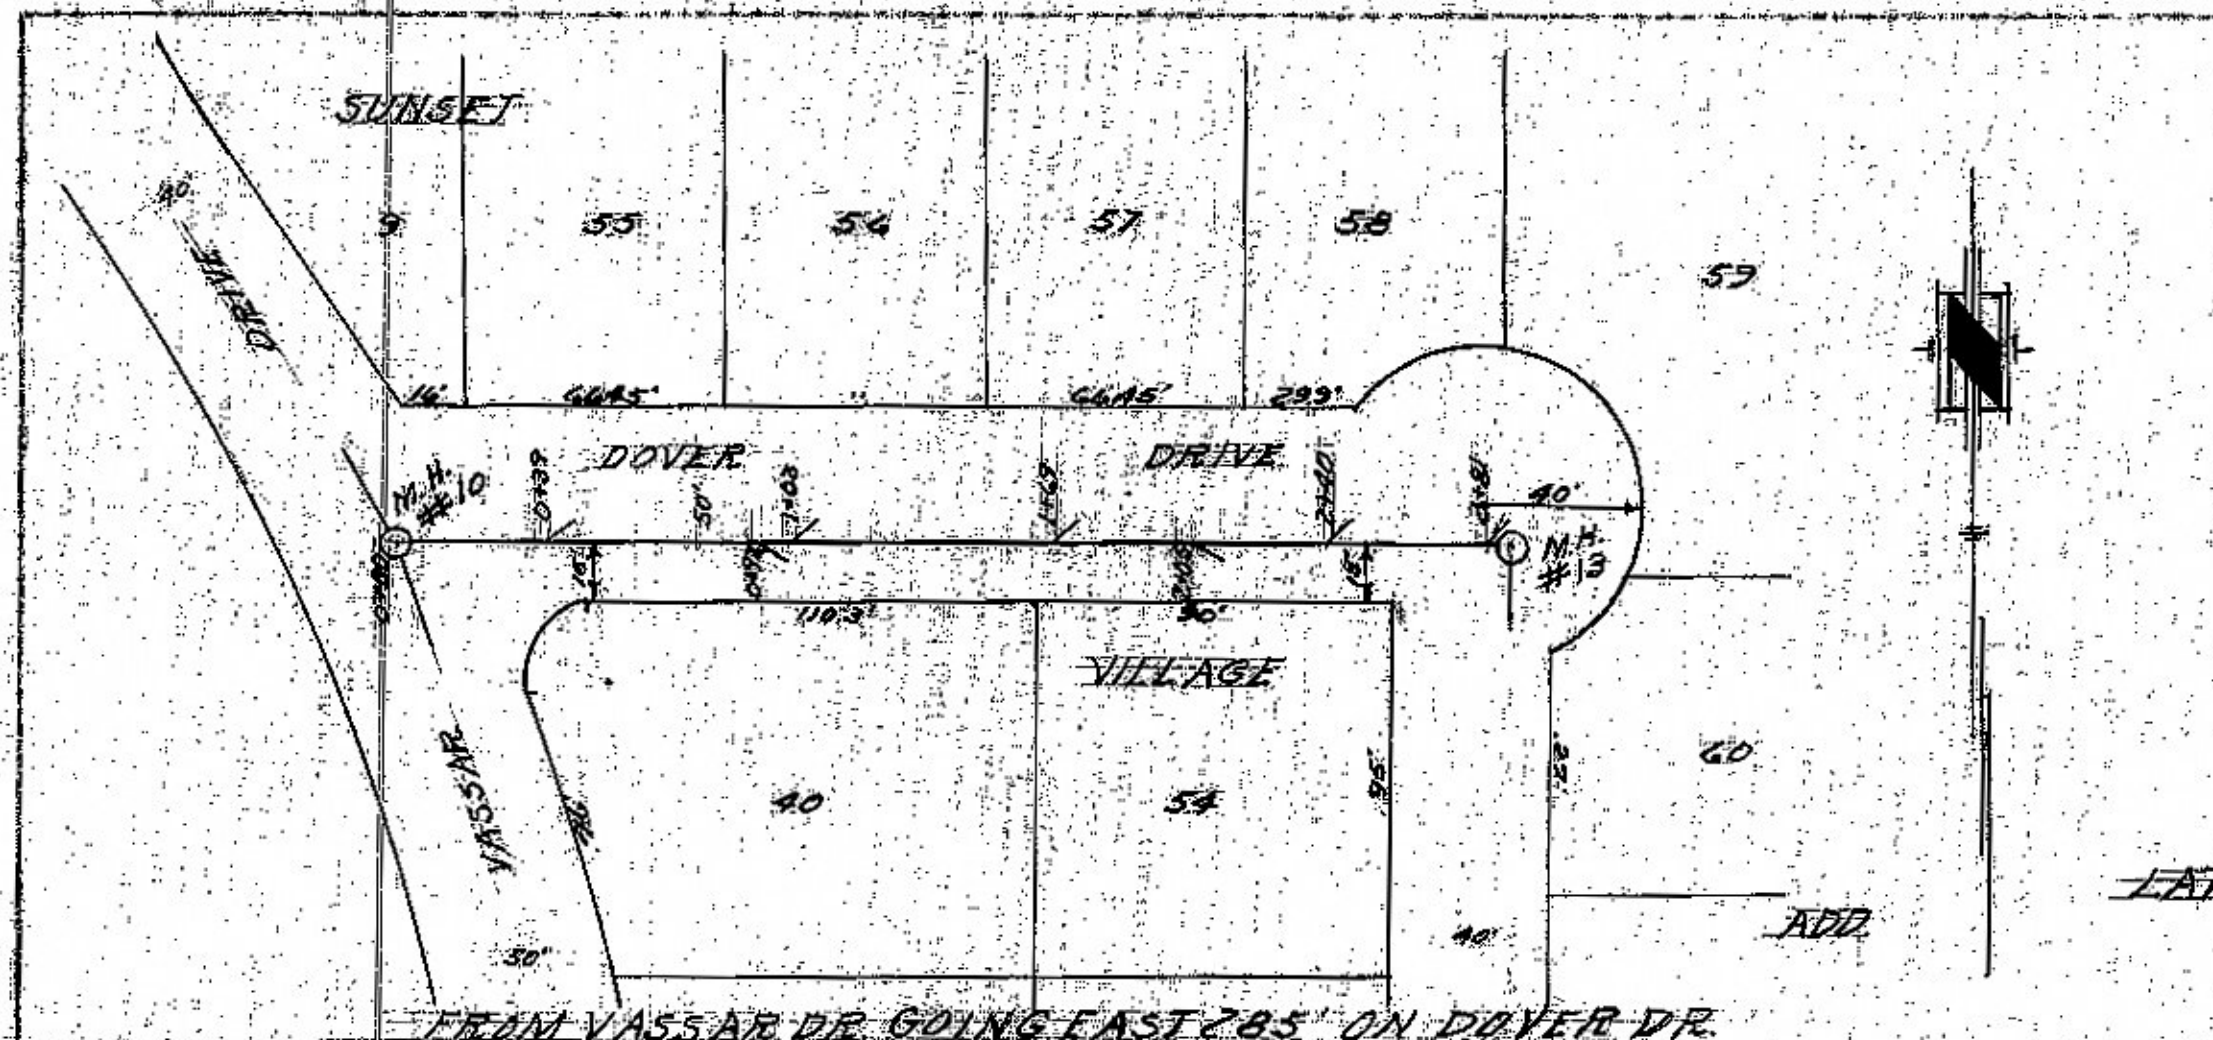
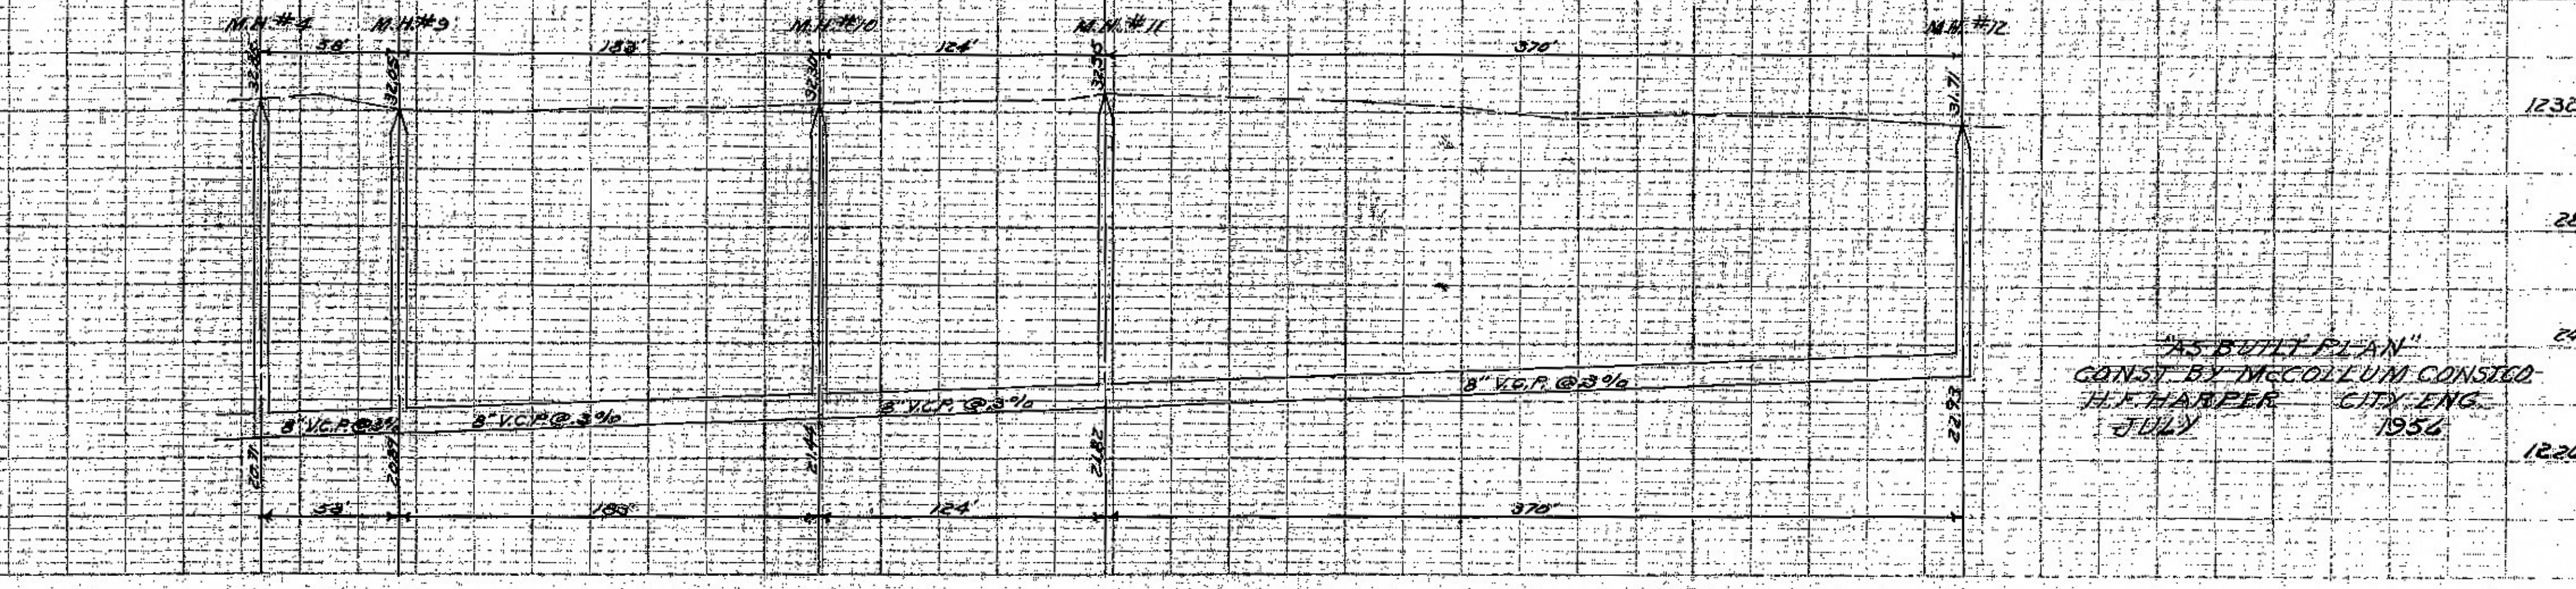
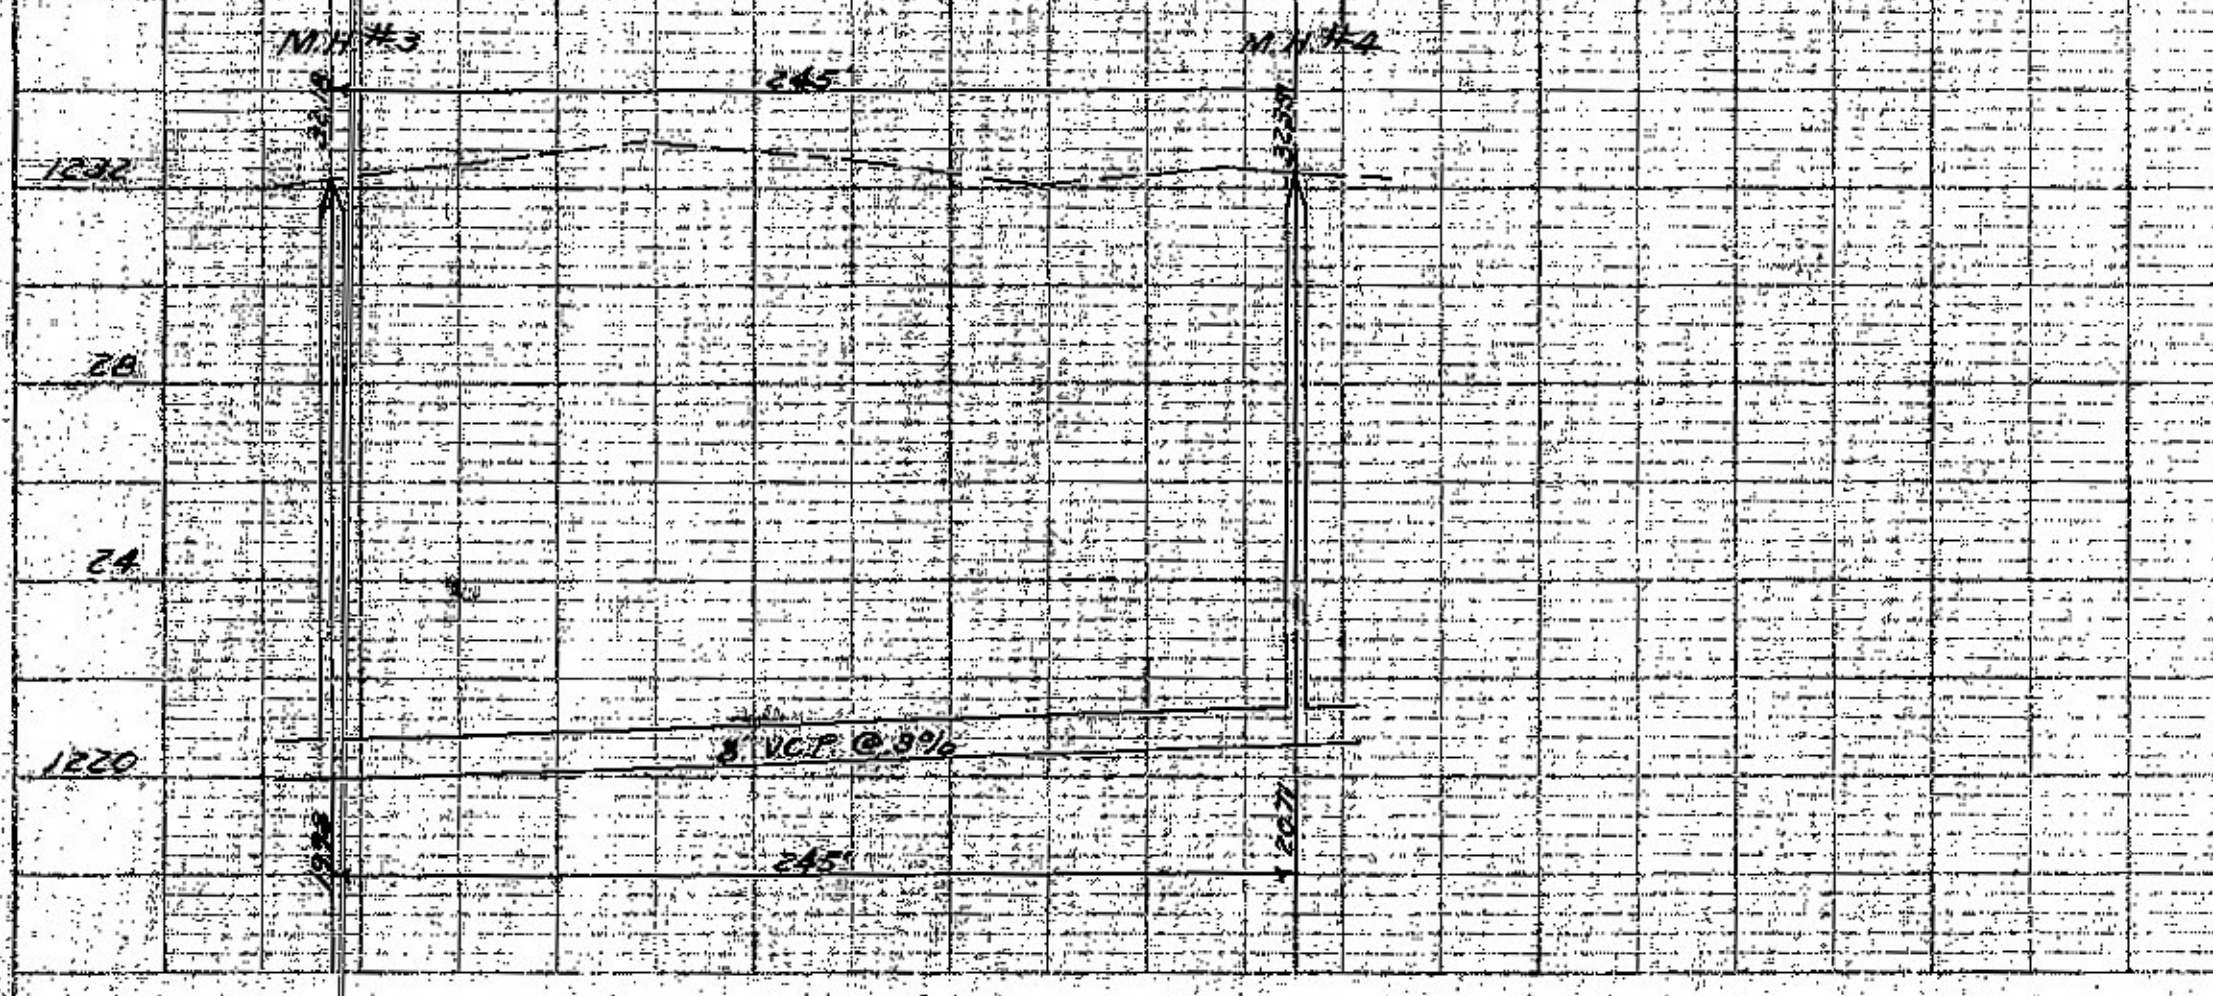


273

DATE: \_\_\_\_\_ BY: \_\_\_\_\_  
 CHECKED BY: \_\_\_\_\_  
 PLANNED BY: \_\_\_\_\_  
 NOTE BOOK: \_\_\_\_\_  
 NO. \_\_\_\_\_  
 RET. BY: \_\_\_\_\_  
 DATE: \_\_\_\_\_

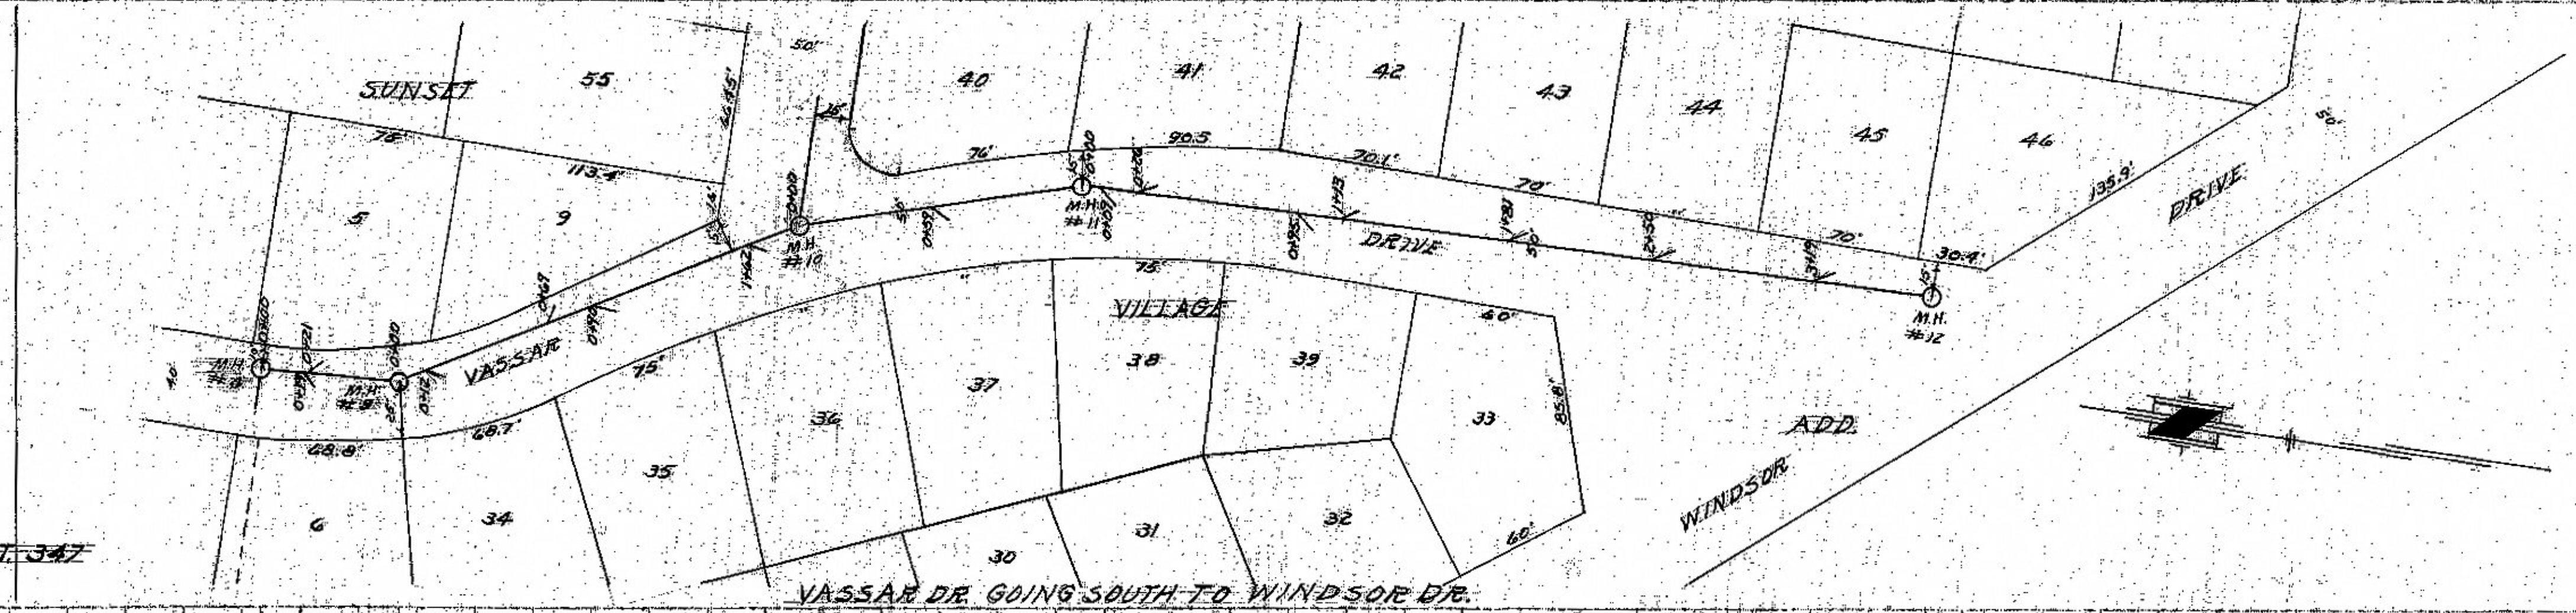

DATE: \_\_\_\_\_ BY: \_\_\_\_\_  
 CHECKED BY: \_\_\_\_\_  
 PLANNED BY: \_\_\_\_\_  
 NOTE BOOK: \_\_\_\_\_  
 NO. \_\_\_\_\_  
 RET. BY: \_\_\_\_\_  
 DATE: \_\_\_\_\_

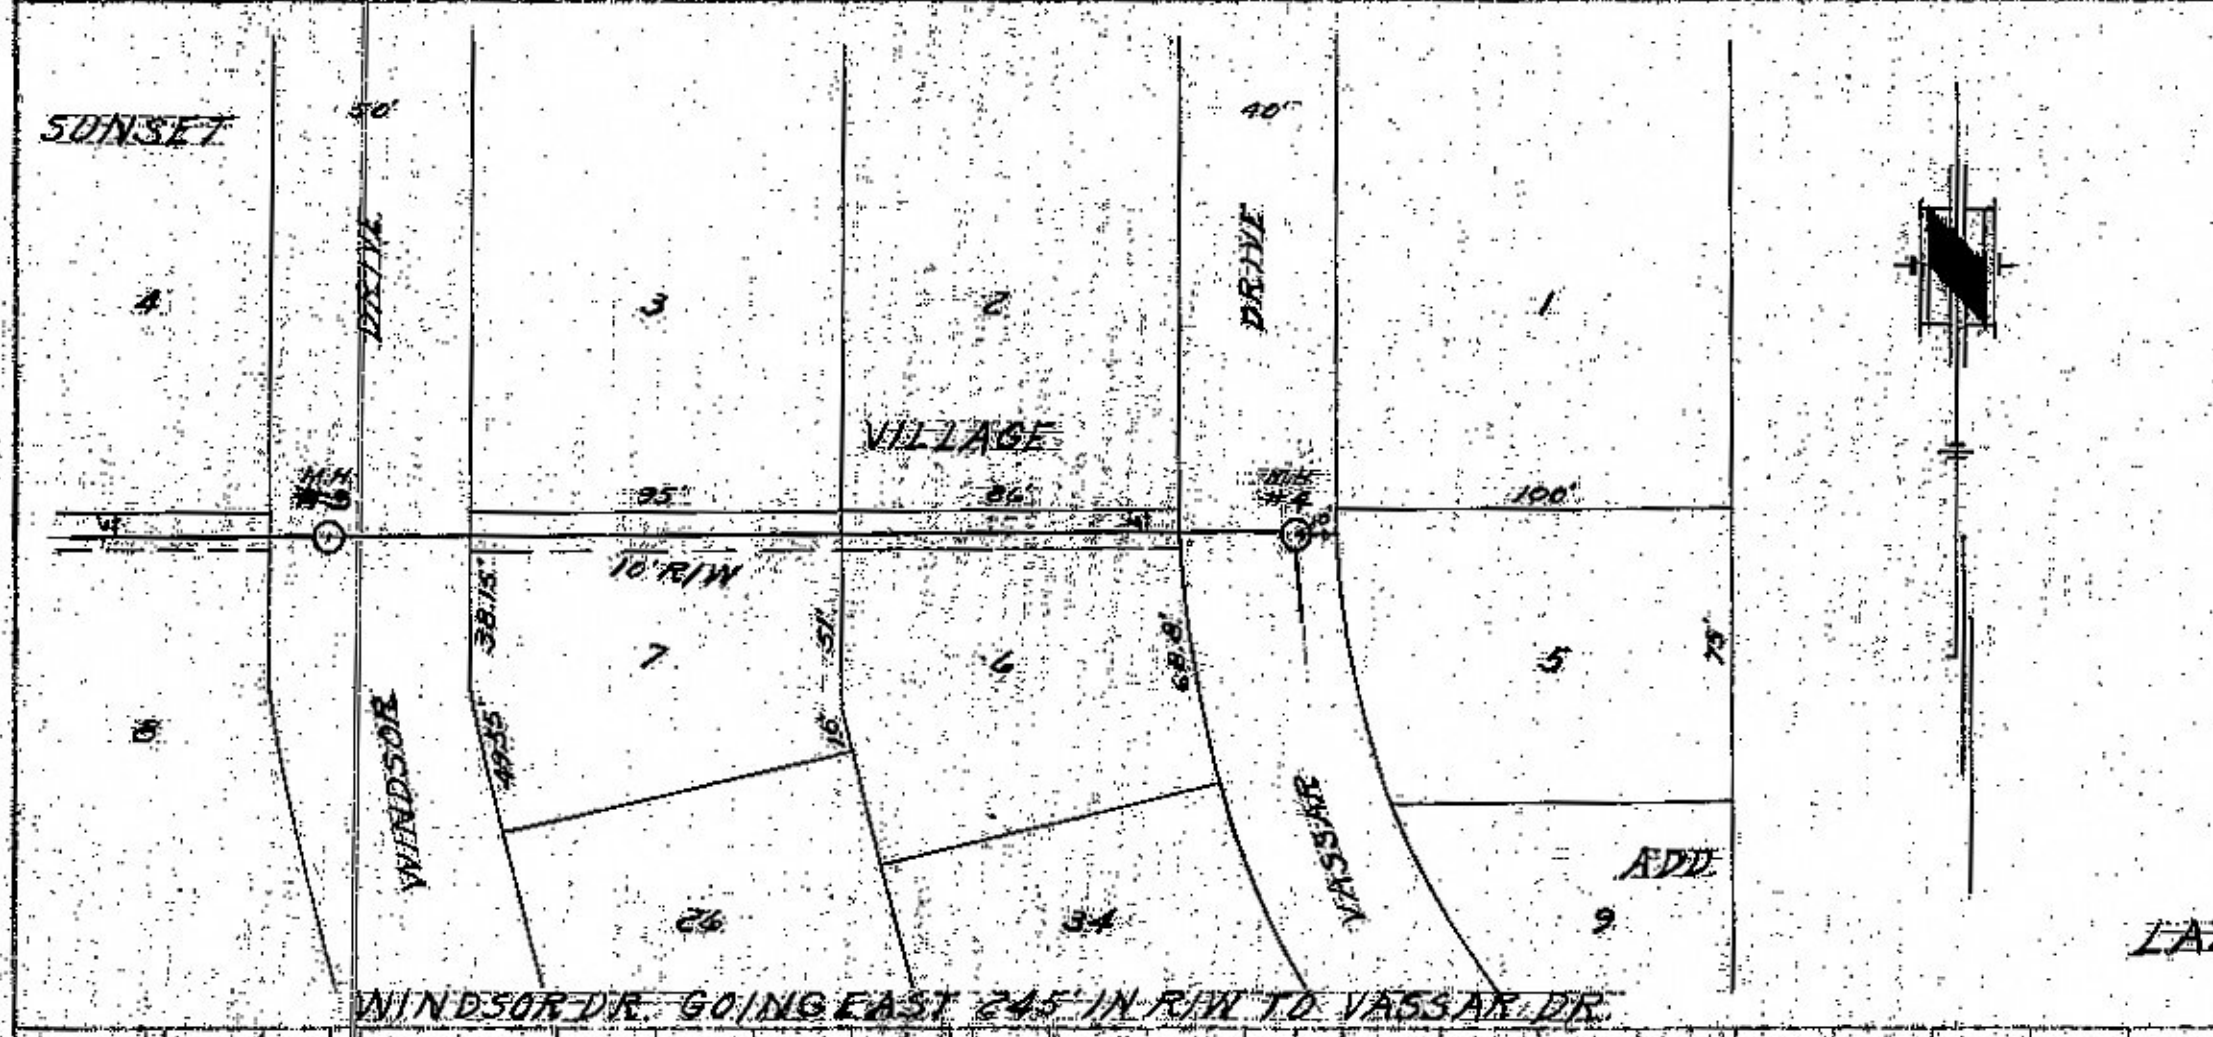

"AS BUILT PLAN"  
 CONST. BY MCCOLLUM CONSTRUCTION CO.  
 J.H. HARPER CITY ENG.  
 JULY 1956