




LAT. 347

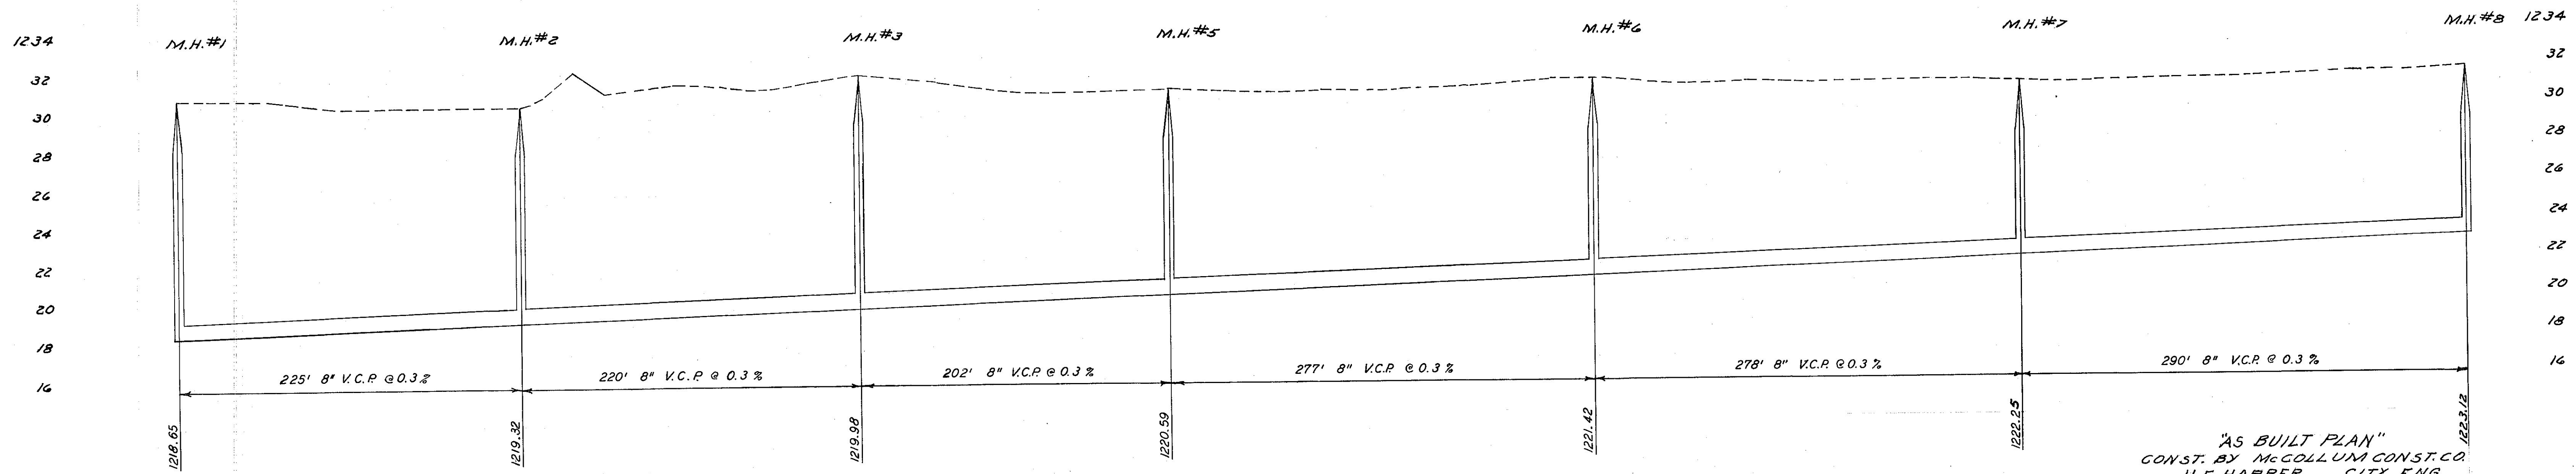

"AS BUILT PLAN"  
 CONST. BY MCGOLLUM CONST. CO.  
 H.F. HARPER CITY ENG.  
 JULY 1956