

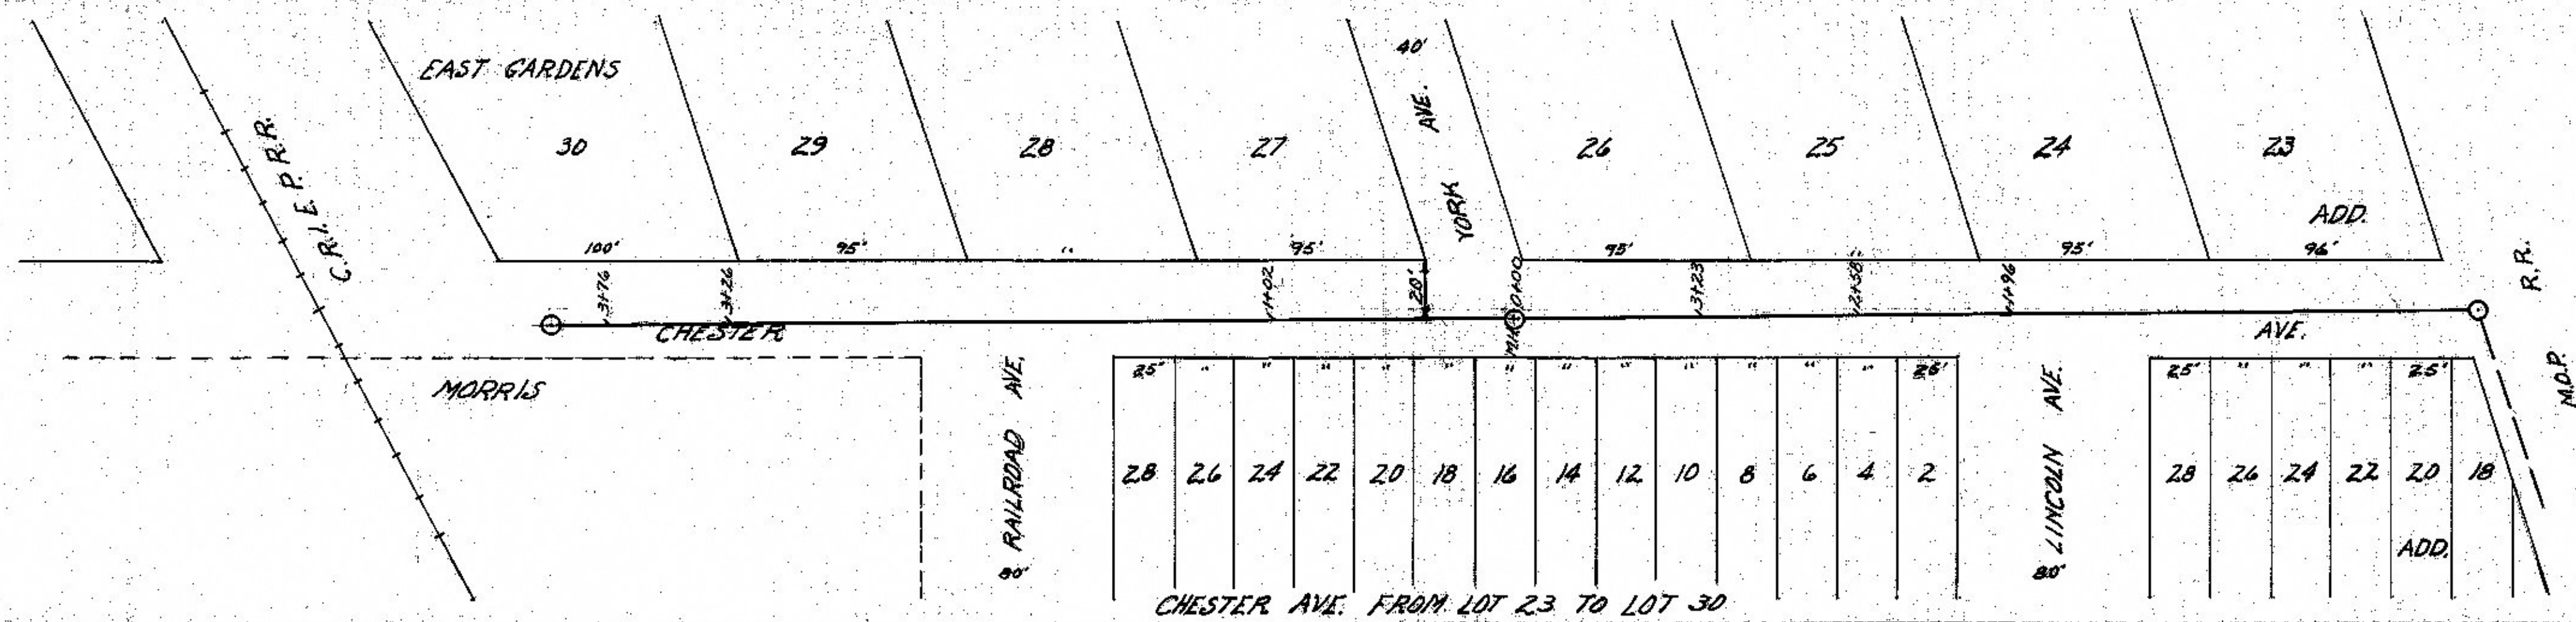
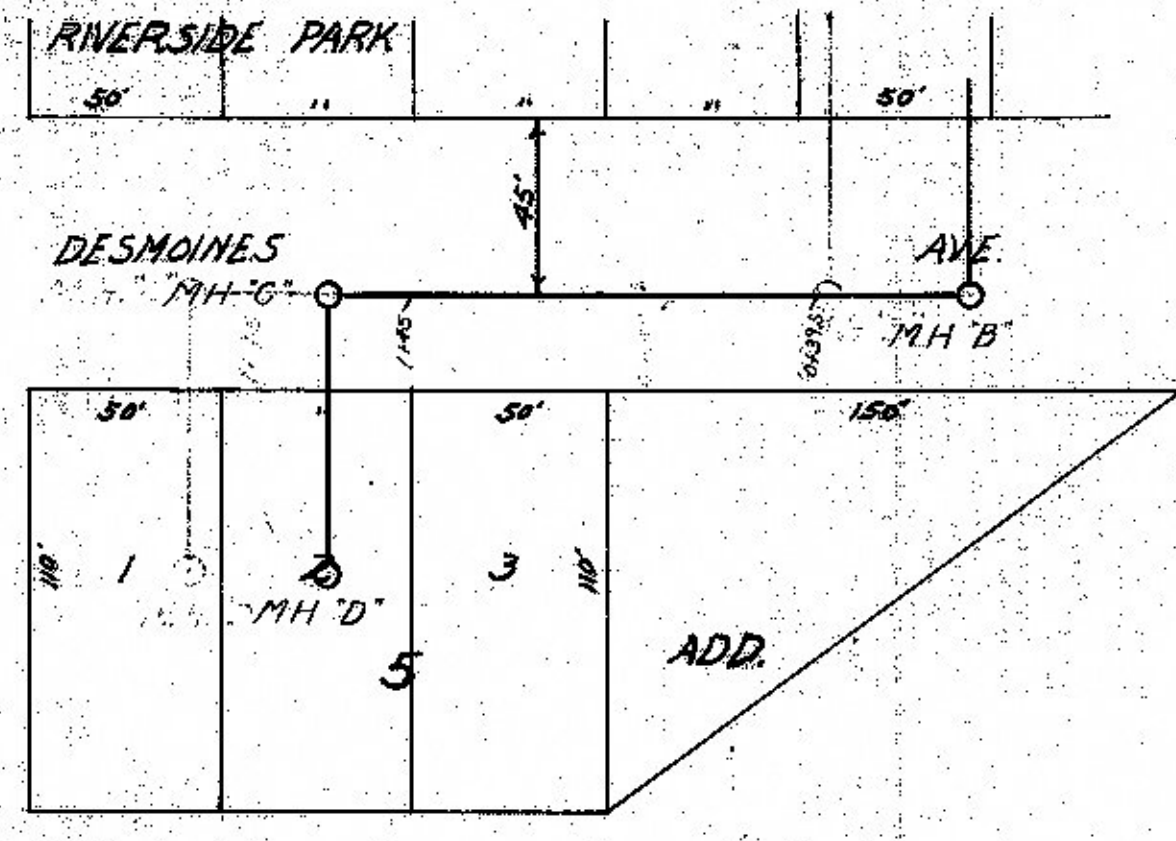



275

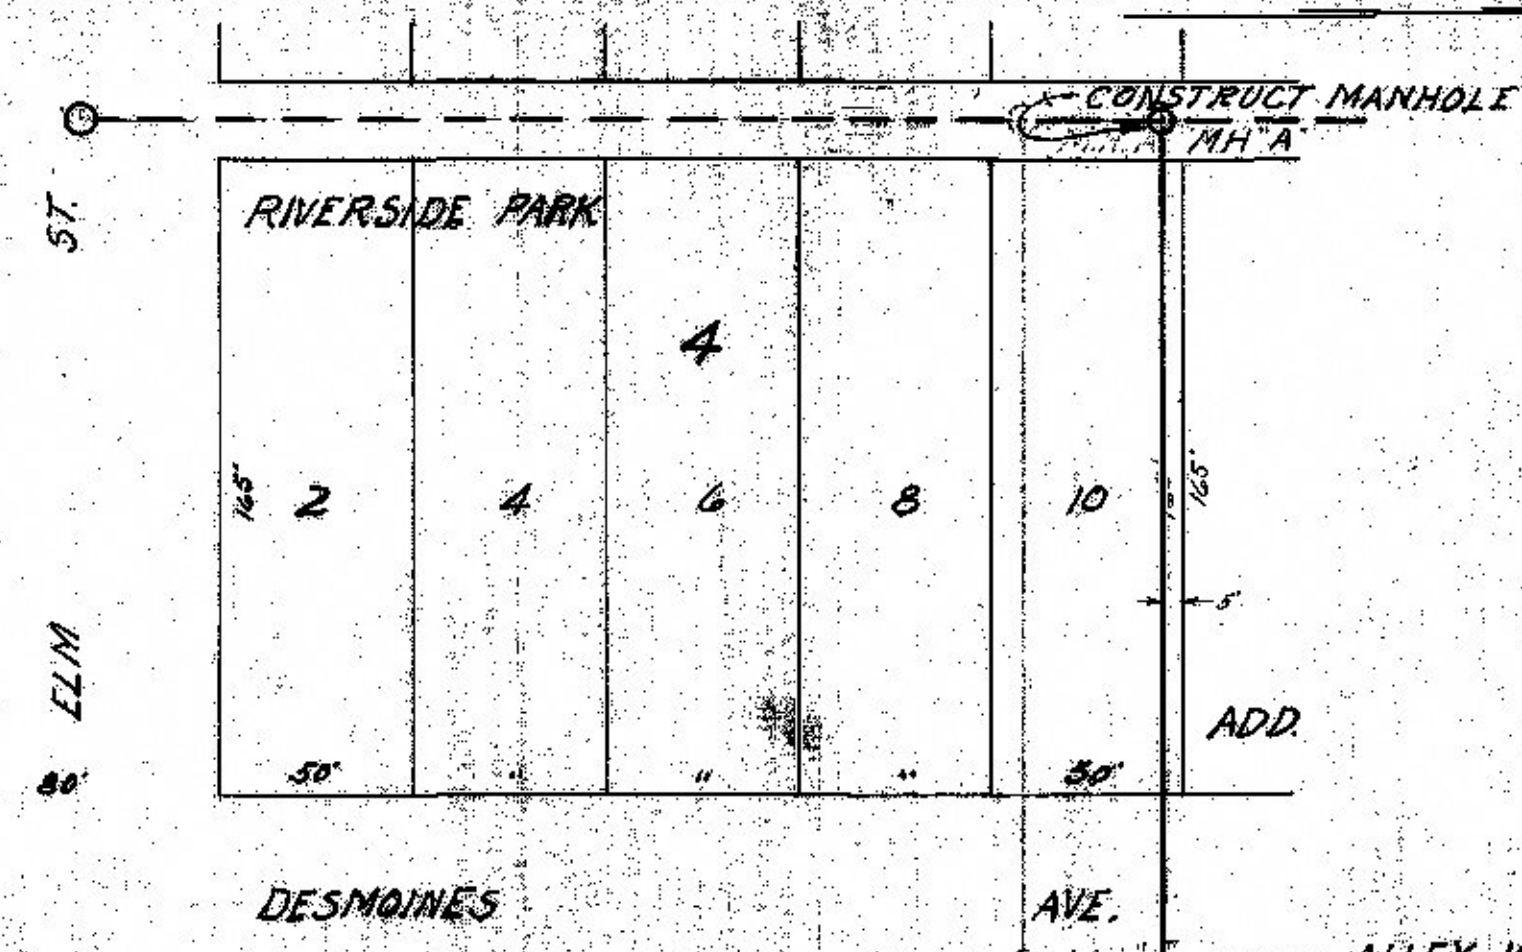

CHESTER AVE. FROM LOT 23 TO LOT 30
Lateral #346

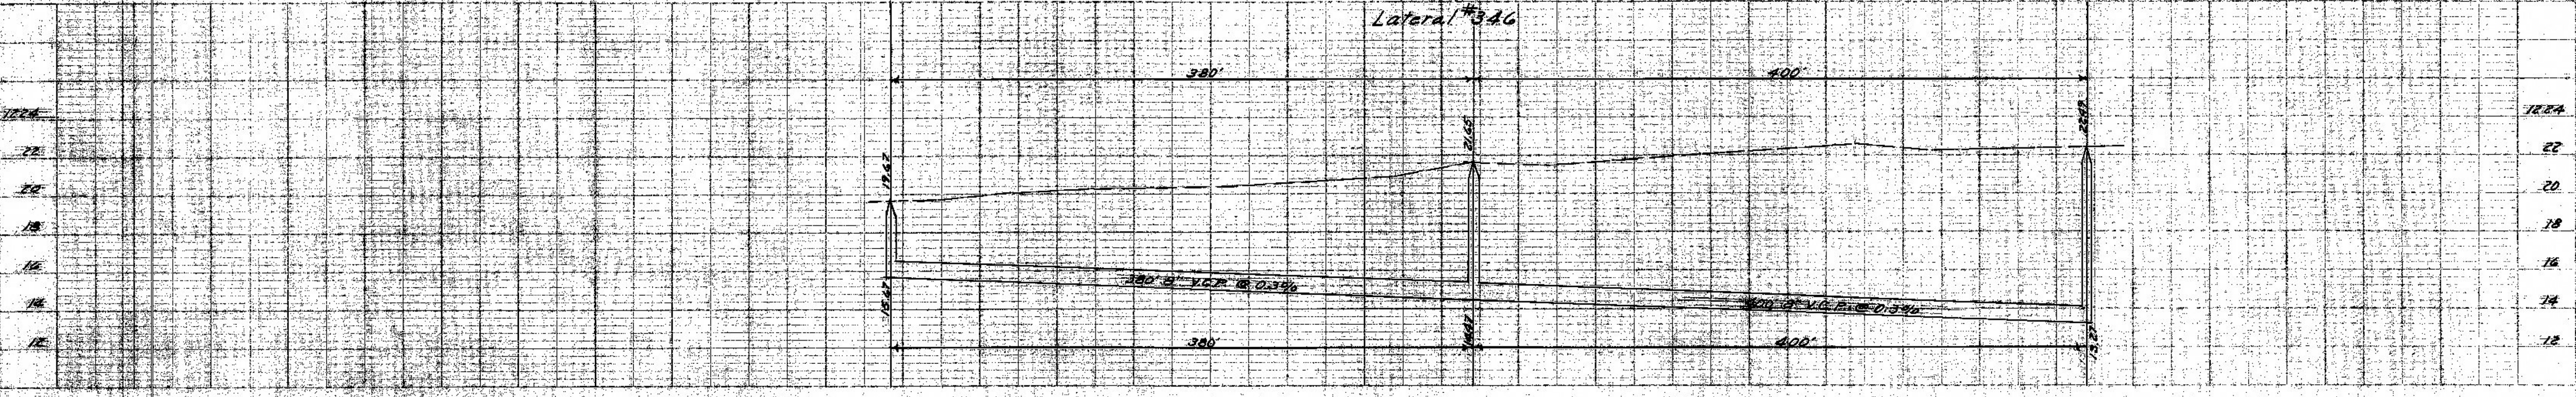

ALLEY W. OF DESMOINES THENCE EAST TO SERVE BIK 5
Lateral #348

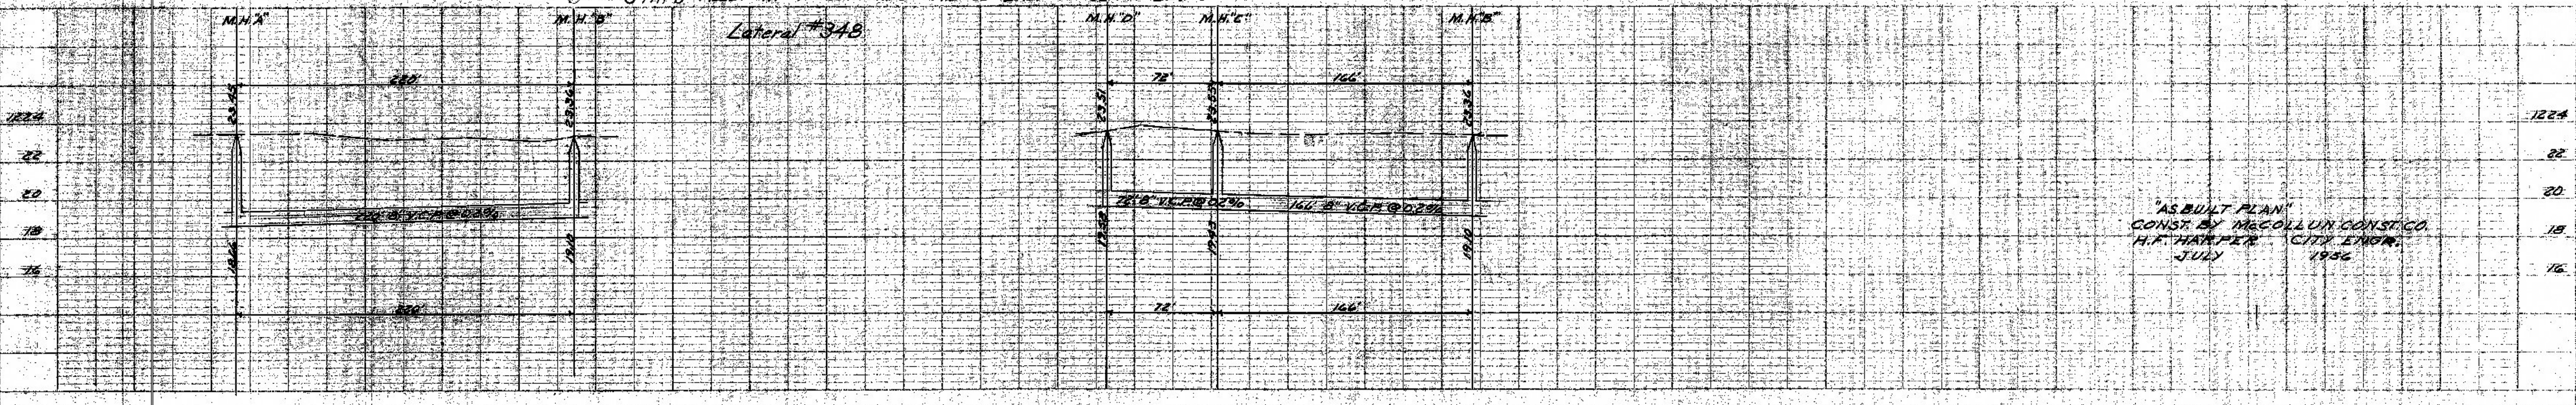

"AS BUILT PLAN"
CONST. BY McCOLLUM CONST. CO.
H.F. HARPER CITY ENGR.
JULY 1936

PLAN
SURVEYED BY
NOTED BOOK
NO.

PROFILE
SURVEYED BY
NOTED BOOK
NO.