
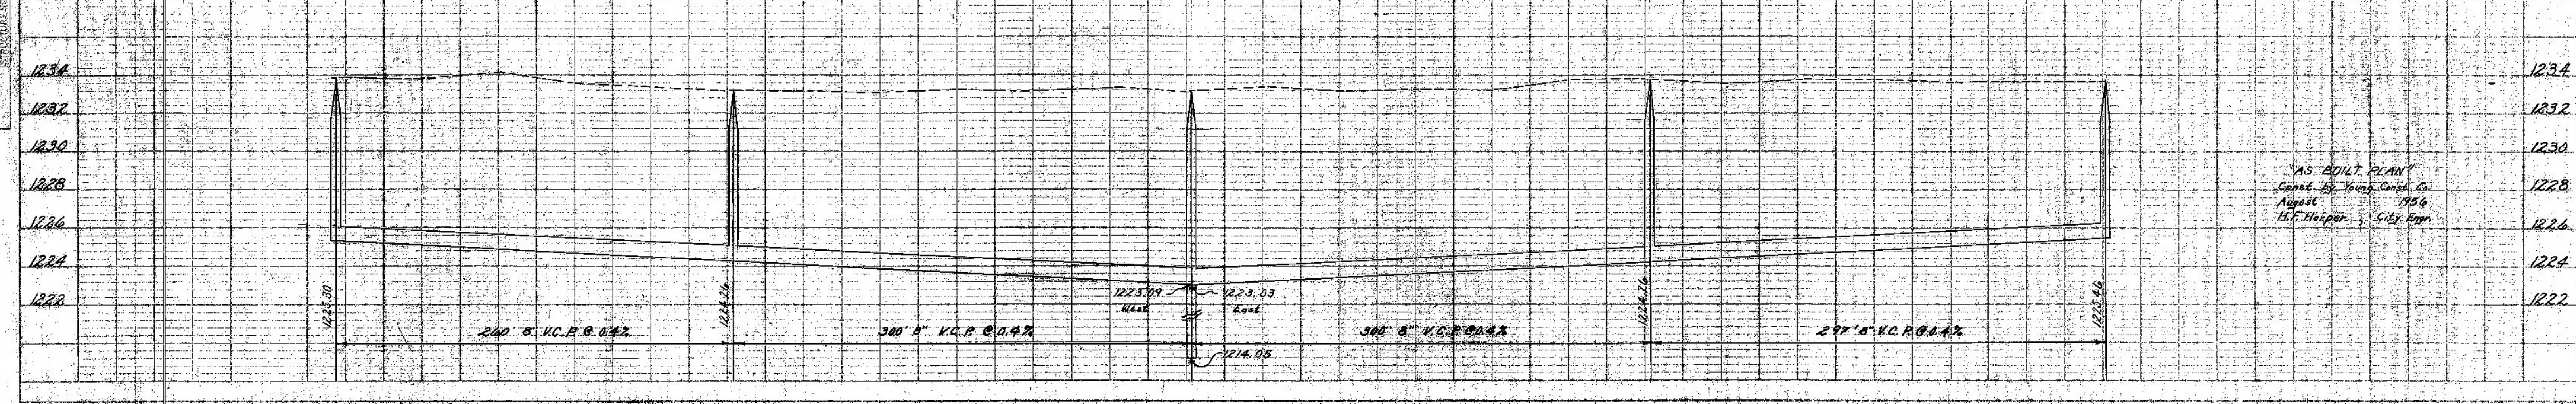
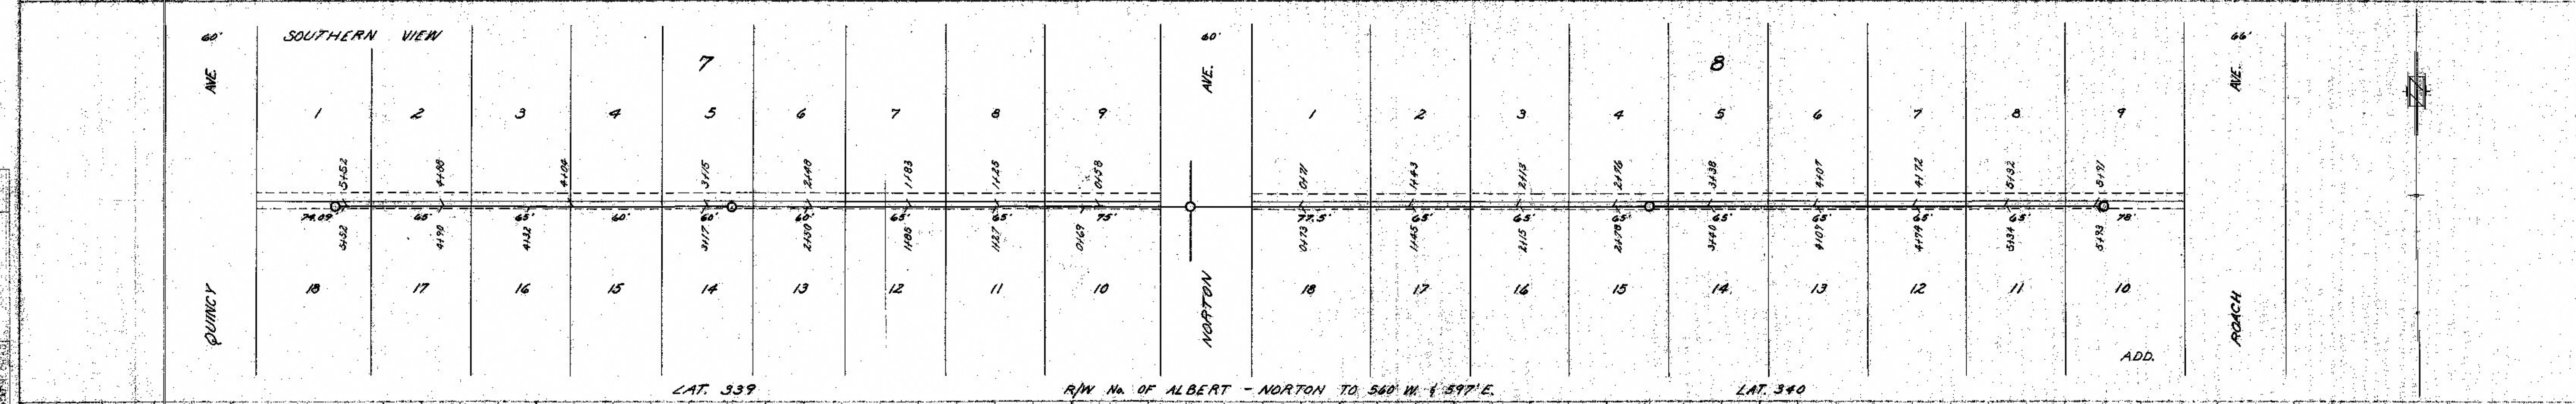
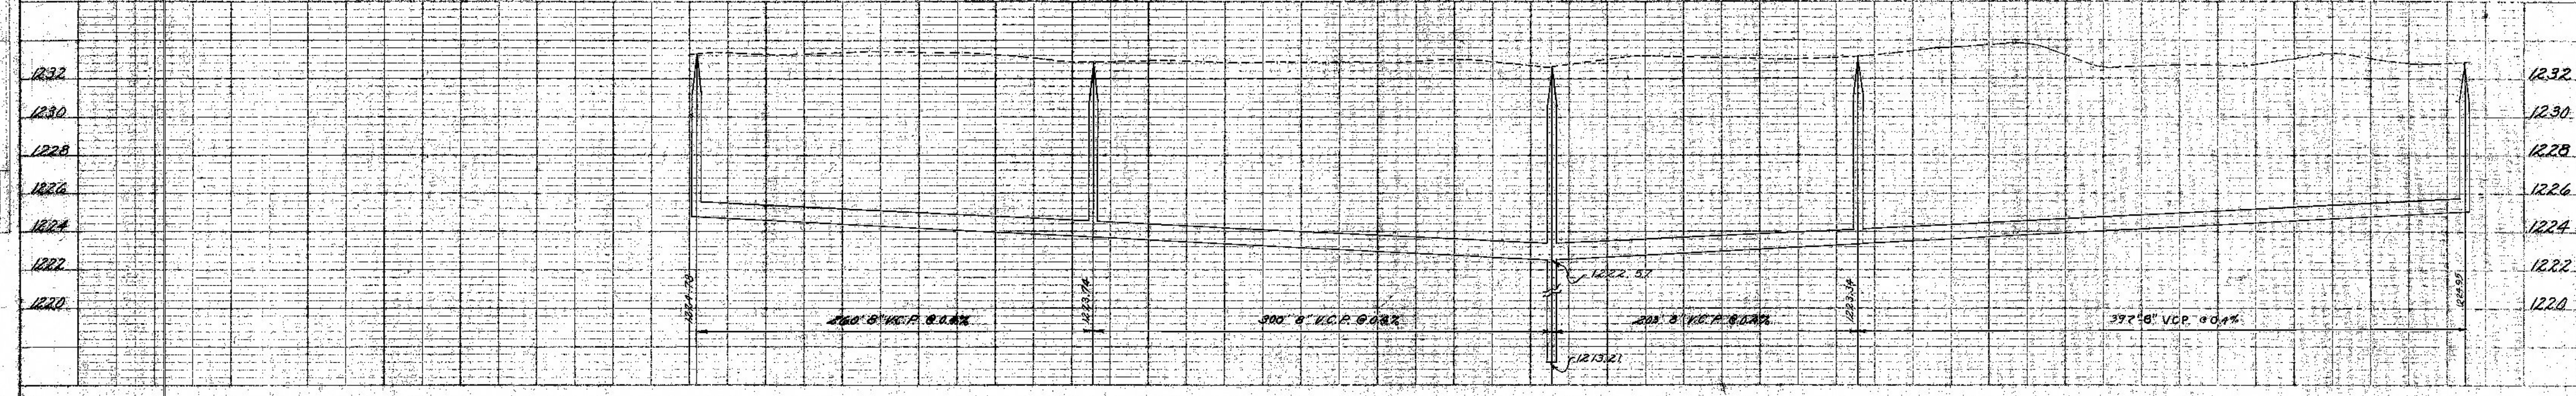


PLAN
 DRAWN BY: []
 CHECKED BY: []
 DATE: []
 NOTE BOOK: []
 PLOTTER: []
 BY: []
 NO. []

PROFILE
 DRAWN BY: []
 CHECKED BY: []
 DATE: []
 NOTE BOOK: []
 PLOTTER: []
 BY: []
 NO. []

276

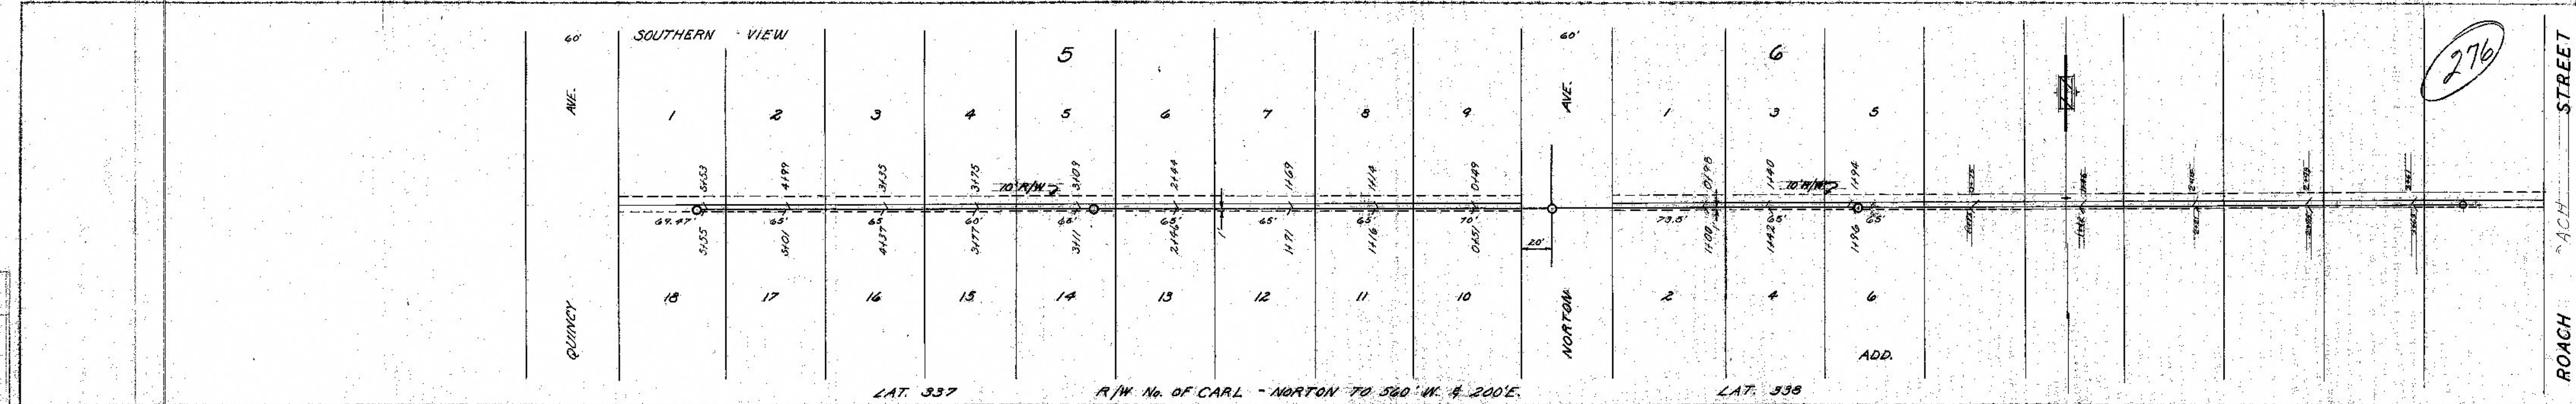

AS BUILT PLAN
 CORRECTED BY: Young Const. Co.
 August 1956
 H.F. Harper, City Engr.