

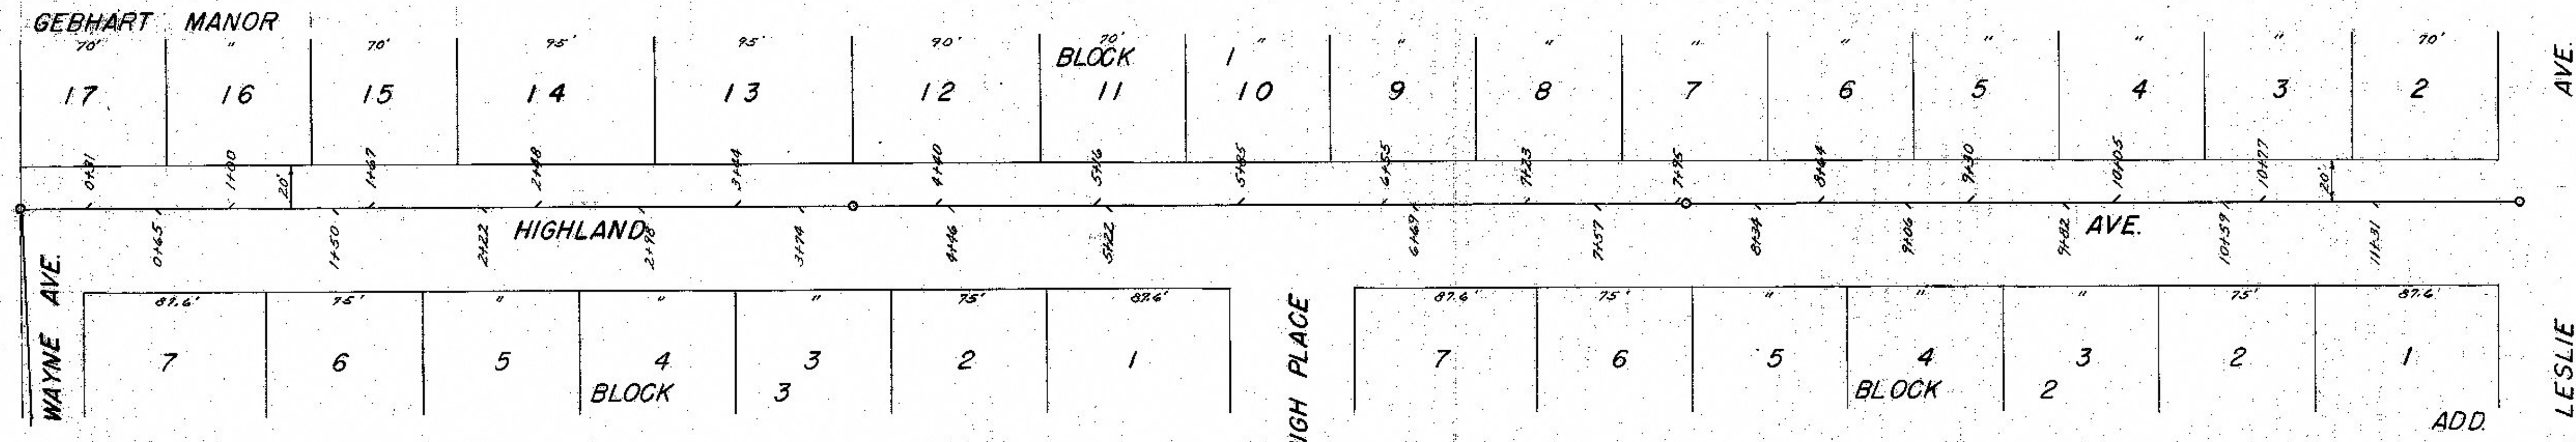


280

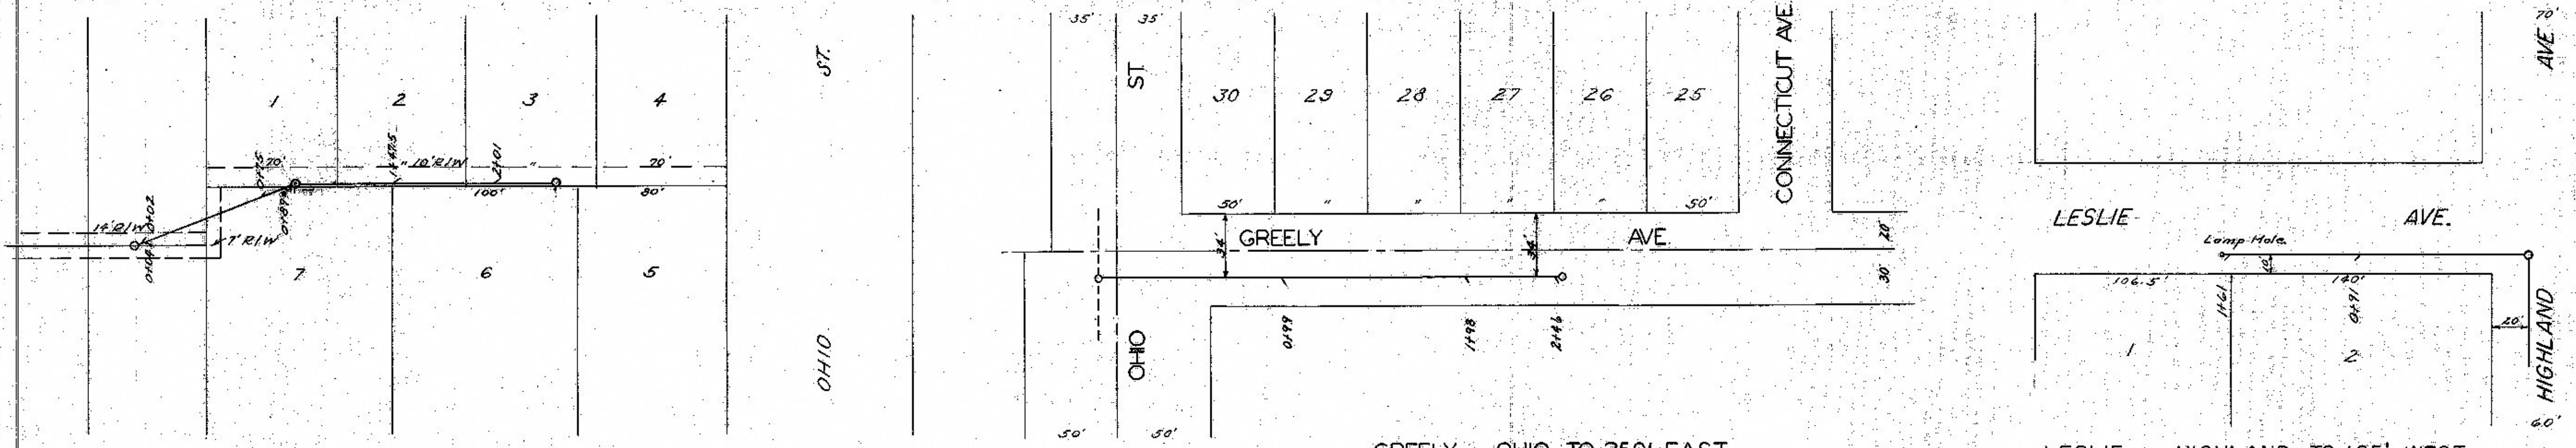


HIGHLAND — WAYNE TO LESLIE
LAT. 356

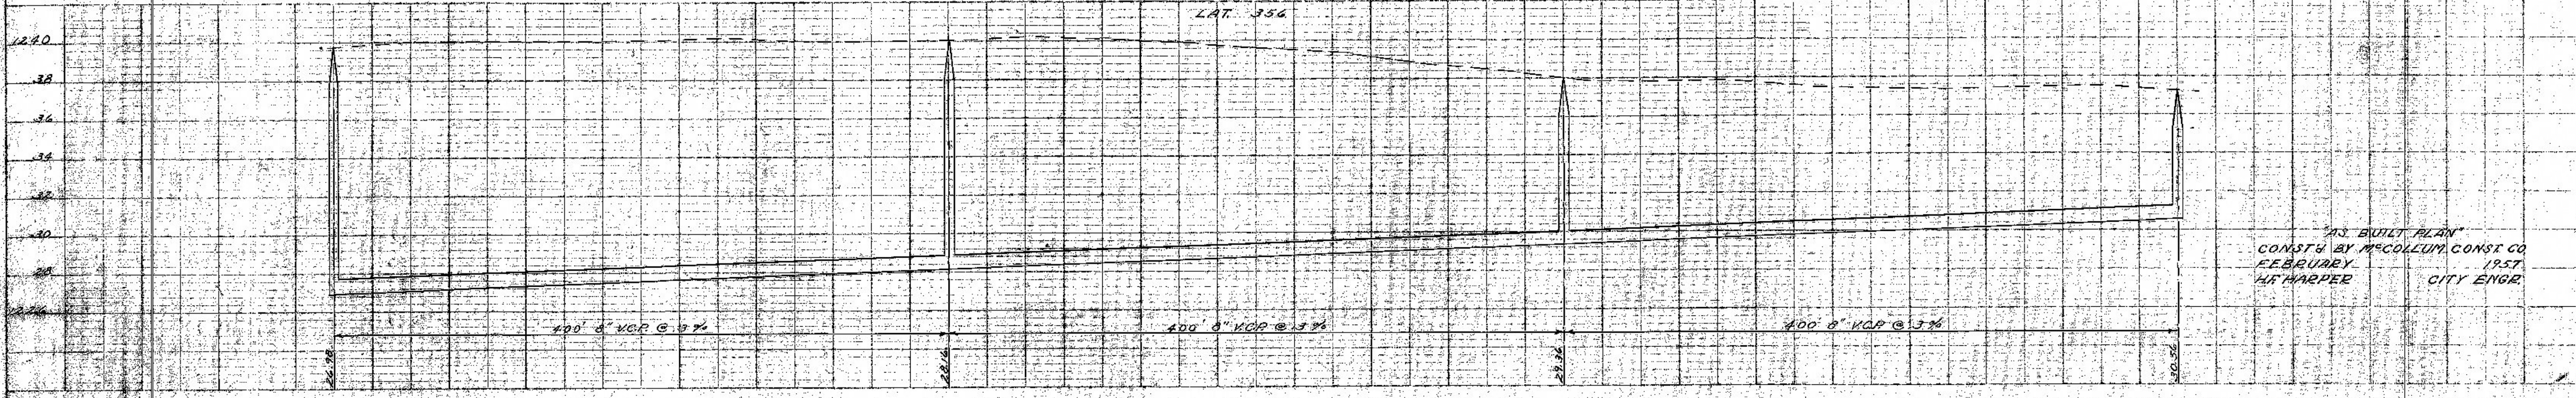

R/W N. RUSSELL (BLK. 3, COUNTRYSIDE ADD.)
LAT. 355

GREELY — OHIO TO 250' EAST
LAT. 352
Const. by J.O. Wilmoth Const.

LESLIE — HIGHLAND TO 165' WEST
LAT. 350

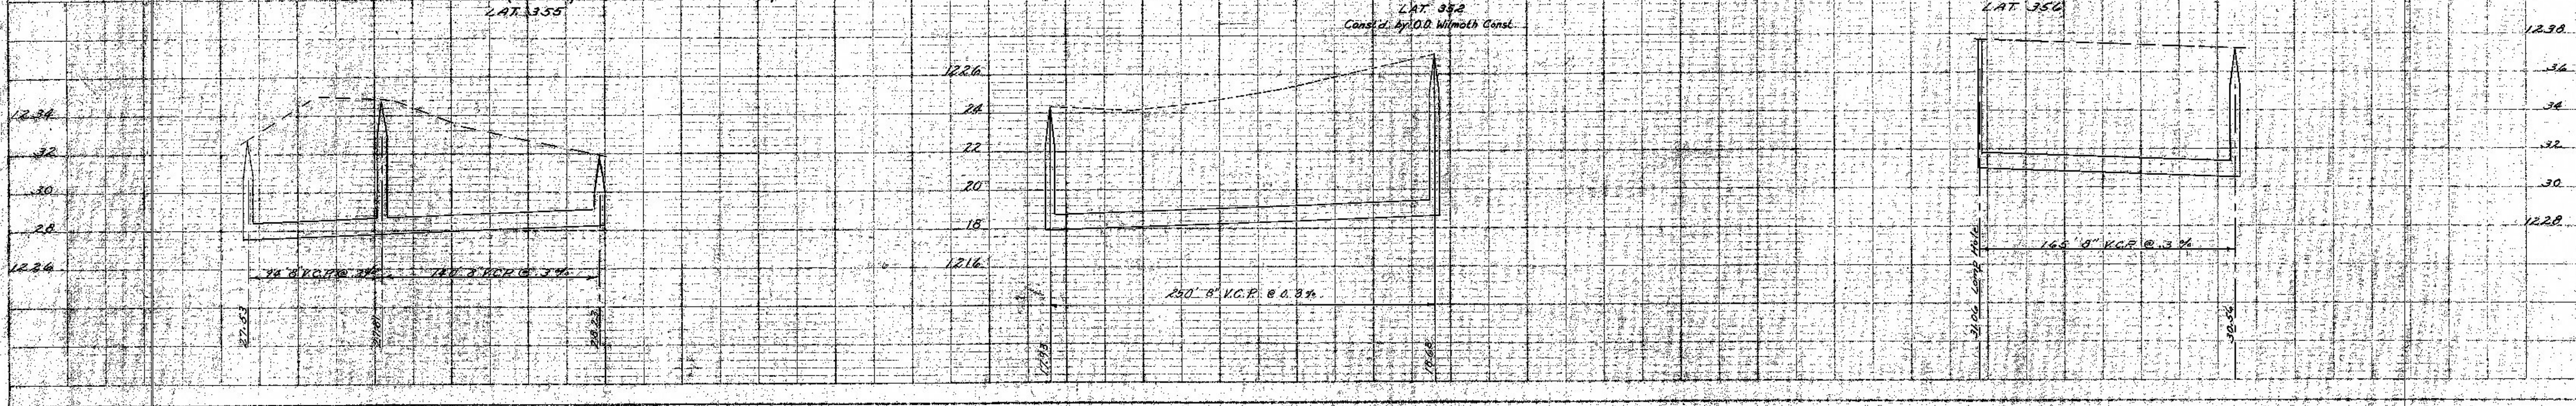

PLAN
SIGNED
PROFES.
NOTE BOOK PLANNING OVERSEER
NO. 31
DATE 10/15/57

PROFILE
SIGNED
PROFES.
NOTE BOOK PLANNING OVERSEER
NO. 31
DATE 10/15/57