
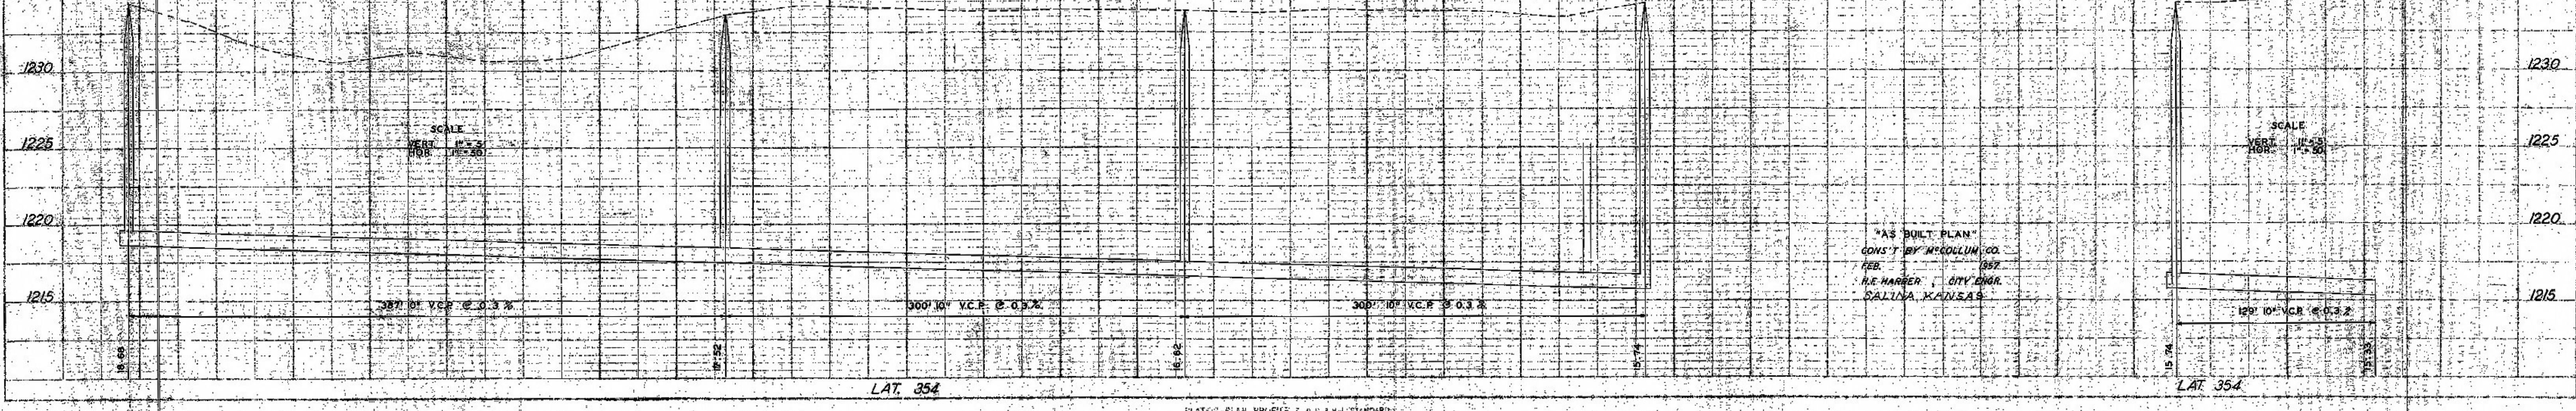
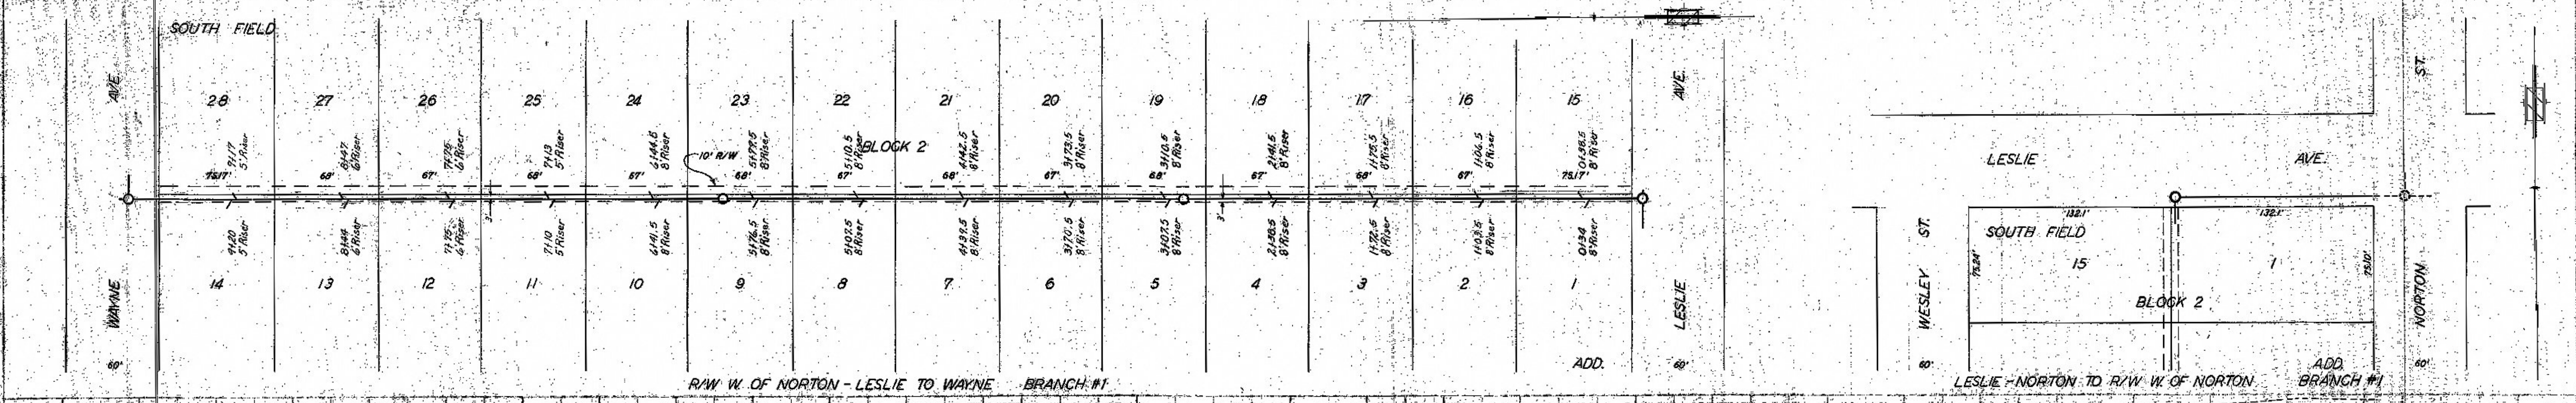
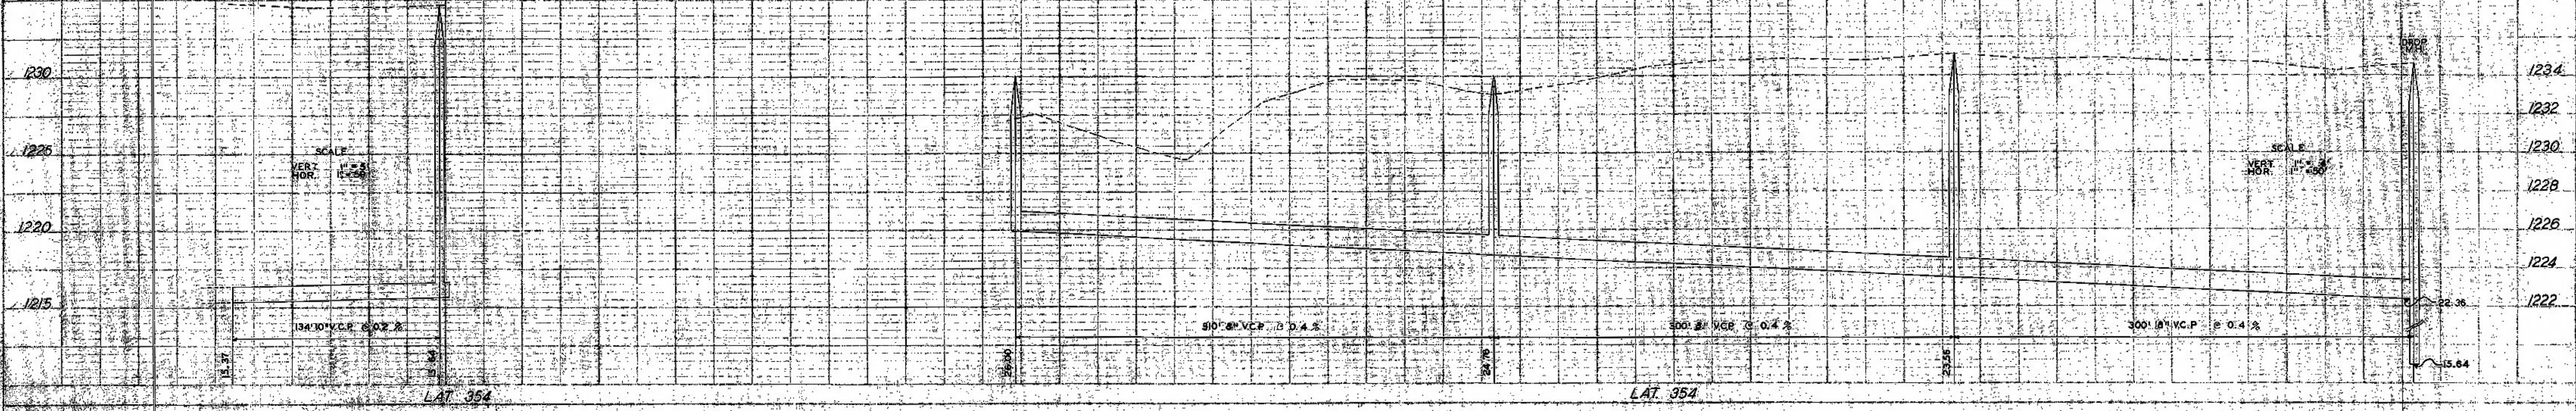


282

PLAN  
 SHEET NO. 1  
 DATE  
 BY  
 CHECKED  
 APPROVED

PROFILE  
 SHEET NO. 1  
 DATE  
 BY  
 CHECKED  
 APPROVED

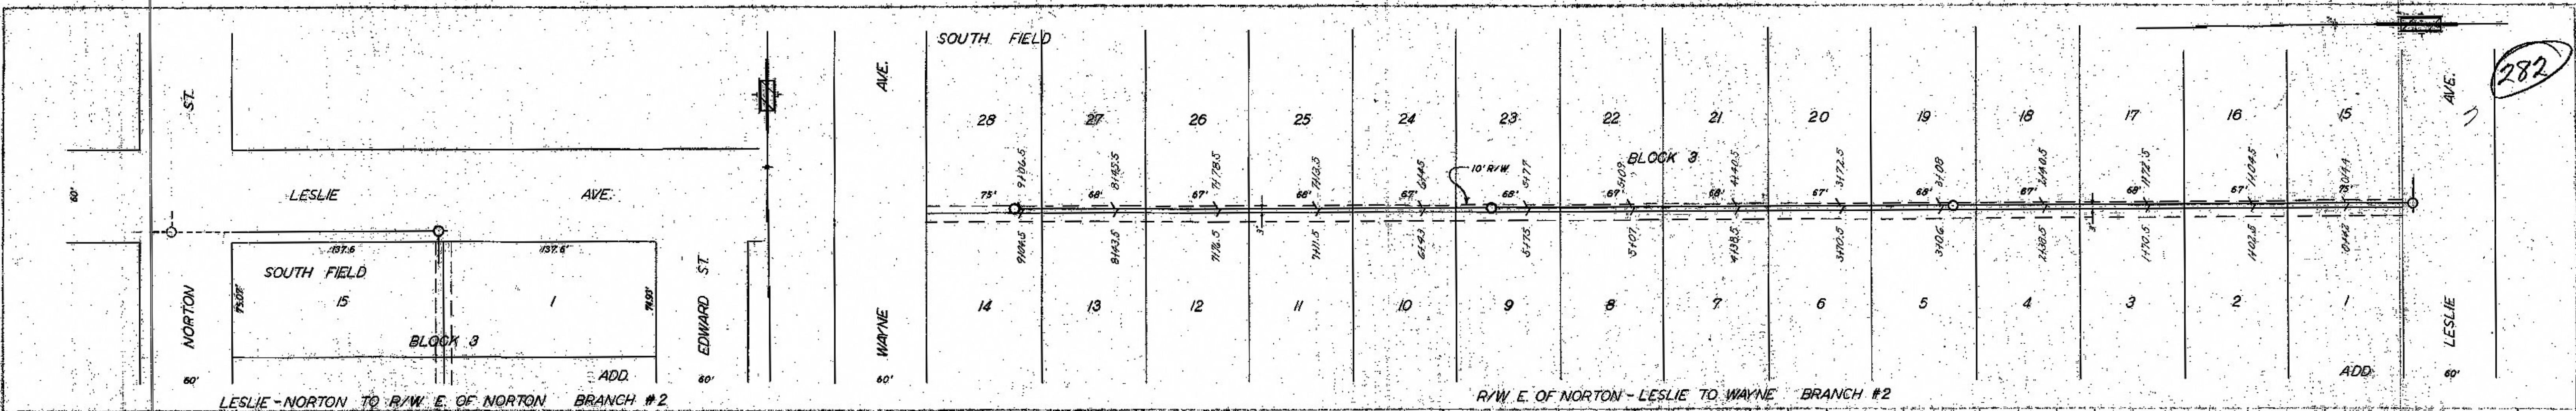

"AS BUILT PLAN"  
 CONST. BY MCCOLLUM CO.  
 FEB. 1927  
 H.E. HARRER, CITY ENGR.  
 SALINA, KANSAS