



PLAN
SCALE
1" = 40'
VERT. SCALE
1" = 5'

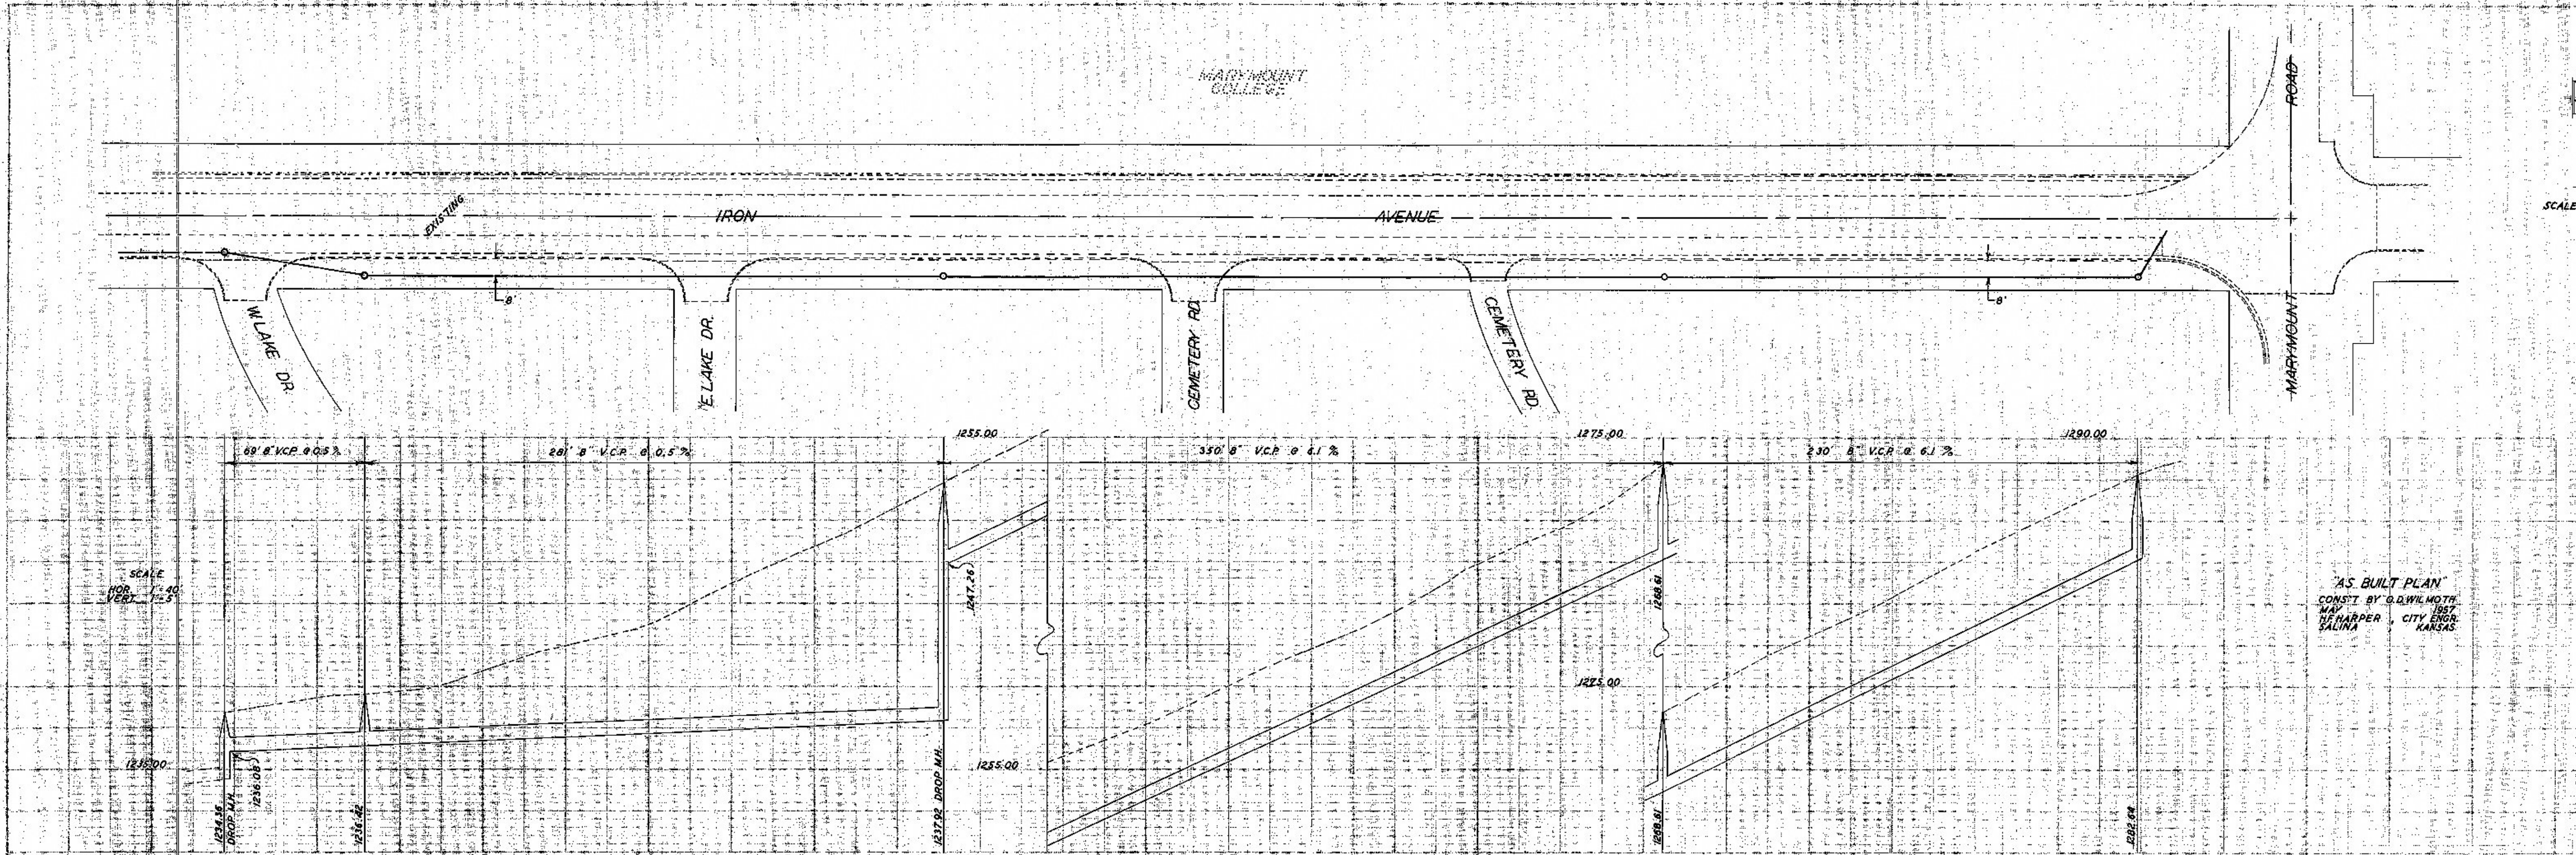

AS BUILT PLAN
CONST. BY G.D. WILMOTH
MAY 1957
WABER, CITY ENGINEER
PALLINA

SCALE 1" = 40'

PROFILE
SCALE
1" = 40'
VERT. SCALE
1" = 5'

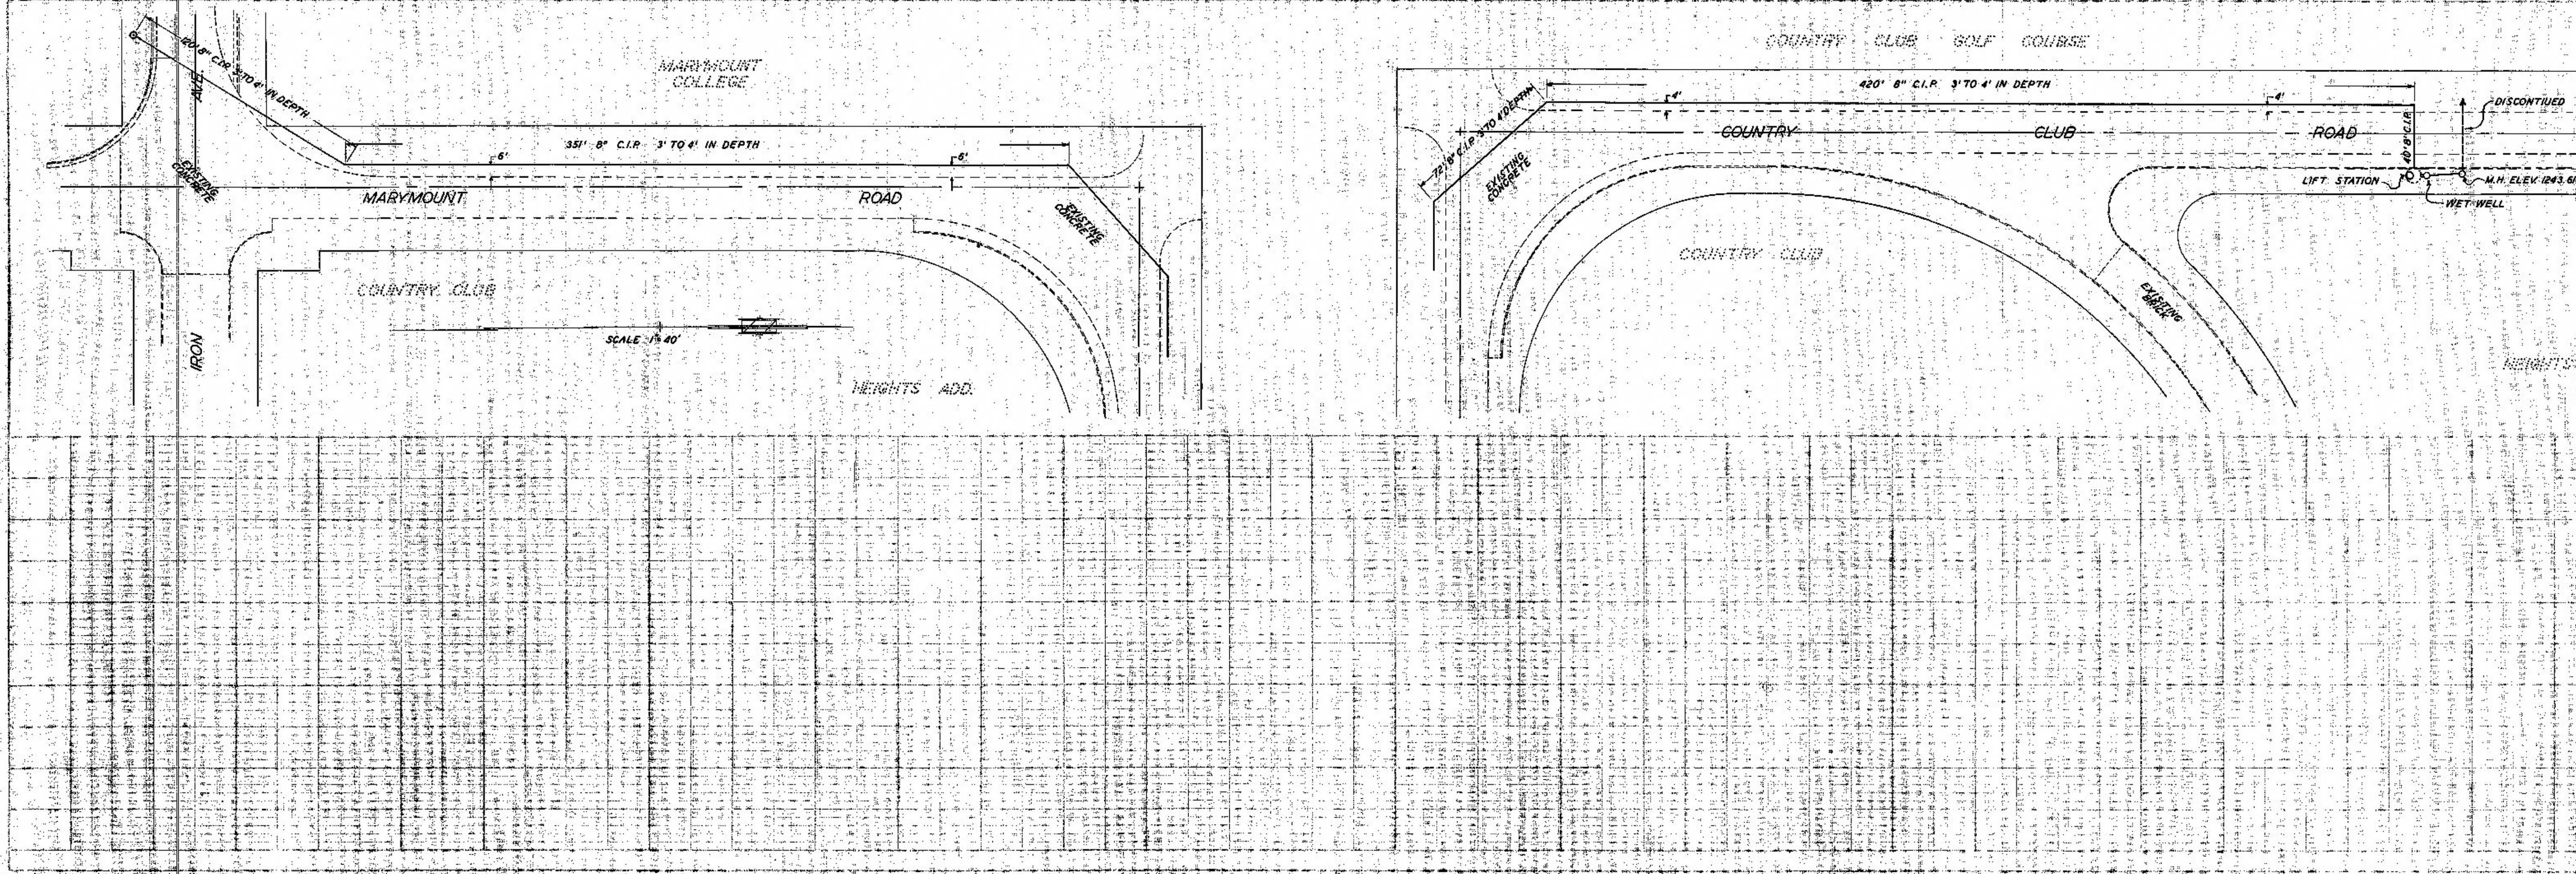

SCALE 1" = 40'

HEIGHTS ADD.