
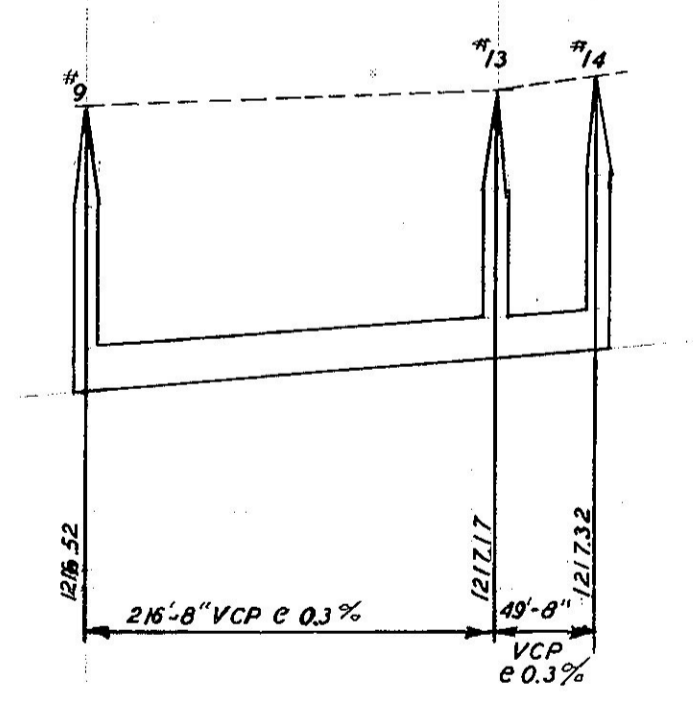
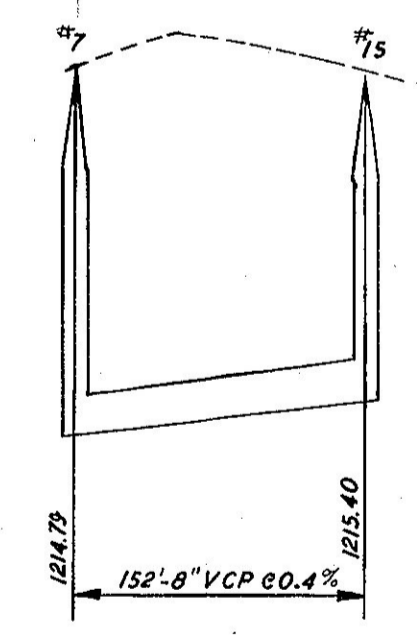
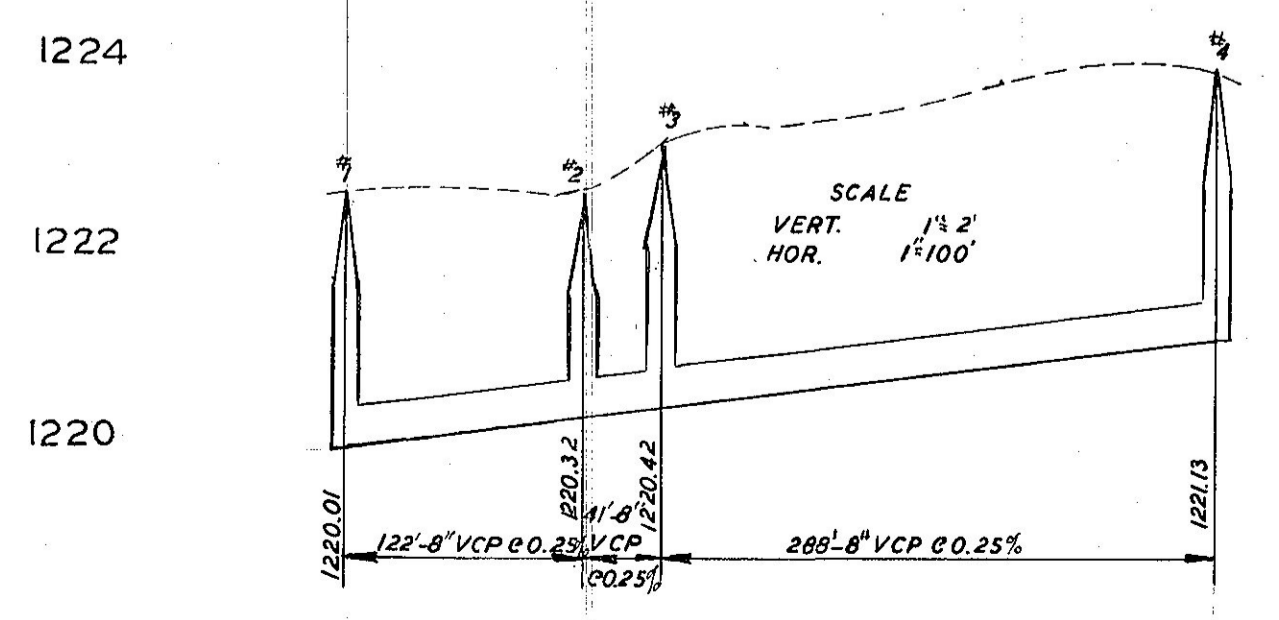
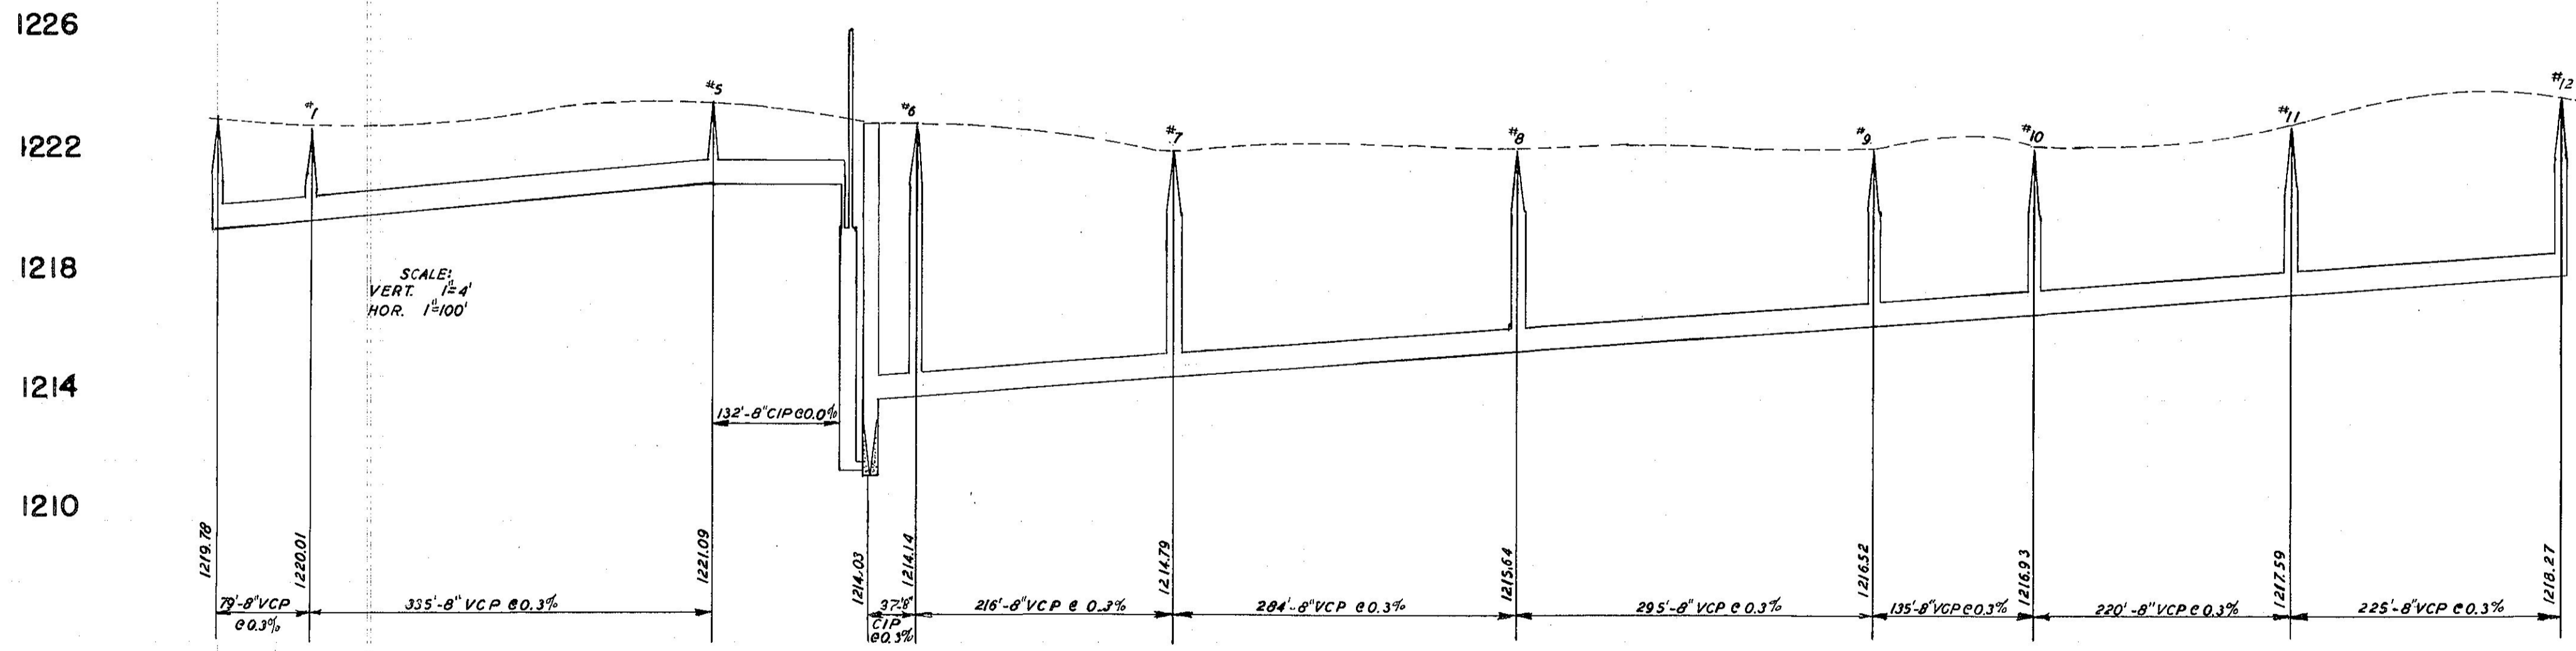
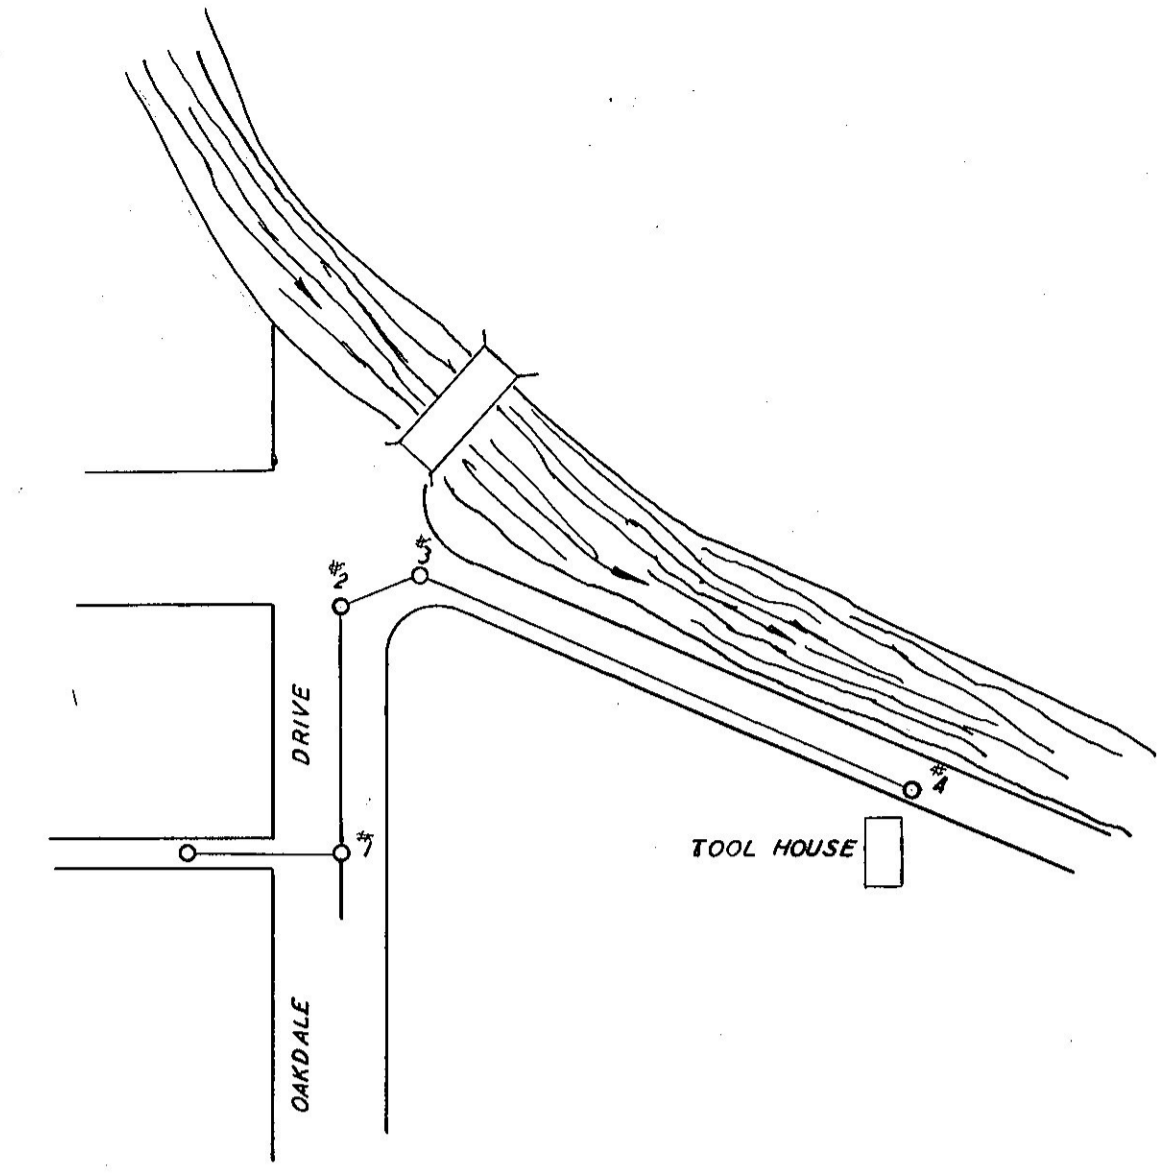


285

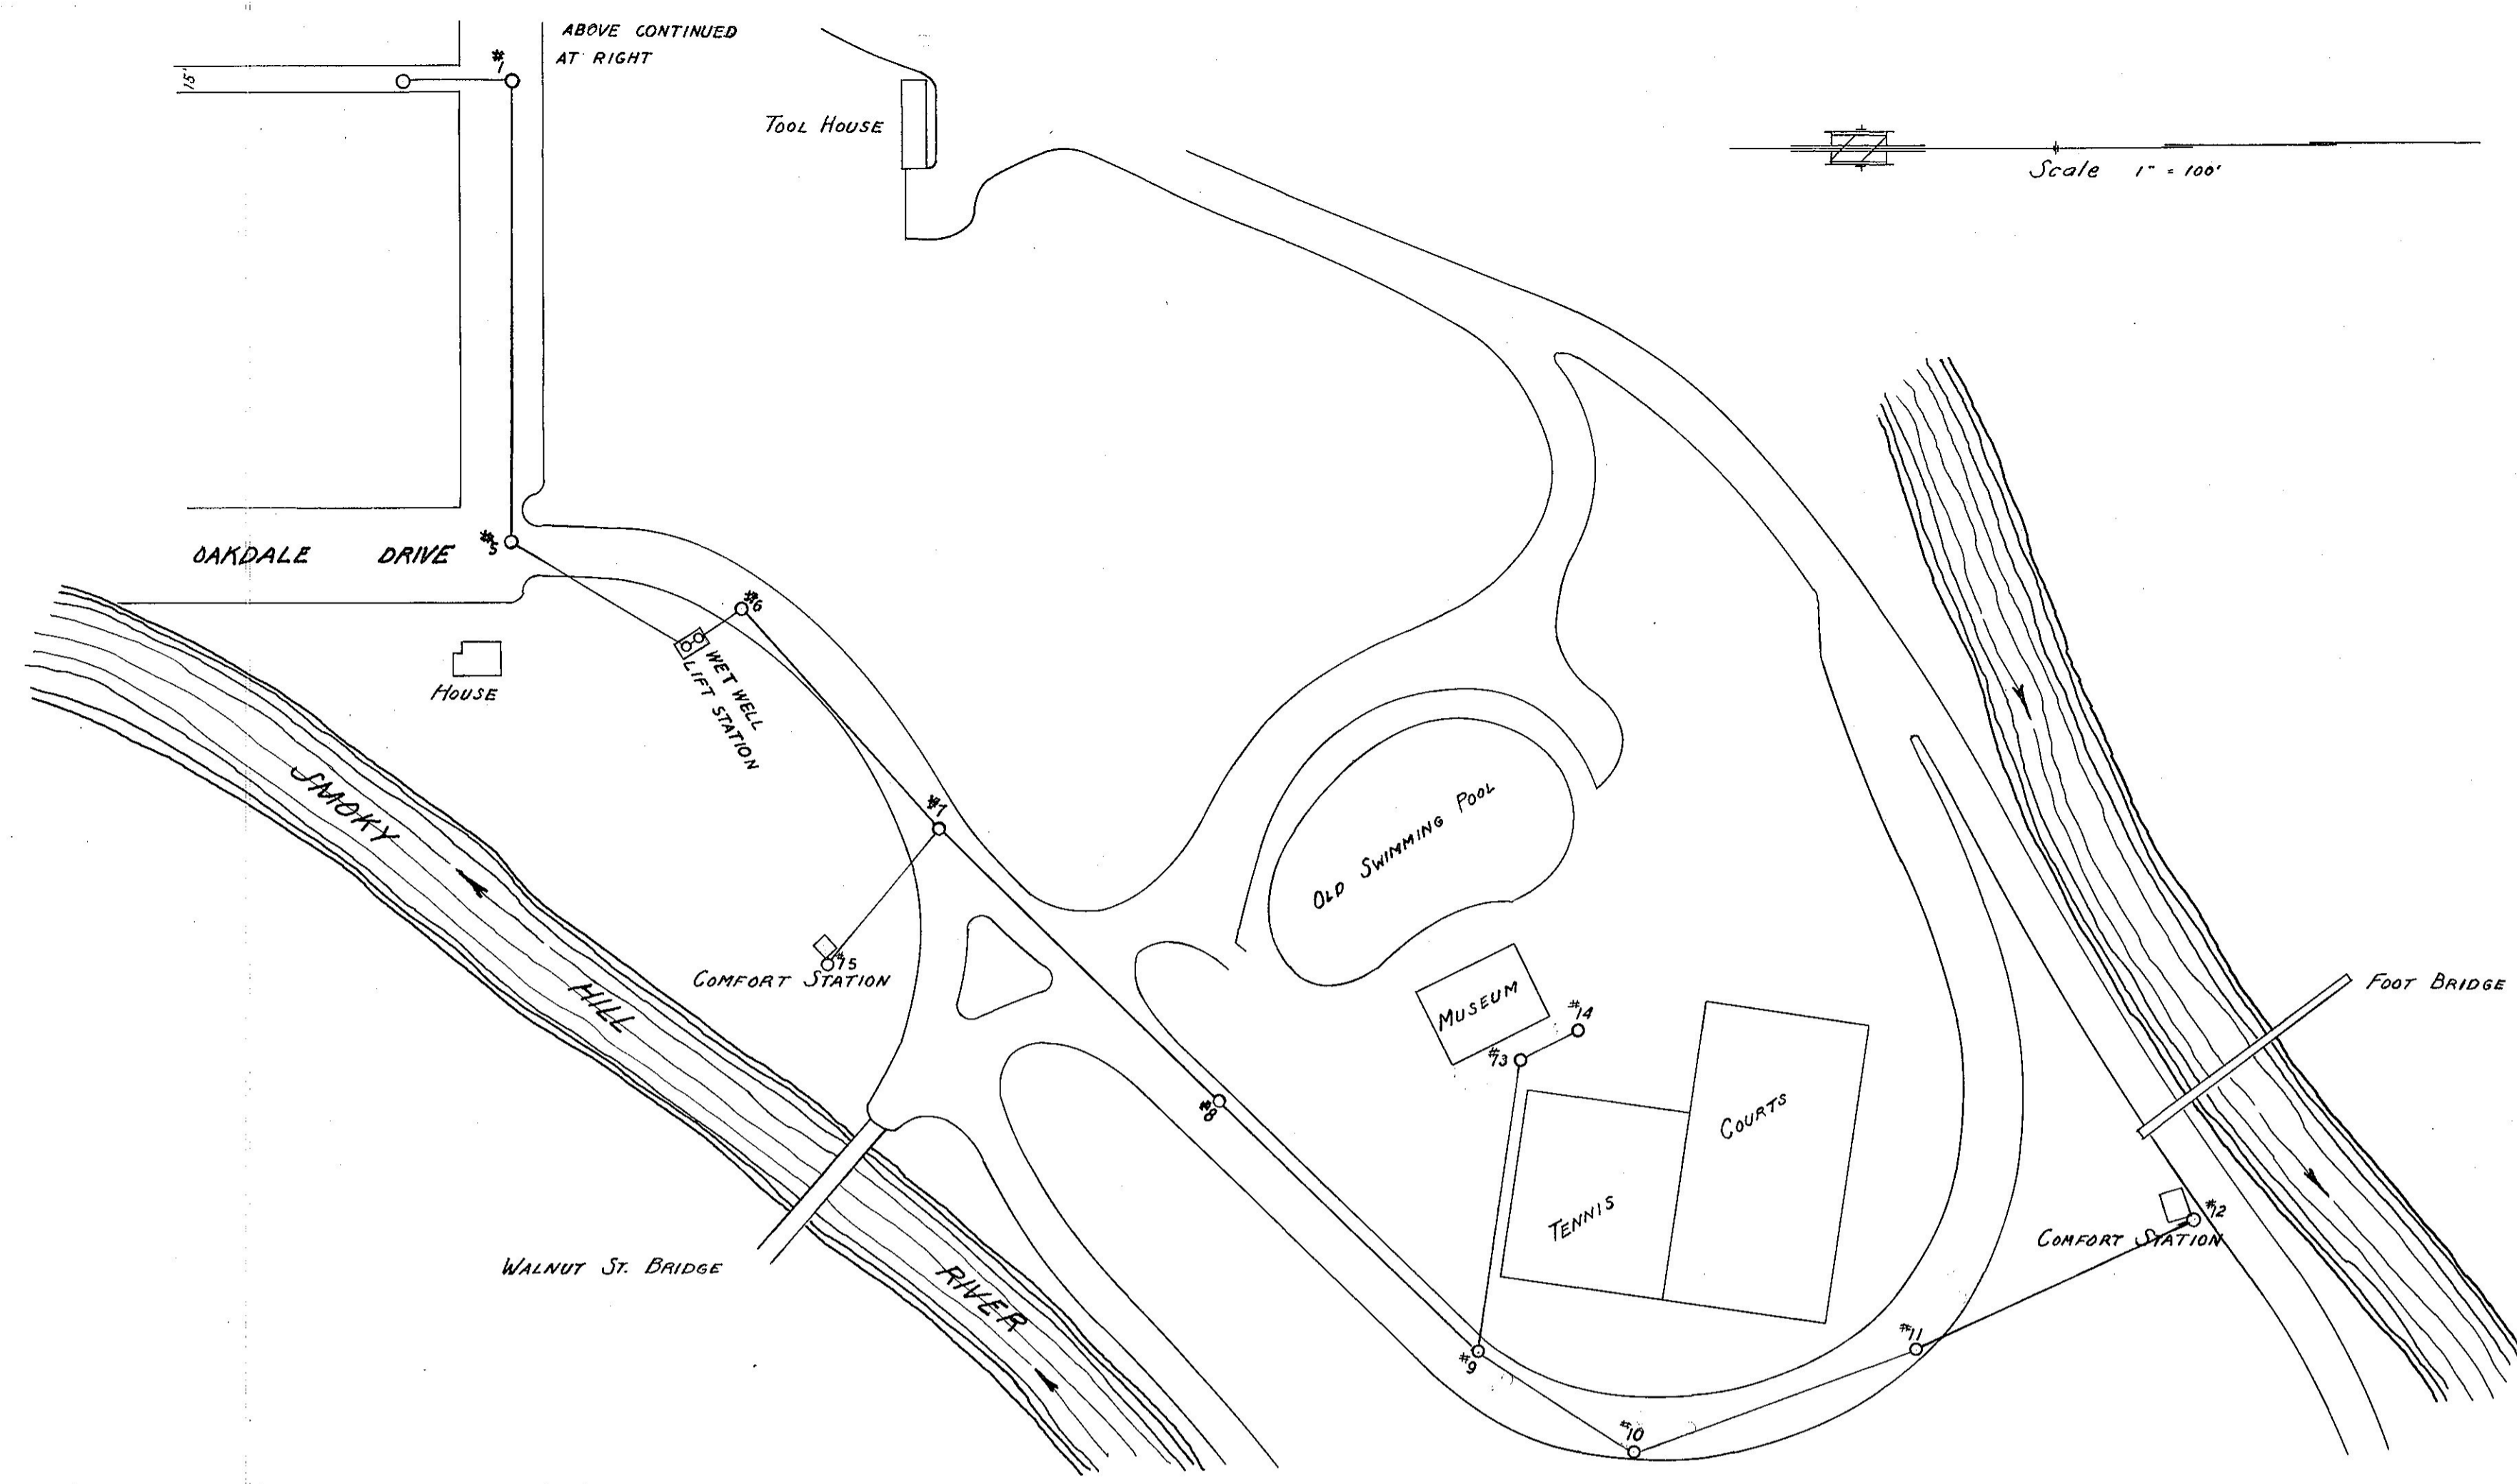

"AS BUILT PLAN"
 CONST BY O.D. WILMOTH/CONST
 MAR. 1937
 H.F. HARPER CITY ENGR
 SALINA KANSAS