



PLAN
UNPLATTED

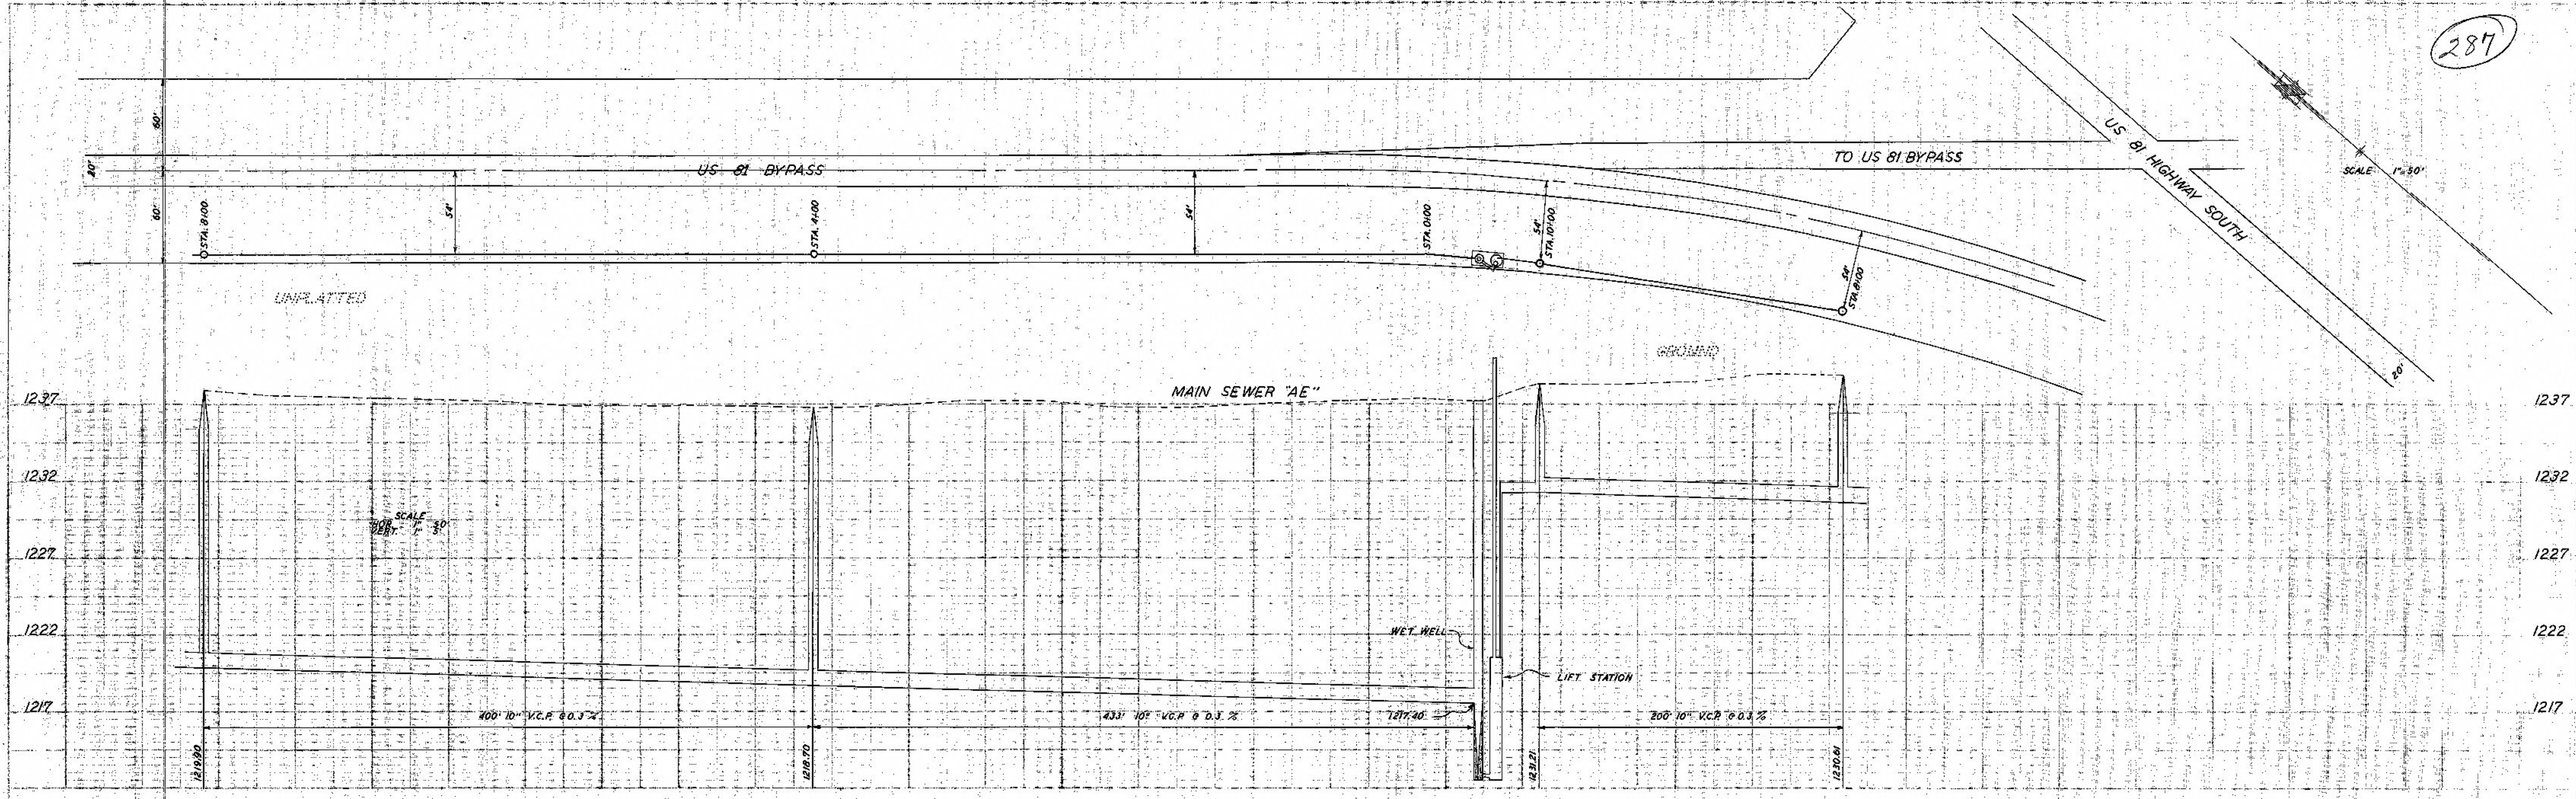

PROFILE
UNPLATTED

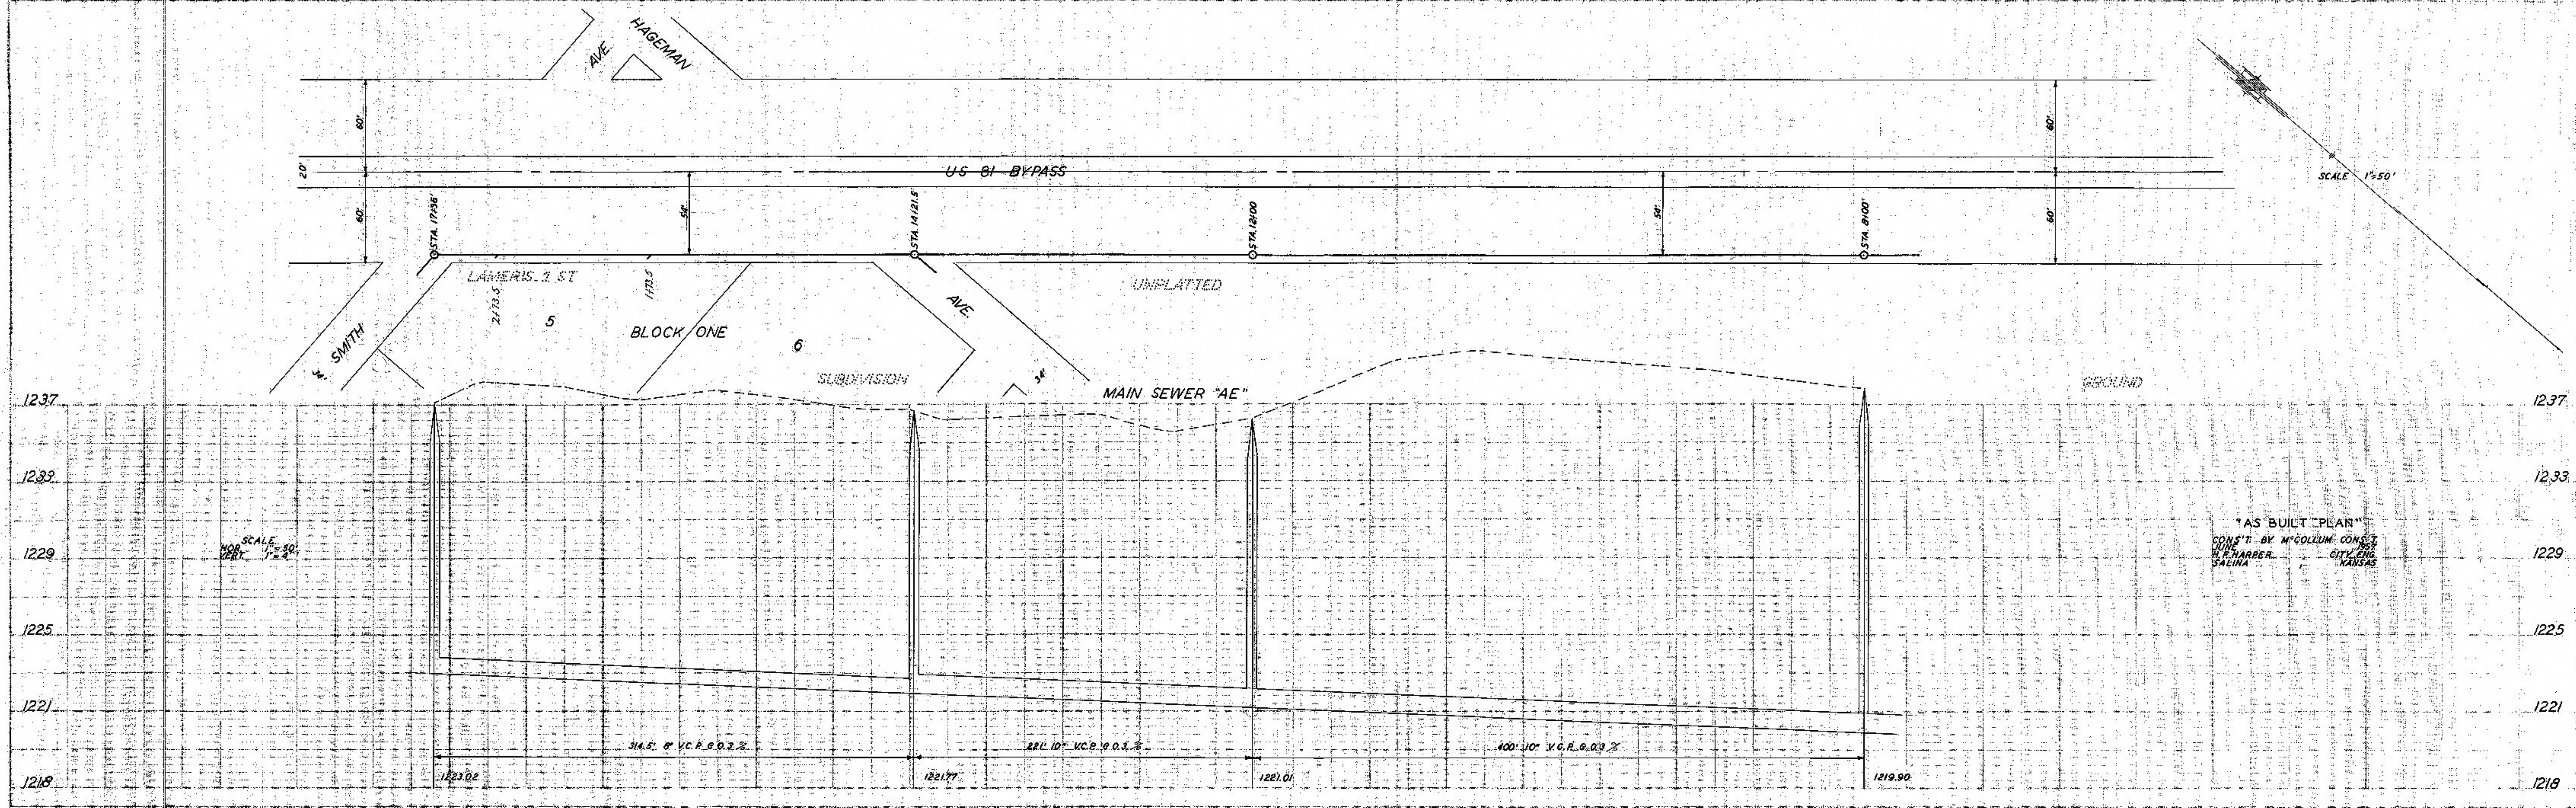

"AS BUILT" PLAN
CONS'T BY MCGILLUM CONSULTING ENGINEERS
SALINA, KANSAS