

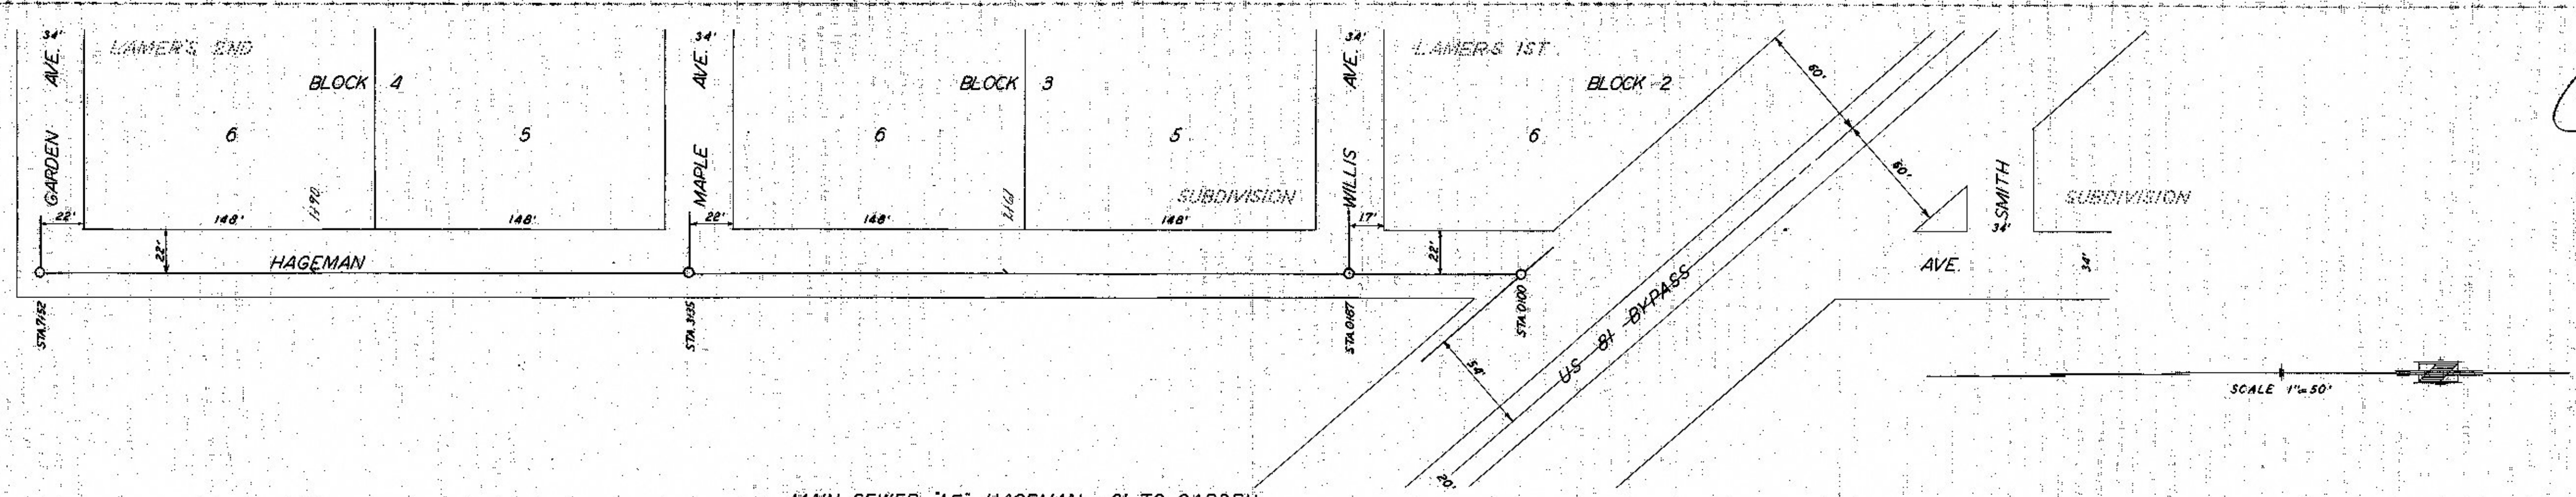



288

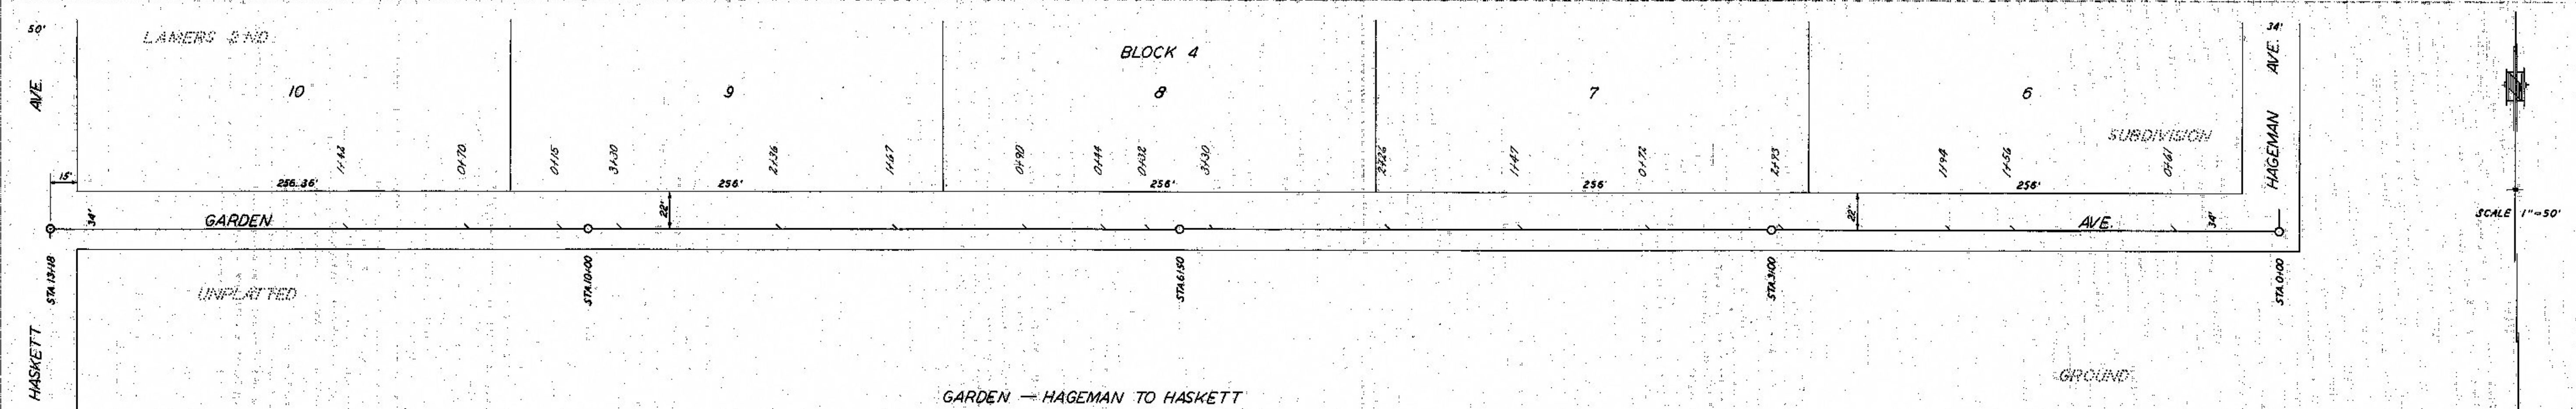

MAIN SEWER 'AE' HAGEMAN - 81 TO GARDEN

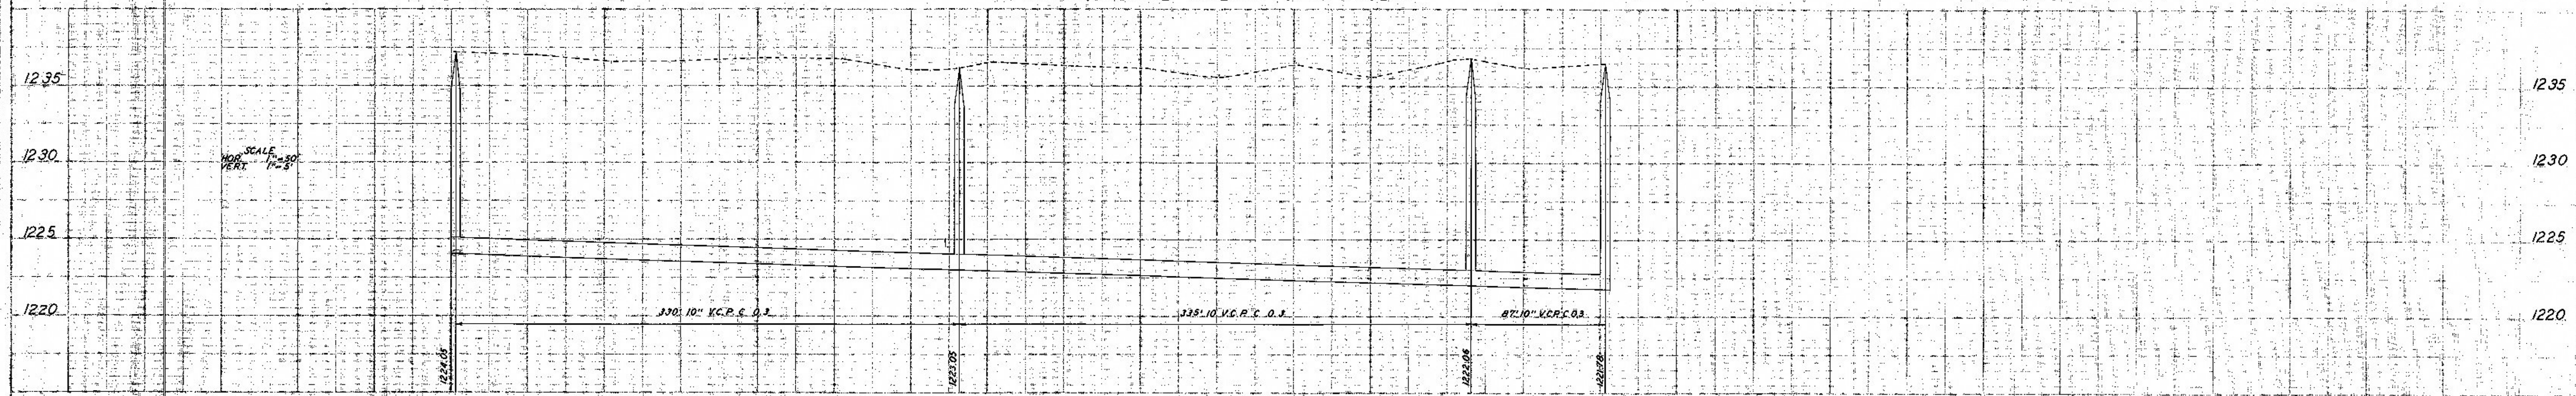

GARDEN - HAGEMAN TO HASKETT

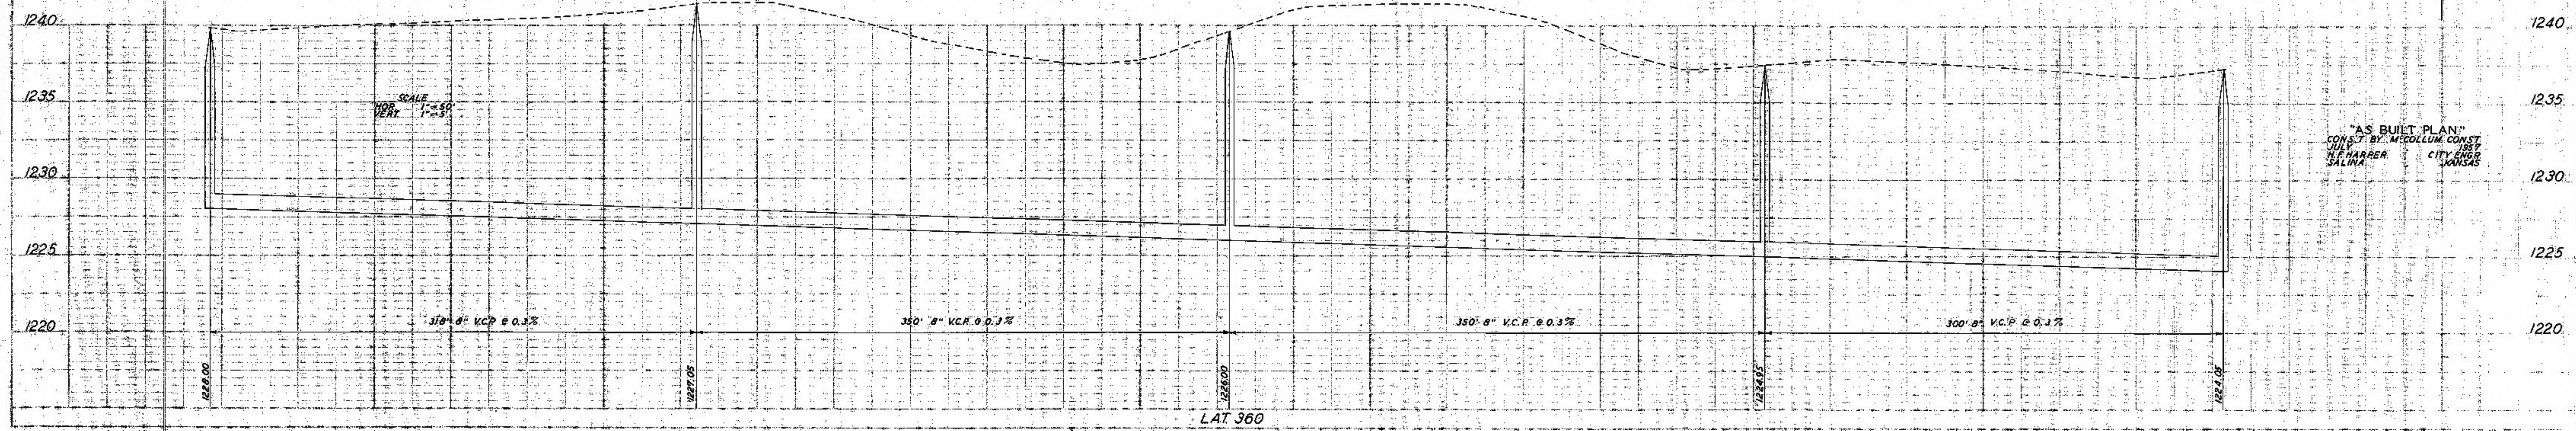

LAT 360

"AS BUILT PLAN"  
CONSULT BY: MCDONALD, CONSTRUCTION  
JULY 1987  
S. L. HARPER CITY ENGINEER  
MANAGER

PLAN  
DATE: 7/1/87  
DRAWN BY: J. L. COLLINS  
CHECKED BY: S. L. HARPER

PROFILE  
DATE: 7/1/87  
DRAWN BY: J. L. COLLINS  
CHECKED BY: S. L. HARPER