
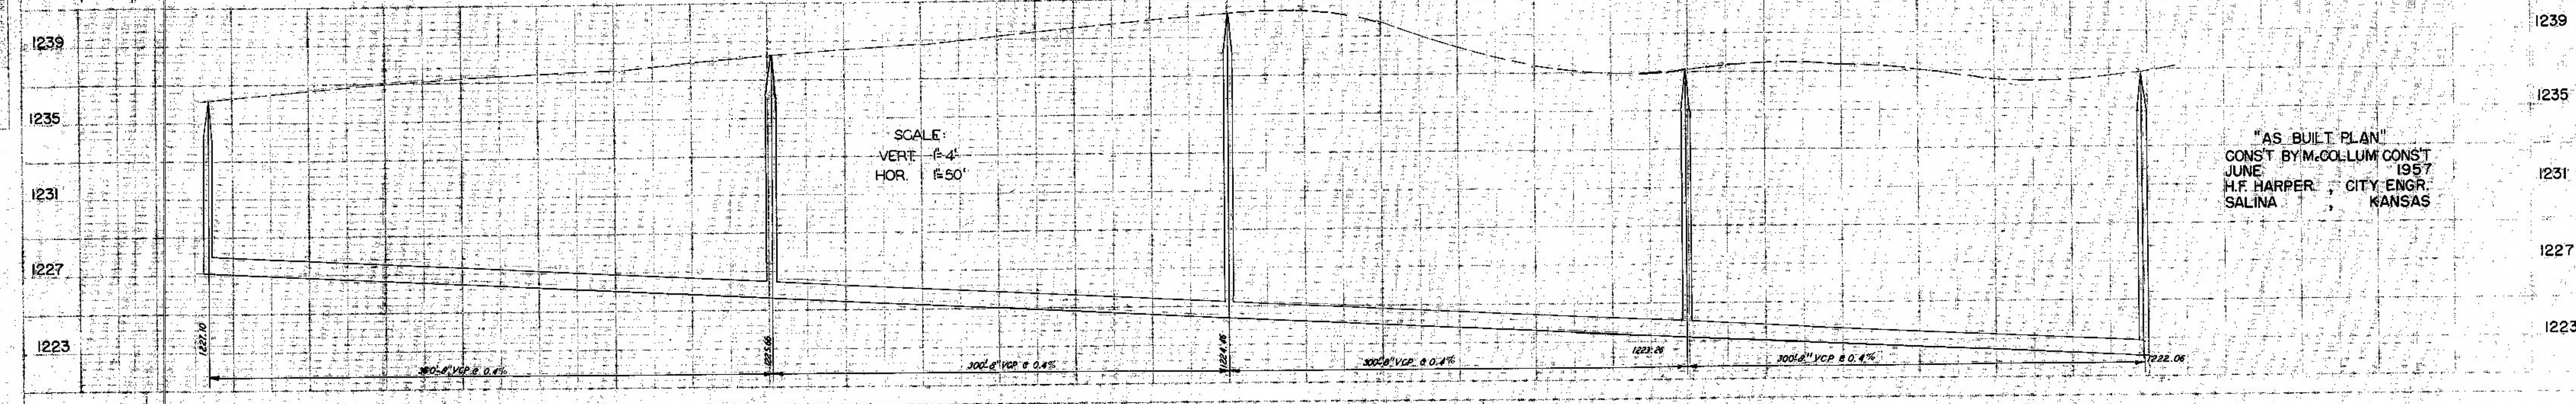
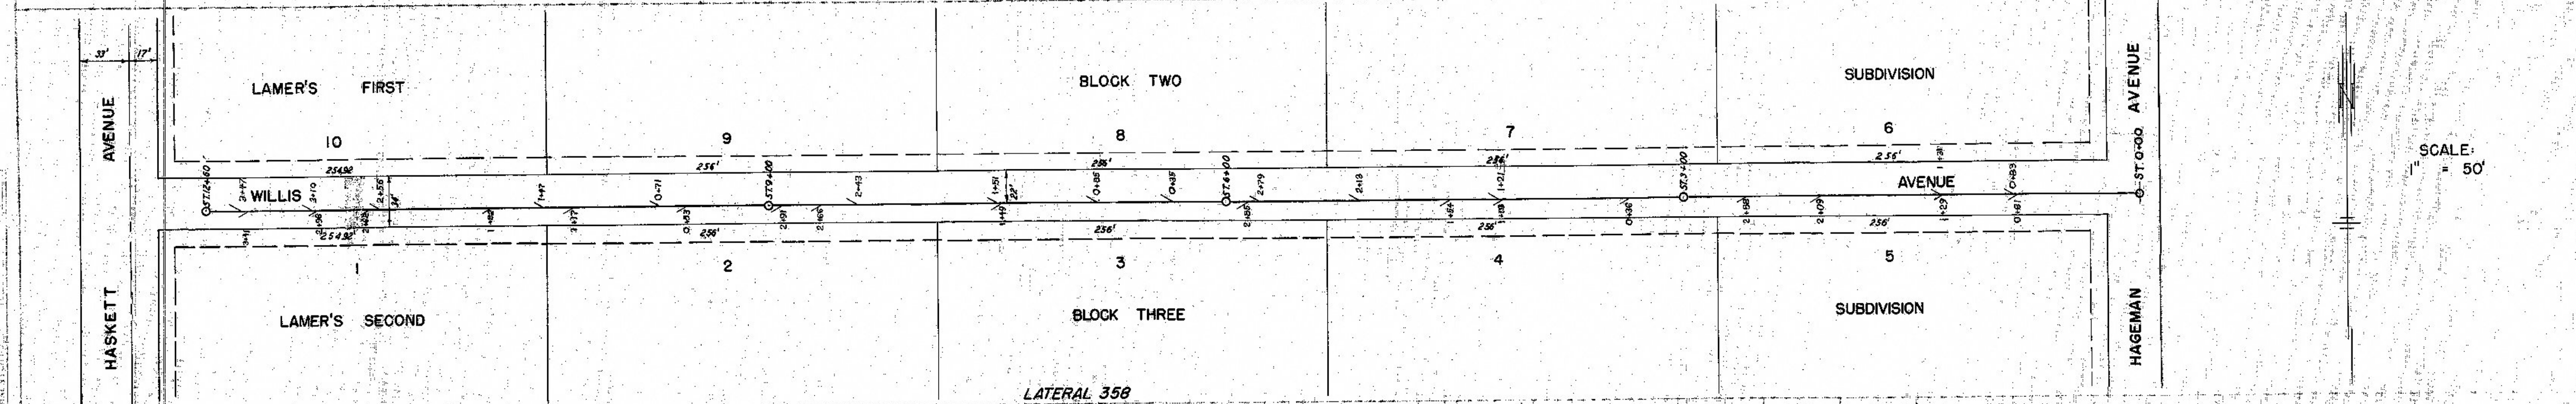
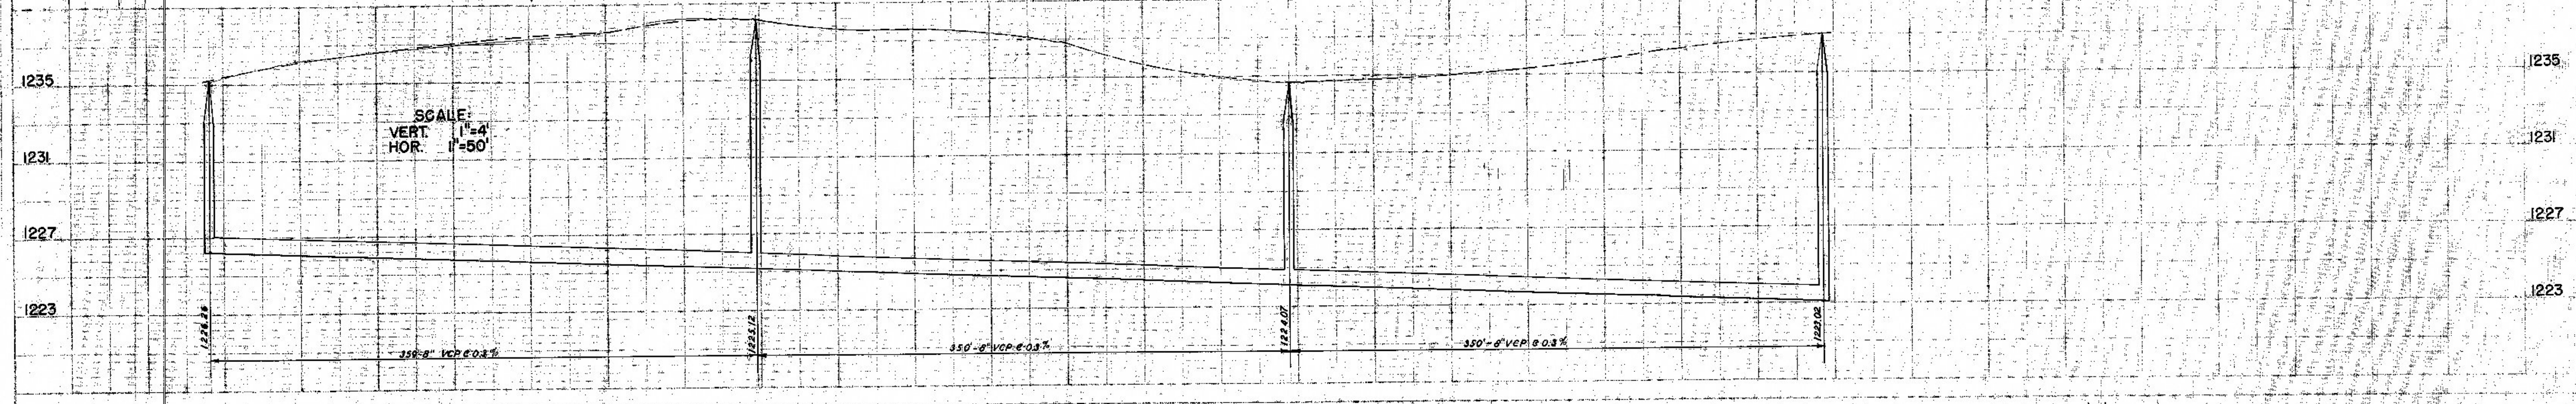


66-70-197-2

290

SCALE:  
1" = 50'

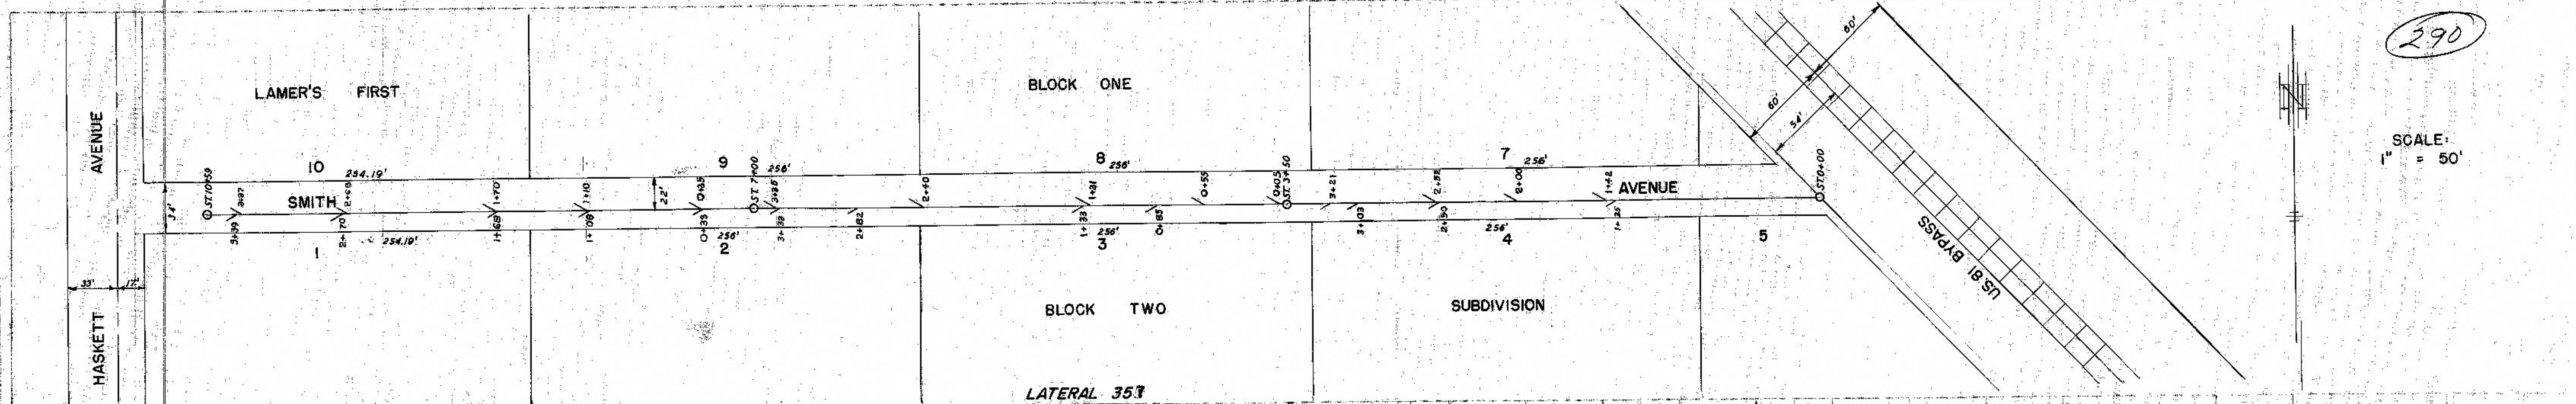

"AS BUILT PLAN"  
 CONST. BY M. COLLUM CONST. CO.  
 JUNE 1957  
 H.F. HARPER, CITY ENGR.  
 SALINA, KANSAS

PLAN  
 SCALE: 1" = 50'  
 DATE: 10/1/57  
 DRAWN BY: M. COLLUM  
 CHECKED BY: H.F. HARPER

PROFILE  
 SCALE: VERT. 1" = 4', HOR. 1" = 50'  
 DATE: 10/1/57  
 DRAWN BY: M. COLLUM  
 CHECKED BY: H.F. HARPER