



PLAN
PROPOSED
BY WILMOTH CONST CO
OCTOBER 1957
H.F. HARPER
SALINA
CITY ENGR
KANSAS

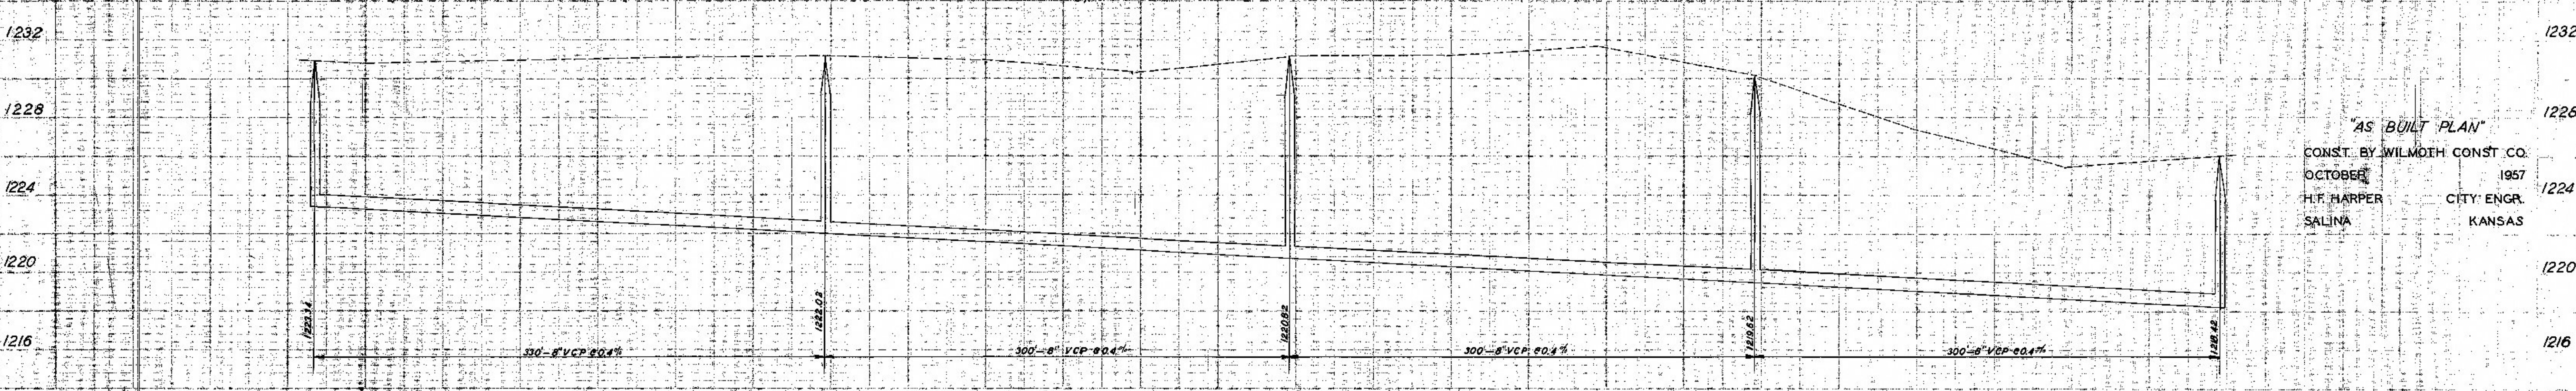

PROFILE
PROPOSED
BY WILMOTH CONST CO
OCTOBER 1957
H.F. HARPER
SALINA
CITY ENGR
KANSAS

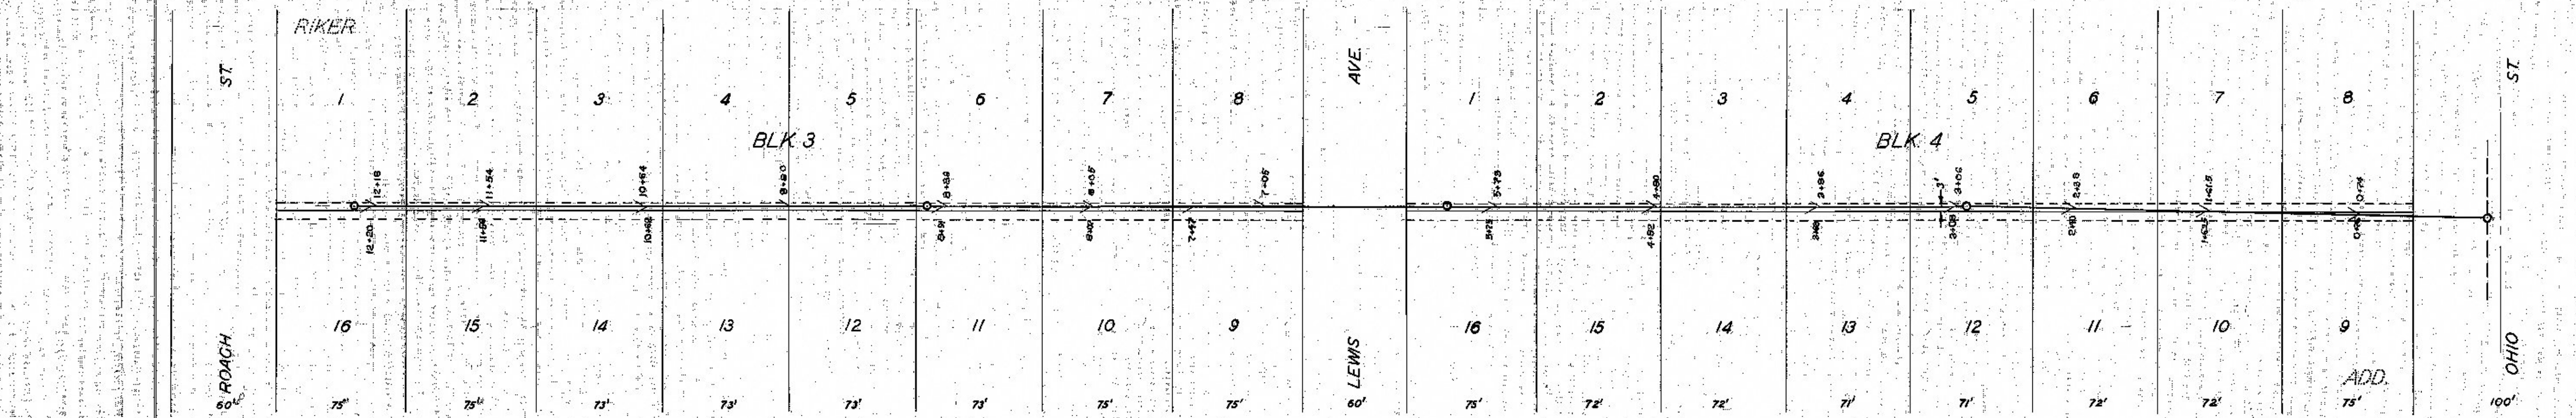