

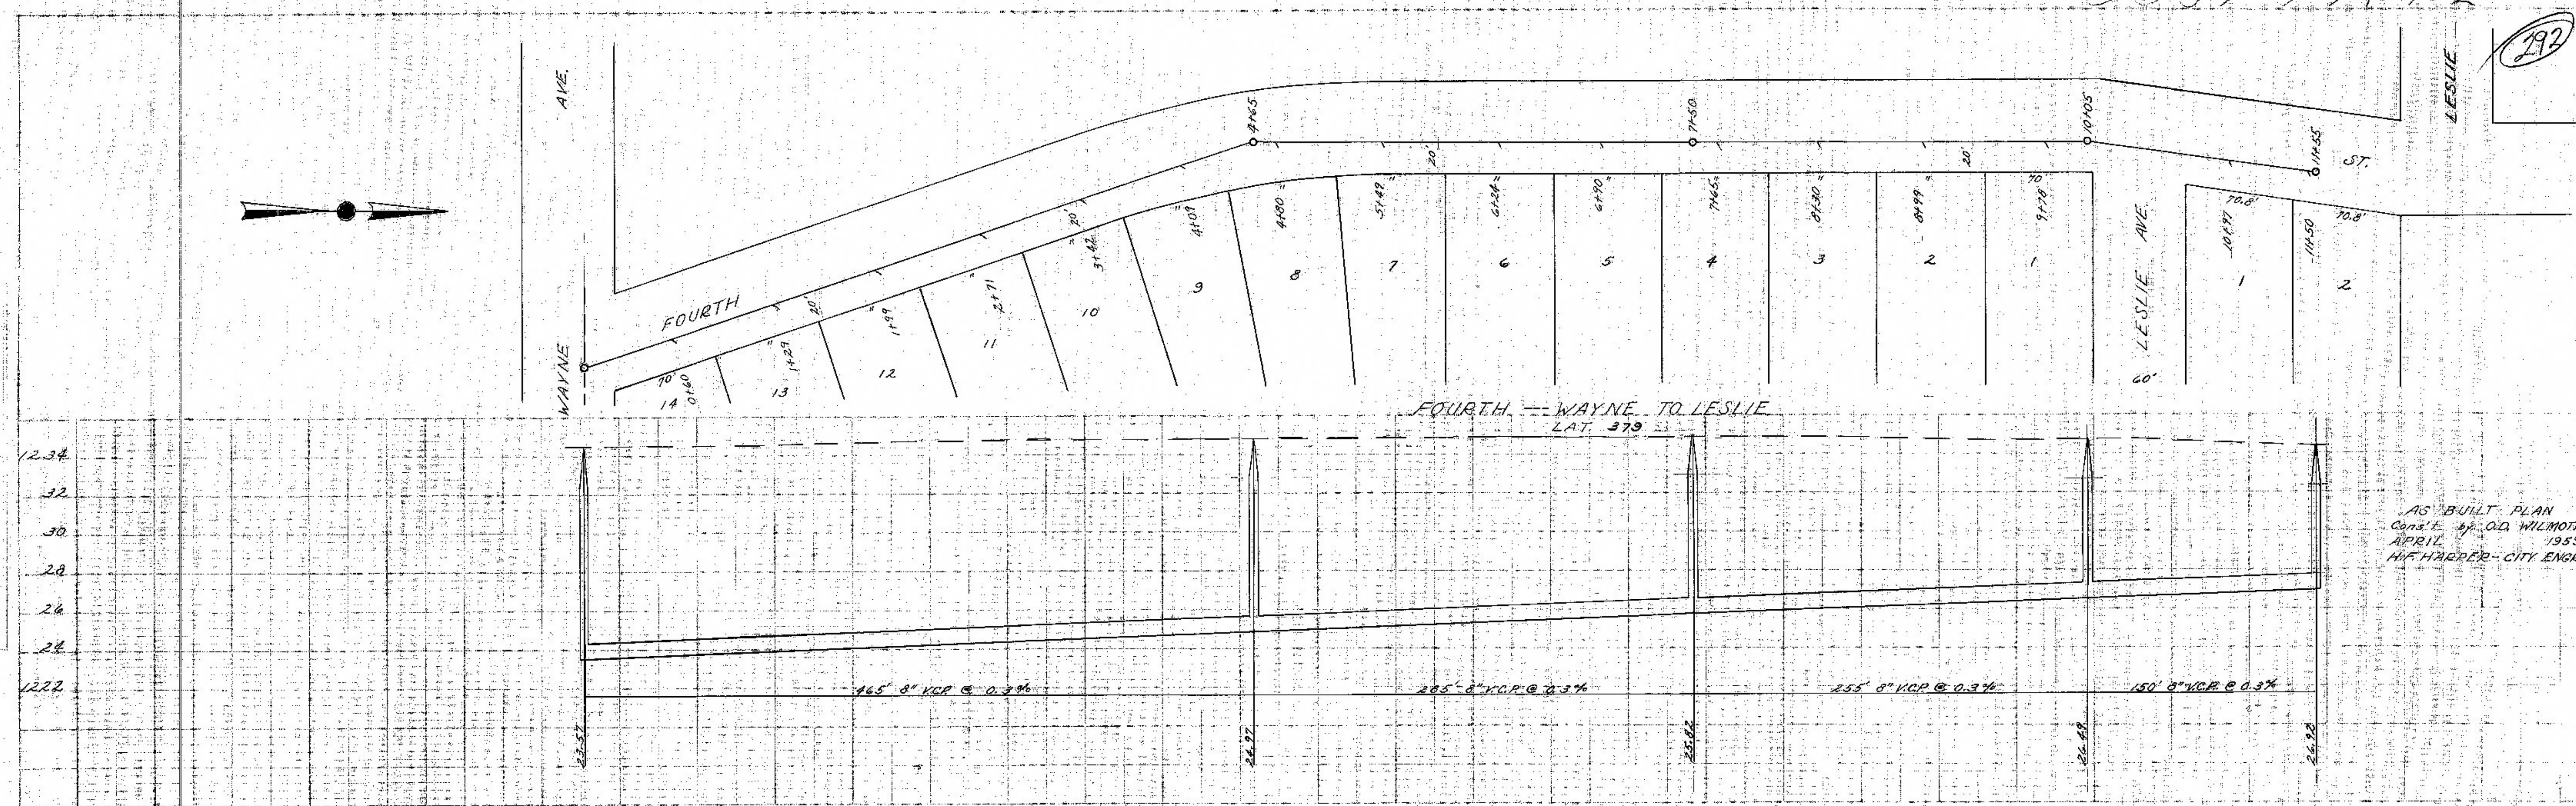
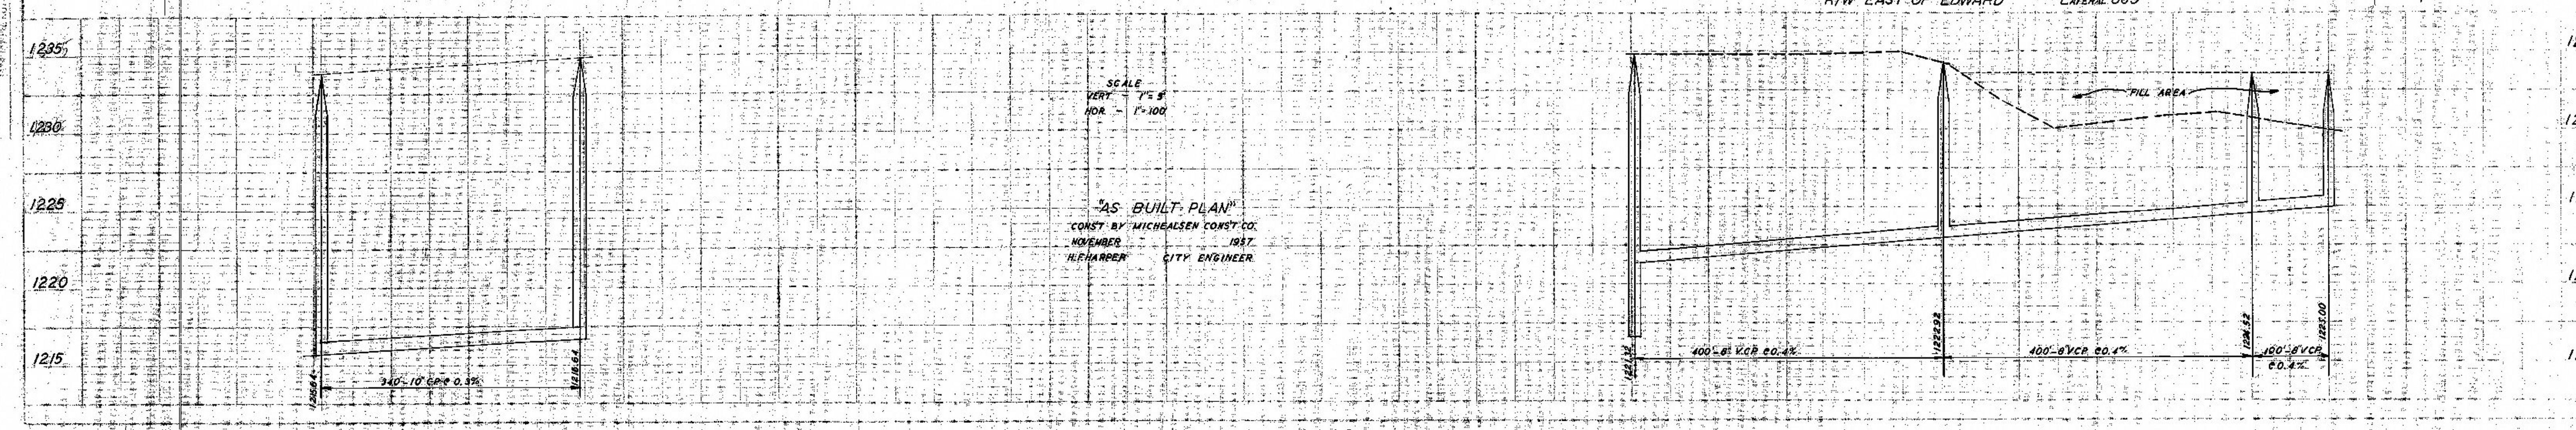


6659 PIA FR  
 292

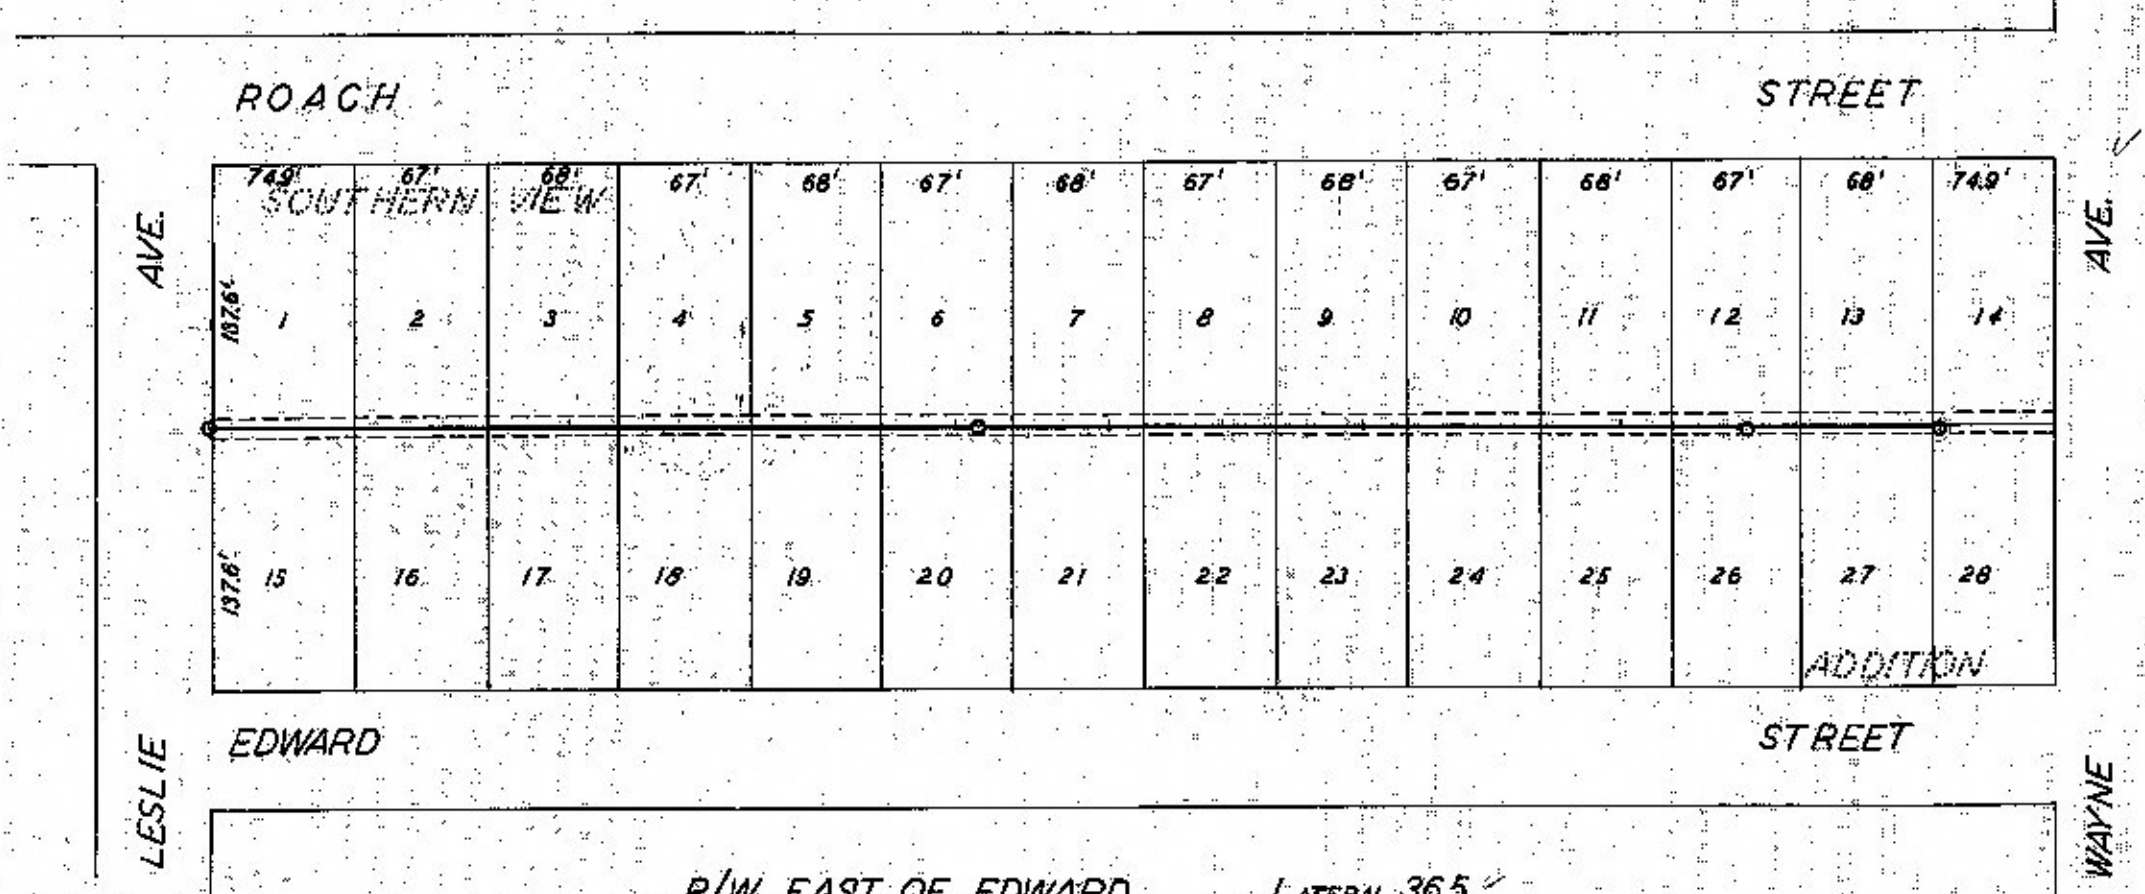

AS BUILT PLAN  
 Const. by O.D. WILLMOTH  
 APRIL 1953  
 H.F. HANSEN - CITY ENGR.

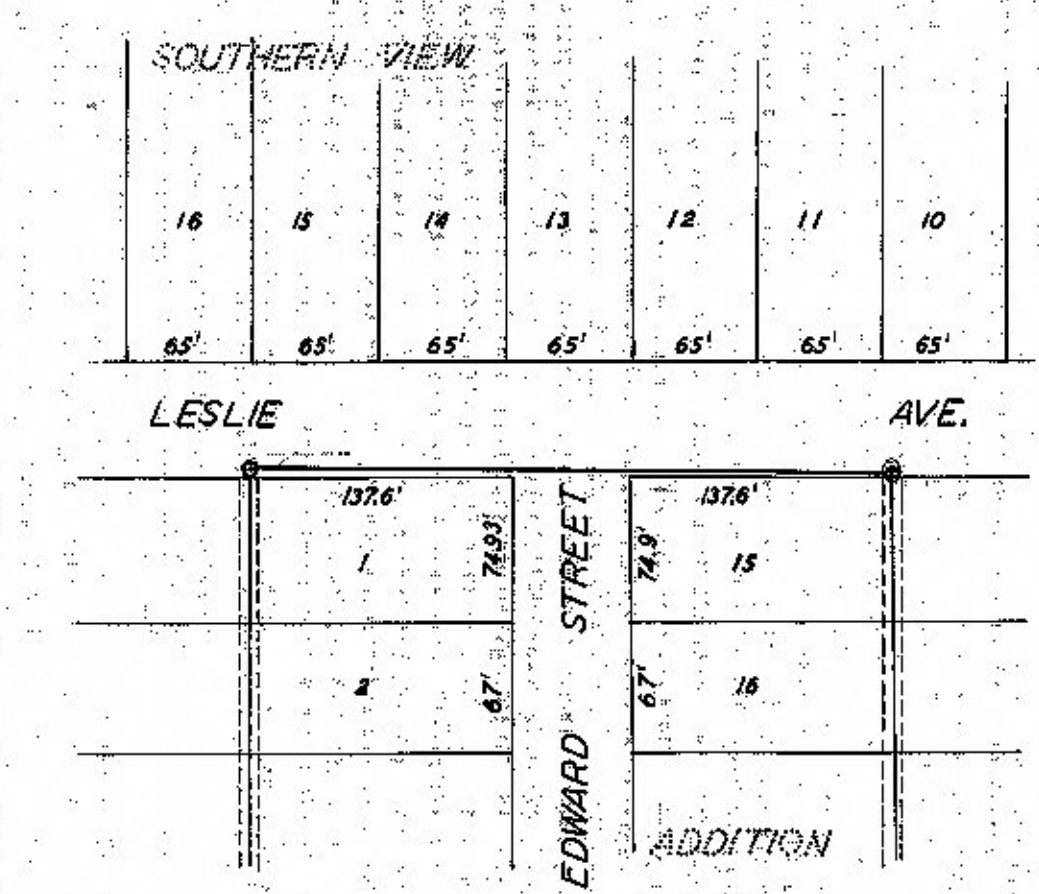

SCALE  
 VERT. 1" = 5'  
 HOR. 1" = 100'

AS BUILT PLAN  
 CONST. BY MICHAELSEN CONST. CO.  
 NOVEMBER 1937  
 H.F. HANSEN CITY ENGINEER

PLAN  
 5' SEE P. 100  
 1" = 100'

PROFILE  
 5' SEE P. 100  
 1" = 100'