
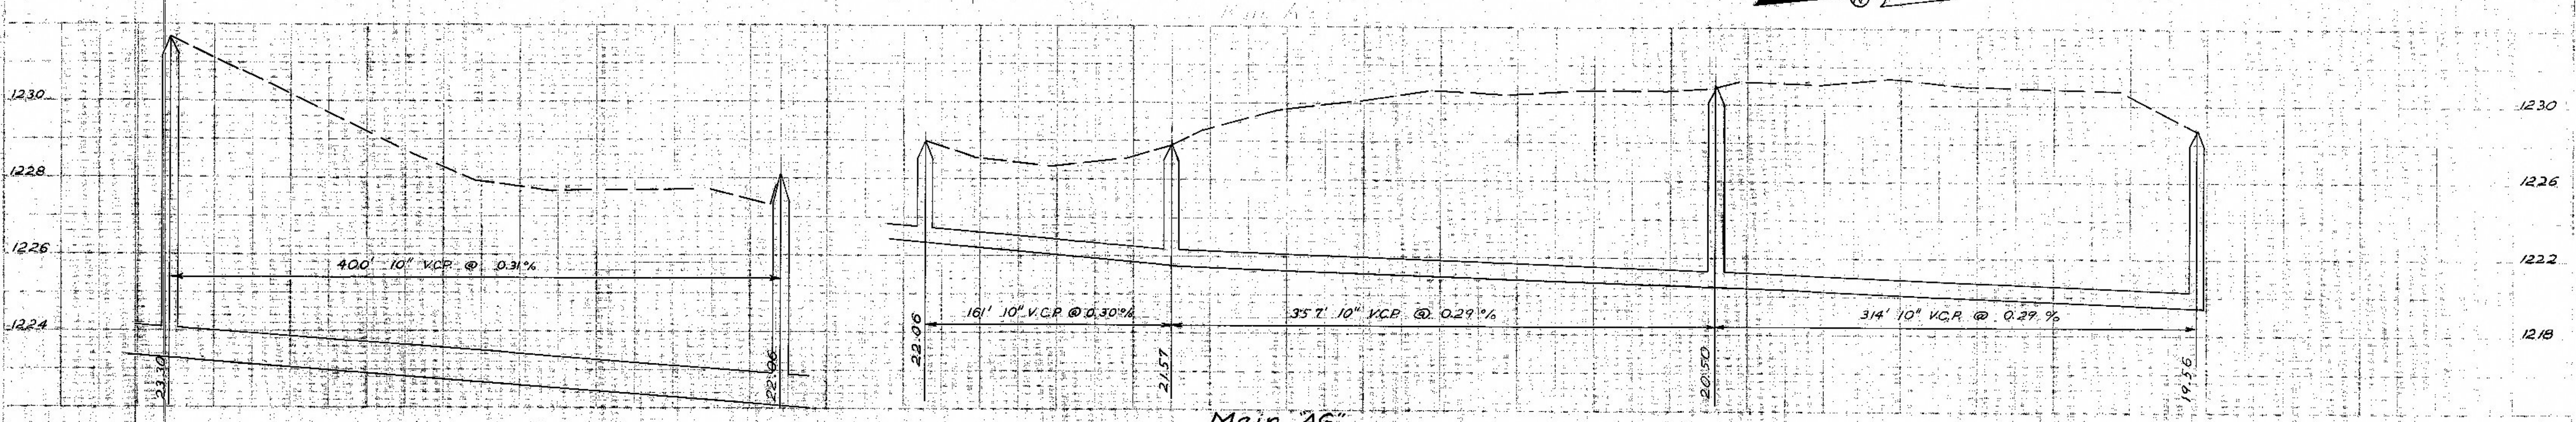
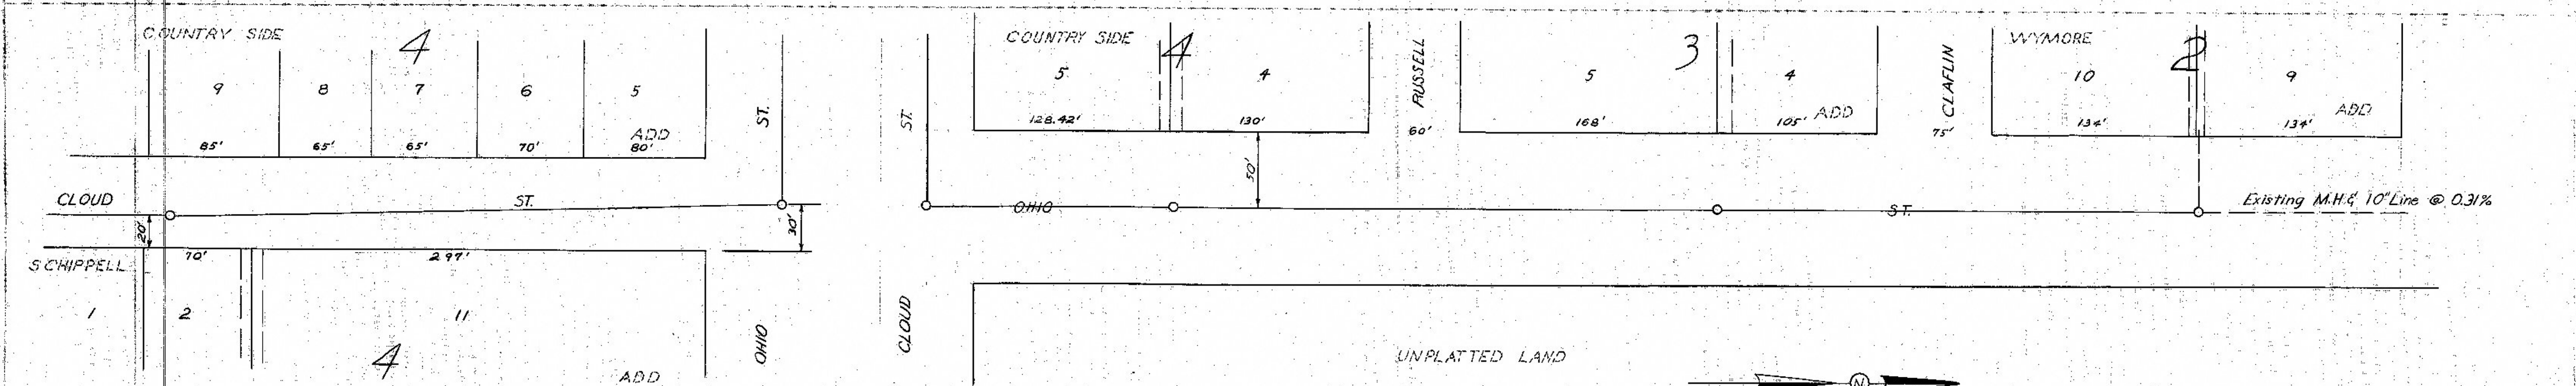
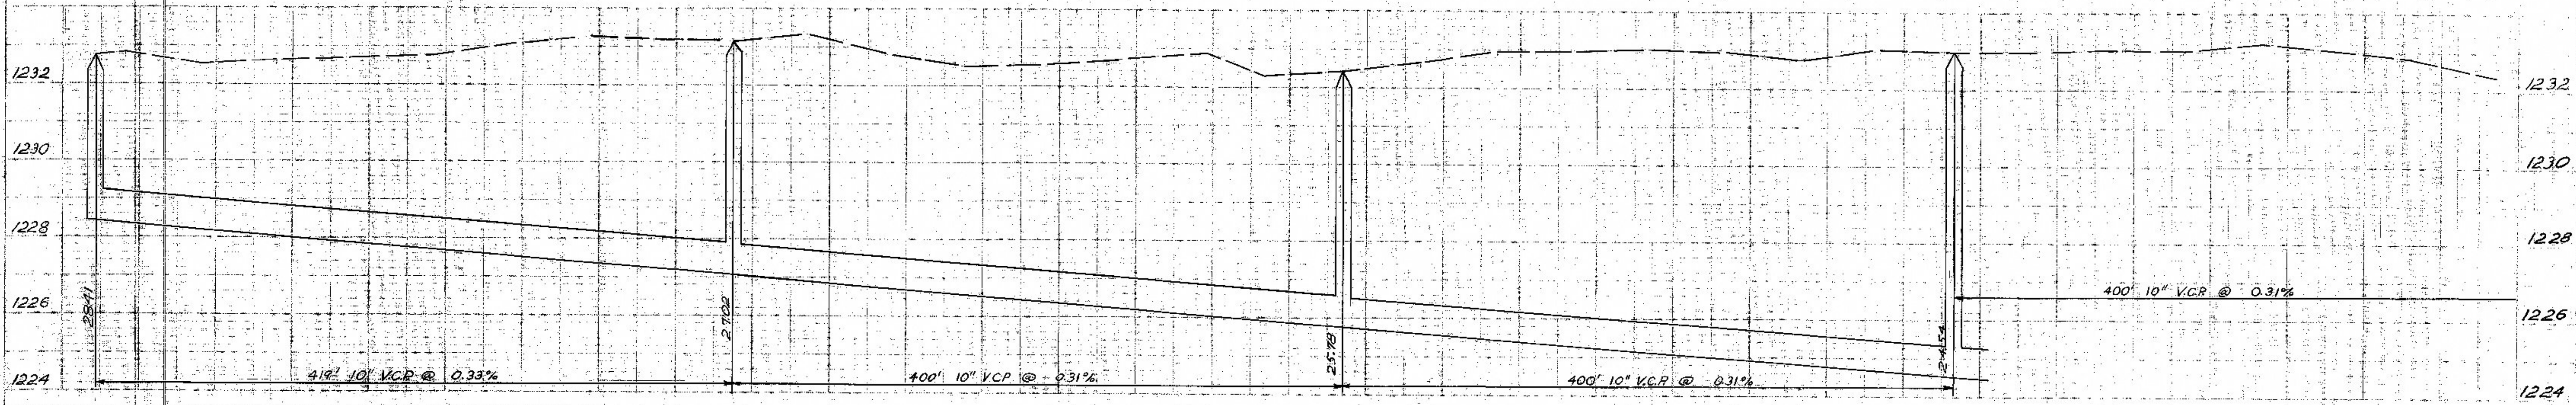


GG-77 P14 T-2

296

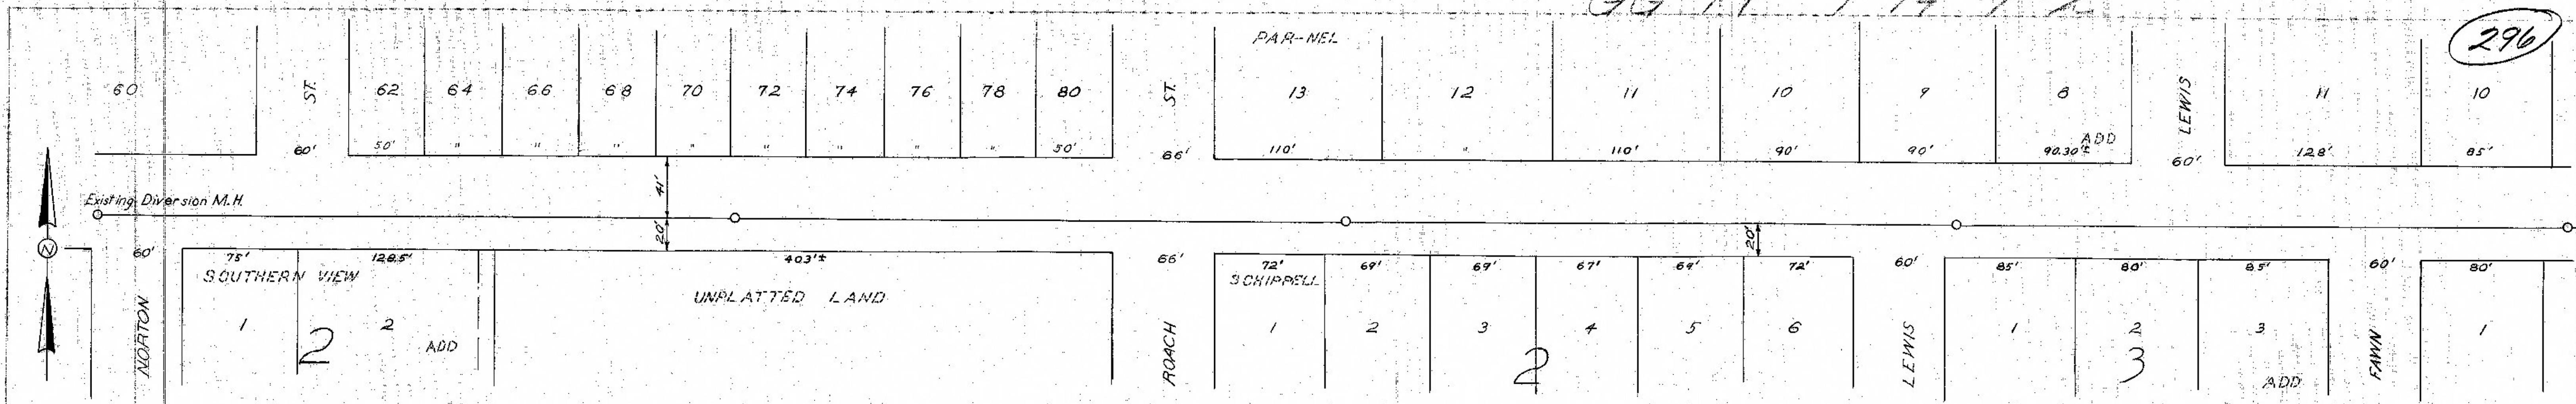

Main AG