


PLAN	DATE
SURVEYED	
DESIGNED	
PROF'D	
NOTE BOOK	
NO. OF SHEETS	
NO. OF SHEETS CHECKED	
NO. OF SHEETS	



PROFILE	DATE
SURVEYED	
DESIGNED	
PROF'D	
NOTE BOOK	
NO. OF SHEETS	
NO. OF SHEETS CHECKED	
NO. OF SHEETS	

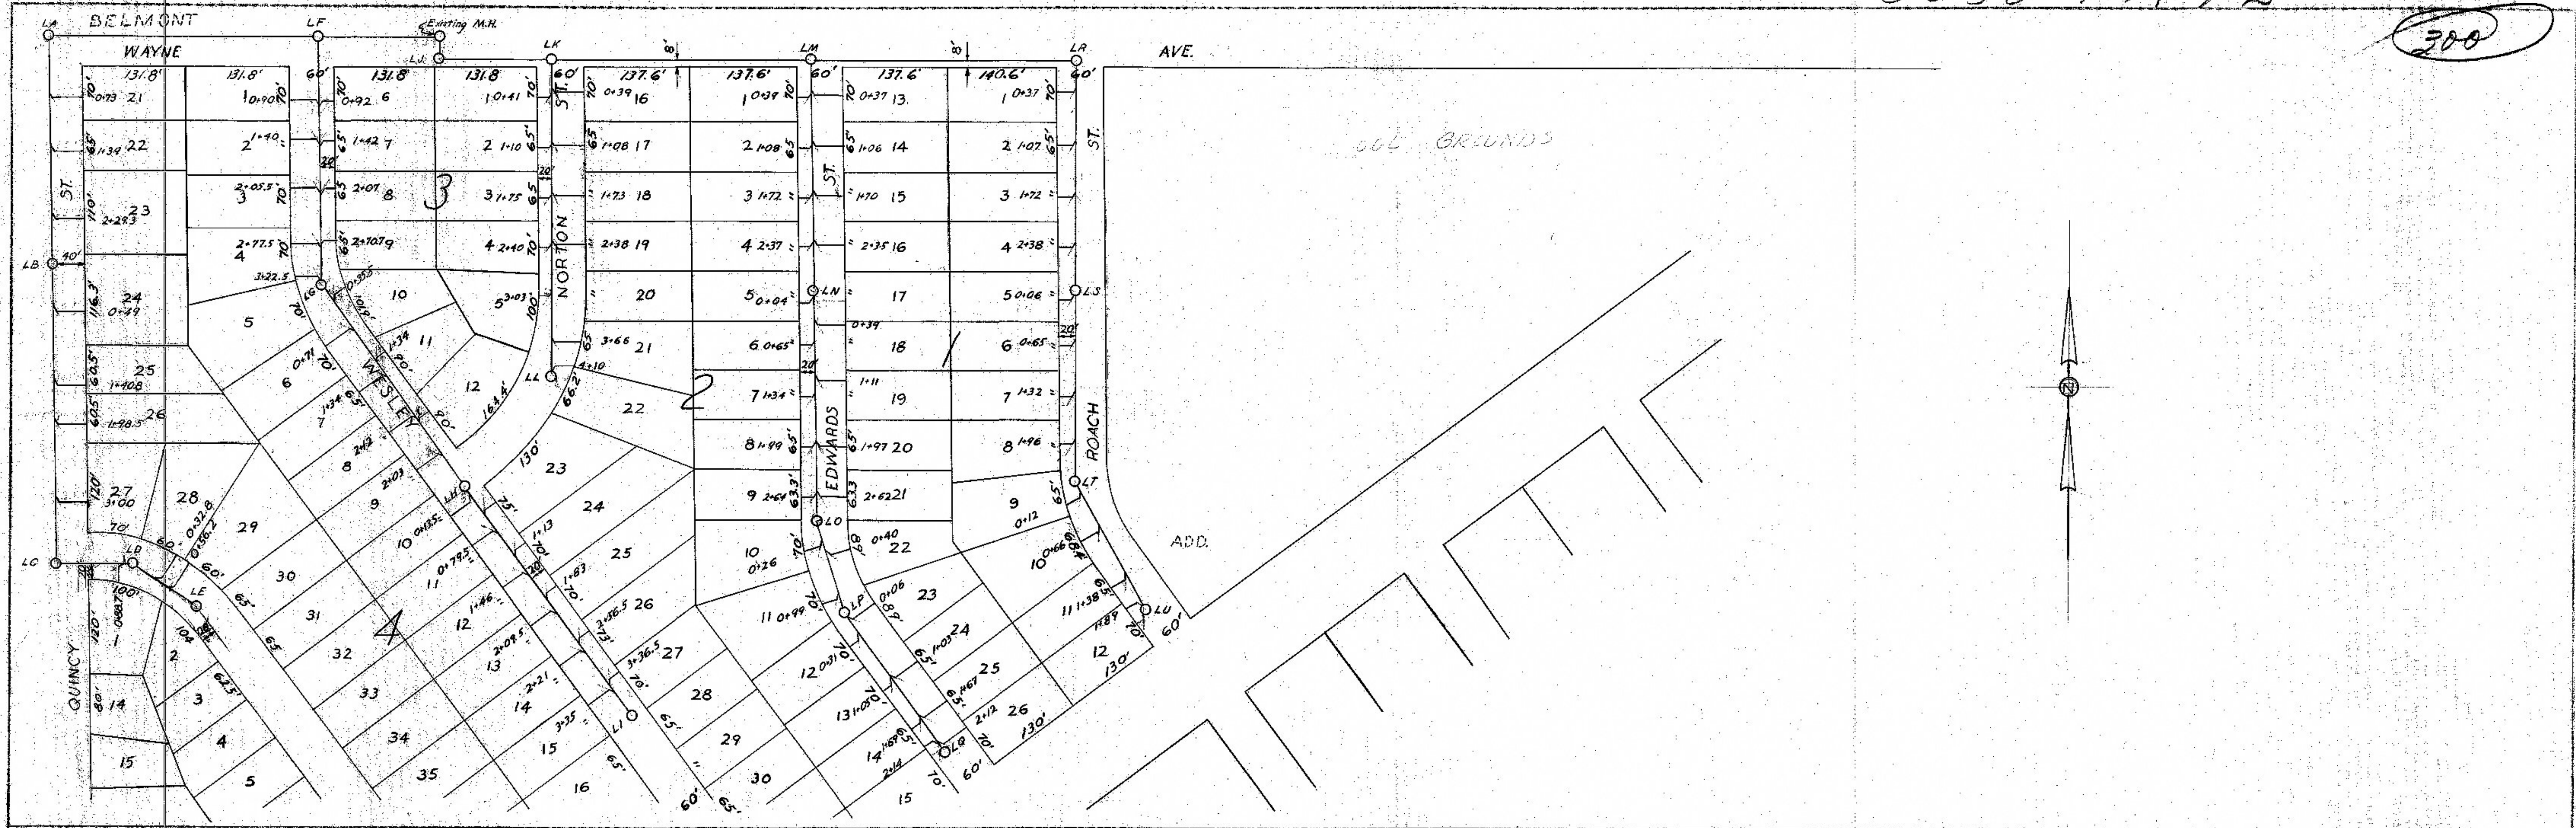