




302

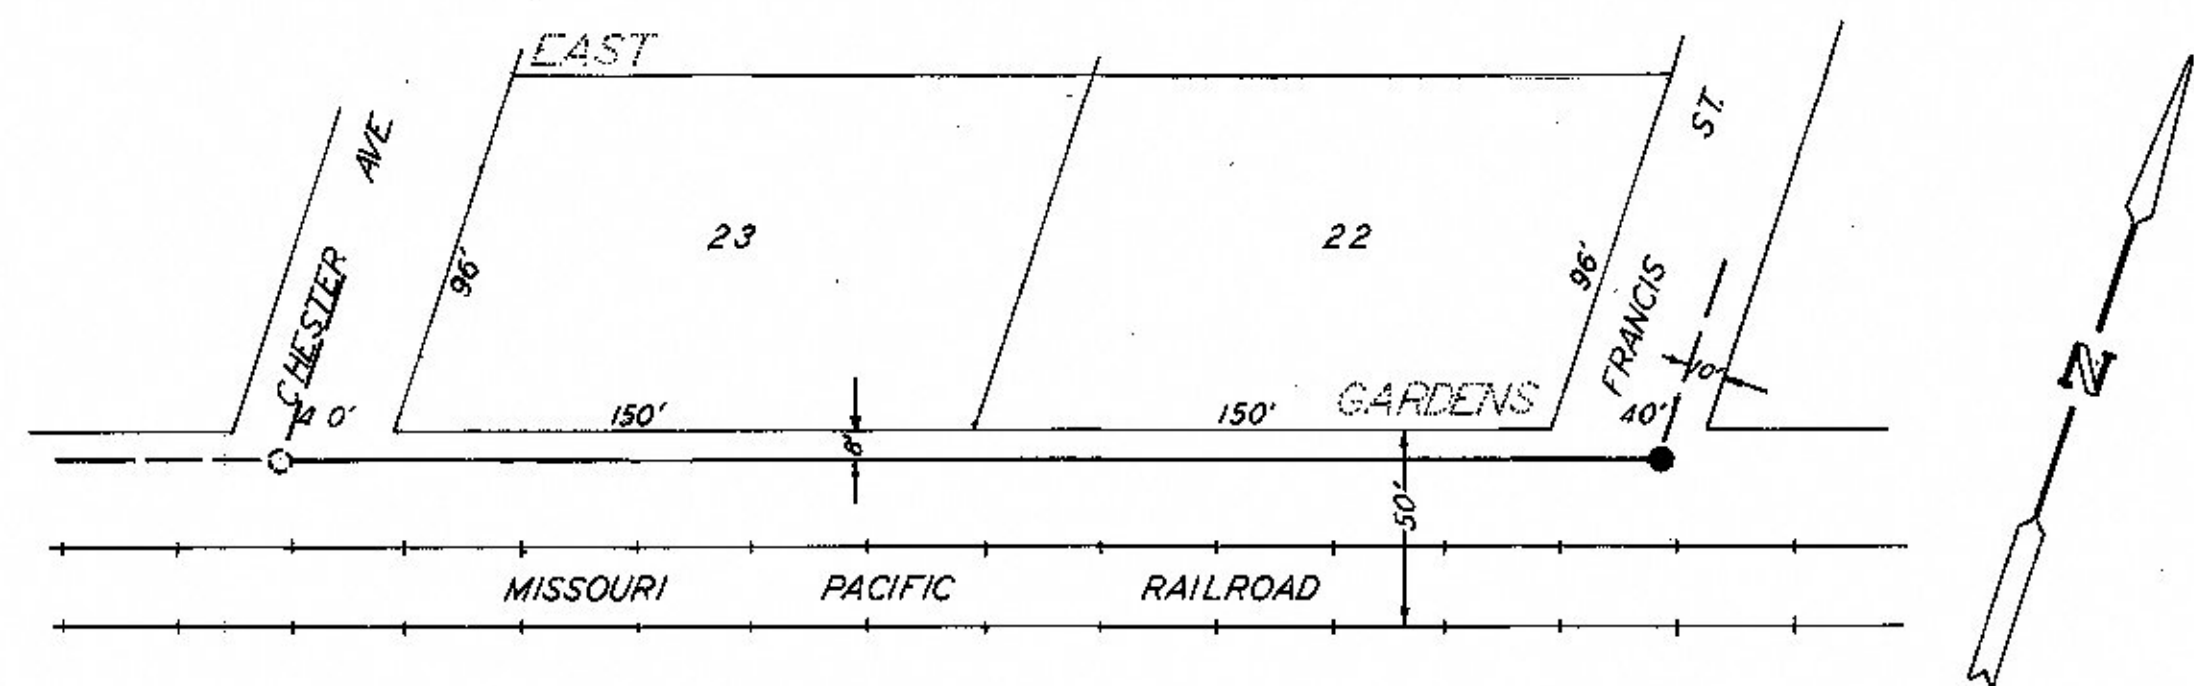


SANITARY SEWER-MO. PAC. R.W.-CHESTER TO FRANCIS

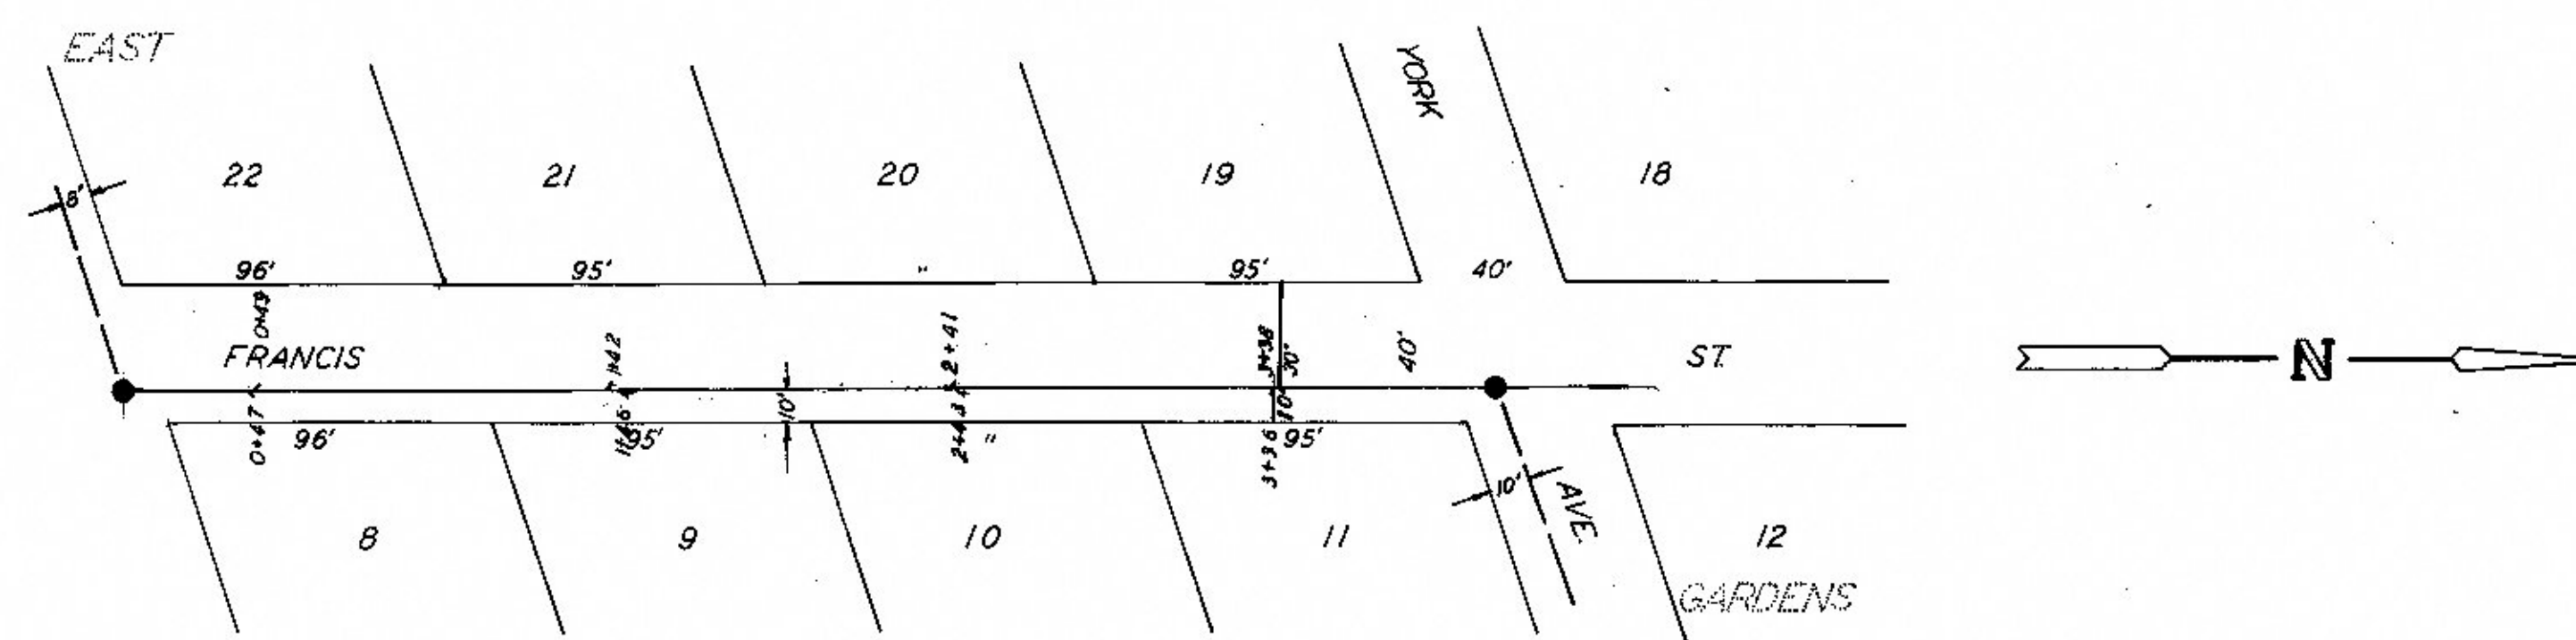


SANITARY SEWER-FRANCIS-MO. PAC. R.W. TO YORK

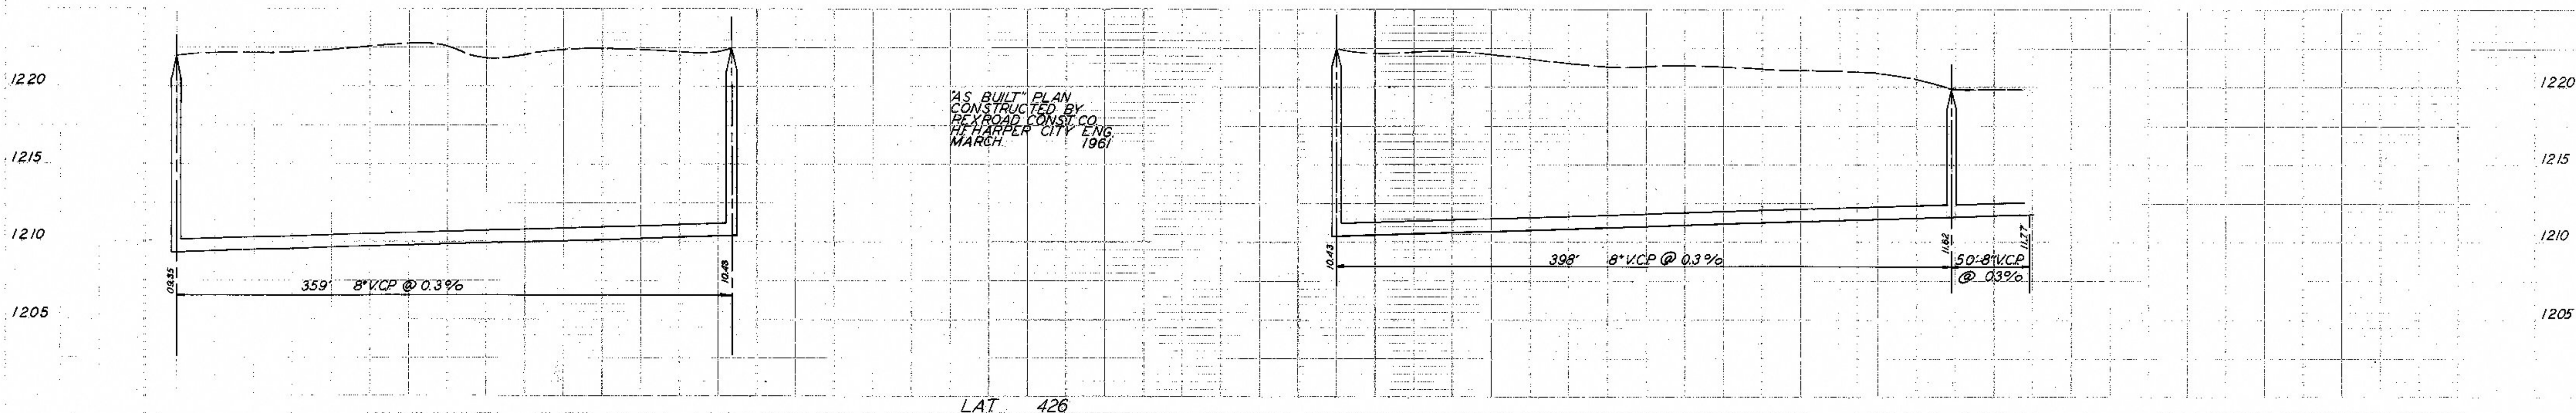

LAT. 426

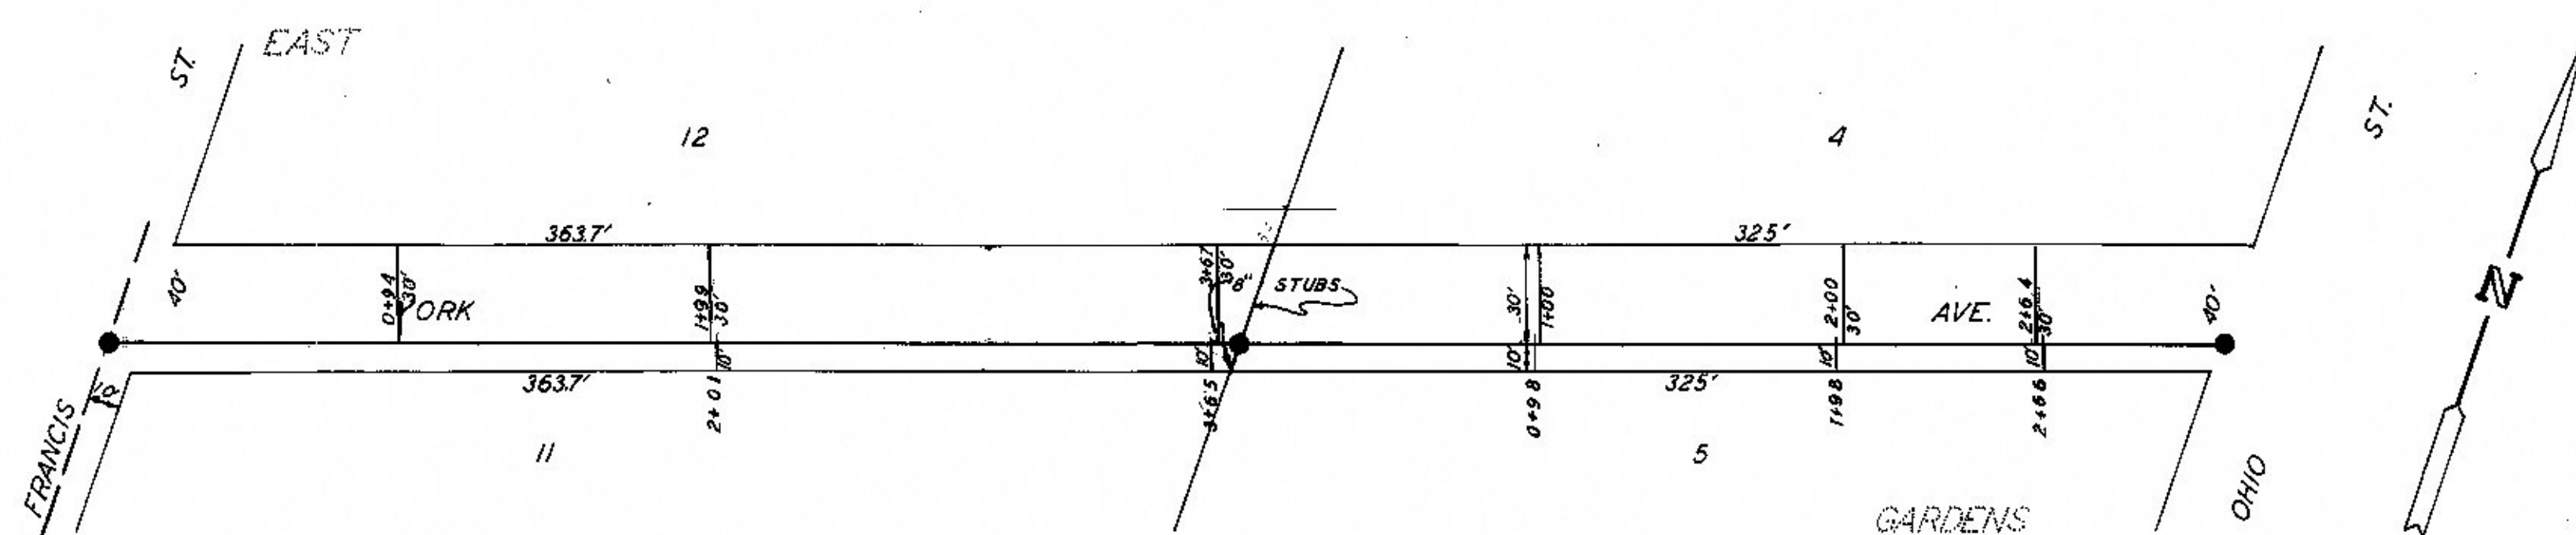

SANITARY SEWER-YORK-FRANCIS TO OHIO

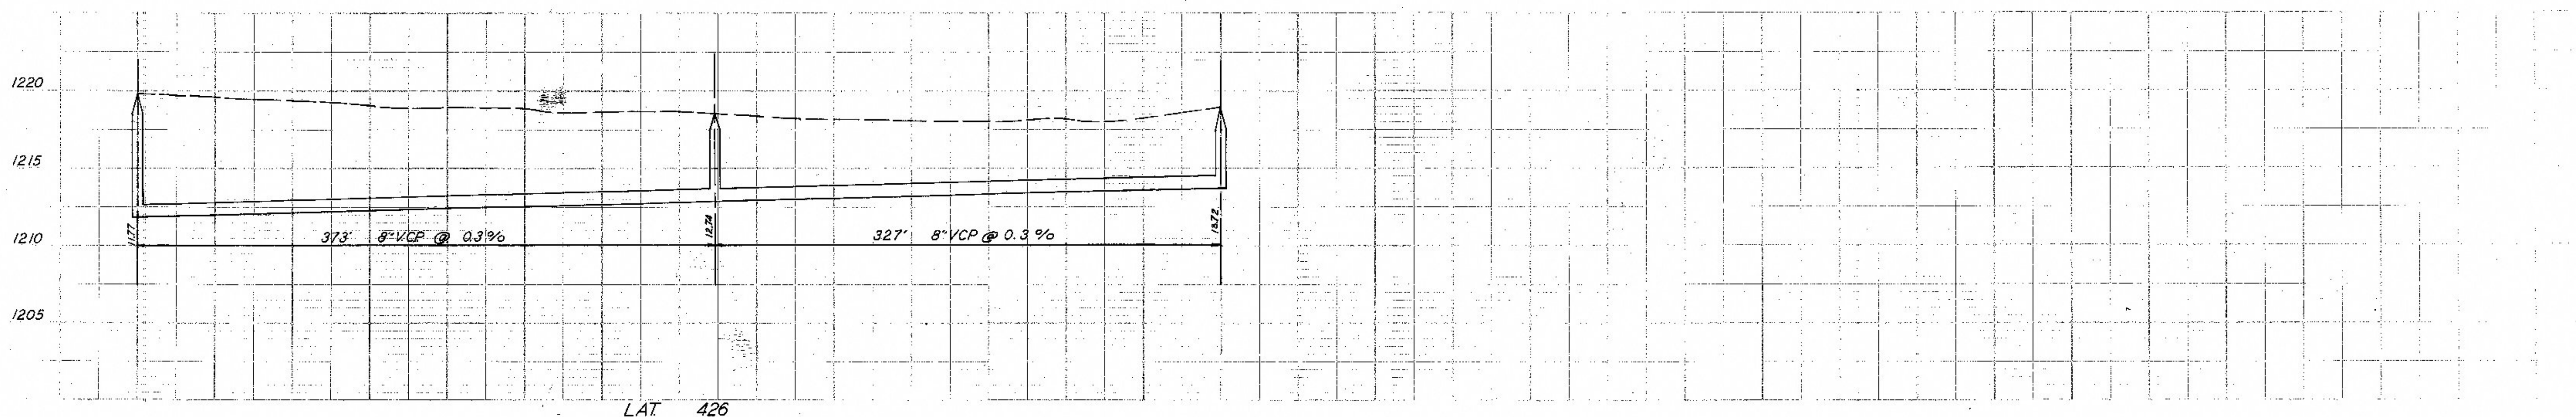

LAT. 426