



GG-62 P-14 FR


304

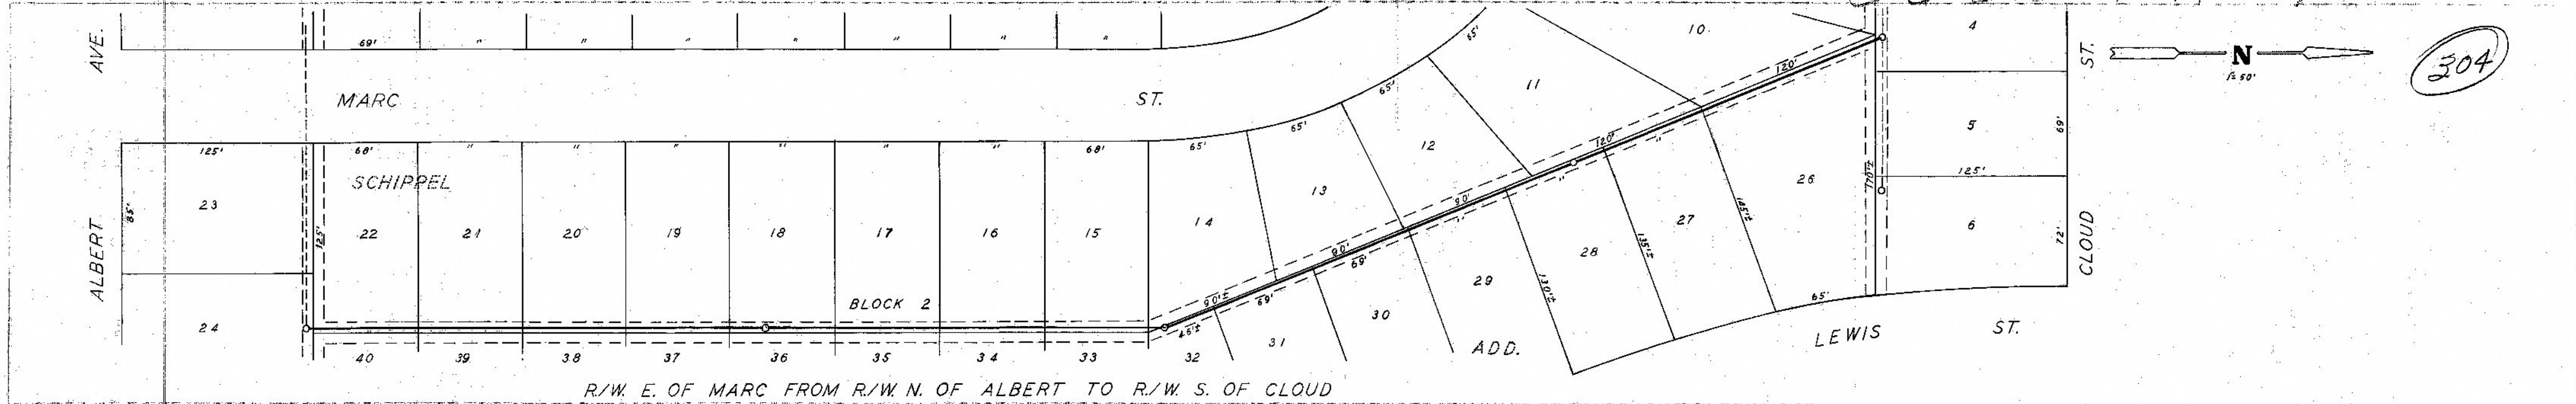


R/W E. OF MARC FROM R/W N. OF ALBERT TO R/W S. OF CLOUD

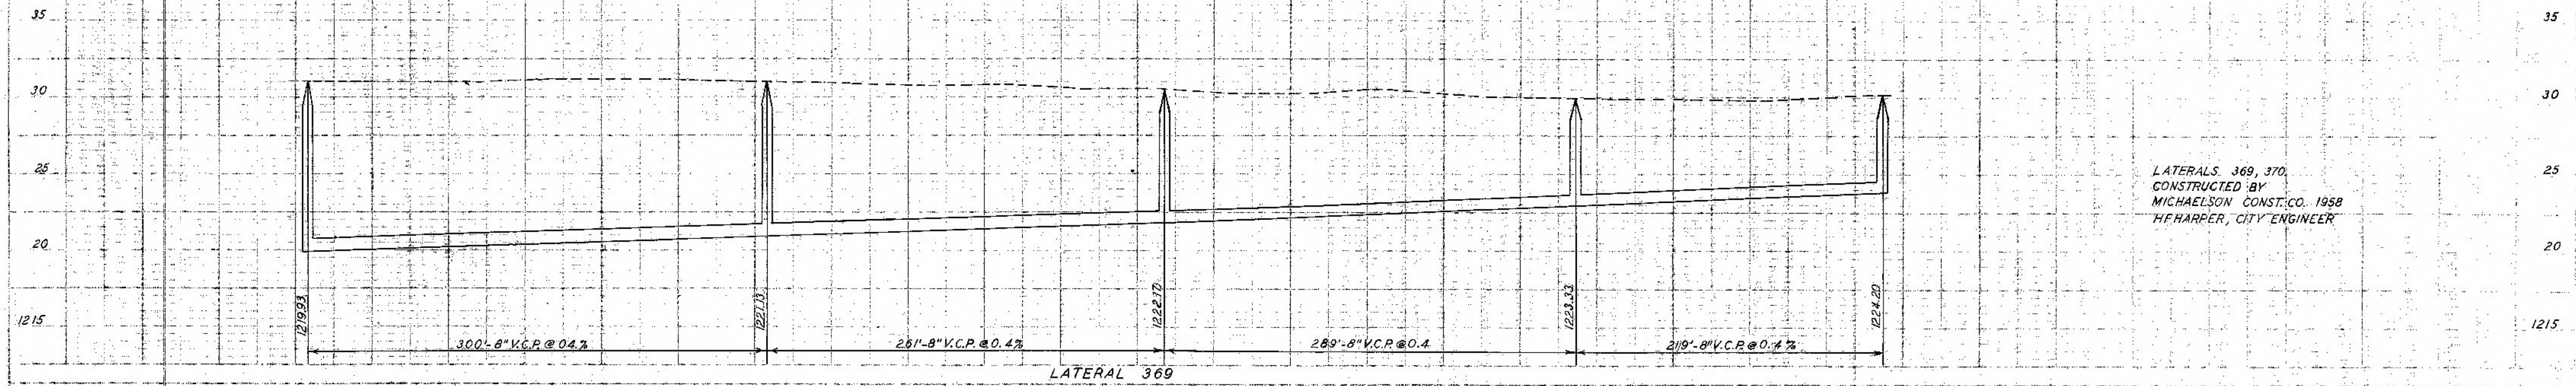


LATERALS 369, 370,
CONSTRUCTED BY
MICHAELSON CONST. CO. 1958
H. HARPER, CITY ENGINEER

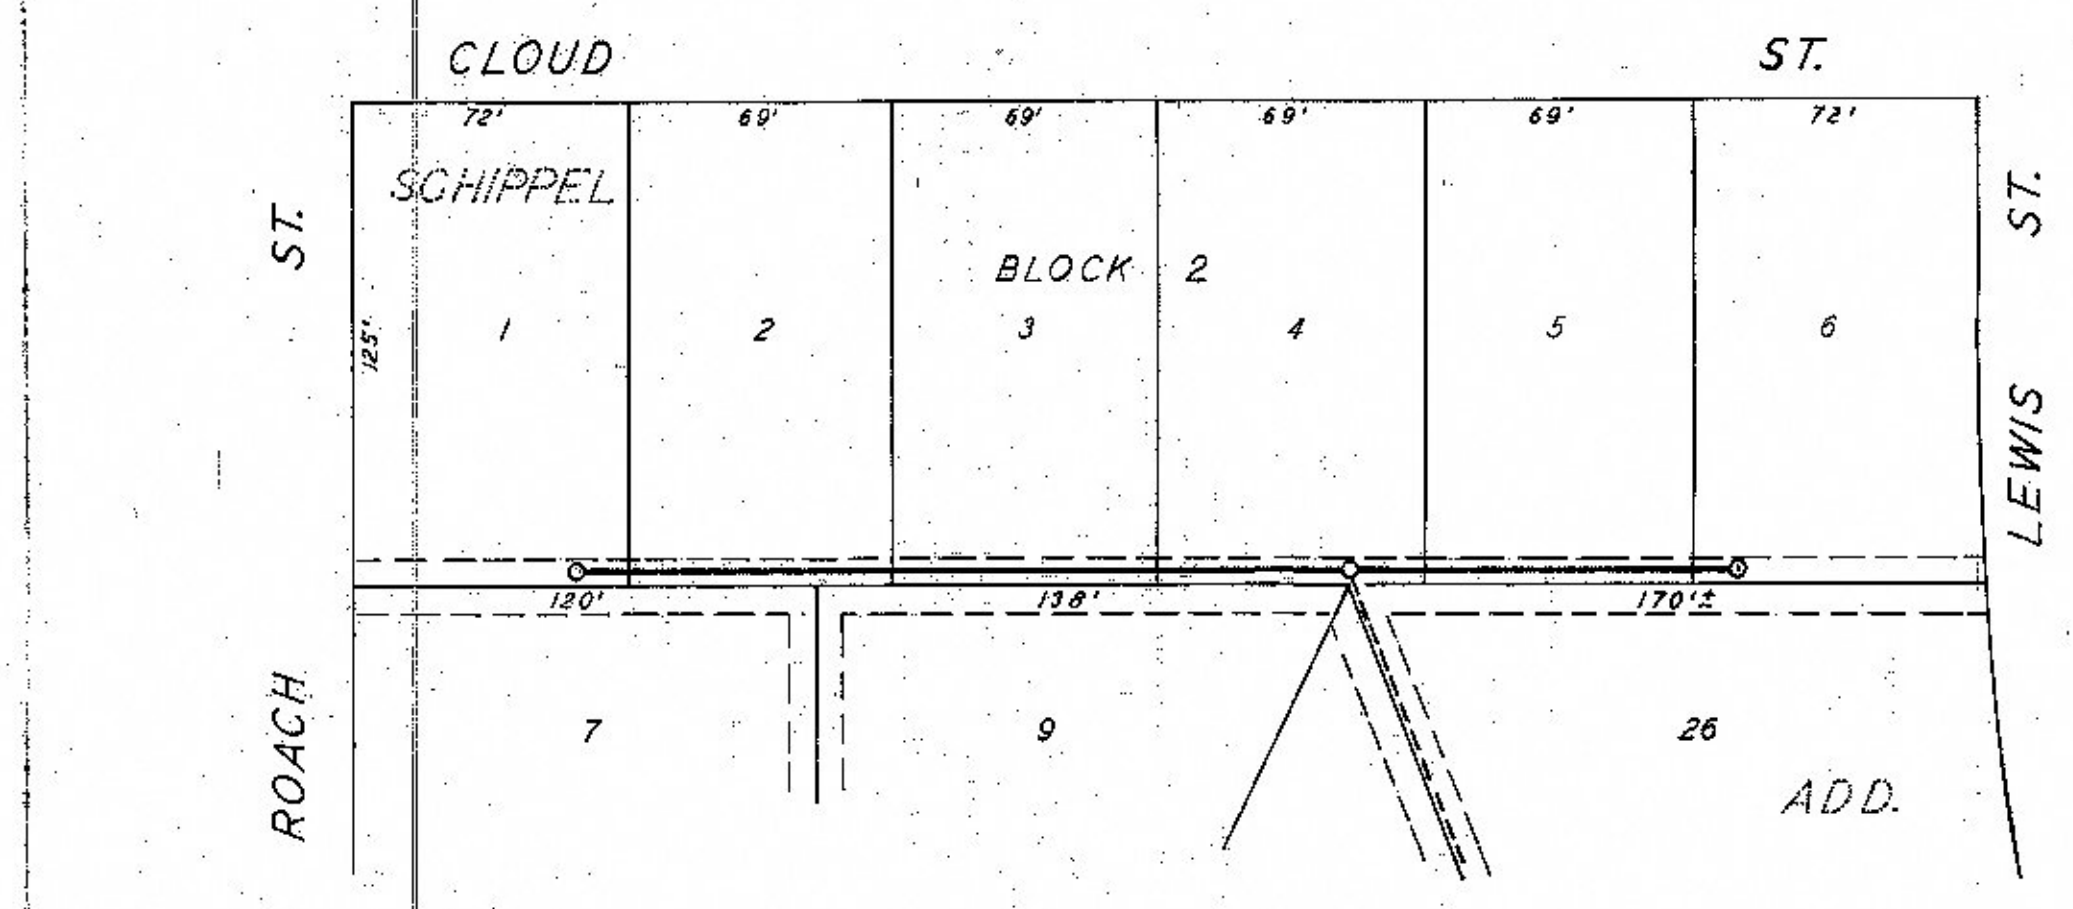


R/W S. OF CLOUD FROM LOT 1 TO LOT 4, LOT 6 TO LOT 4

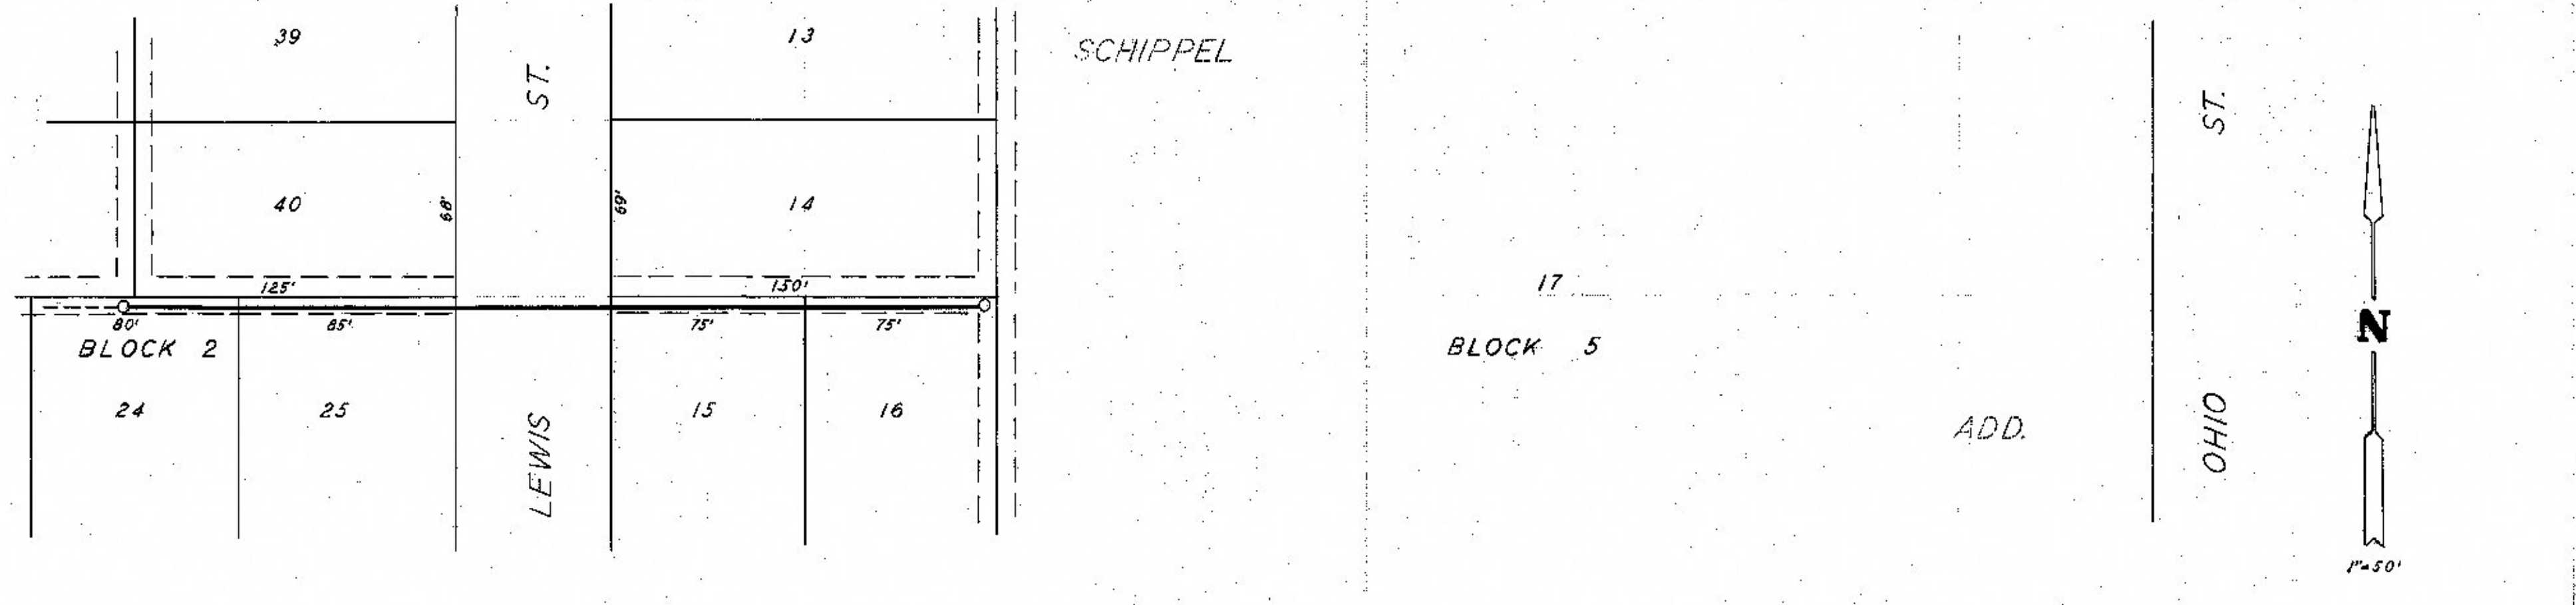

R/W N. OF ALBERT FROM R/W E. OF MARC TO R/W E. OF LEWIS

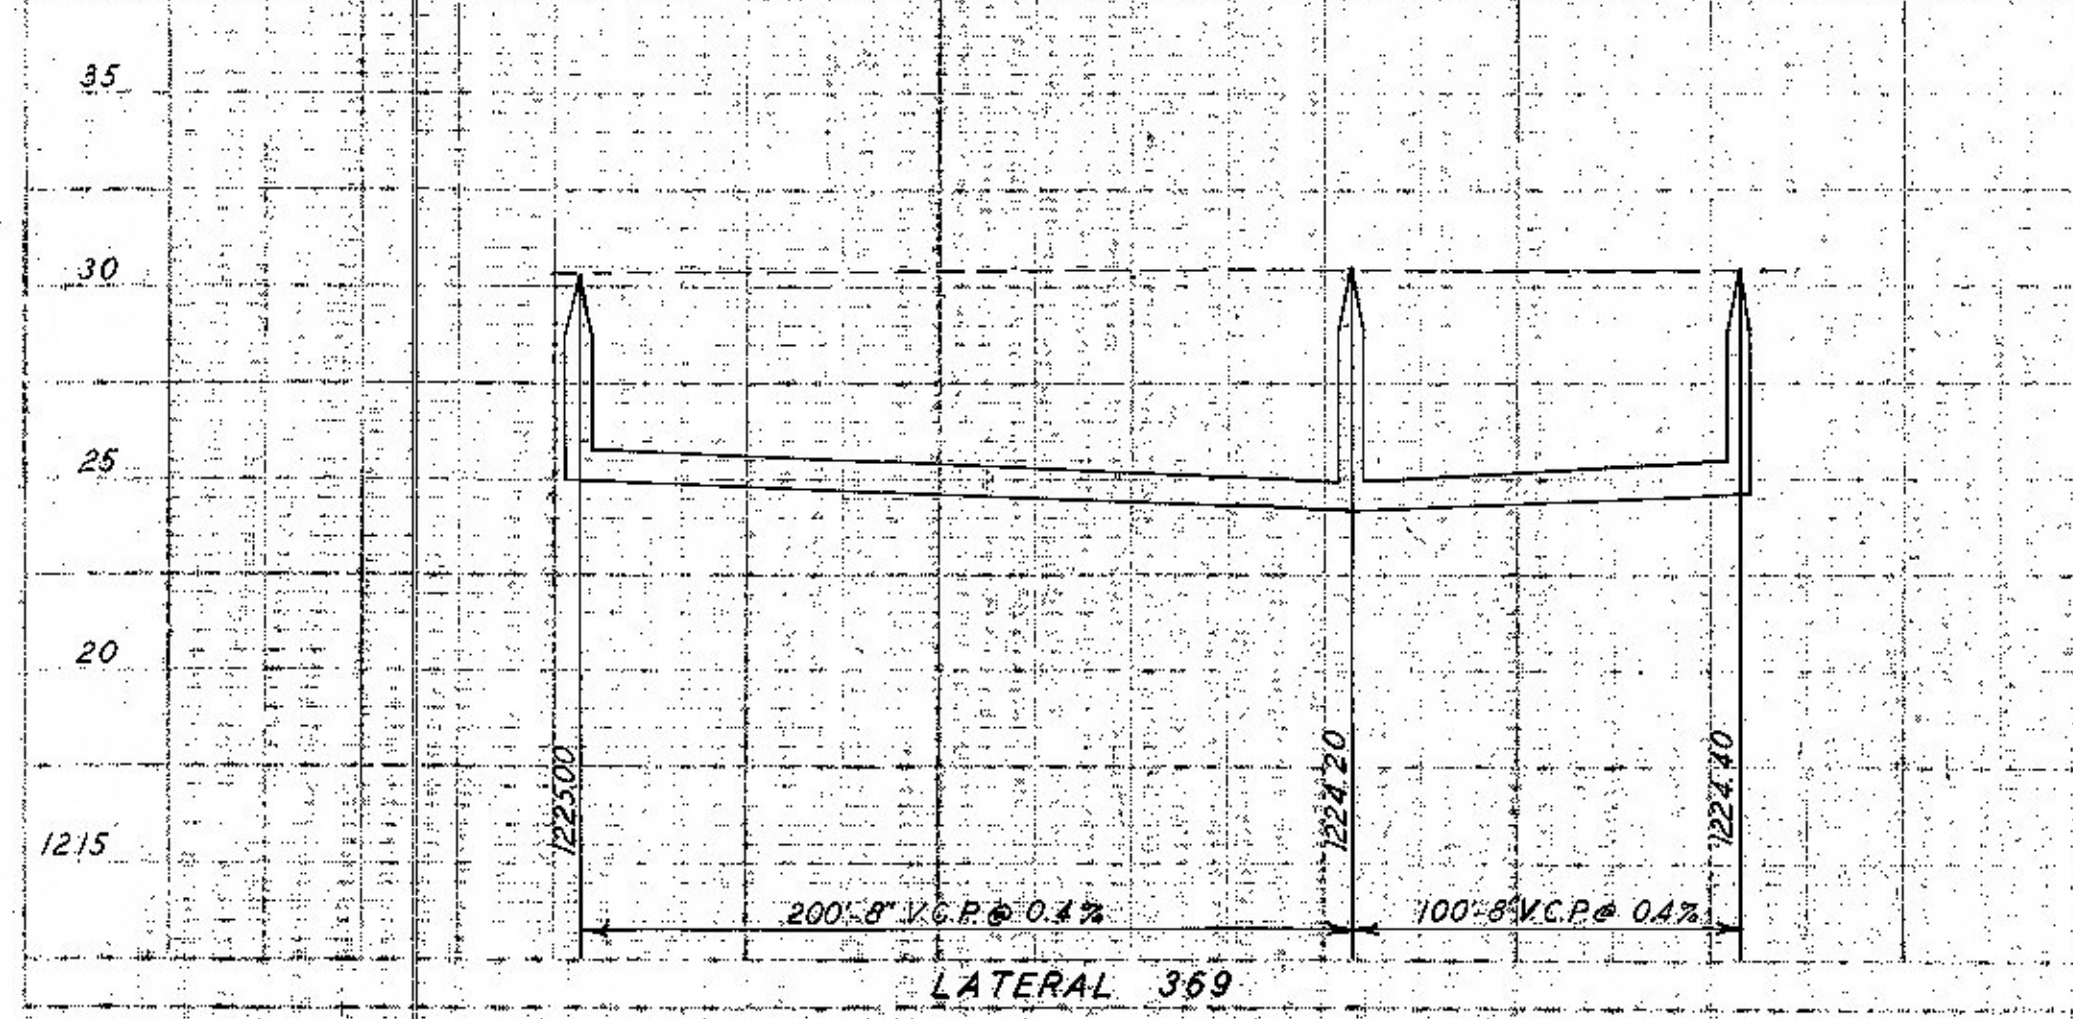

LATERAL 369

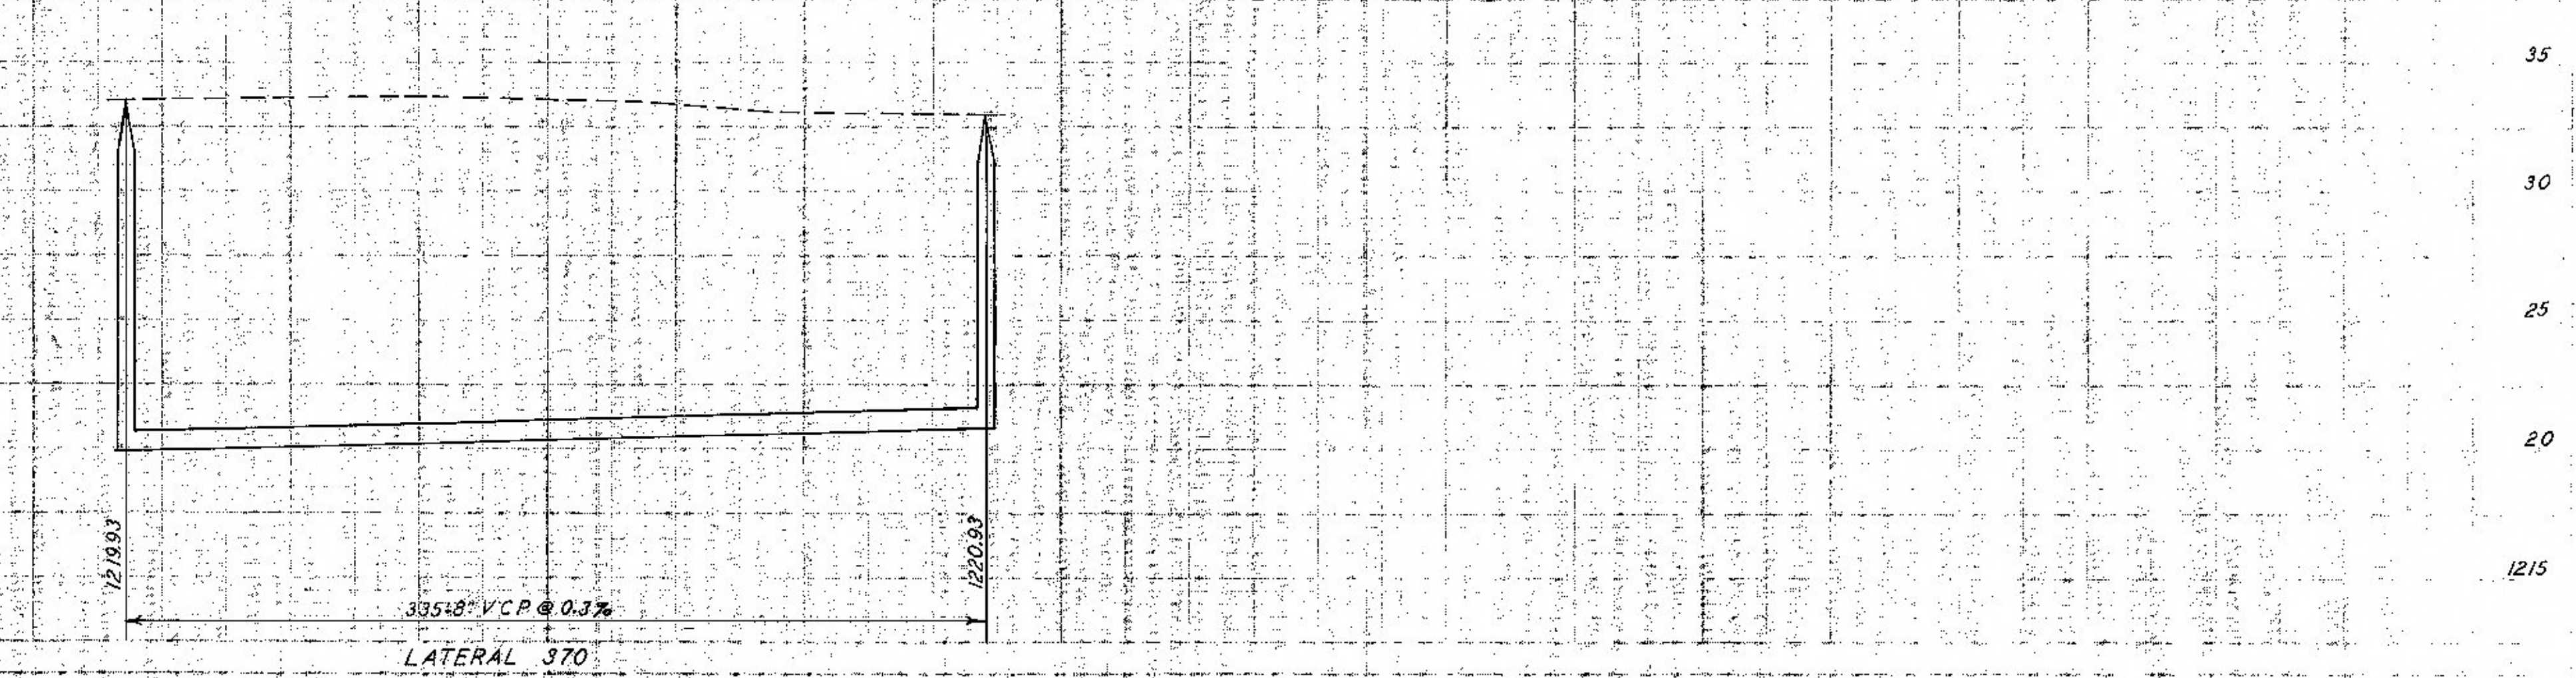

LATERAL 370