
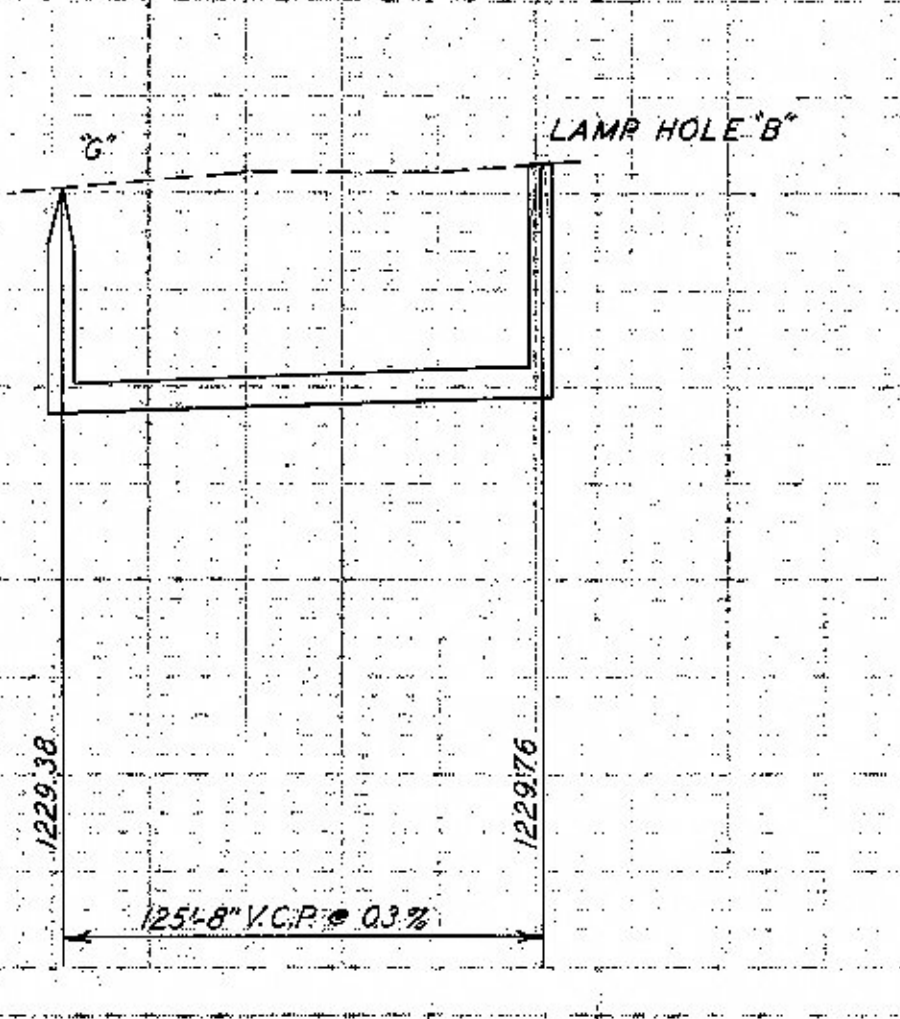
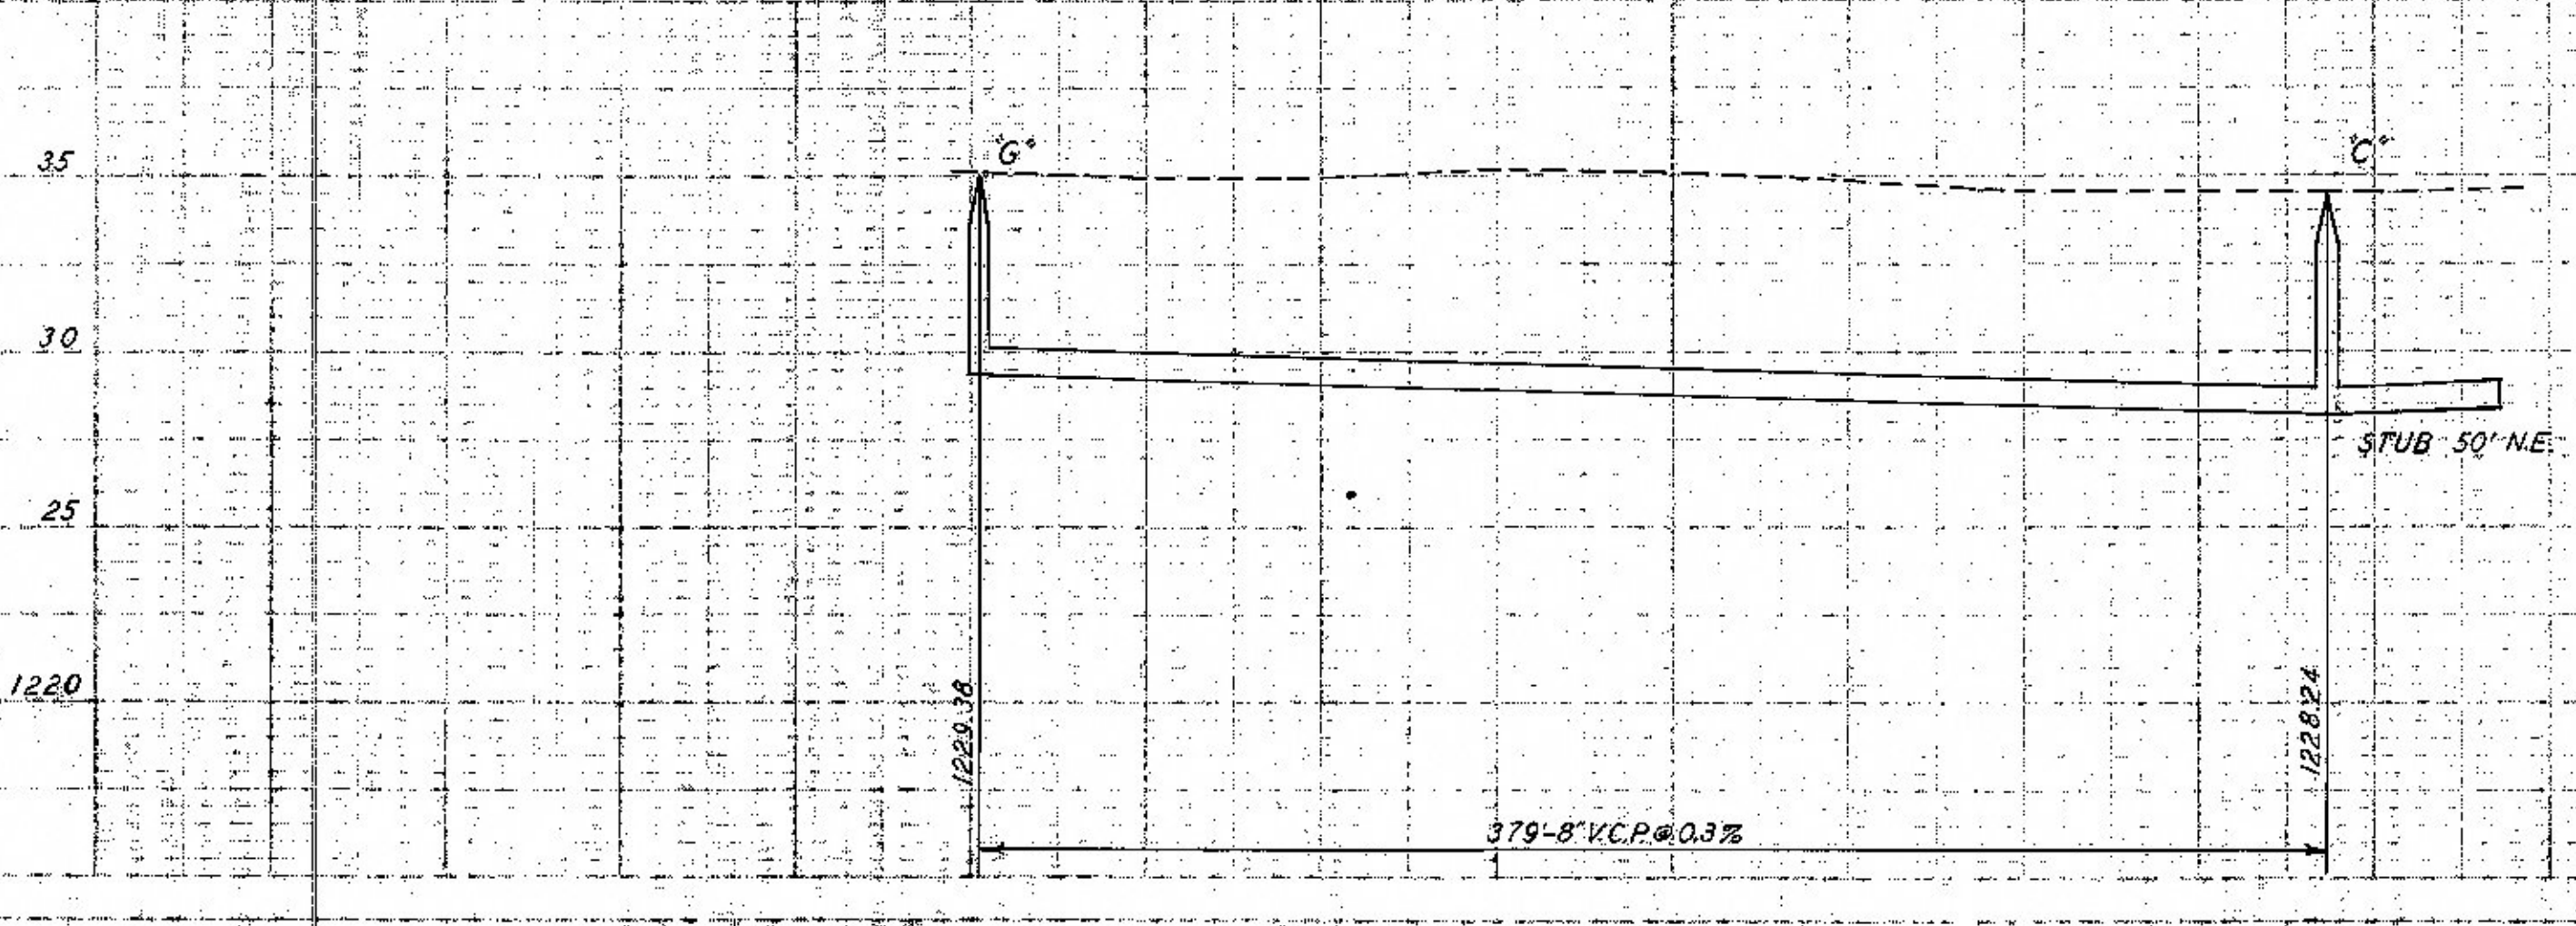
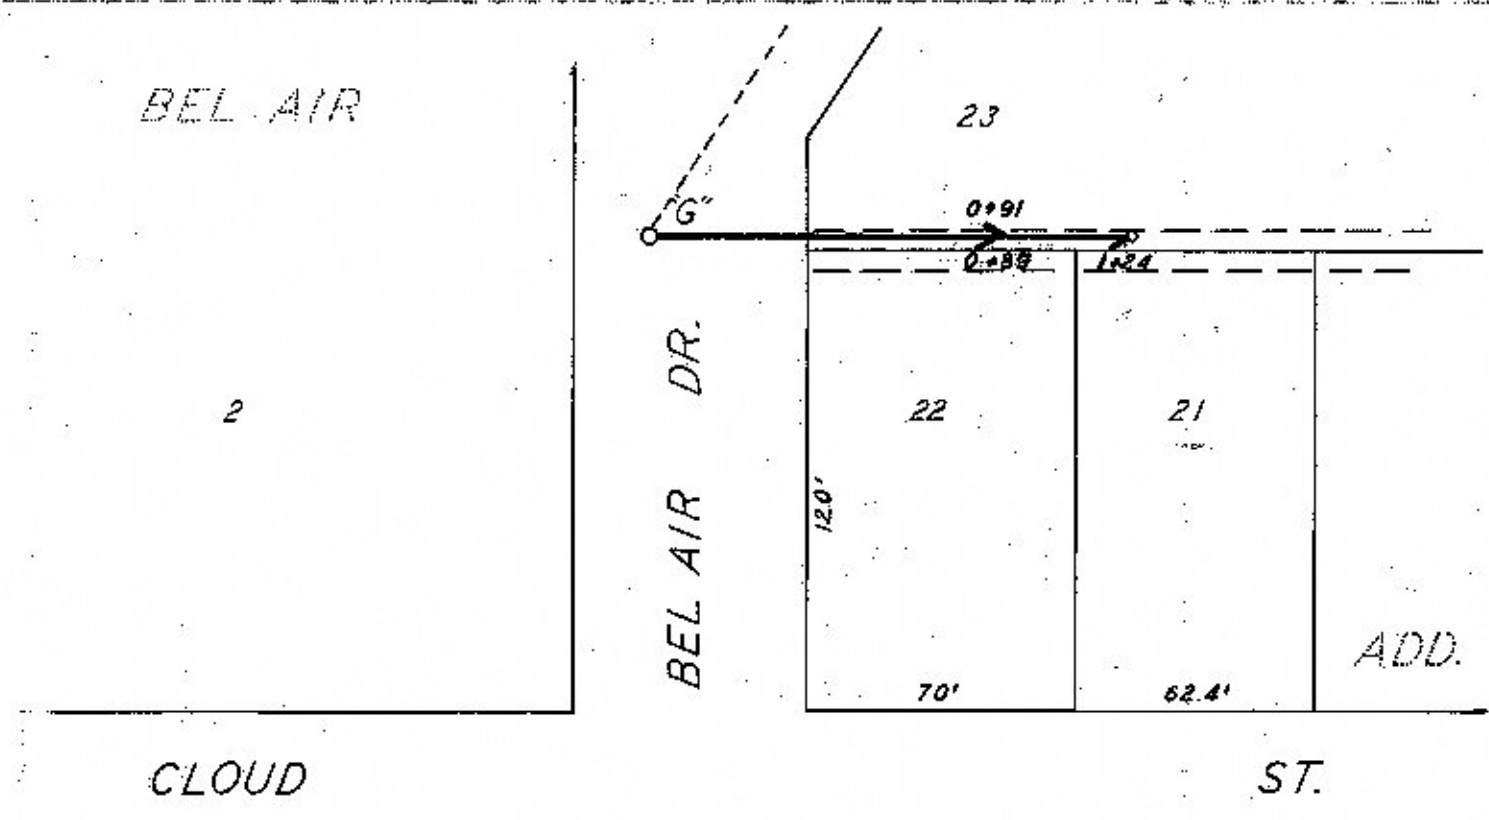


LATERAL 397

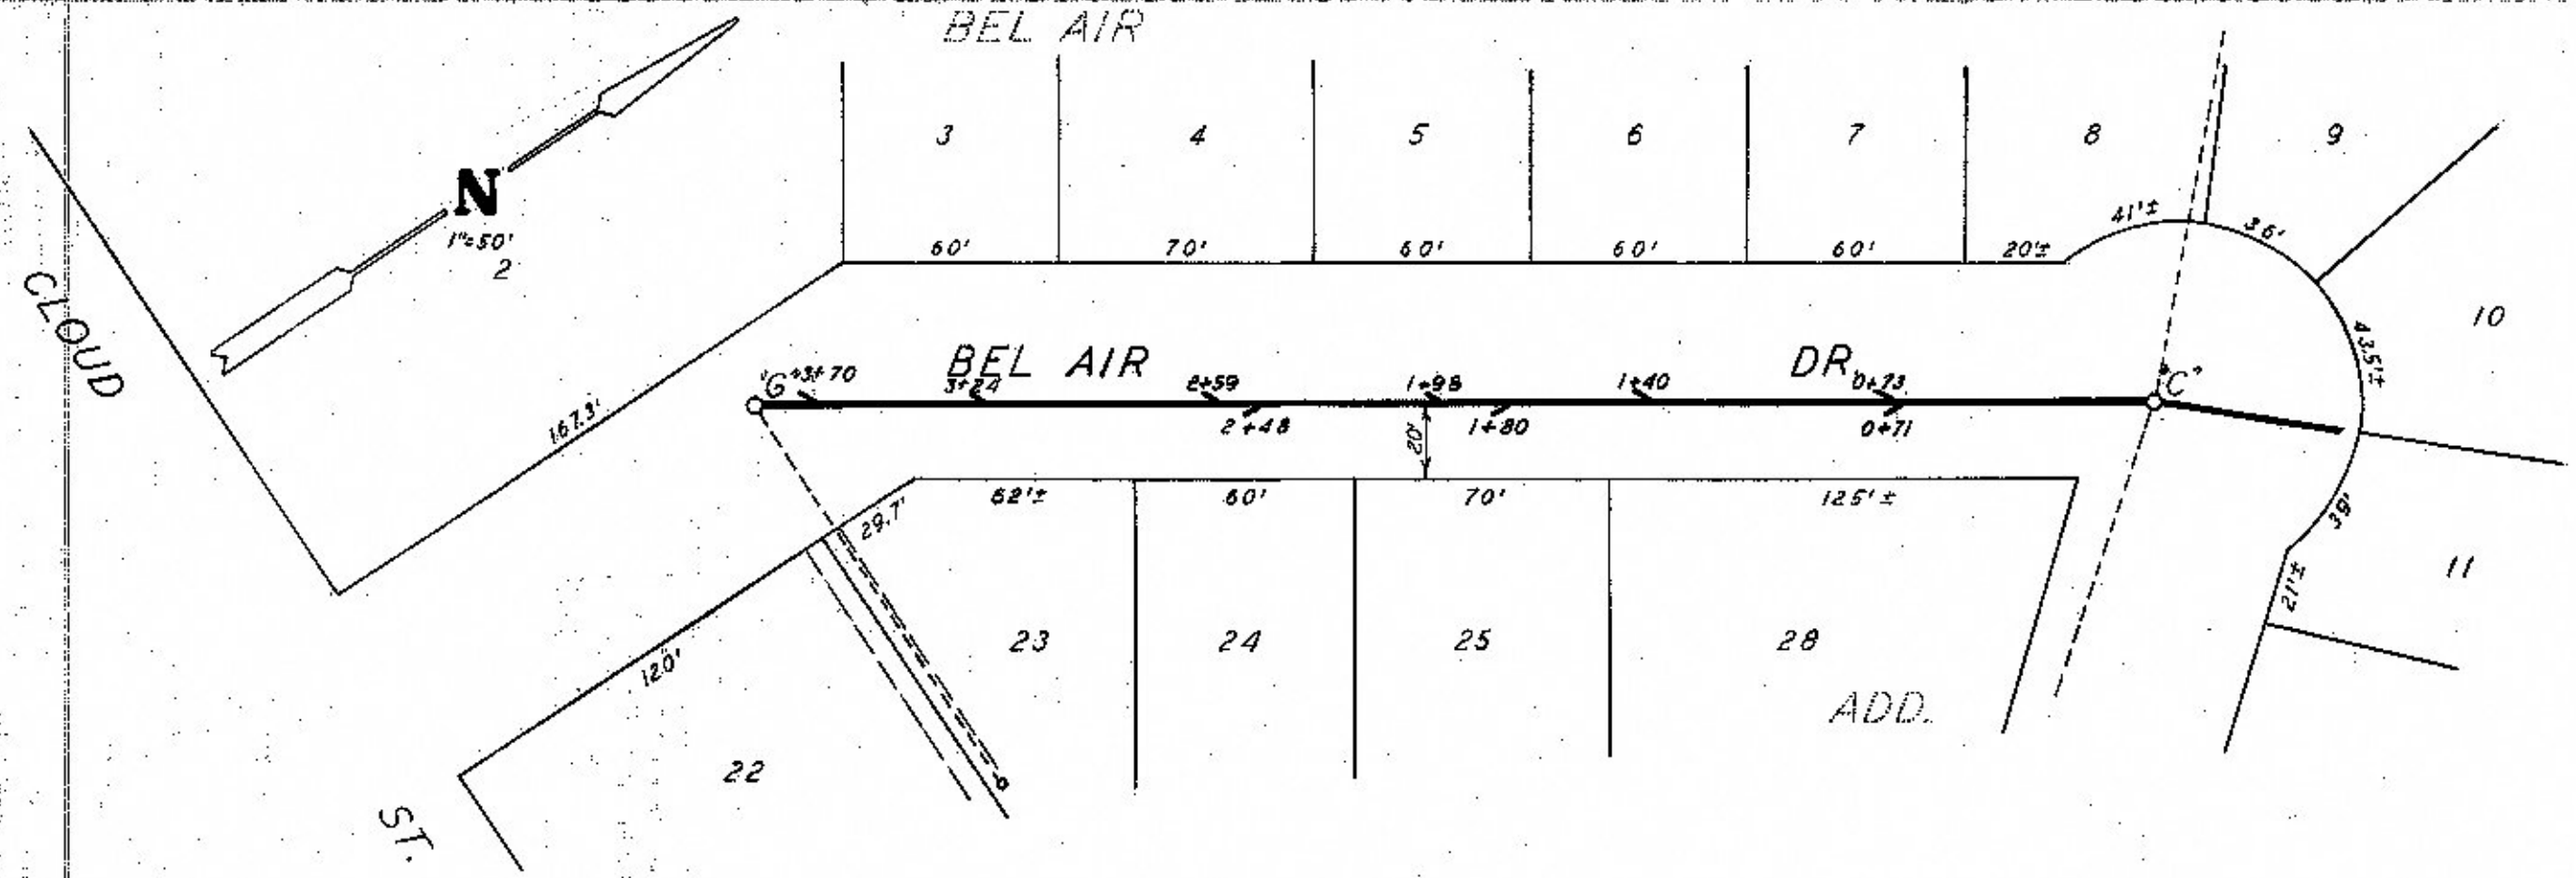

LATERAL 397