
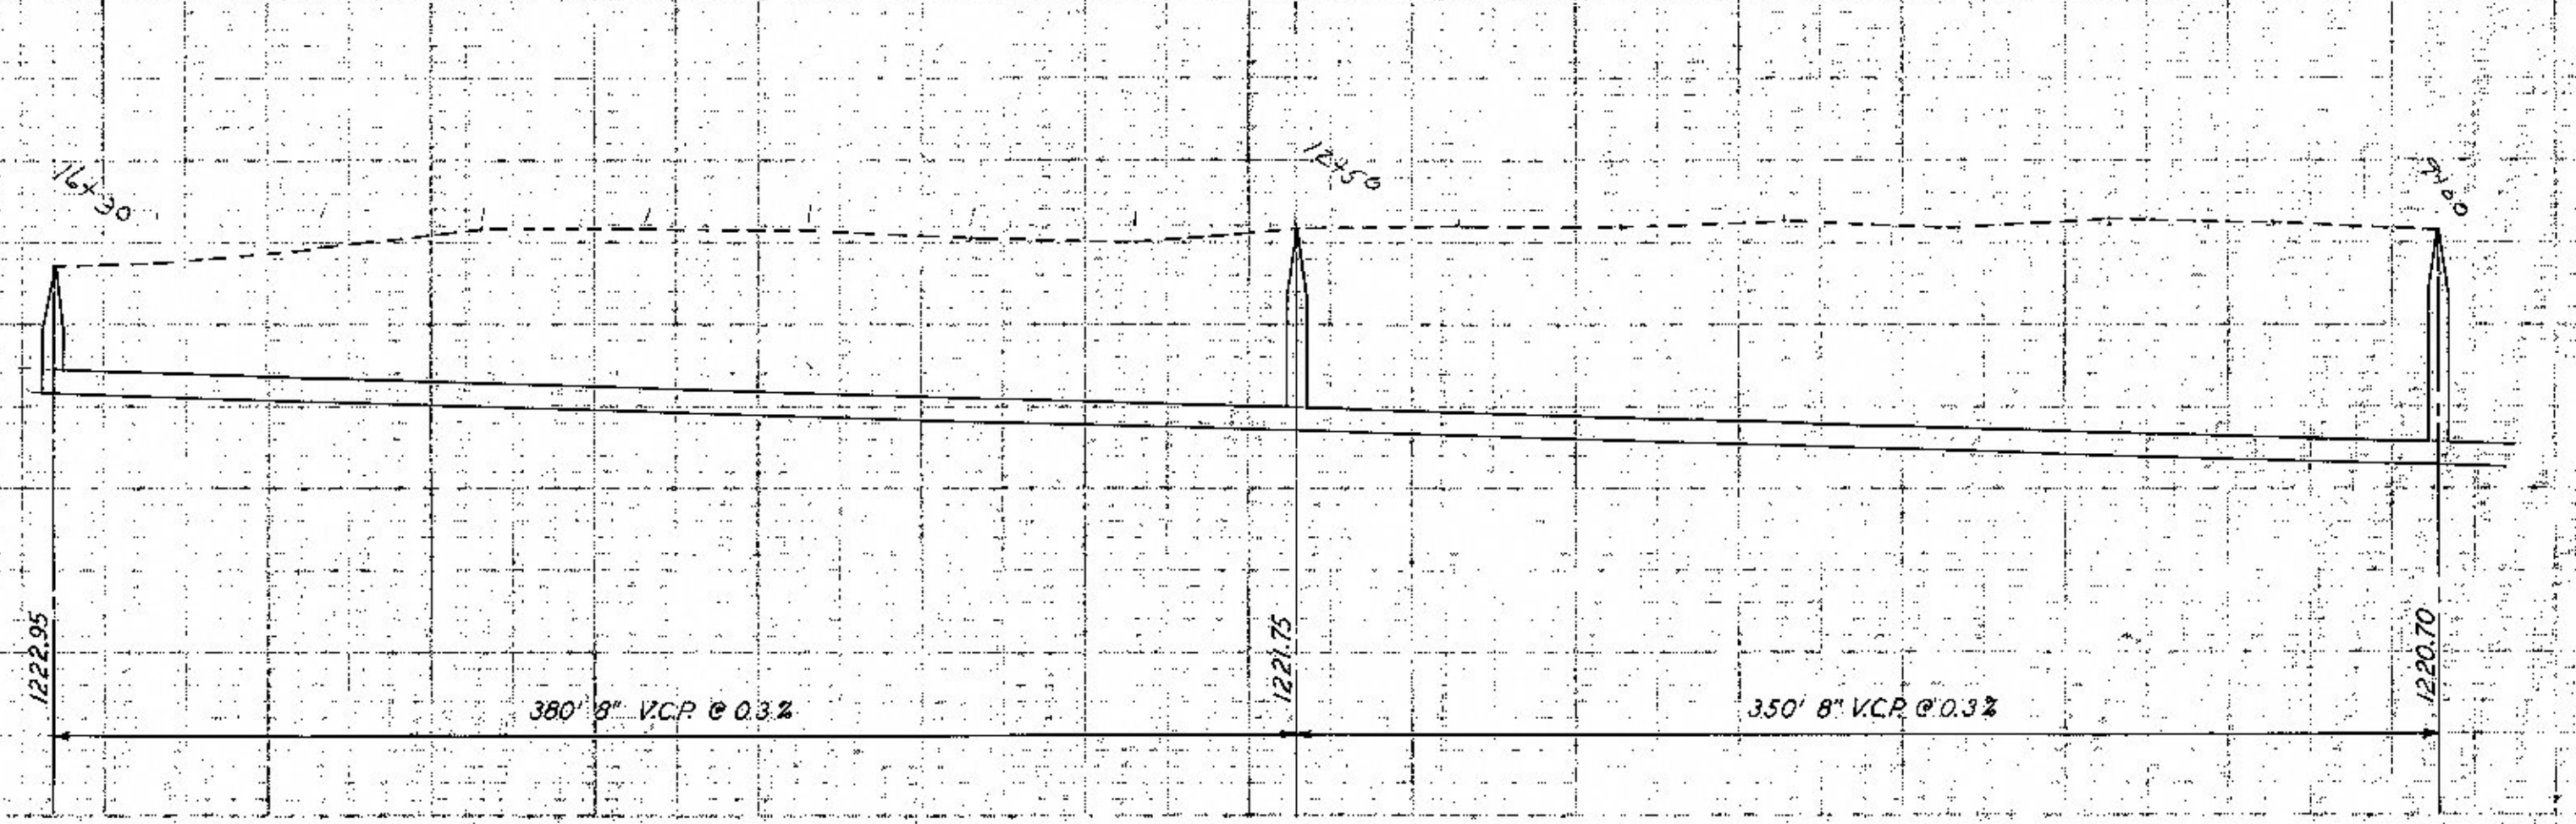


AS BUILT PLAN  
 CONST. BY L.W. REYROAD  
 DEC. 1939  
 H.F. HARRER CITY ENG.

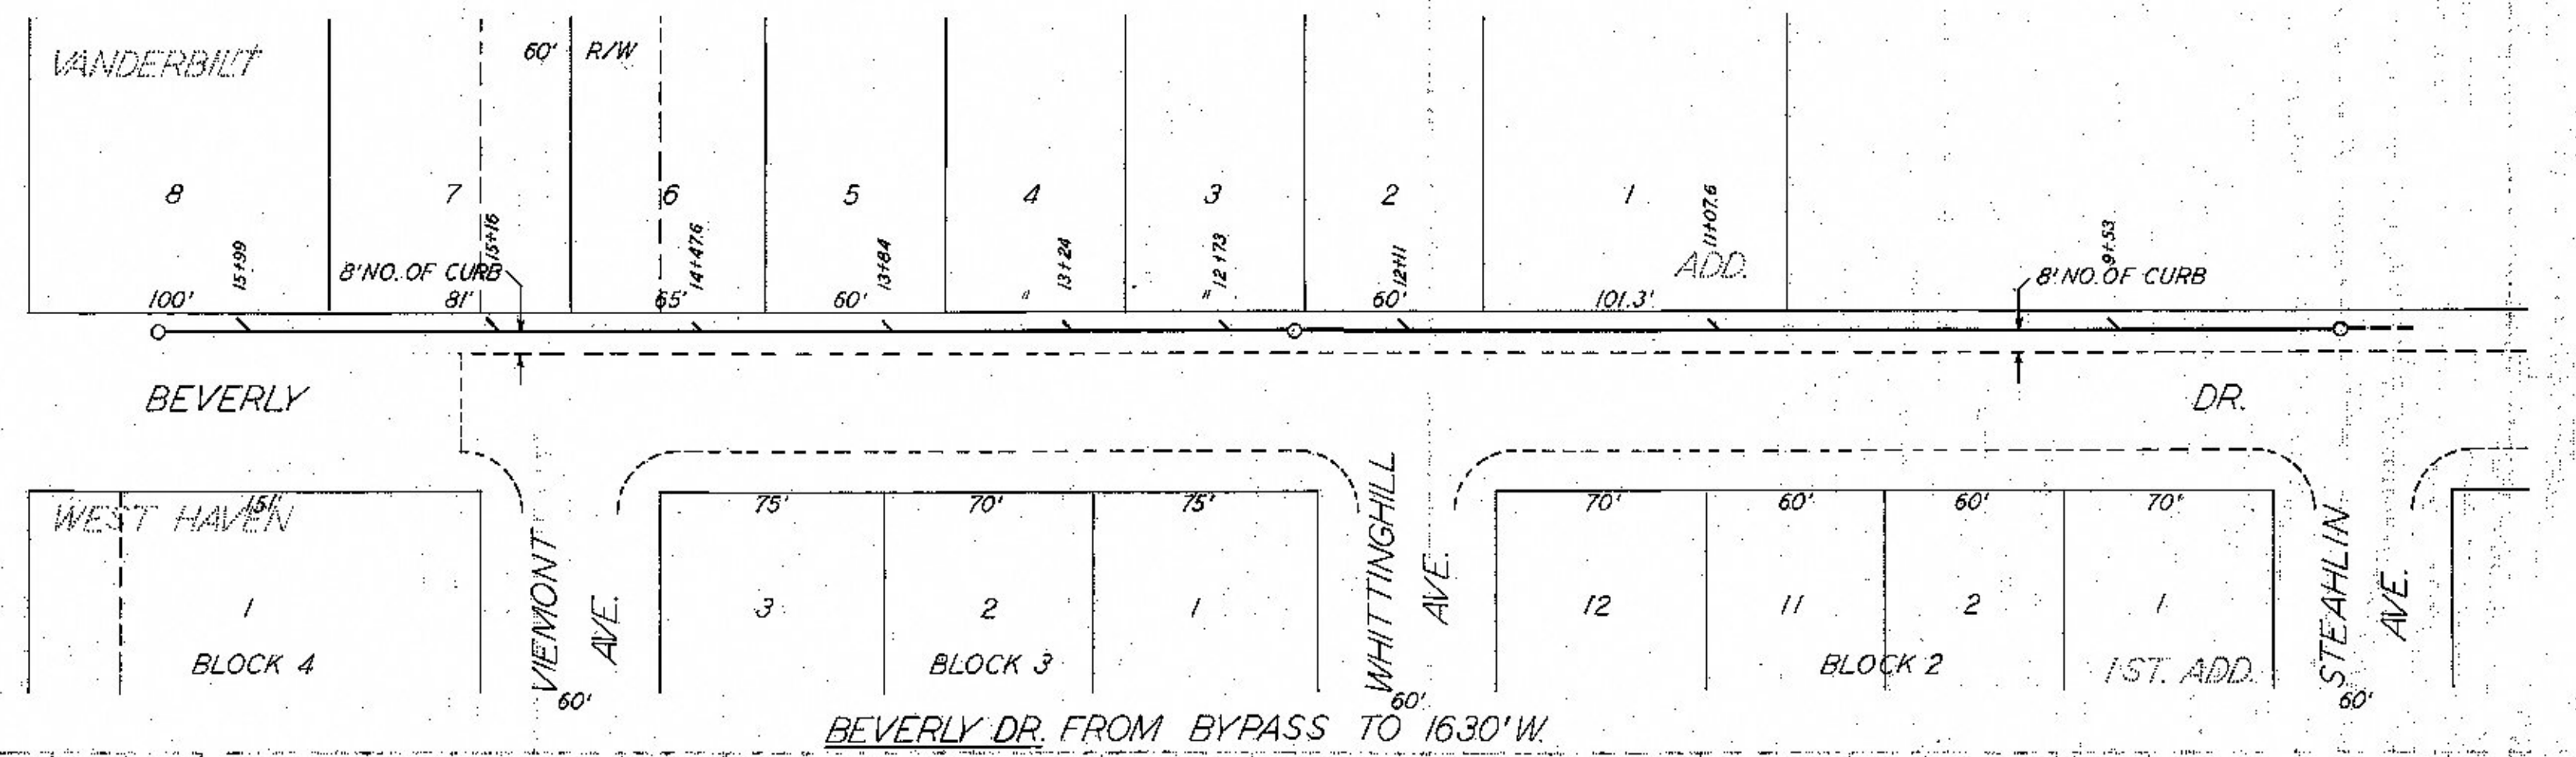

PLAN  
 DATE: 12/1/40  
 DRAWN BY: [illegible]  
 CHECKED BY: [illegible]

PROFILE  
 DATE: 12/1/40  
 DRAWN BY: [illegible]  
 CHECKED BY: [illegible]