

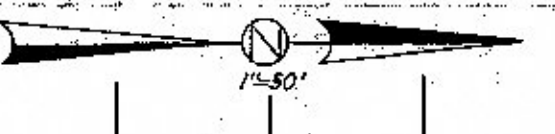
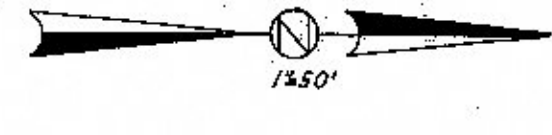
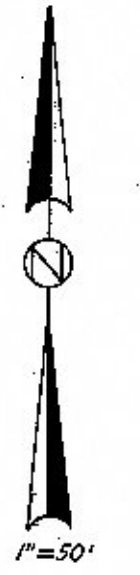
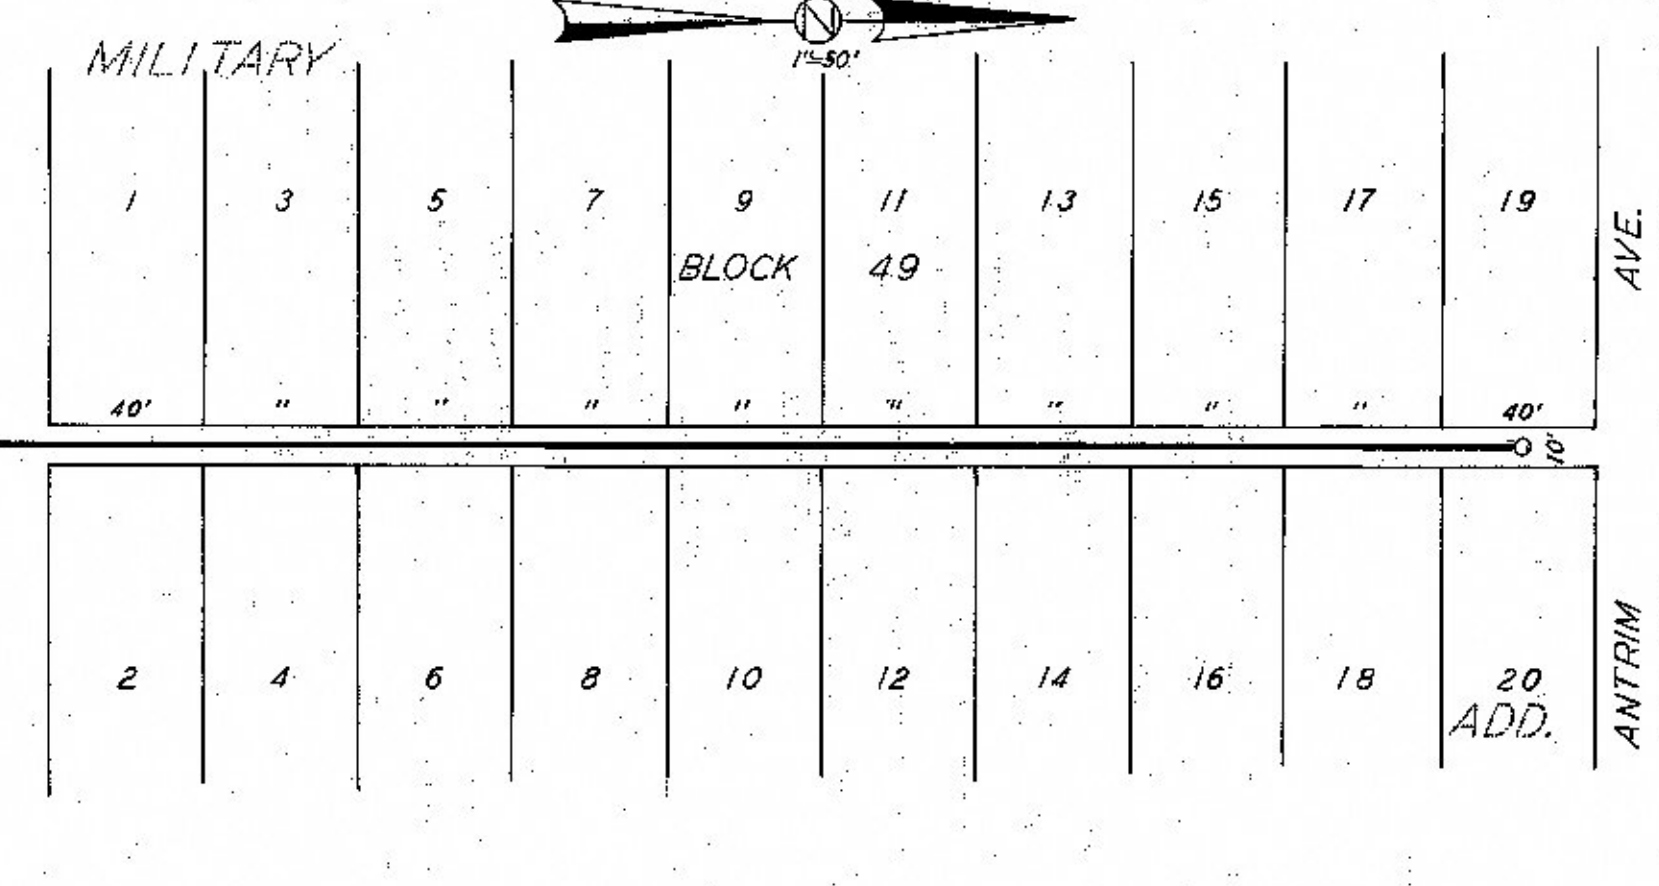
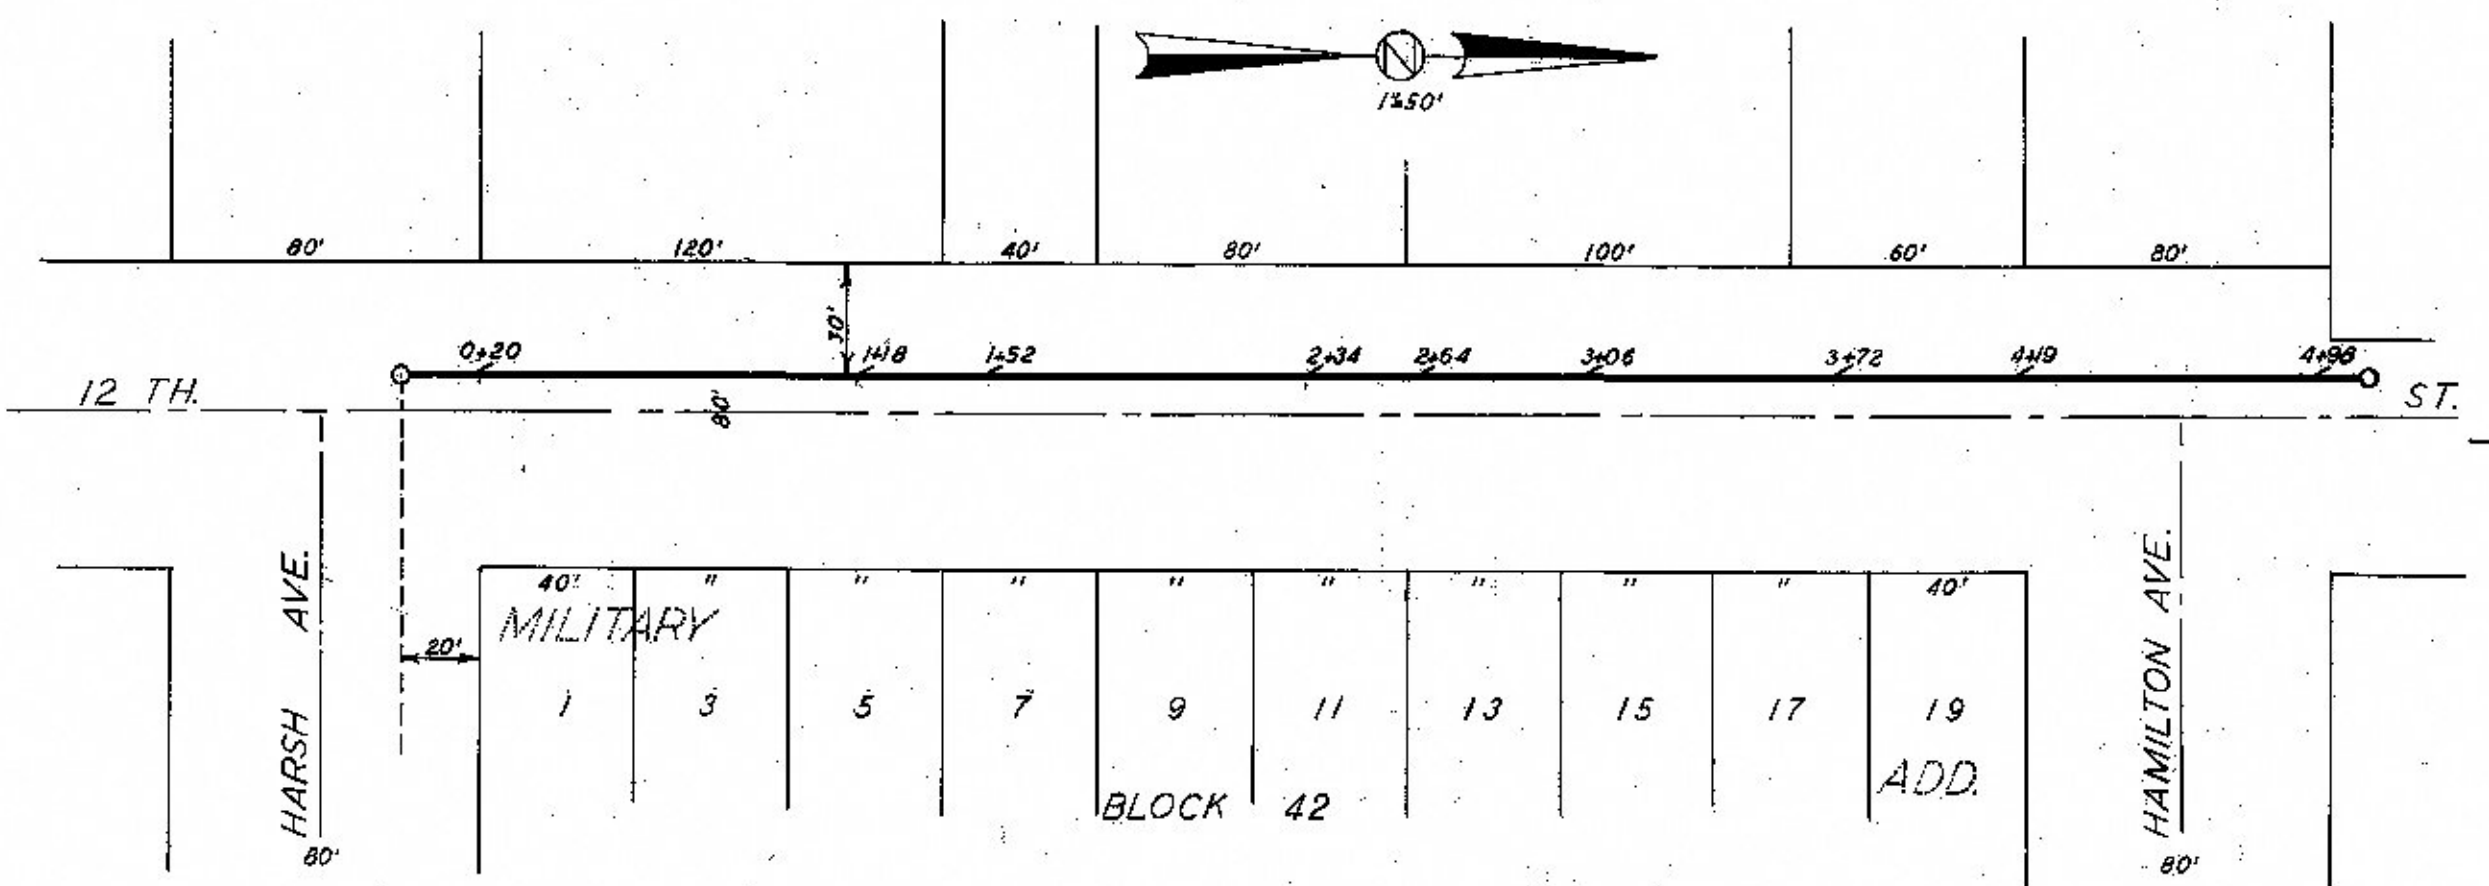
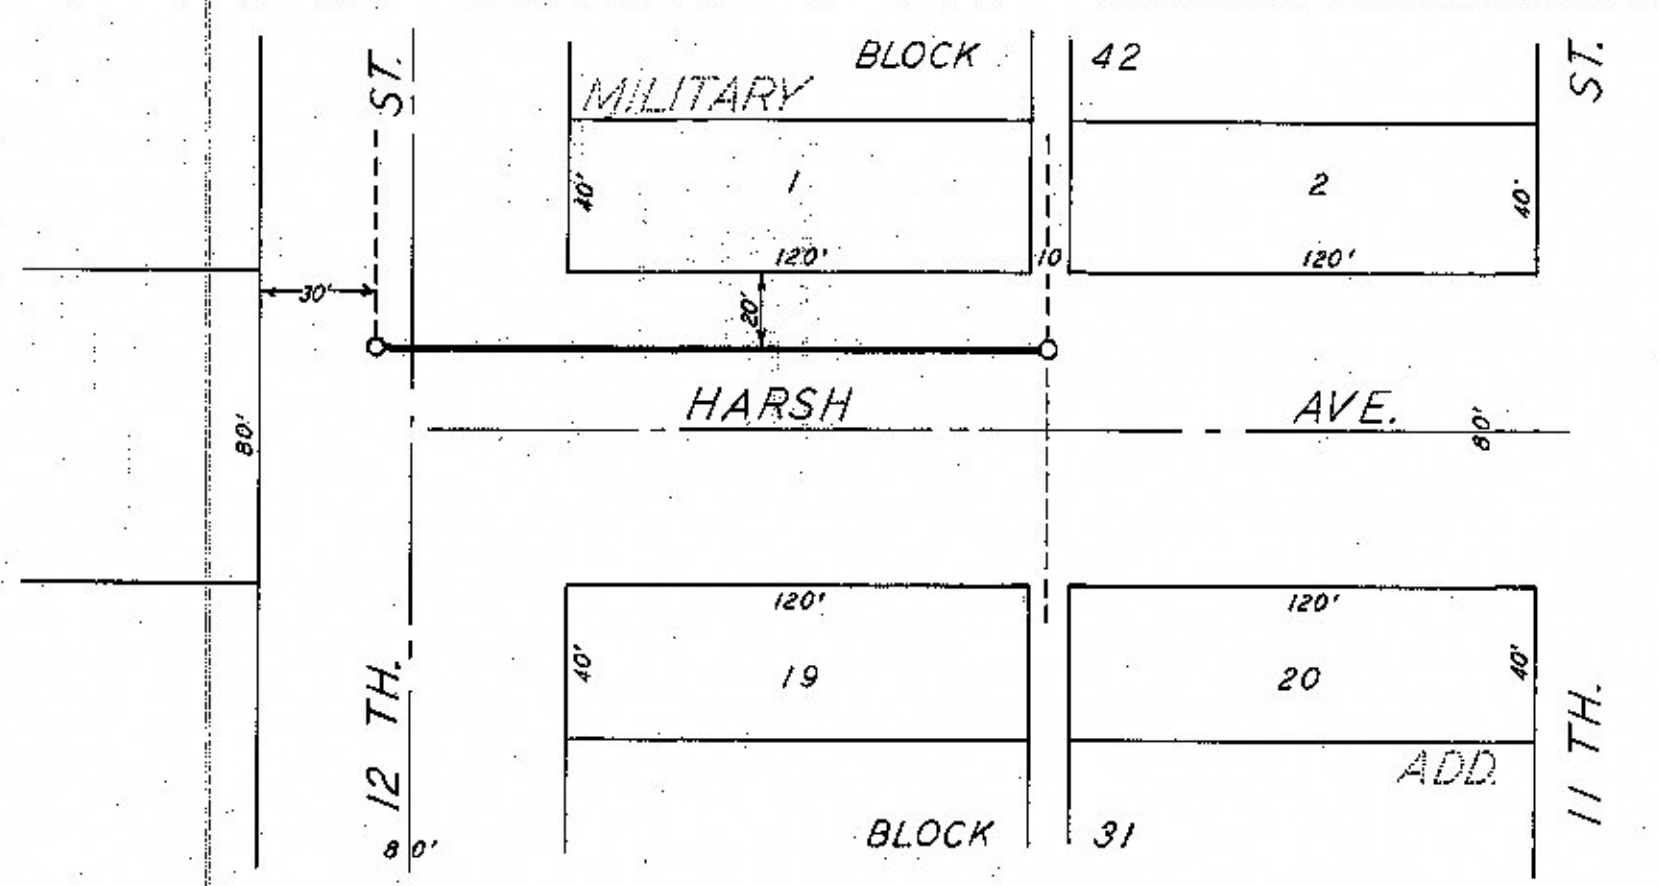


LATERAL 383 PACIFIC- ALLEY E. OF 12 TH. TO ALLEY W. OF 12TH. - N. PACIFIC TO HARSH

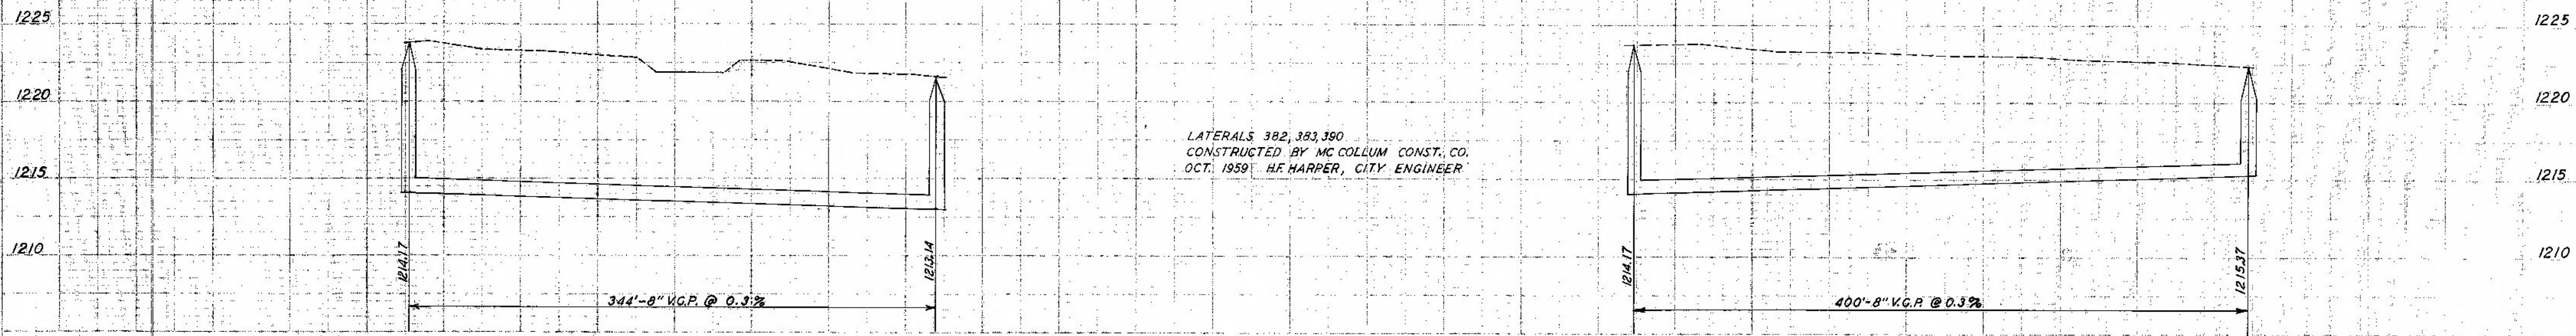

HARSH FROM ALLEY E. OF 12 TH. TO 12 TH., N. TO HAMILTON

R/W E. OF 12 TH. HAMILTON TO ANTRIM

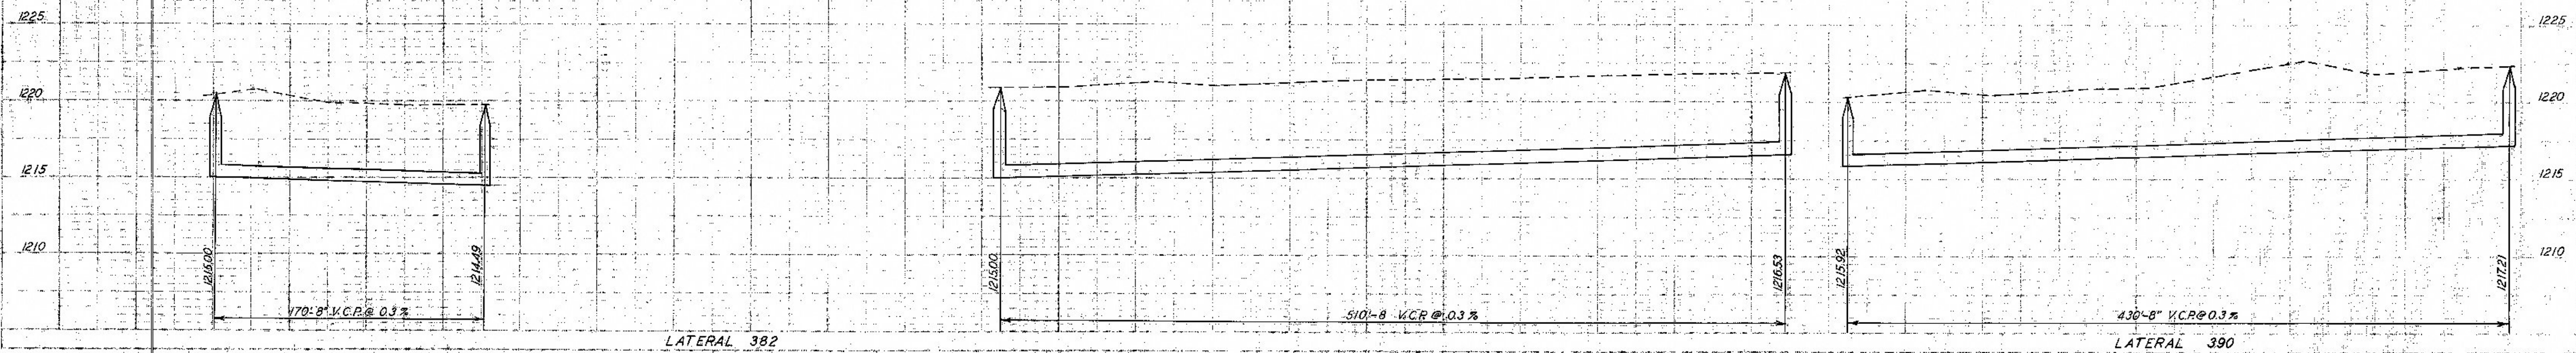

LATERAL 382

LATERAL 390

POSTED TO THE PUBLIC RECORDS OF THE CITY OF DENVER, COLORADO, MAY 1960.