




308

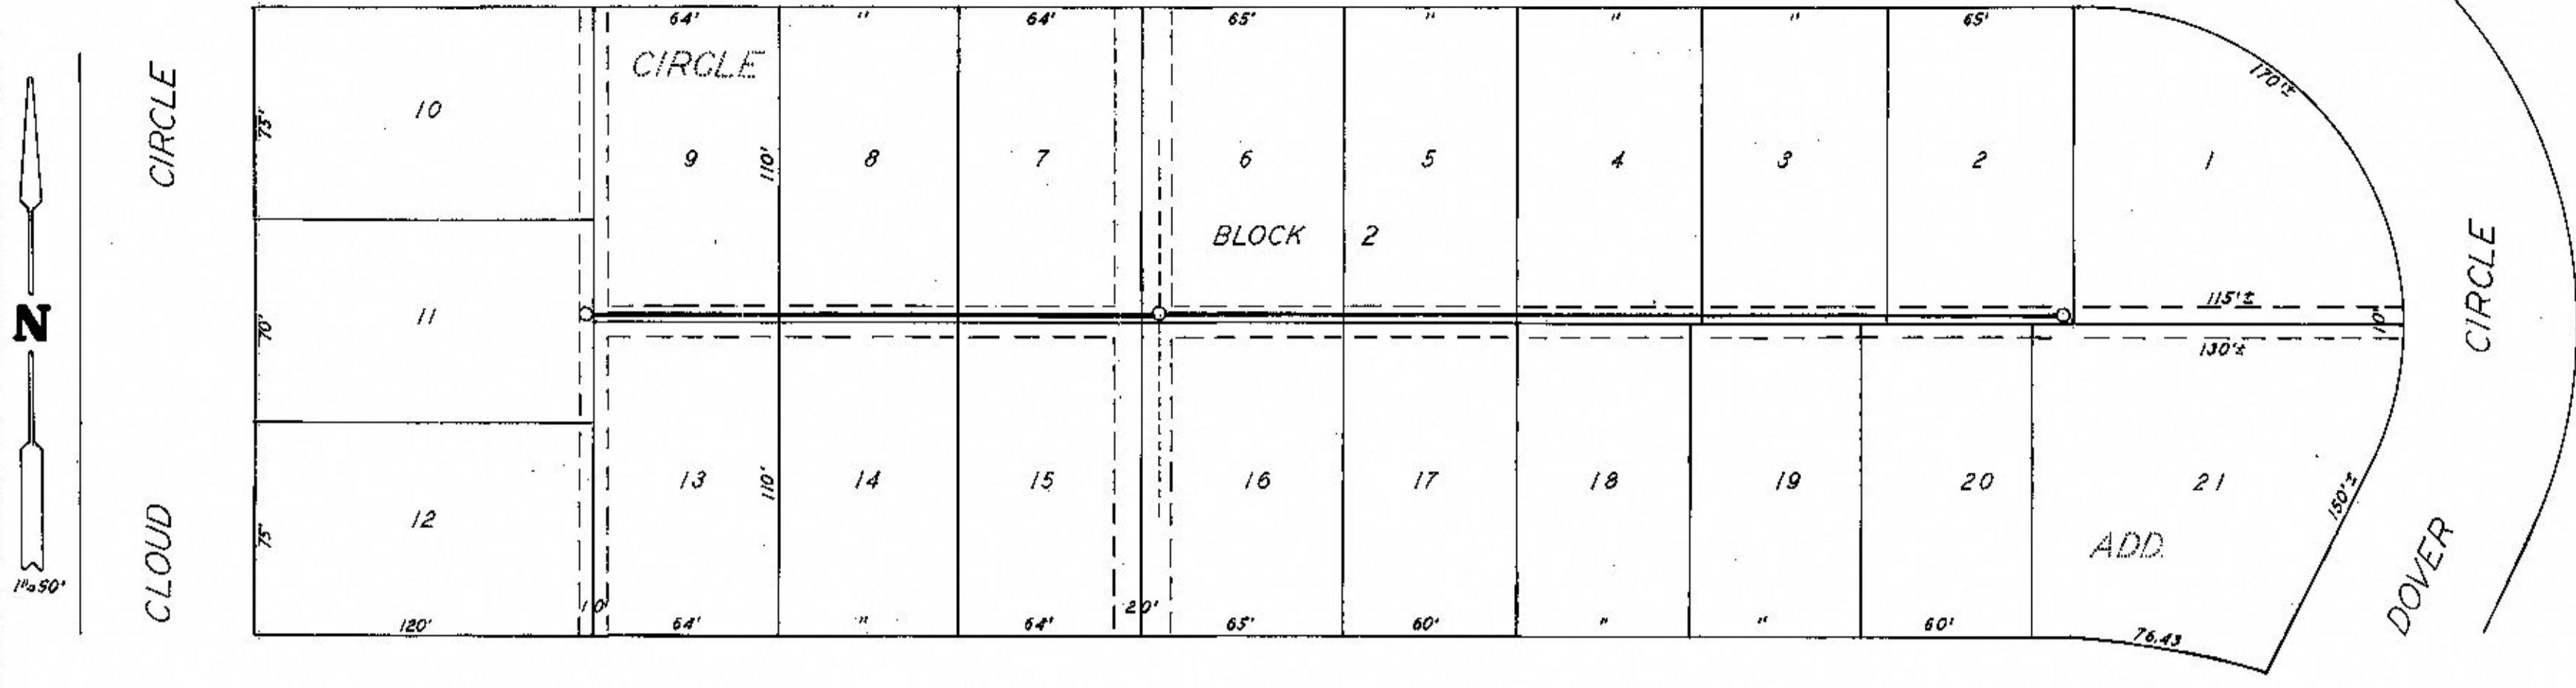



SANITARY SEWER SERVING BLOCK 2, CIRCLE ADD.

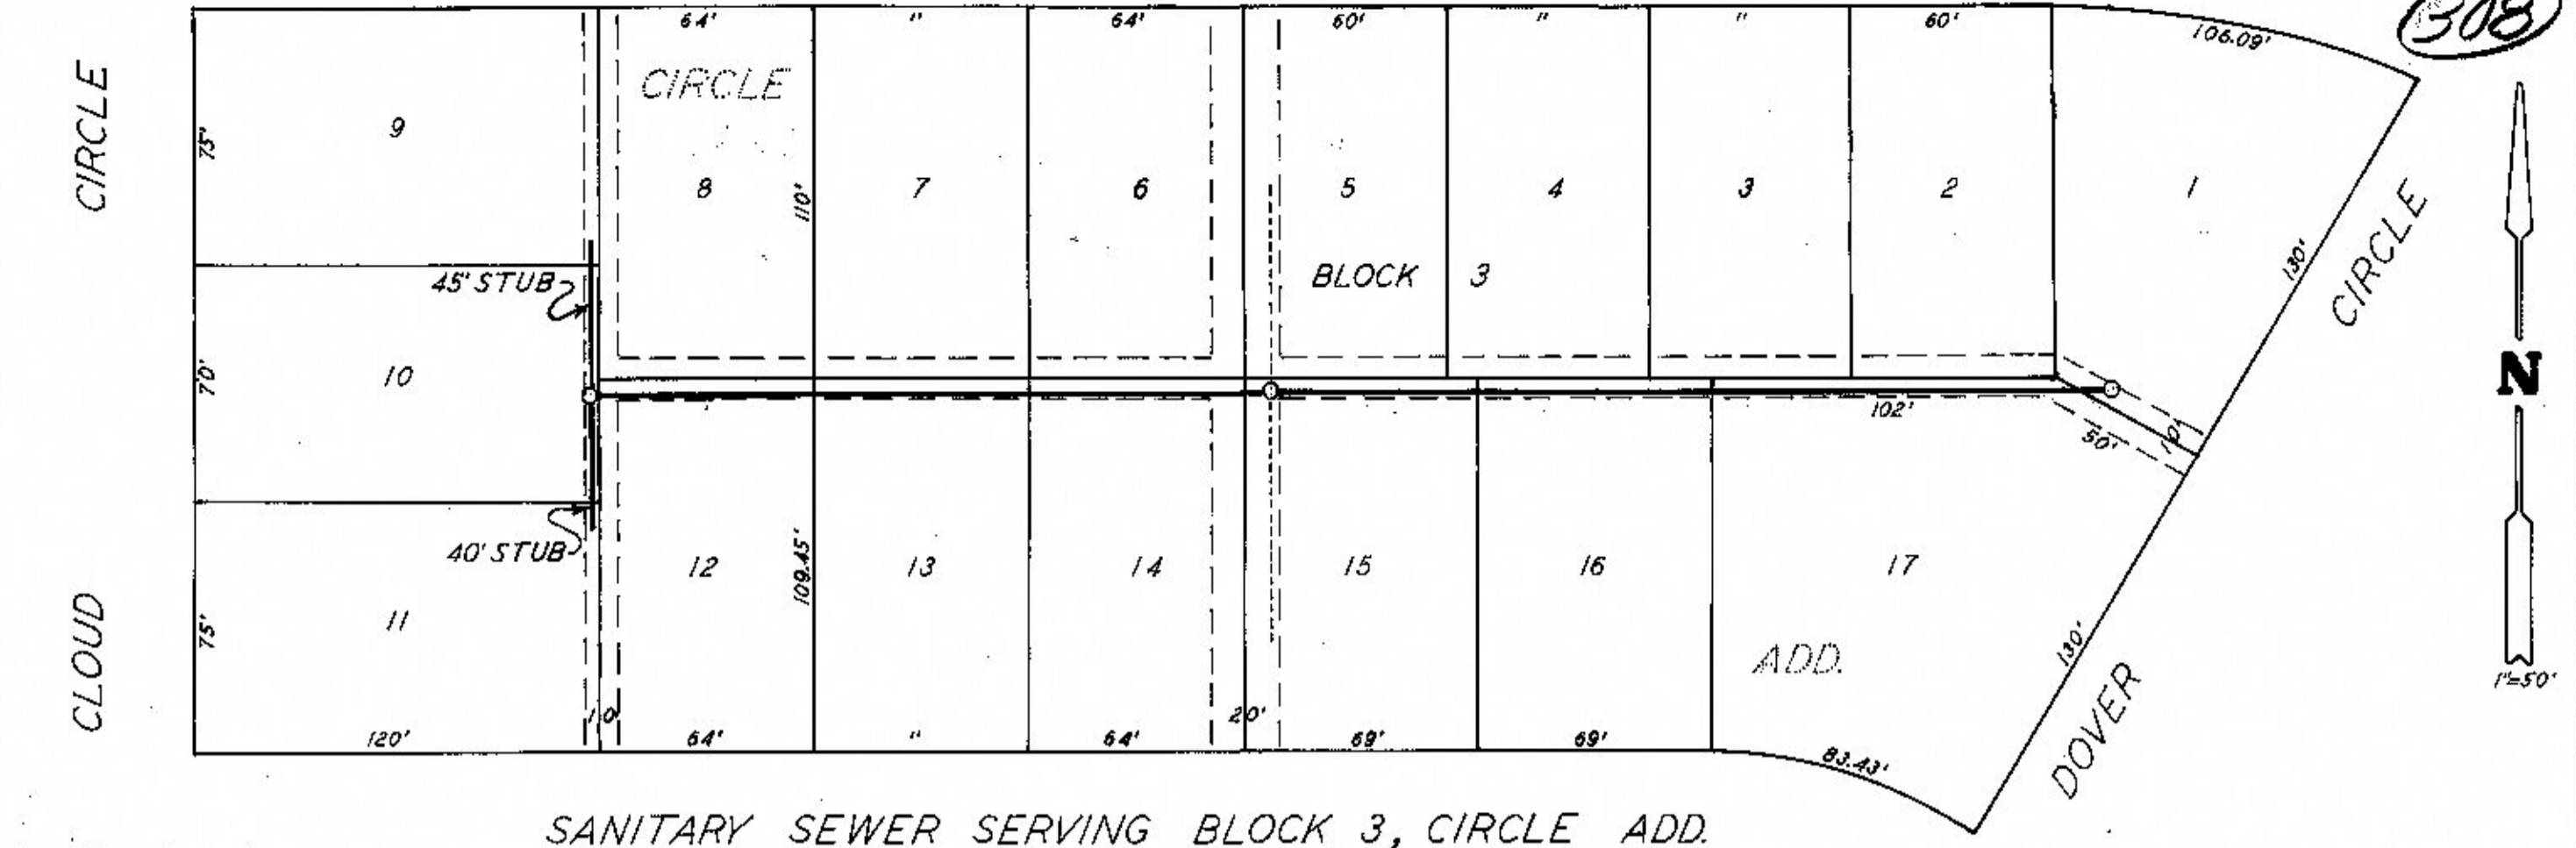

SANITARY SEWER SERVING BLOCK 3, CIRCLE ADD.

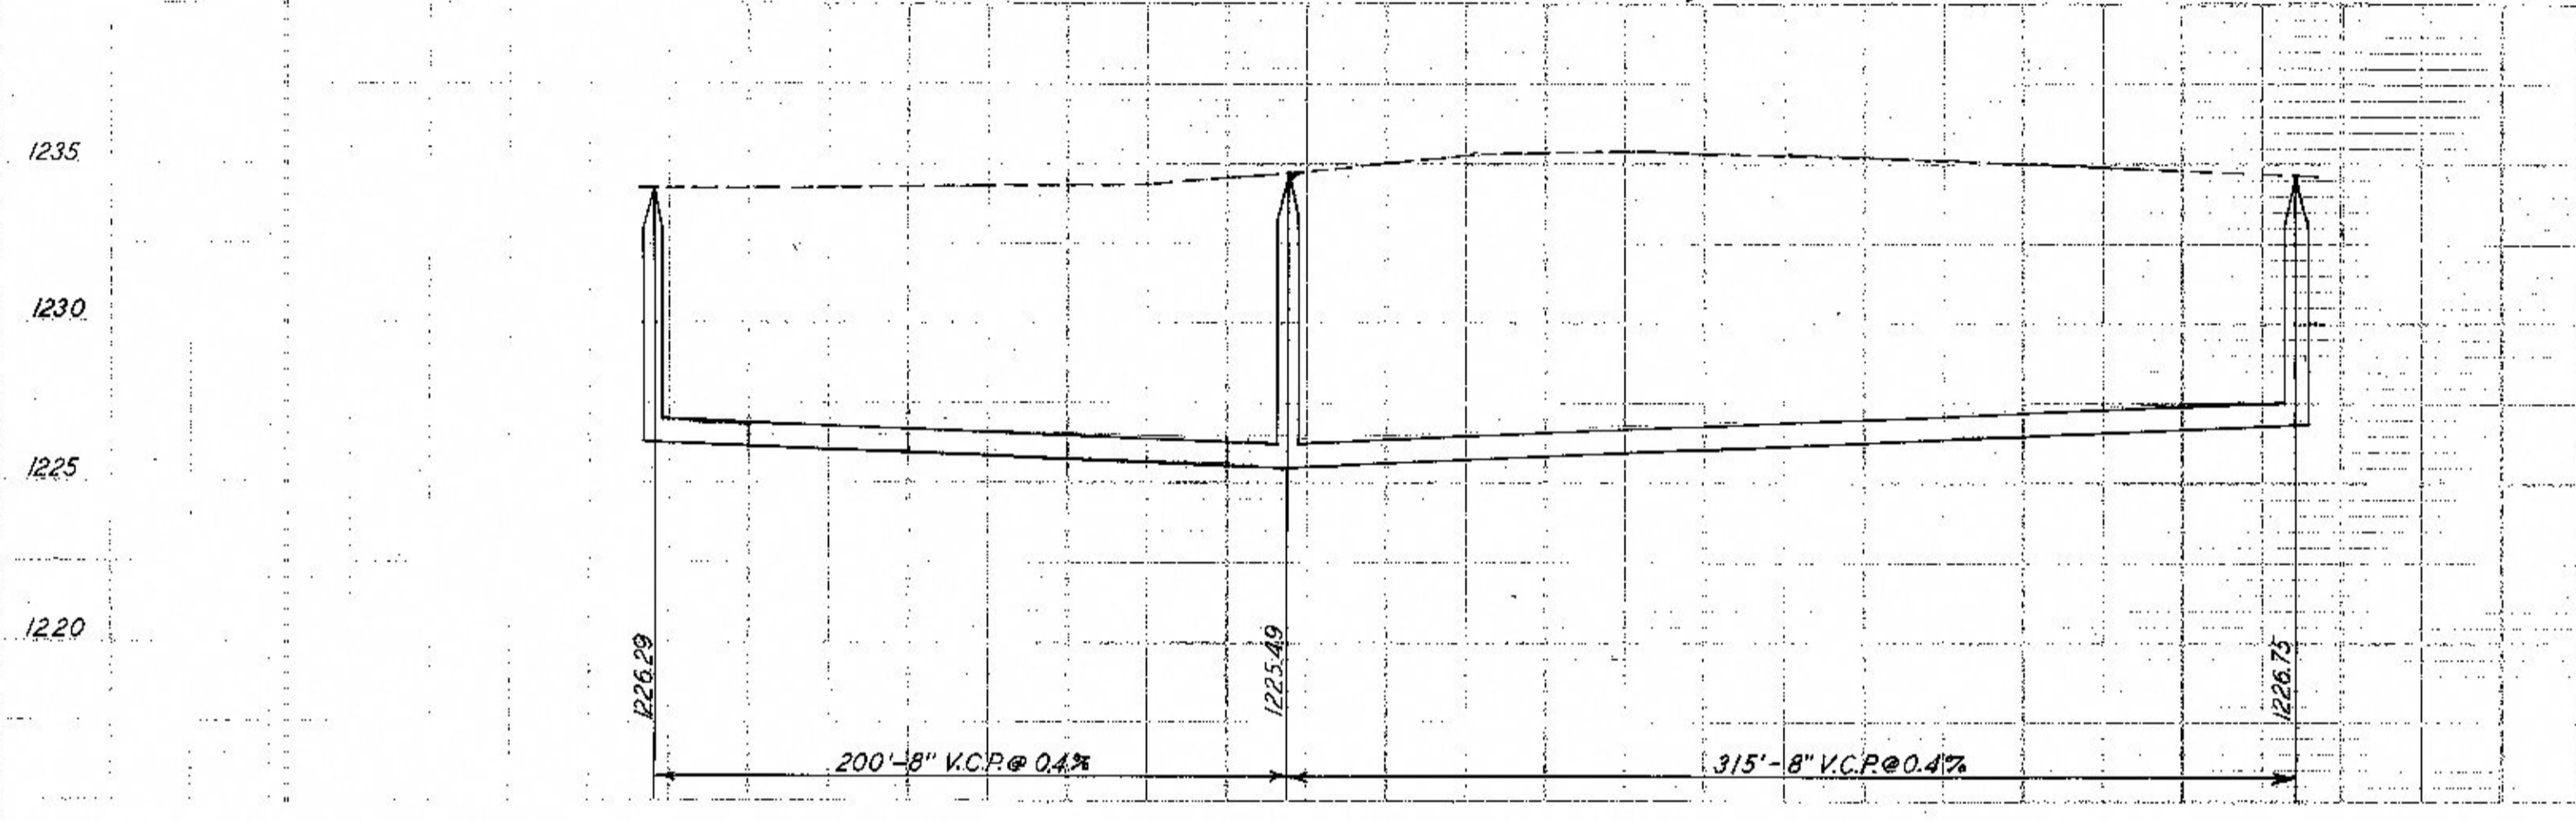

AS BUILT PLAN 1959  
CONSTRUCTED BY  
MC COLLUM CONST CO  
H F HARPER, CITY ENG

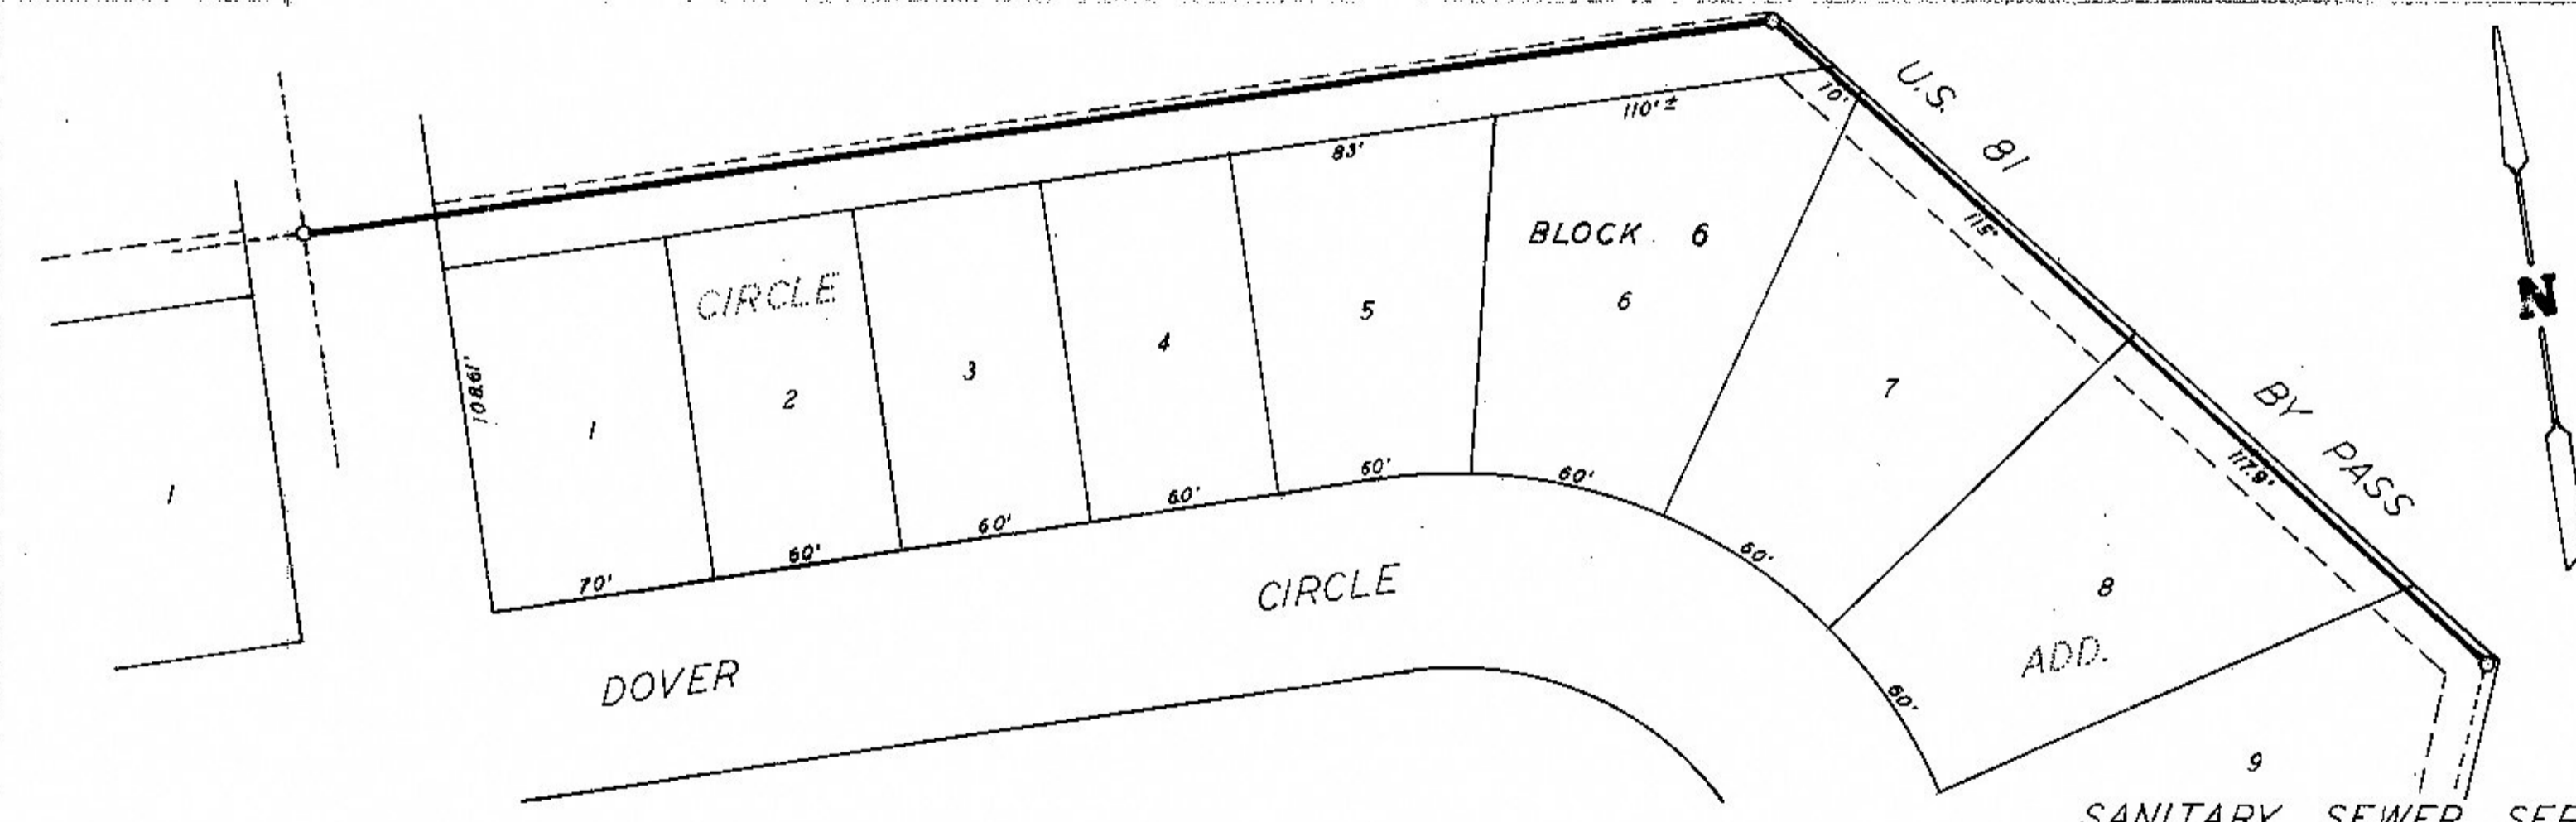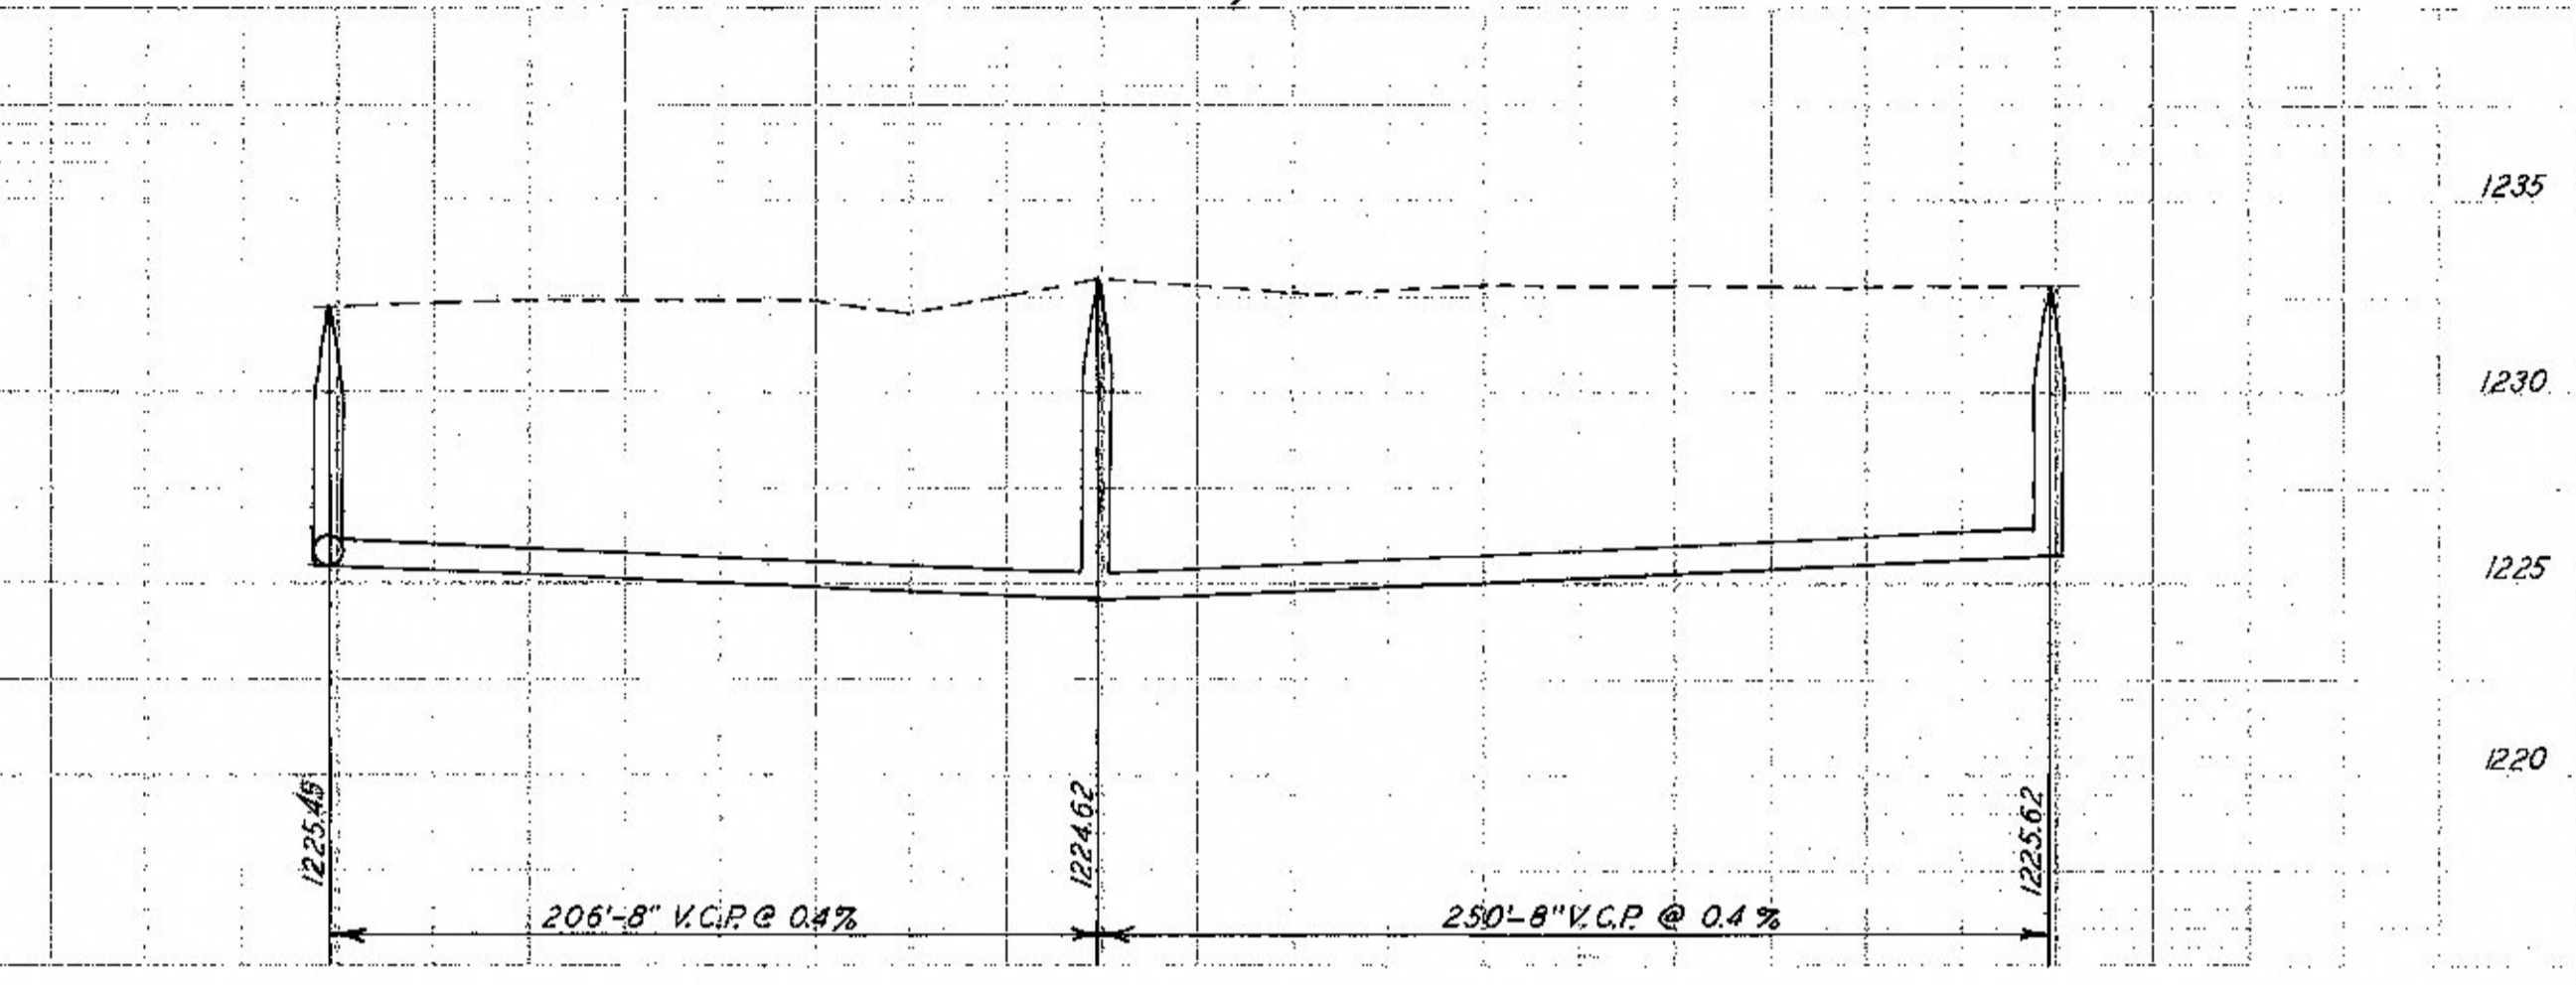

SANITARY SEWER SERVING LOTS 1 TO 15, BLOCK 6, CIRCLE ADD.

