



SANITARY SEWER MAIN FROM LIKENS FOSTER ADD. THROUGH CIRCLE ADD. TO INGERMANSON HEIGHTS ADD.

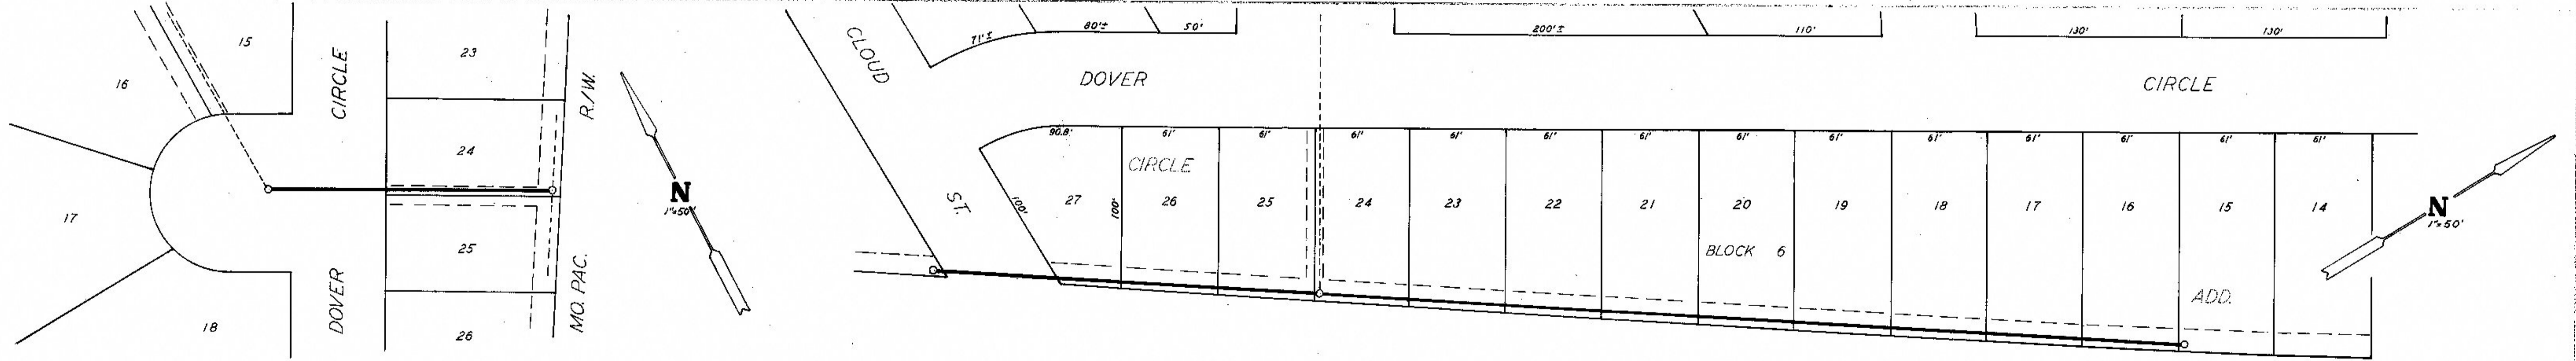

SANITARY SEWER SERVING LOTS 15 TO 27, BLOCK 6 CIRCLE ADD.

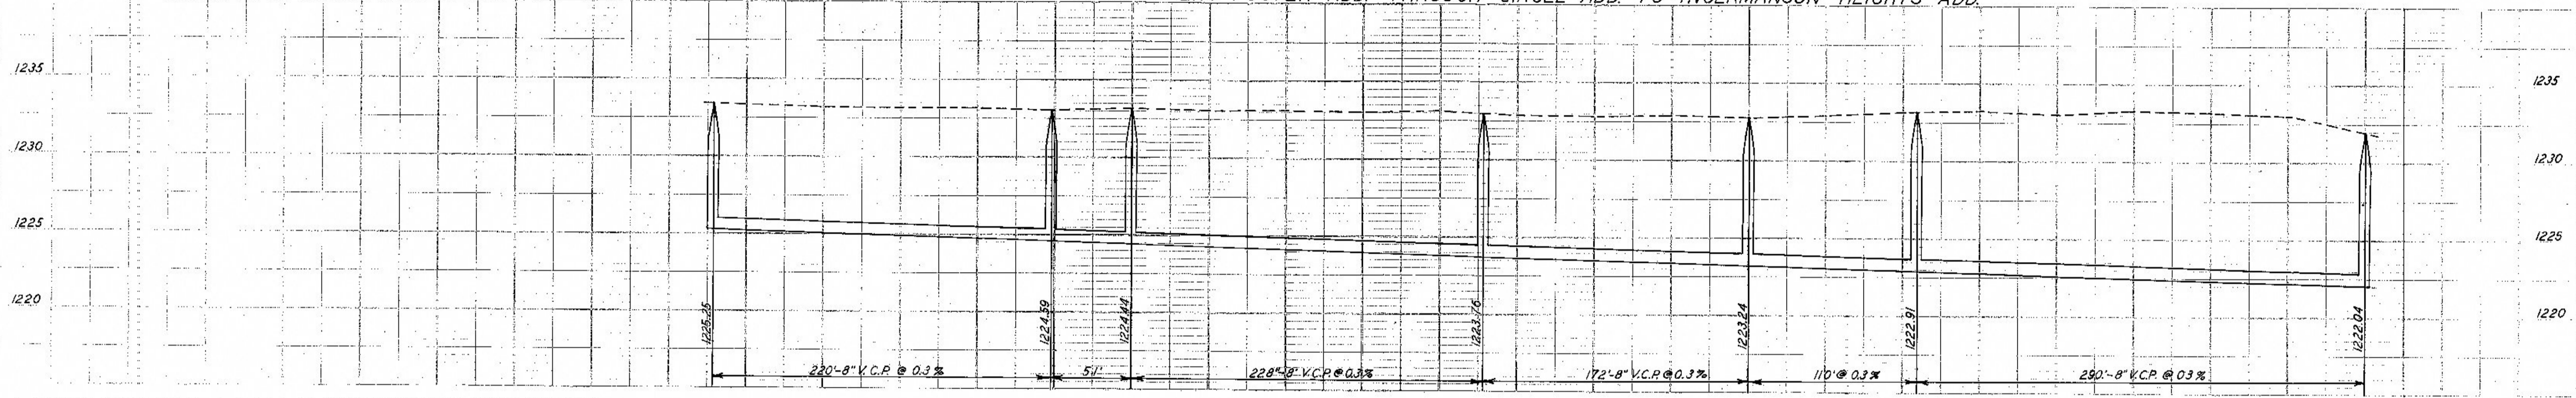