


389





GG-66 P-14 F-2

(311)

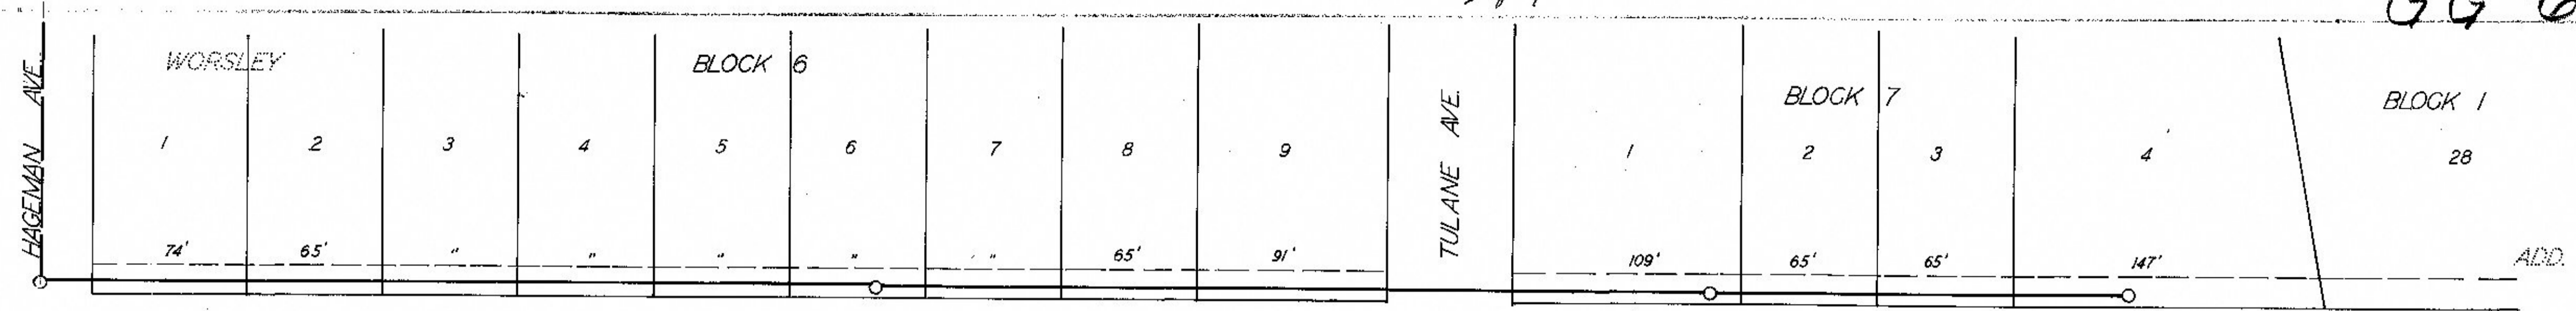

UNPLATED LAND

R/W SOUTH OF YALE-HAGEMAN TO 1000' EAST

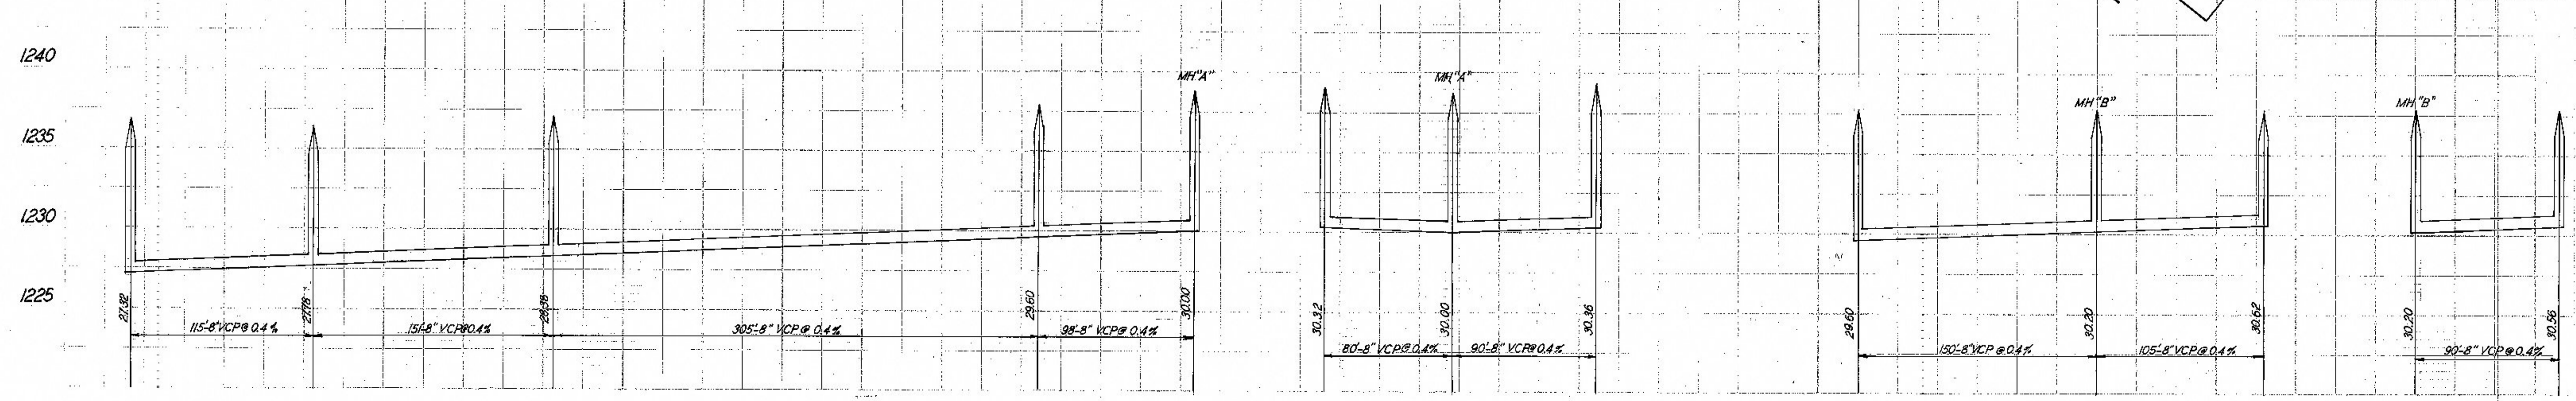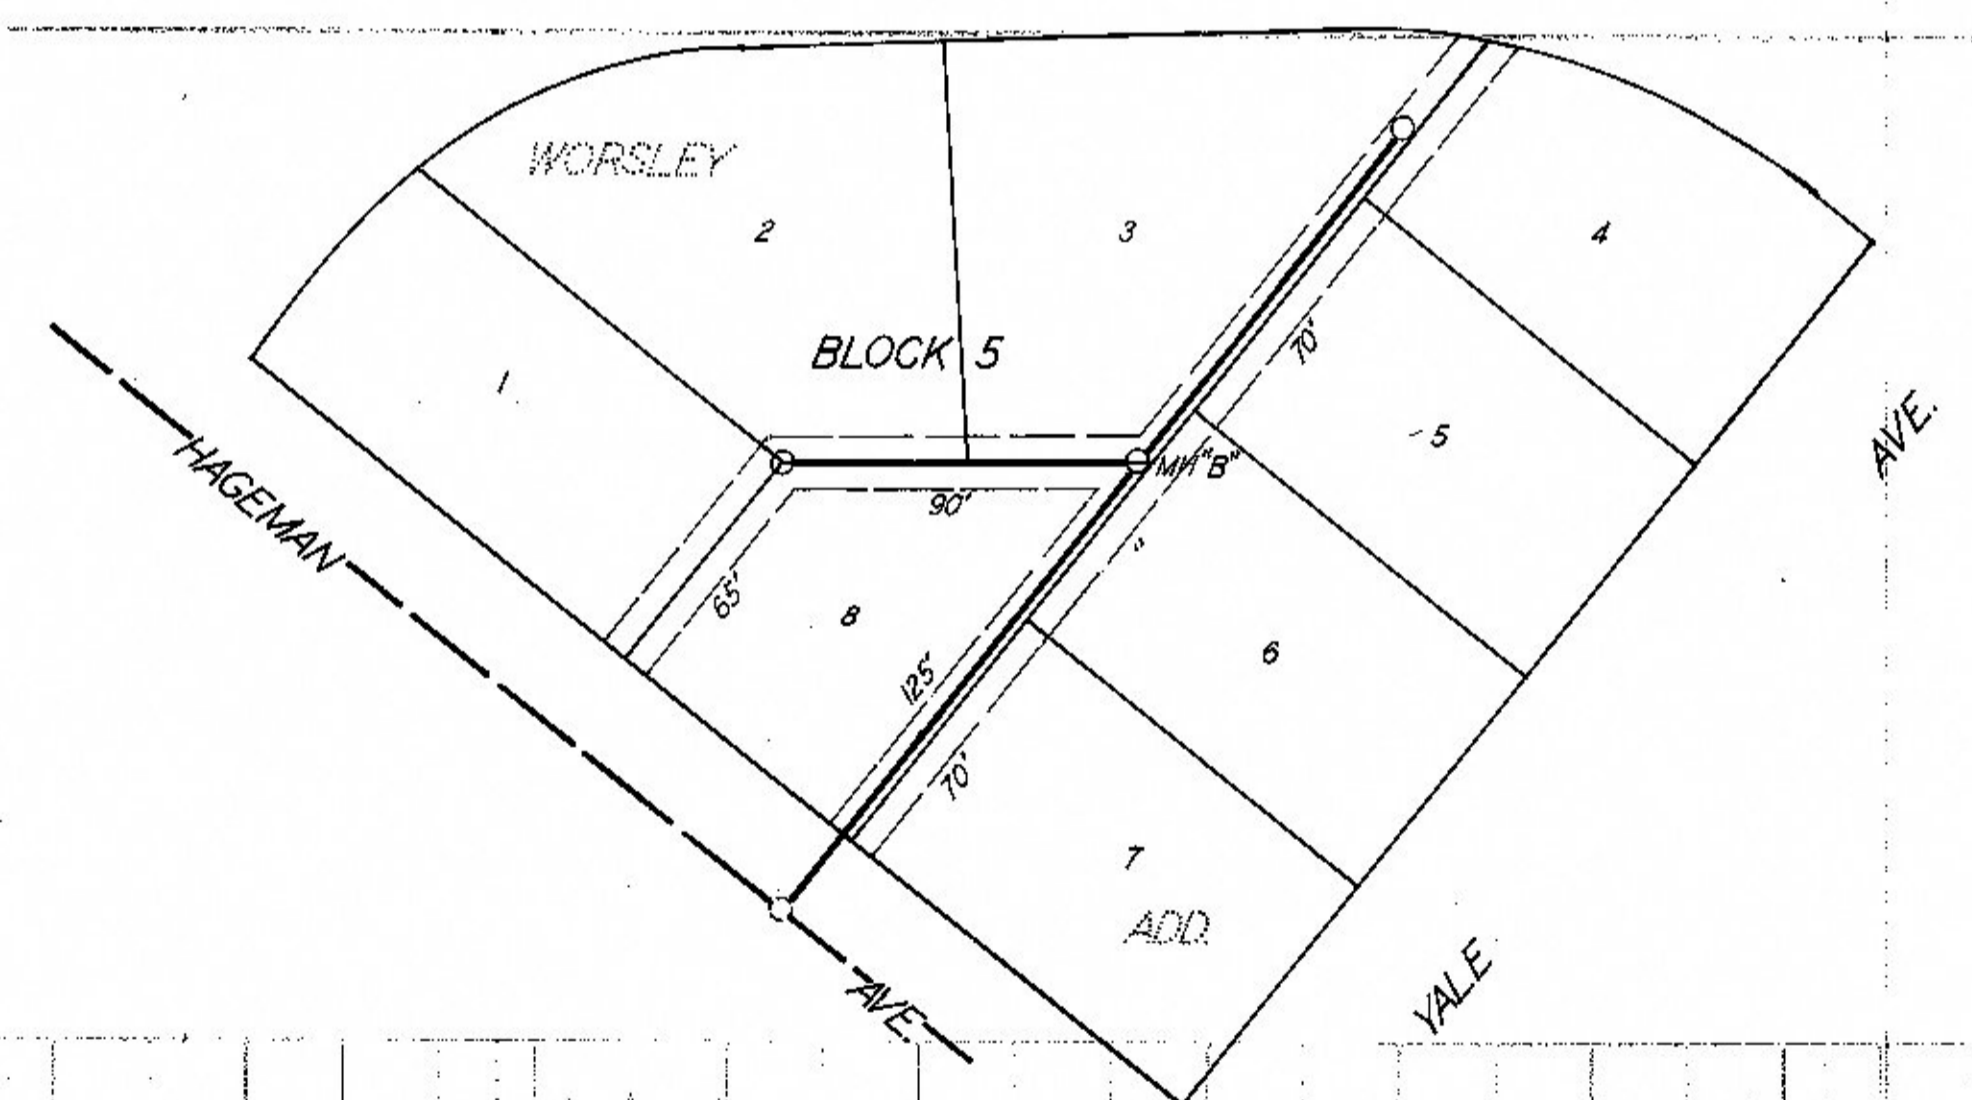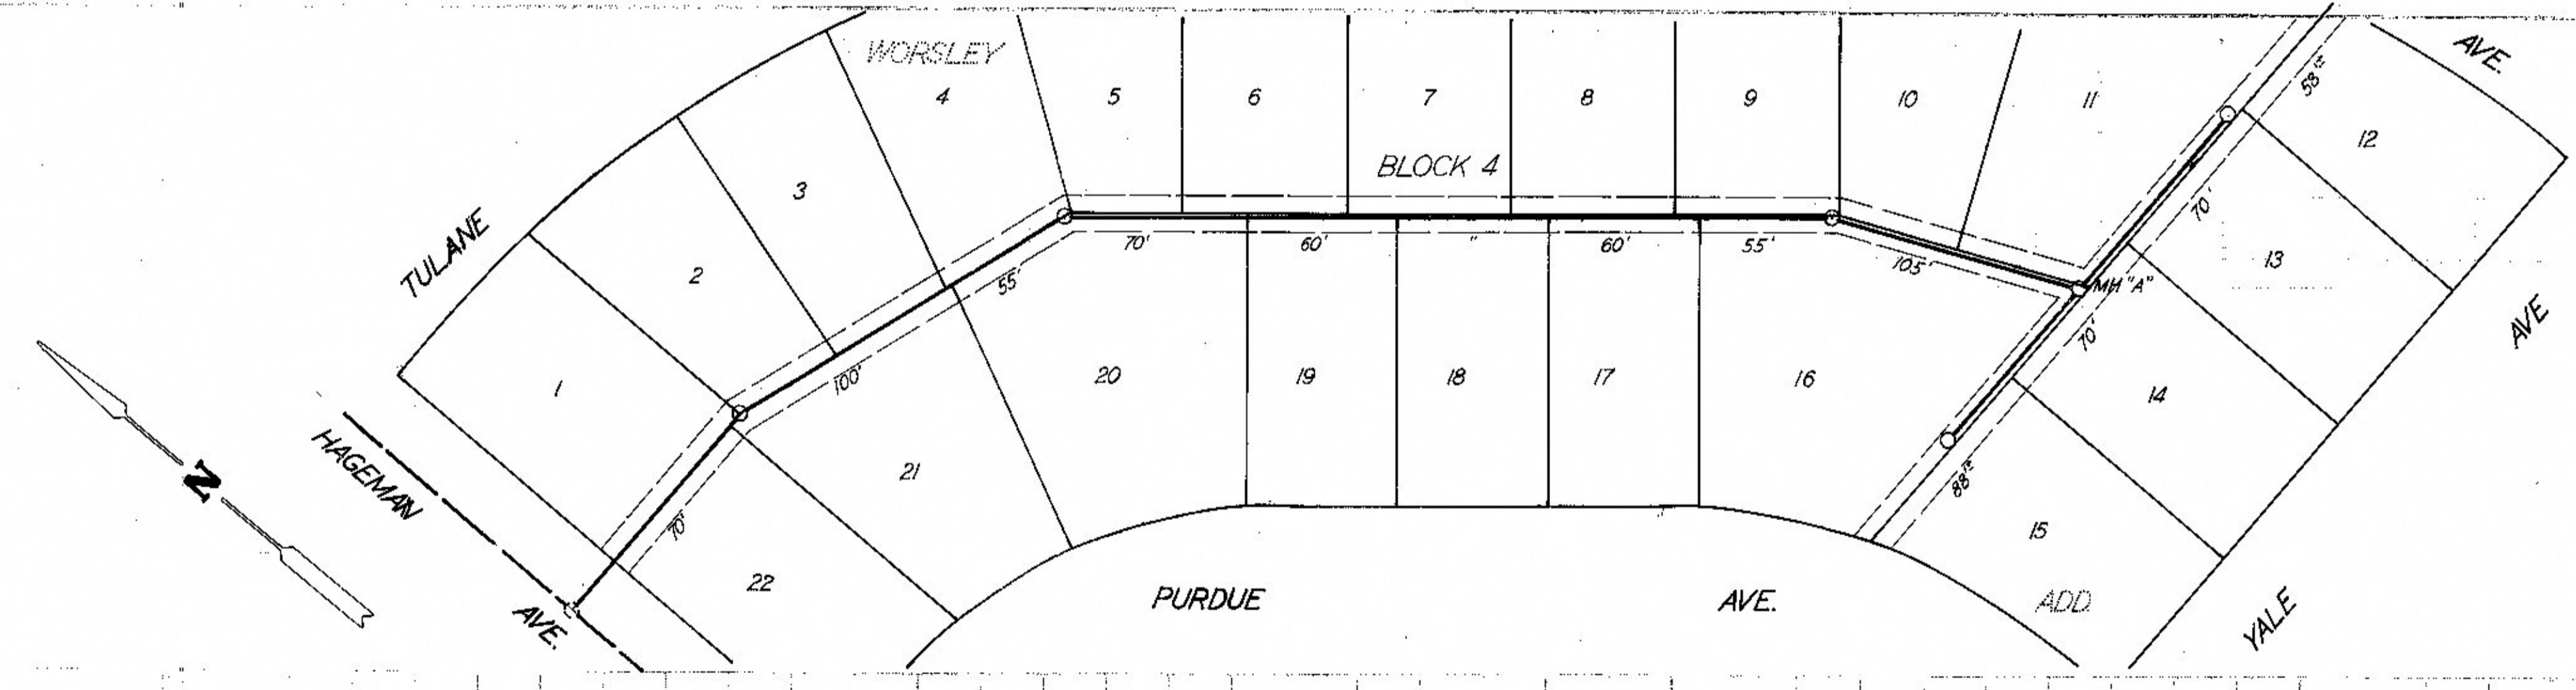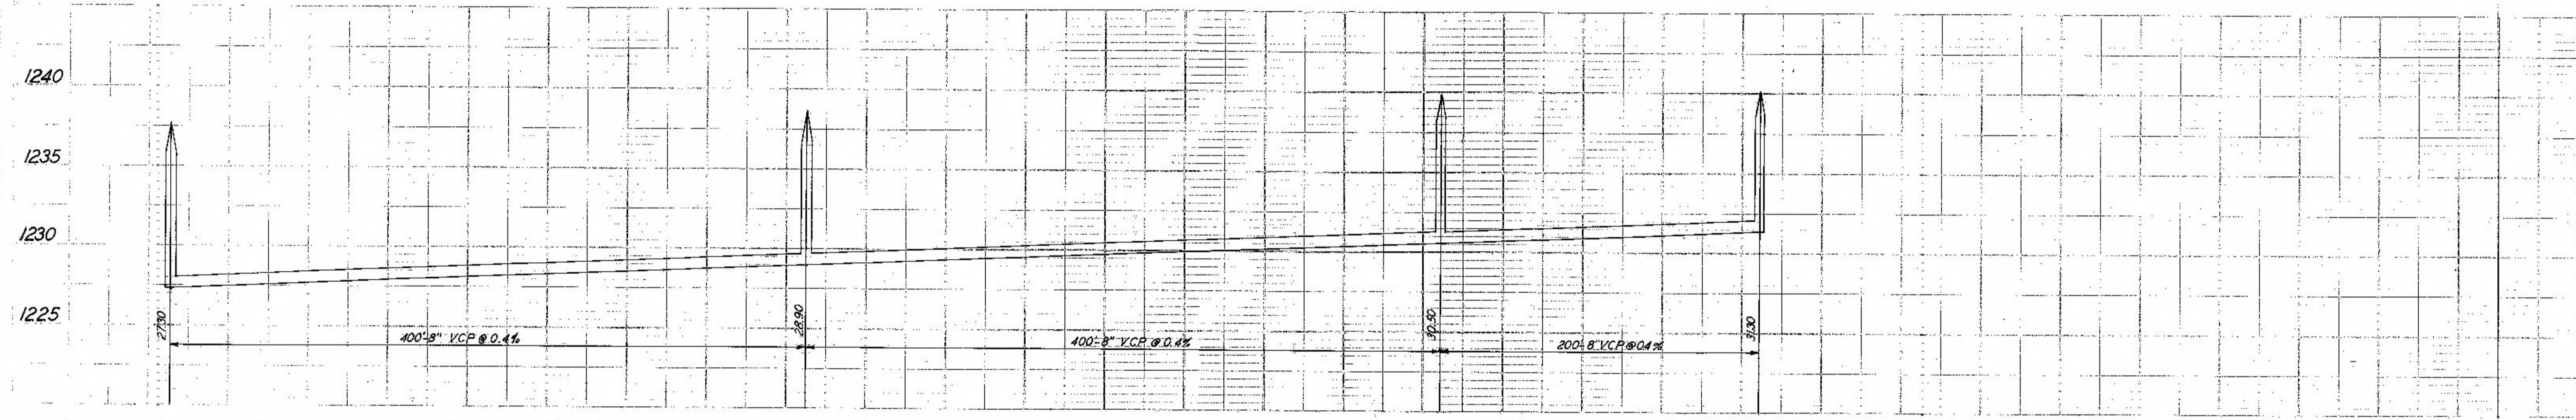

387

388