



SANITARY SEWER - CLAREMONT - R/W S. RUSKIN TO S. OF QUEENS

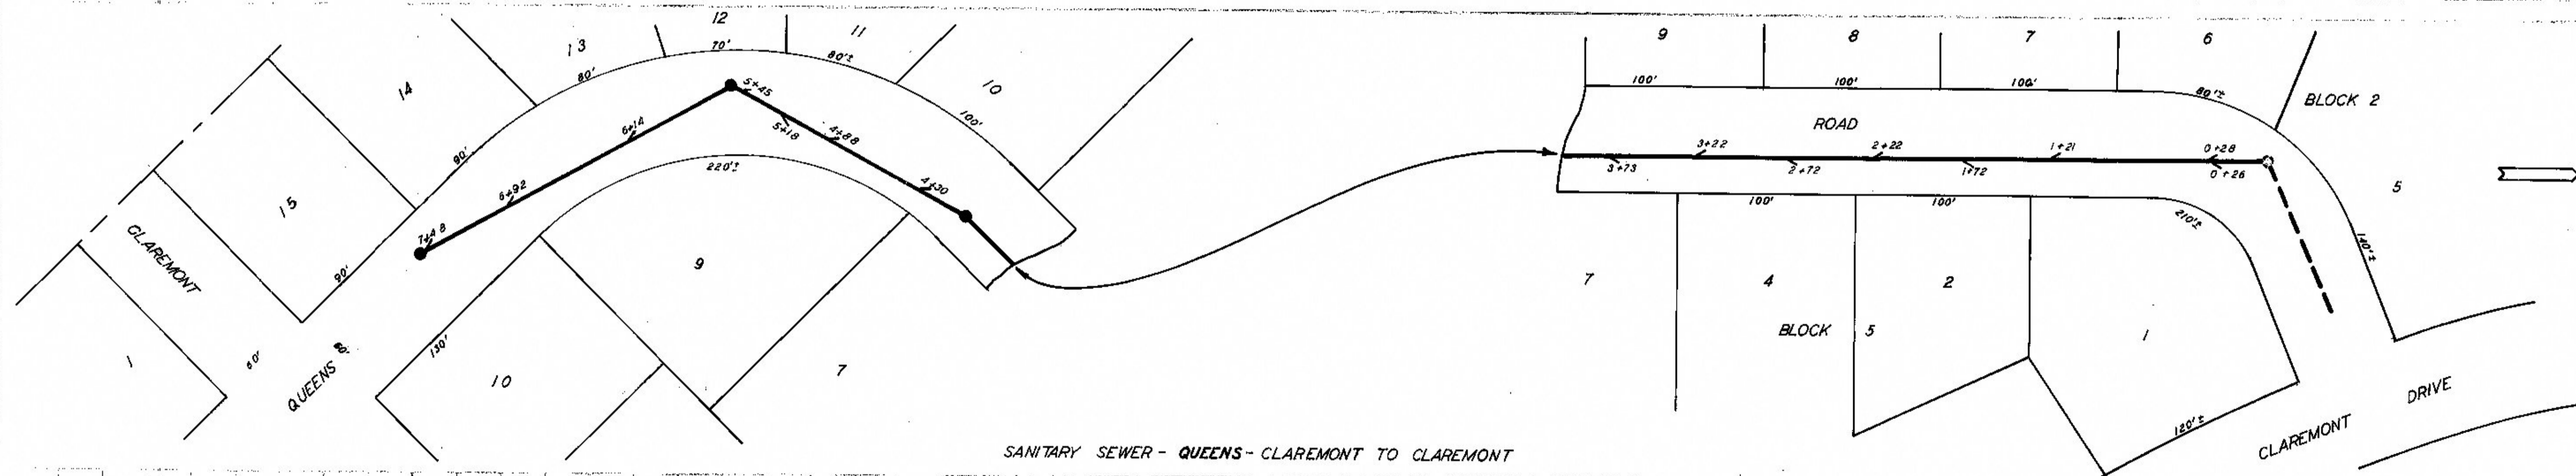

SANITARY SEWER - QUEENS - CLAREMONT TO CLAREMONT

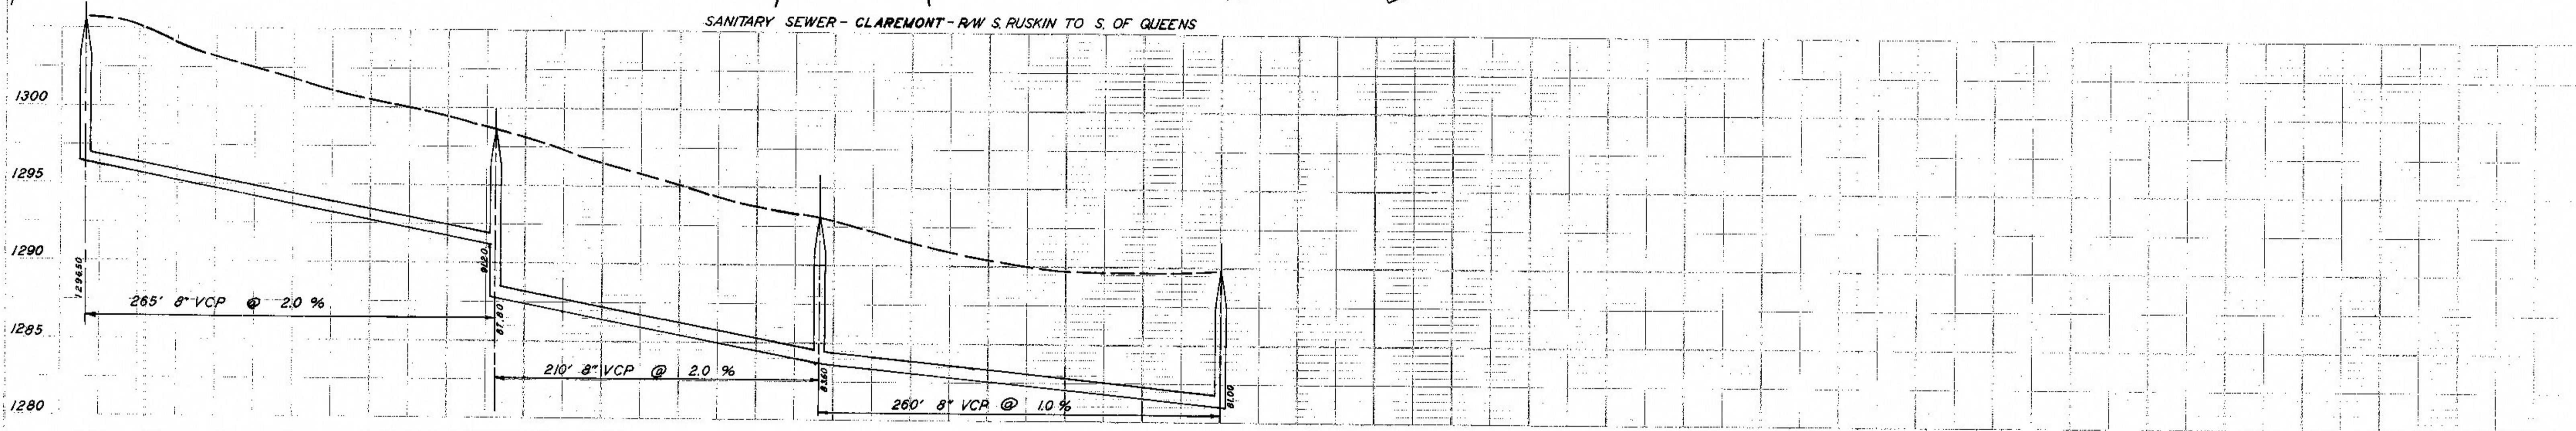